

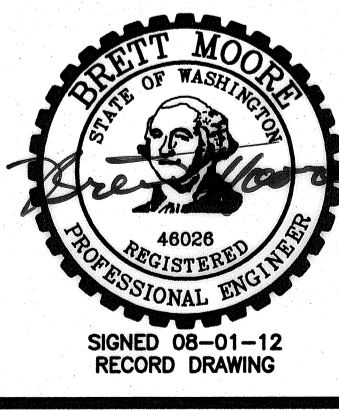
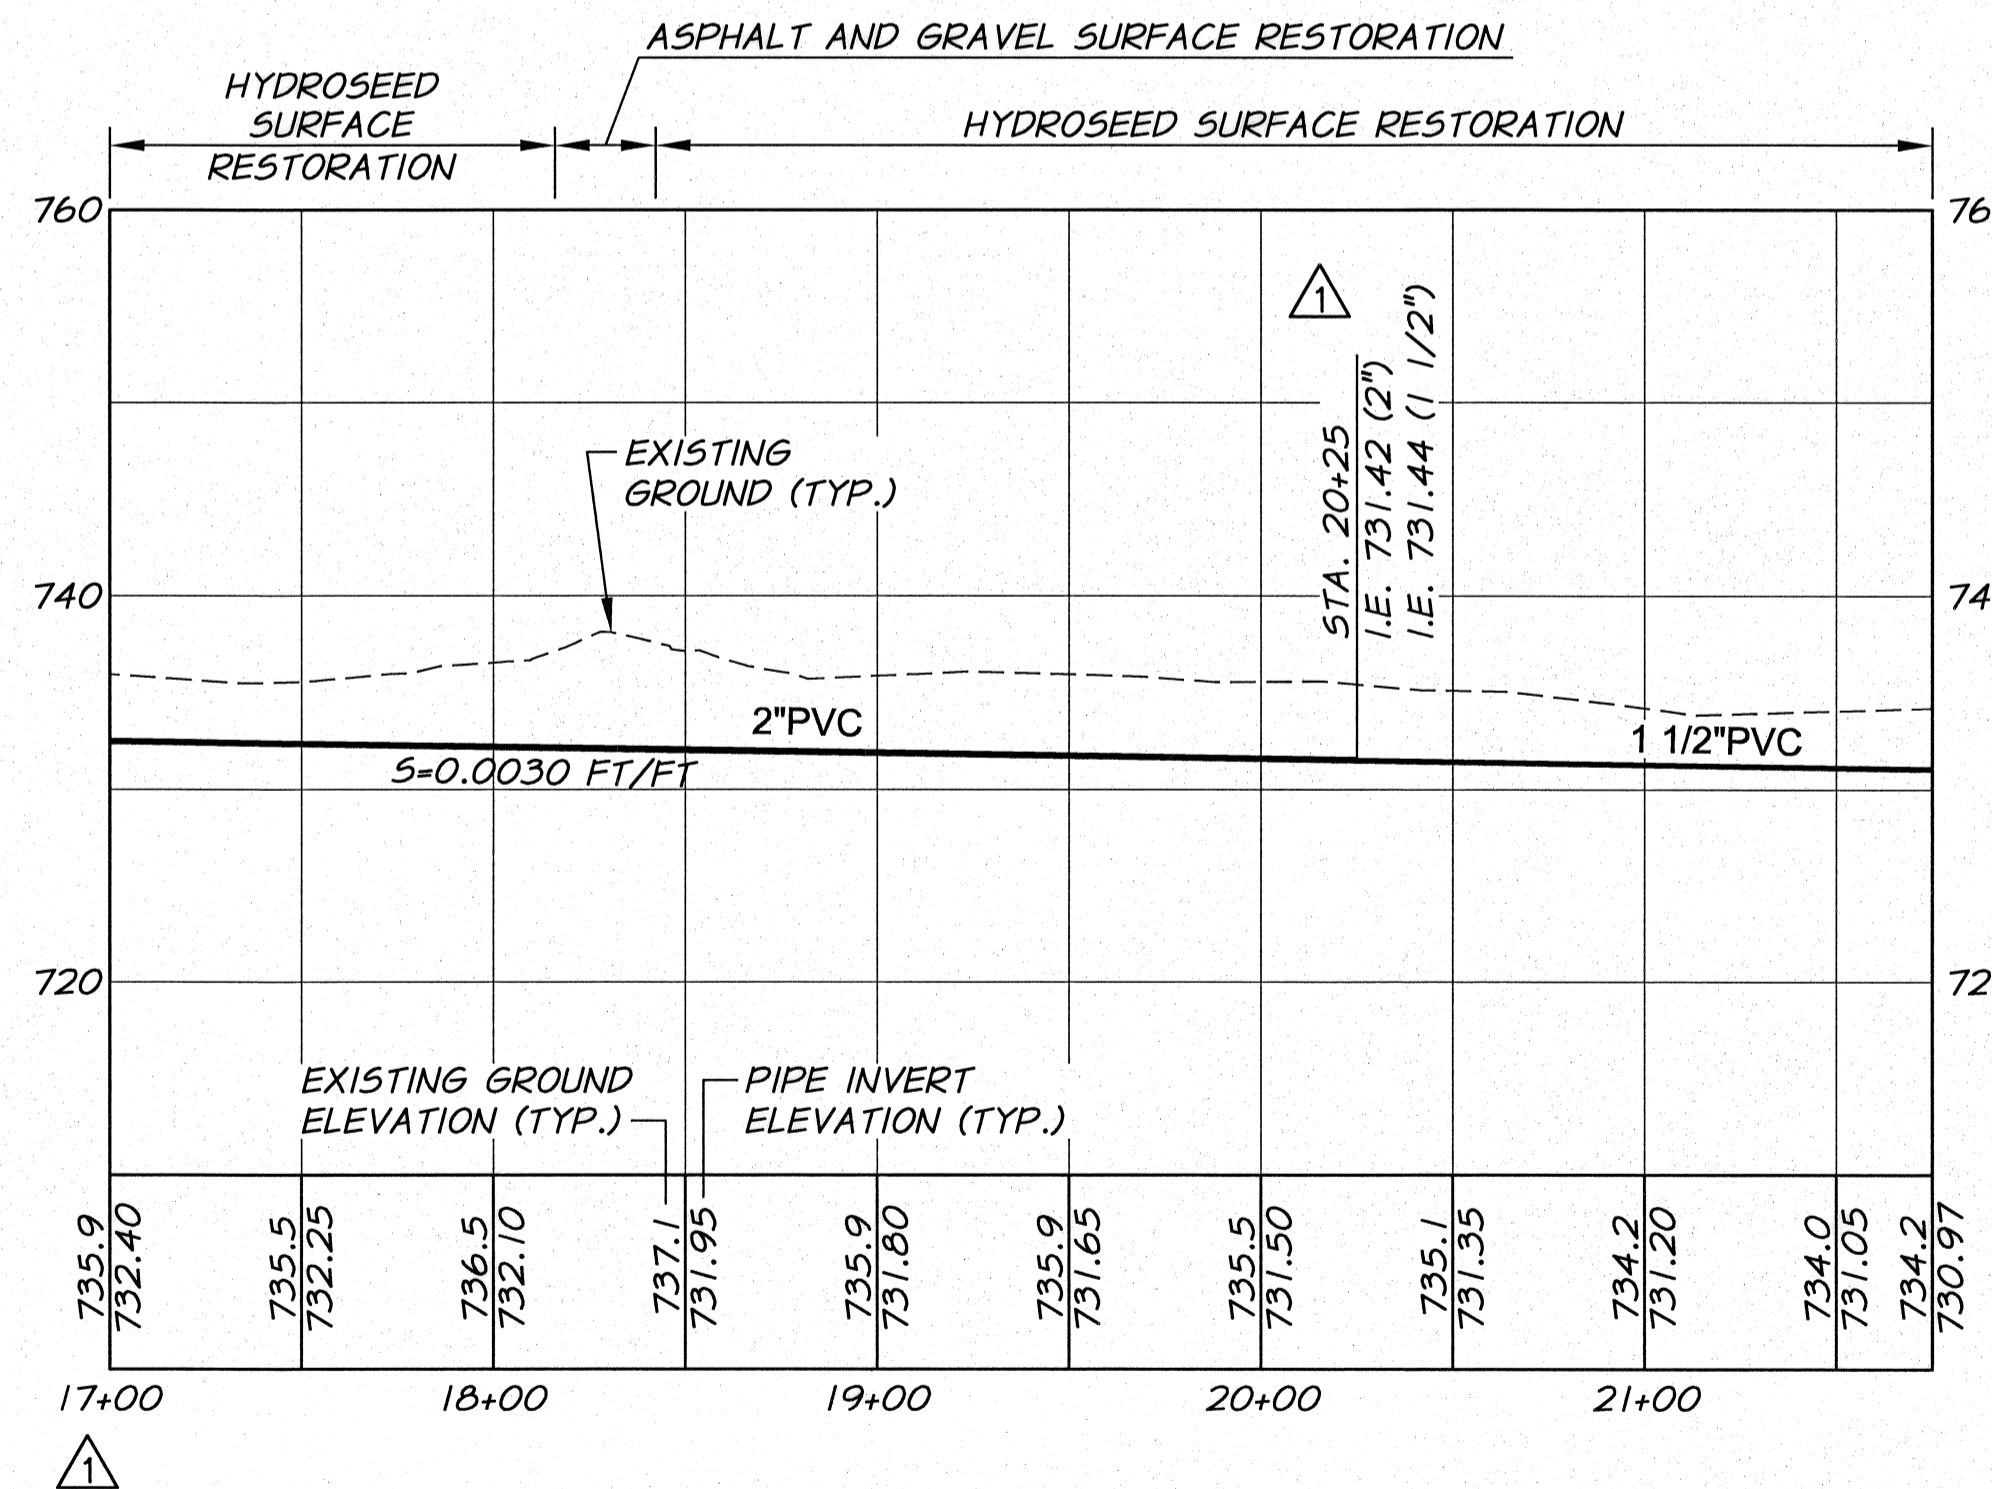


**WORK ITEMS**

- Ⓓ REMOVE CONTROL GATE, PIPING, AND CONCRETE STRUCTURE FROM CANAL OUTLET. RESTORE CANAL BANK WITH COMPACTED GENERAL BACKFILL MATERIAL. SHAPE BANK TO MATCH EXISTING. PAID UNDER "IRRIGATION CONTROL STRUCTURE REMOVAL" BID ITEM.

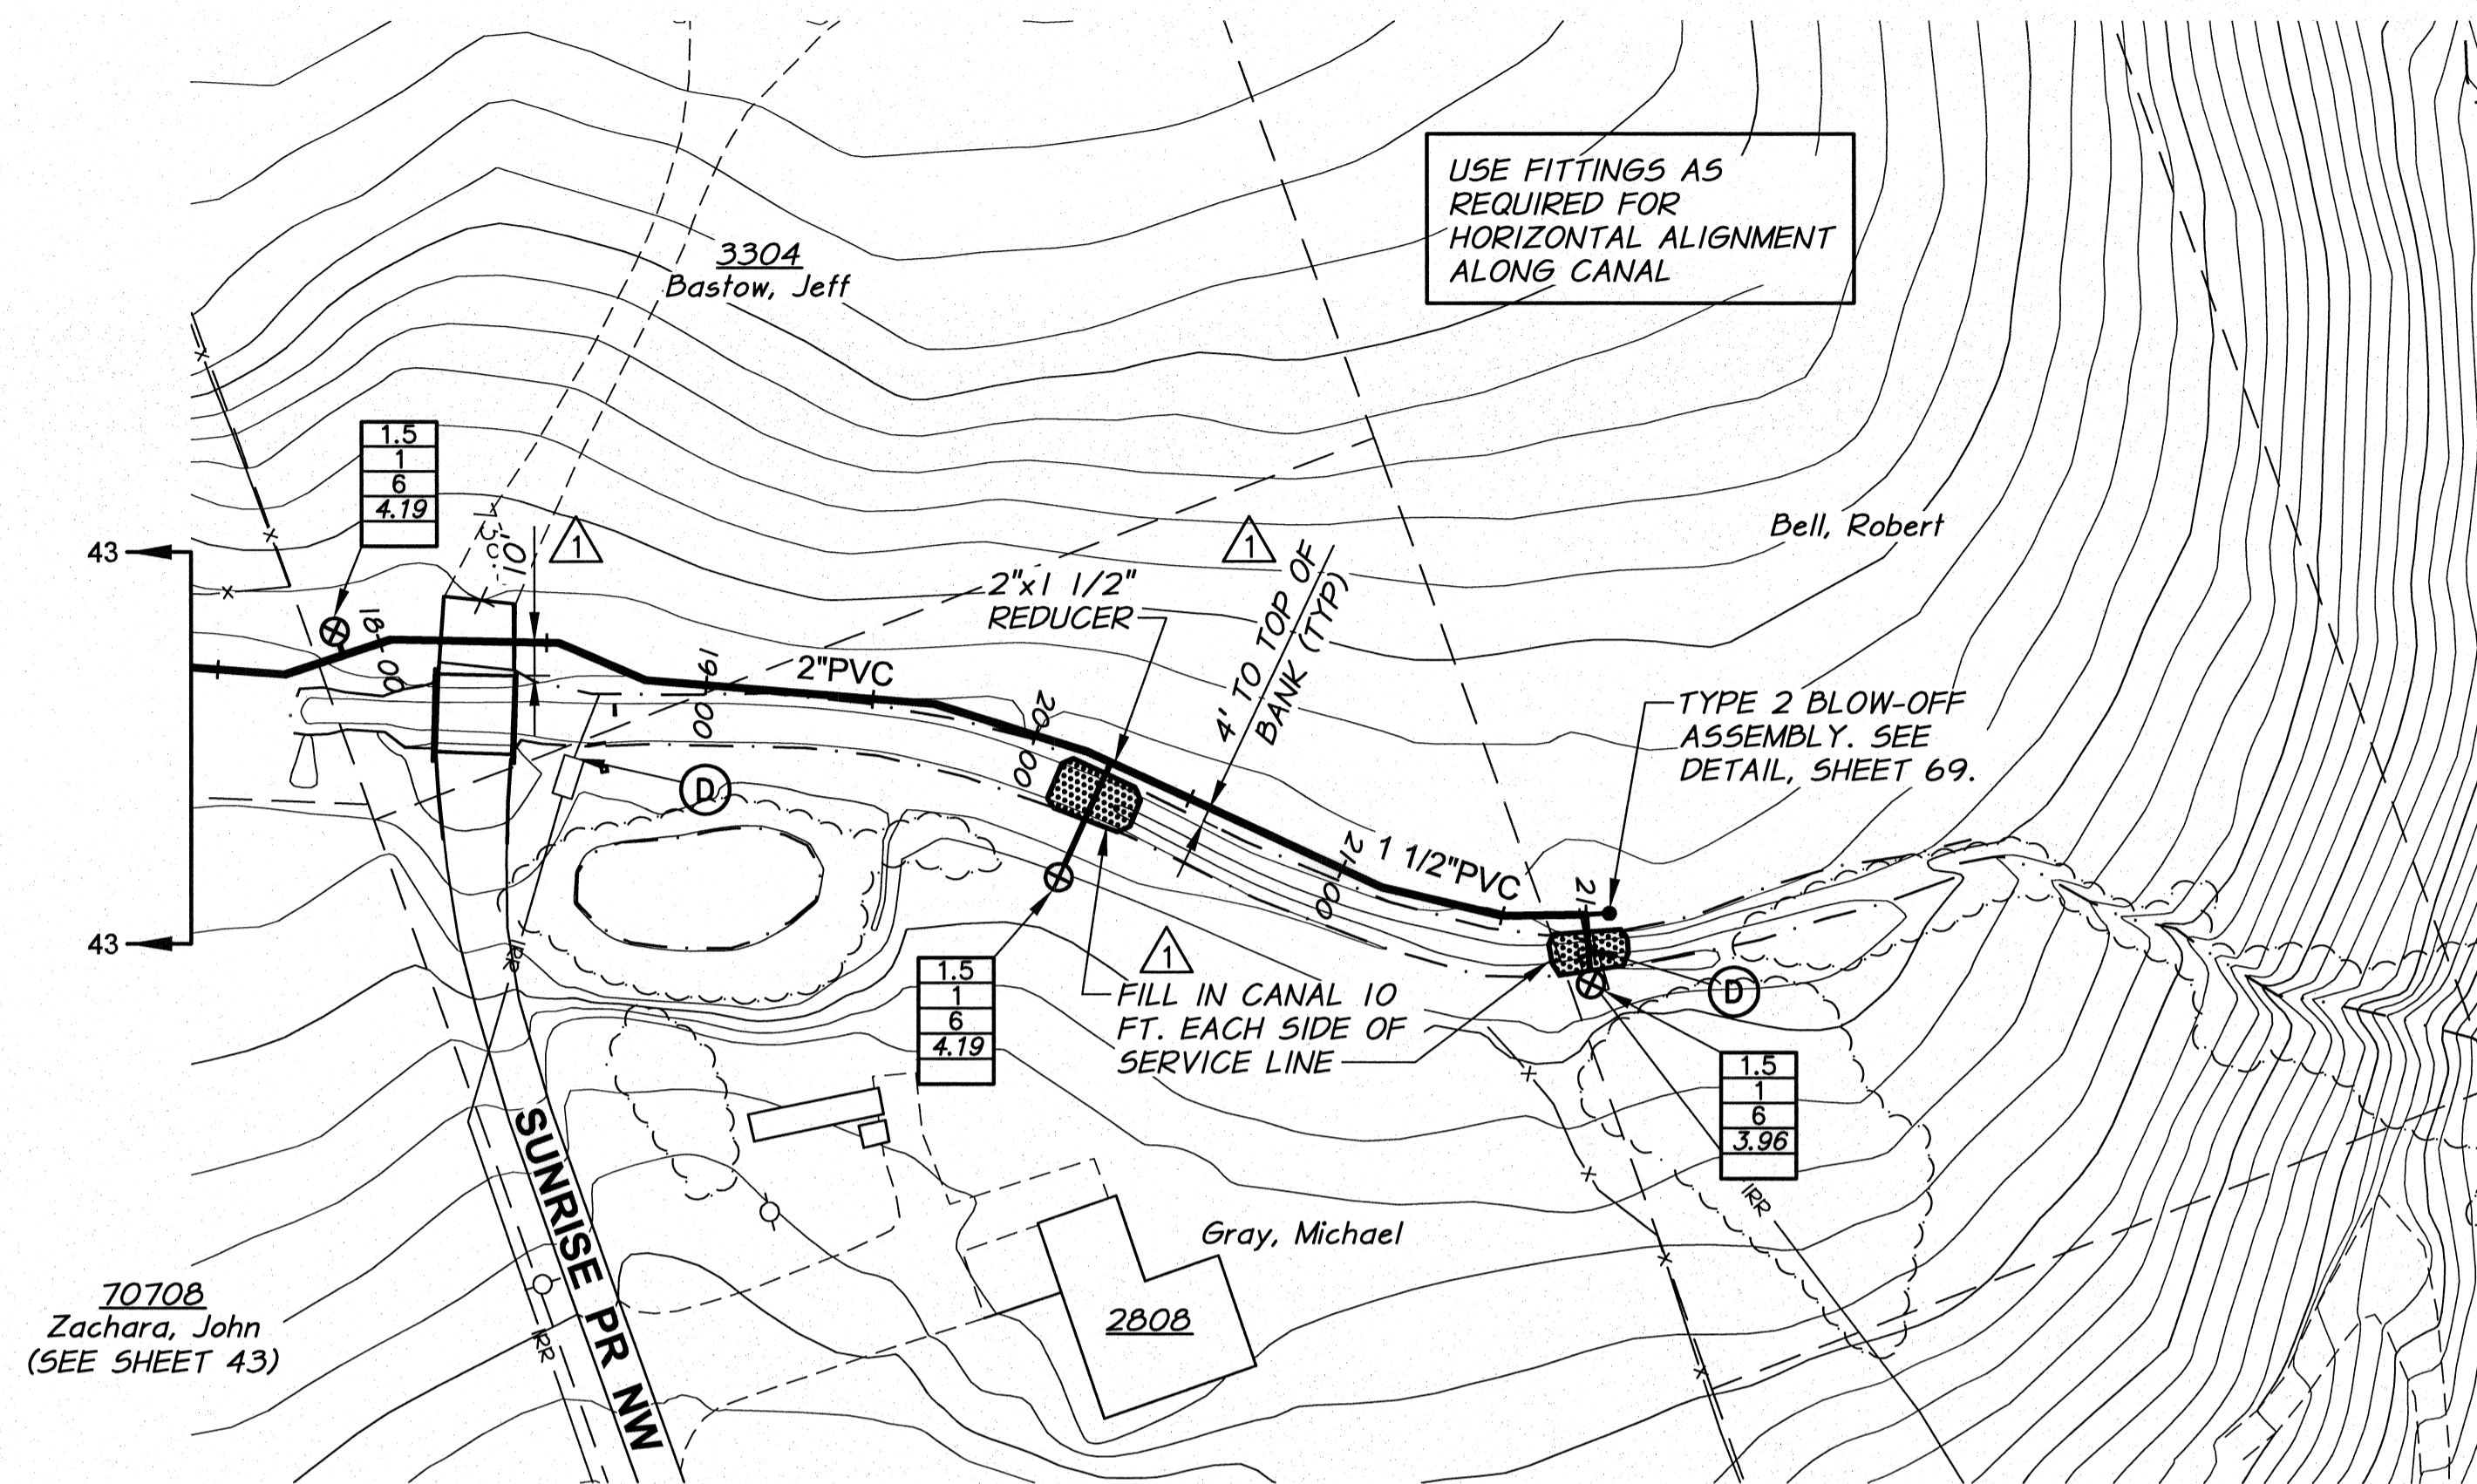


REVISION	ADDENDUM NO. 1	BY	R.H.	DATE	9/10
DESIGNED BY	R. HARRIS	XREFS:	TB-BID.dwg	JOB NUMBER	1199-336
DRAWN BY	E. ARNTZ	ACAD FILE:	North_B.dwg	DATE	2010
REVIEWED BY	J. HOLLOPETER	COPYRIGHT 2010 BY ANDERSON-PERRY & ASSOC., INC.			

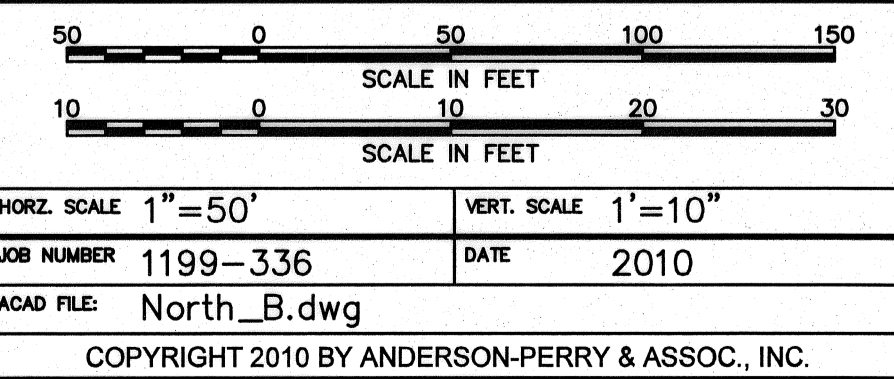

**RECORD DRAWINGS**

These record drawings have been prepared, in part, on the basis of information compiled and furnished by others. They may contain some discrepancies and omissions, and do not necessarily represent "exact" field conditions. The Owner and the Engineer accept no responsibility for their accuracy.

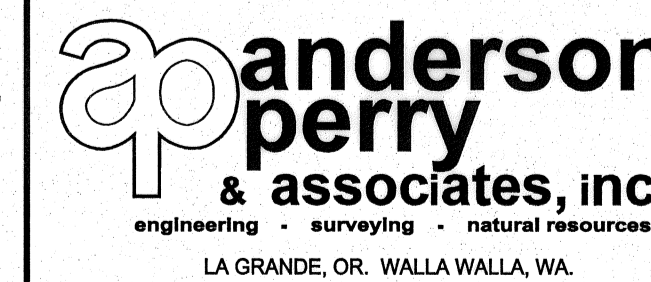

**BENTON IRRIGATION DISTRICT  
IRRIGATION SYSTEM IMPROVEMENTS  
PHASE 2A**

**NORTH - MORGAN TO SUNRISE PIPING  
STA. 17+00 TO STA. 21+75**

SHEET

**44**