

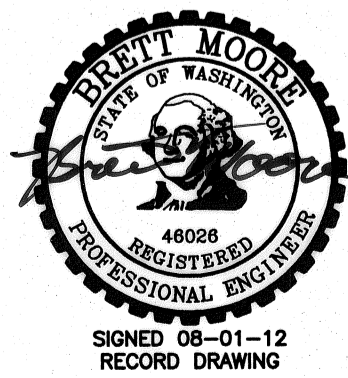


WORK ITEMS

- (B) EXISTING IRRIGATION CONTROL STRUCTURE TO BE REMOVED.
- (C) EXISTING IRRIGATION LINE ALONG ALIGNMENT TO BE ABANDONED. REMOVE AND PLUG AS REQUIRED FOR NEW LINE INSTALLATION.

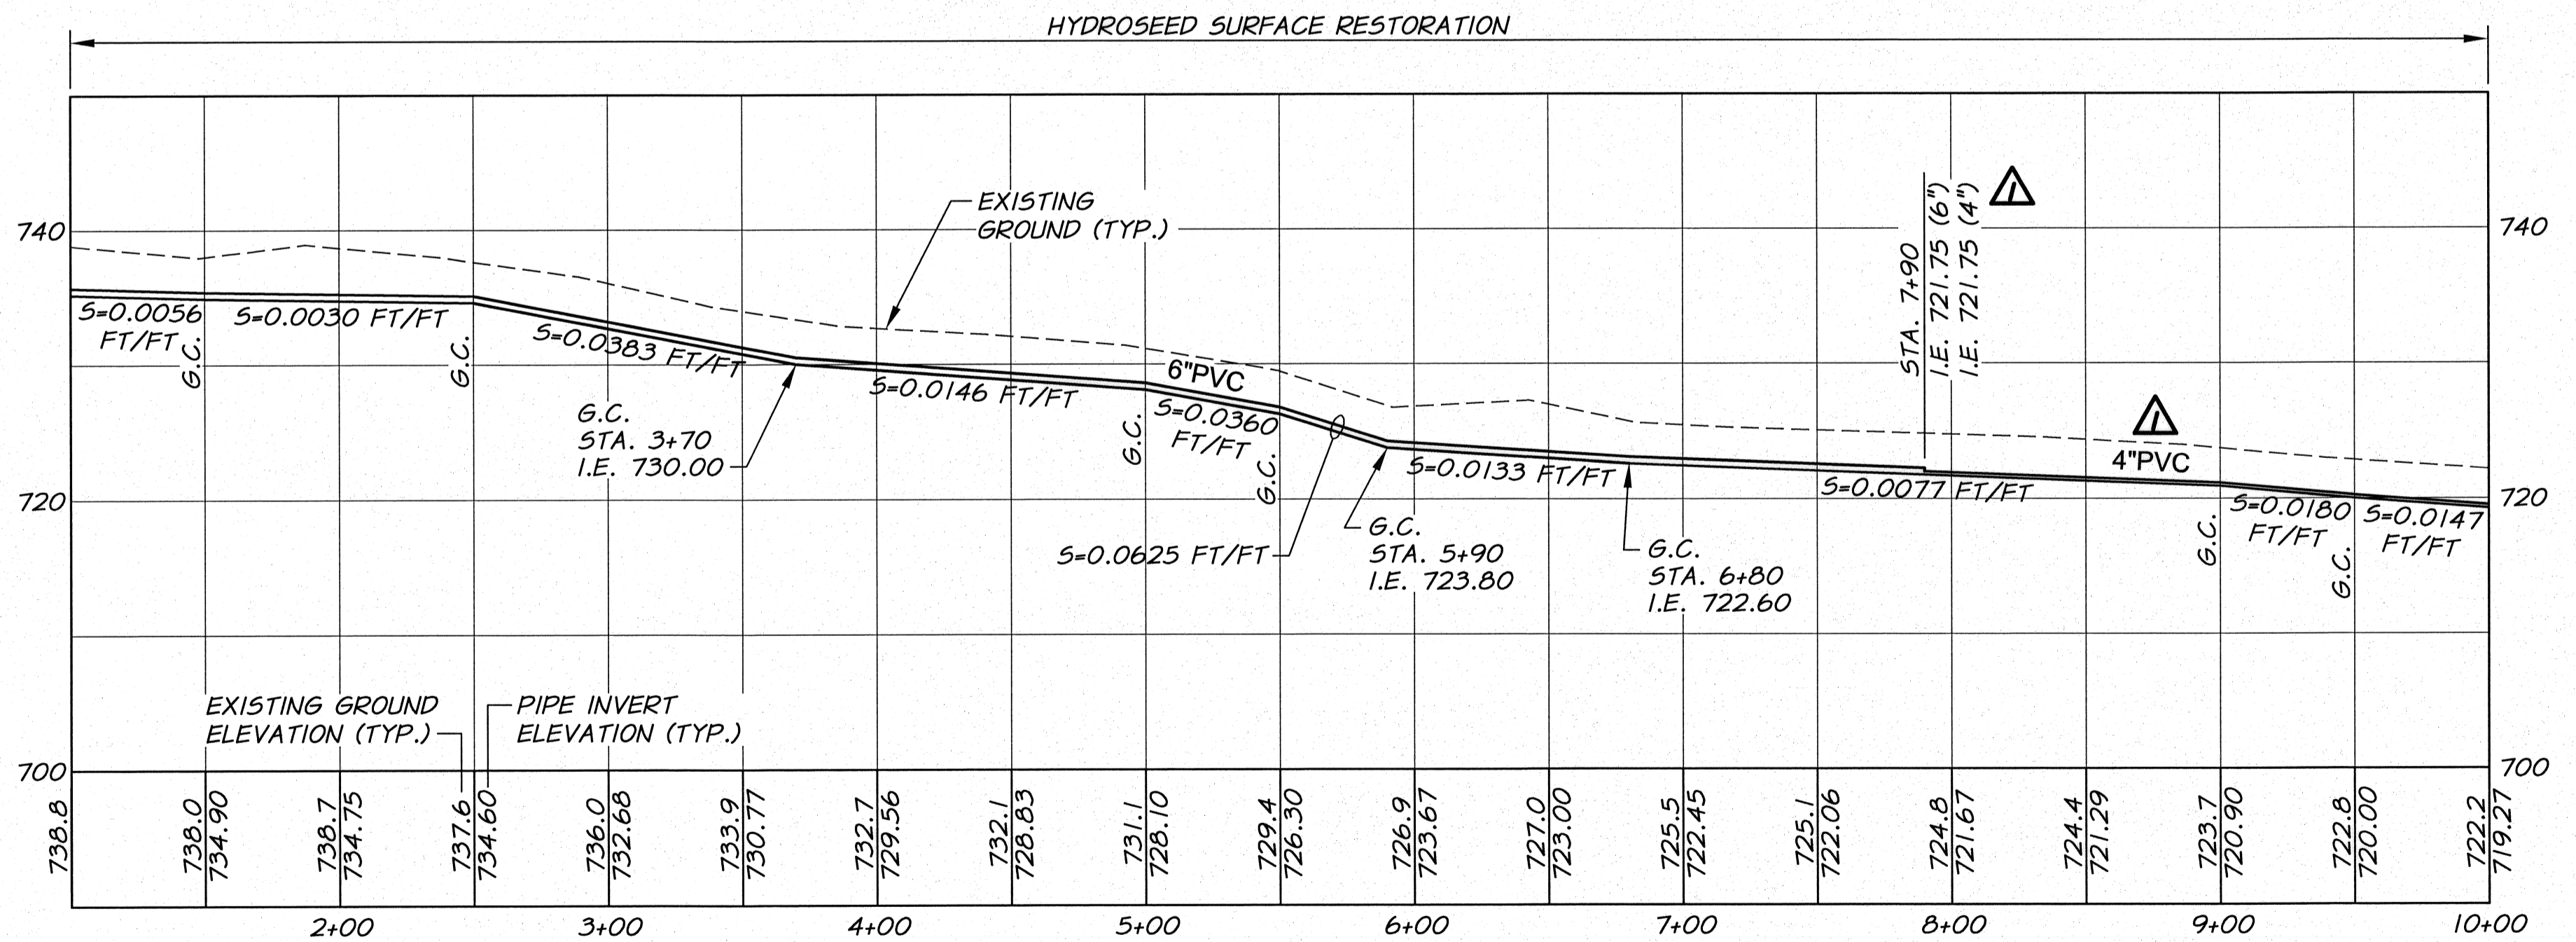


REVISION		BY		DATE	
RECORD DRAWING		E.H.		4/12	
DESIGNED BY	R. HARRIS	XREFS:	TP-BID.dwg	JOB NUMBER	1199-336
DRAWN BY	E. ARNTZ	ACAD FILE:	North_C.dwg	DATE	2010
REVIEWED BY	J. HOLLOPETER	COPYRIGHT 2010 BY ANDERSON-PERRY & ASSOC., INC.			

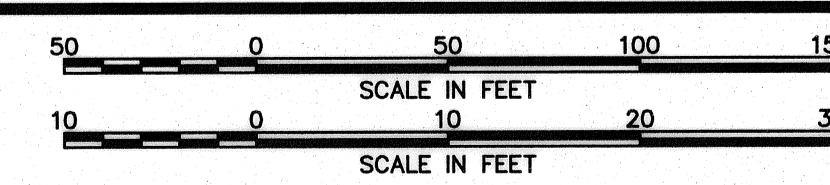

RECORD DRAWINGS

These record drawings have been prepared, in part, on the basis of information compiled and furnished by others. They may contain some discrepancies and omissions, and do not necessarily represent "exact" field conditions. The Owner and the Engineer accept no responsibility for their accuracy.

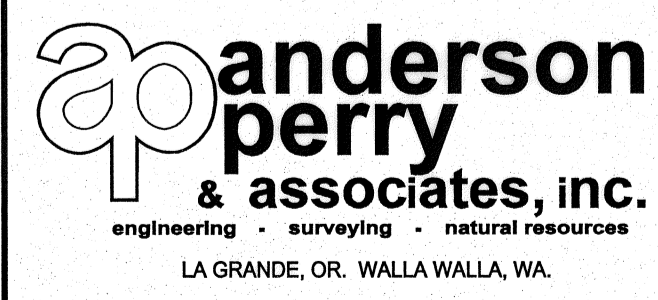

**BENTON IRRIGATION DISTRICT
IRRIGATION SYSTEM IMPROVEMENTS
PHASE 2A**

NORTH - N. WHAN ROAD PIPING
STA. 0+10 TO STA. 10+00

SHEET
45