


RECORD DRAWING		BY	E.H.	DATE	4/12
DESIGNED BY	R. HARRIS	XREFS:	TB-BID.dwg		
DRAWN BY	E. ARNTZ	JOB NUMBER	1199-336		
REVIEWED BY	J. HOLLOPETER	ACAD FILE:	North_C.dwg		
		DATE	2010		
COPYRIGHT 2010 BY ANDERSON-PERRY & ASSOC., INC.					

50 0 50 100 150	
SCALE IN FEET	
10 0 20 30	
SCALE IN FEET	
HORIZ. SCALE	1"=50'
VERT. SCALE	1"=10"

RECORD DRAWINGS
 These record drawings have been prepared, in part, on the basis of information compiled and furnished by others. They may contain some discrepancies and omissions, and do not necessarily represent "exact" field conditions. The Owner and the Engineer accept no responsibility for their accuracy.

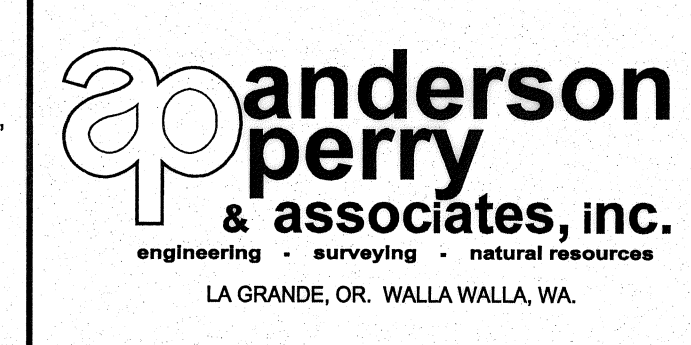

BENTON IRRIGATION DISTRICT
 IRRIGATION SYSTEM IMPROVEMENTS
 PHASE 2A
 NORTH - W. MORGAN ROAD PIPING
 PUMPSTATION TO STA. 14+00

SHEET
47