



RECORD DRAWING		E.H. 4/12	
DESIGNED BY R. HARRIS	XREFS: TB-BID.dwg	JOB NUMBER 1199-336	DATE 2010
DRAWN BY E. ARNTZ		ACAD FILE: North_C.dwg	
REVIEWED BY J. HOLLOPETER		COPYRIGHT 2010 BY ANDERSON-PERRY & ASSOC., INC.	

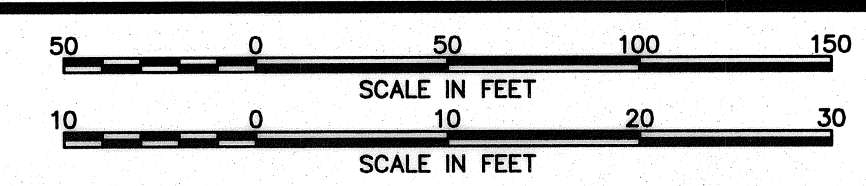

RECORD DRAWINGS
 These record drawings have been prepared, in part, on the basis of information compiled and furnished by others. They may contain some discrepancies and omissions, and do not necessarily represent "exact" field conditions. The Owner and the Engineer accept no responsibility for their accuracy.

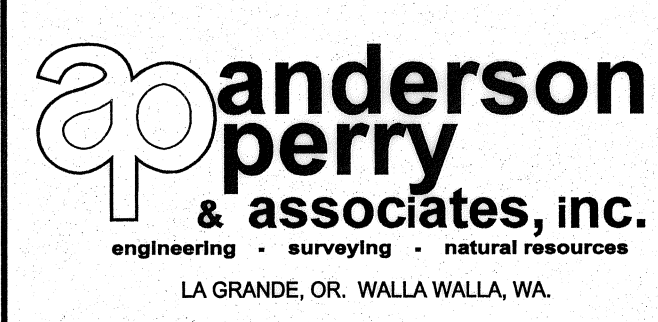

BENTON IRRIGATION DISTRICT
 IRRIGATION SYSTEM IMPROVEMENTS
 PHASE 2A
 NORTH - W. MORGAN ROAD PIPING
 STA. 14+00 TO STA. 27+00

SHEET
48