


**WORK ITEMS**


- (A) EXISTING IRRIGATION LINE ALONG OR CROSSING ALIGNMENT. EXACT LOCATION UNKNOWN. REMOVE AND PLUG AS REQUIRED FOR NEW LINE INSTALLATION.

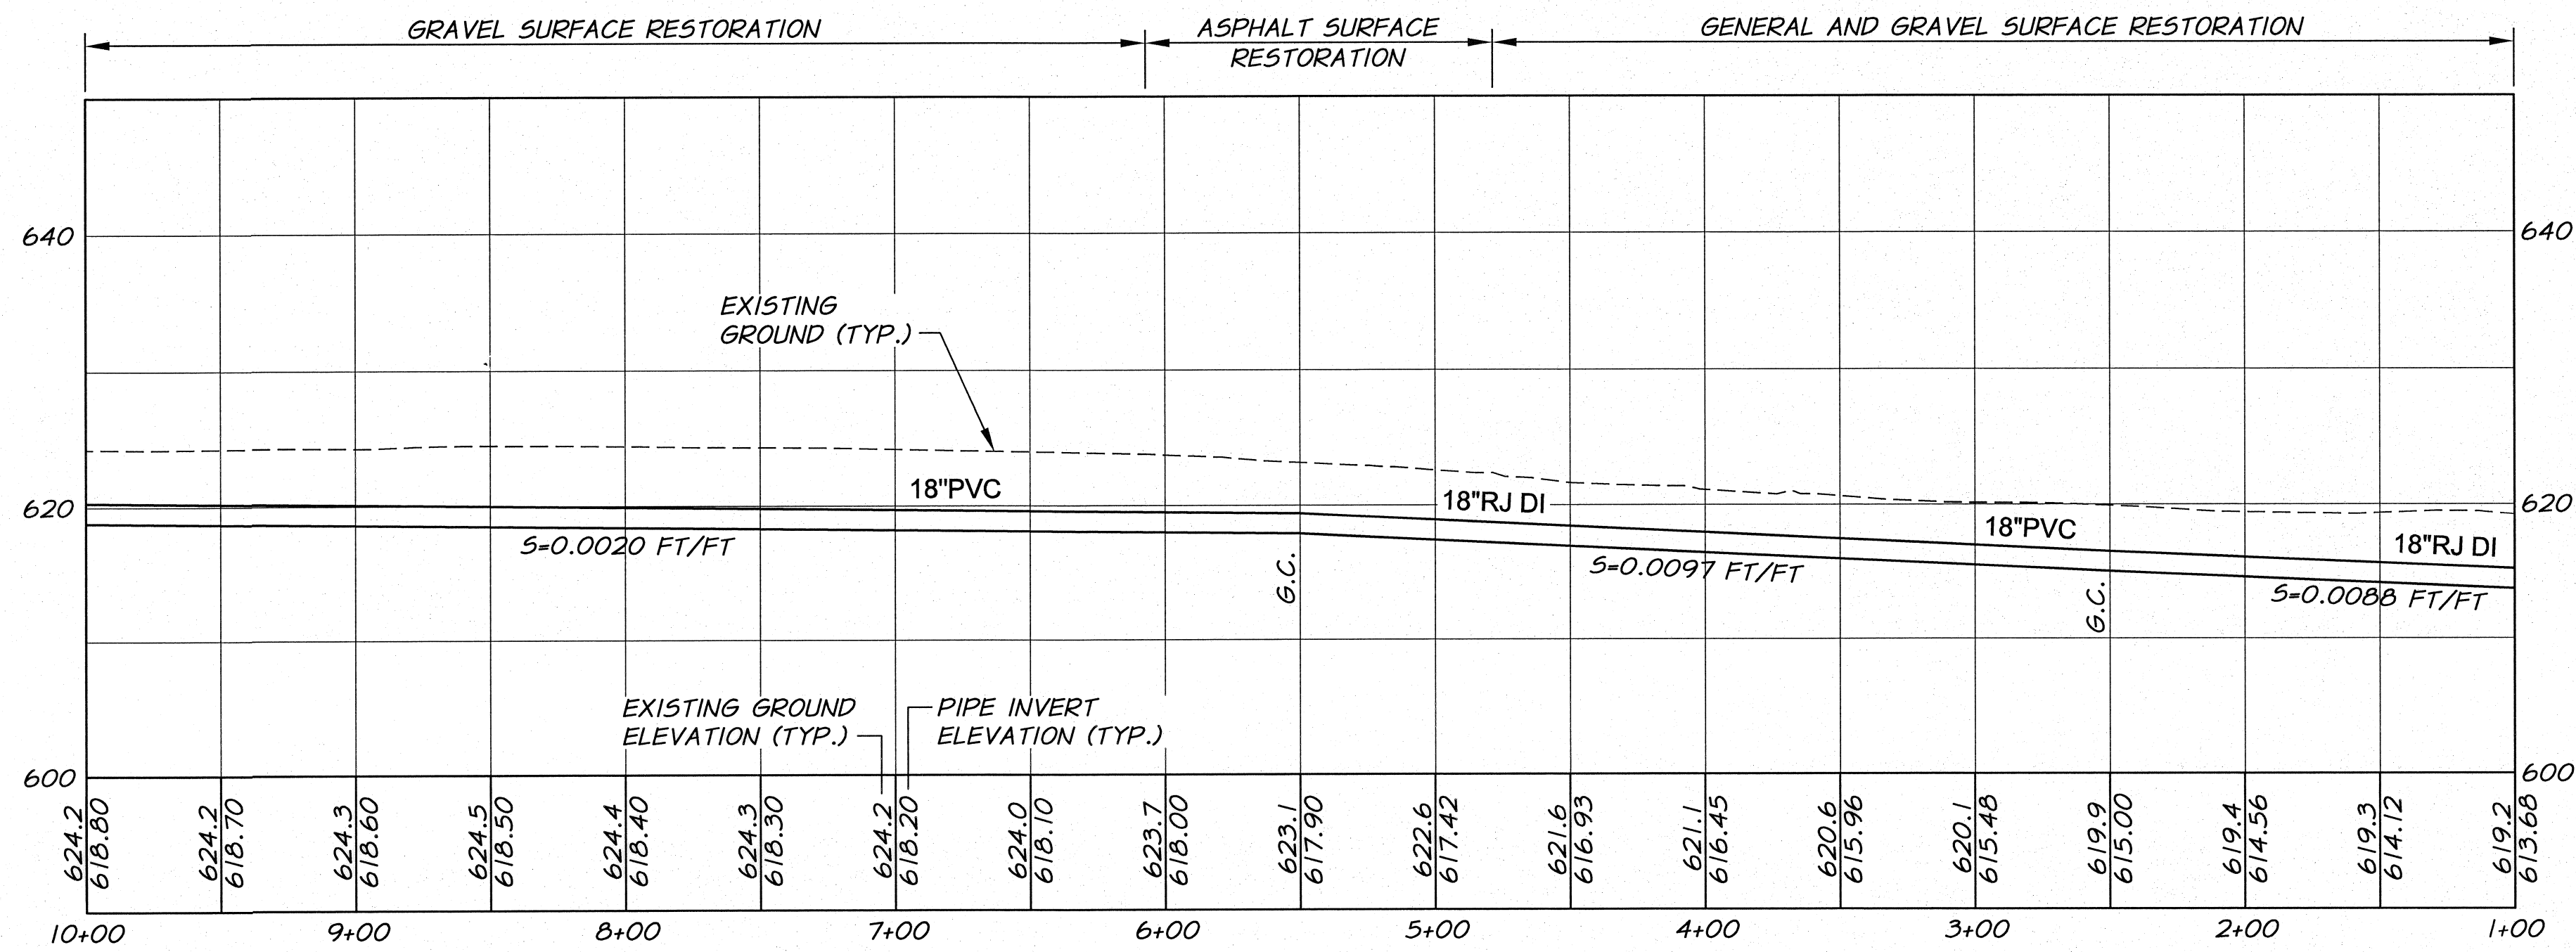

RECORD DRAWING		BY	E.H.	DATE	4/12
DESIGNED BY	R. HARRIS	XREFS: TB-BID.dwg			
DRAWN BY	P. RICHARDSON				
REVIEWED BY	J. HOLLOPETER				

JOB NUMBER	1199-336	DATE	2010
ACAD FILE	HighlandSouth.dwg	COPYRIGHT 2010 BY ANDERSON-PERRY & ASSOC., INC.	

**RECORD DRAWINGS**  
 These record drawings have been prepared, in part, on the basis of information compiled and furnished by others. They may contain some discrepancies and omissions, and do not necessarily represent "exact" field conditions. The Owner and the Engineer accept no responsibility for their accuracy.

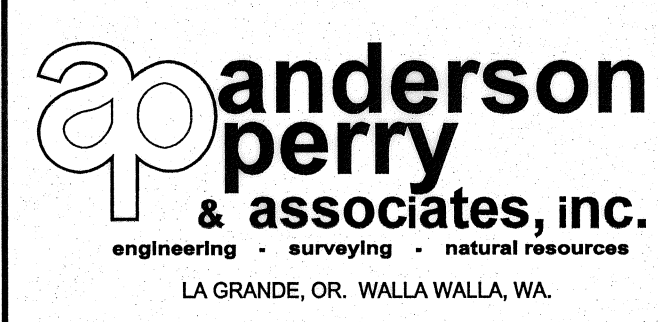

**BENTON IRRIGATION DISTRICT**  
 IRRIGATION SYSTEM IMPROVEMENTS  
 PHASE 2A  
 HIGHLAND SOUTH PIPING  
 STA. 1+00 TO STA. 10+00

SHEET  
**50**