



PLAN
1"=10'

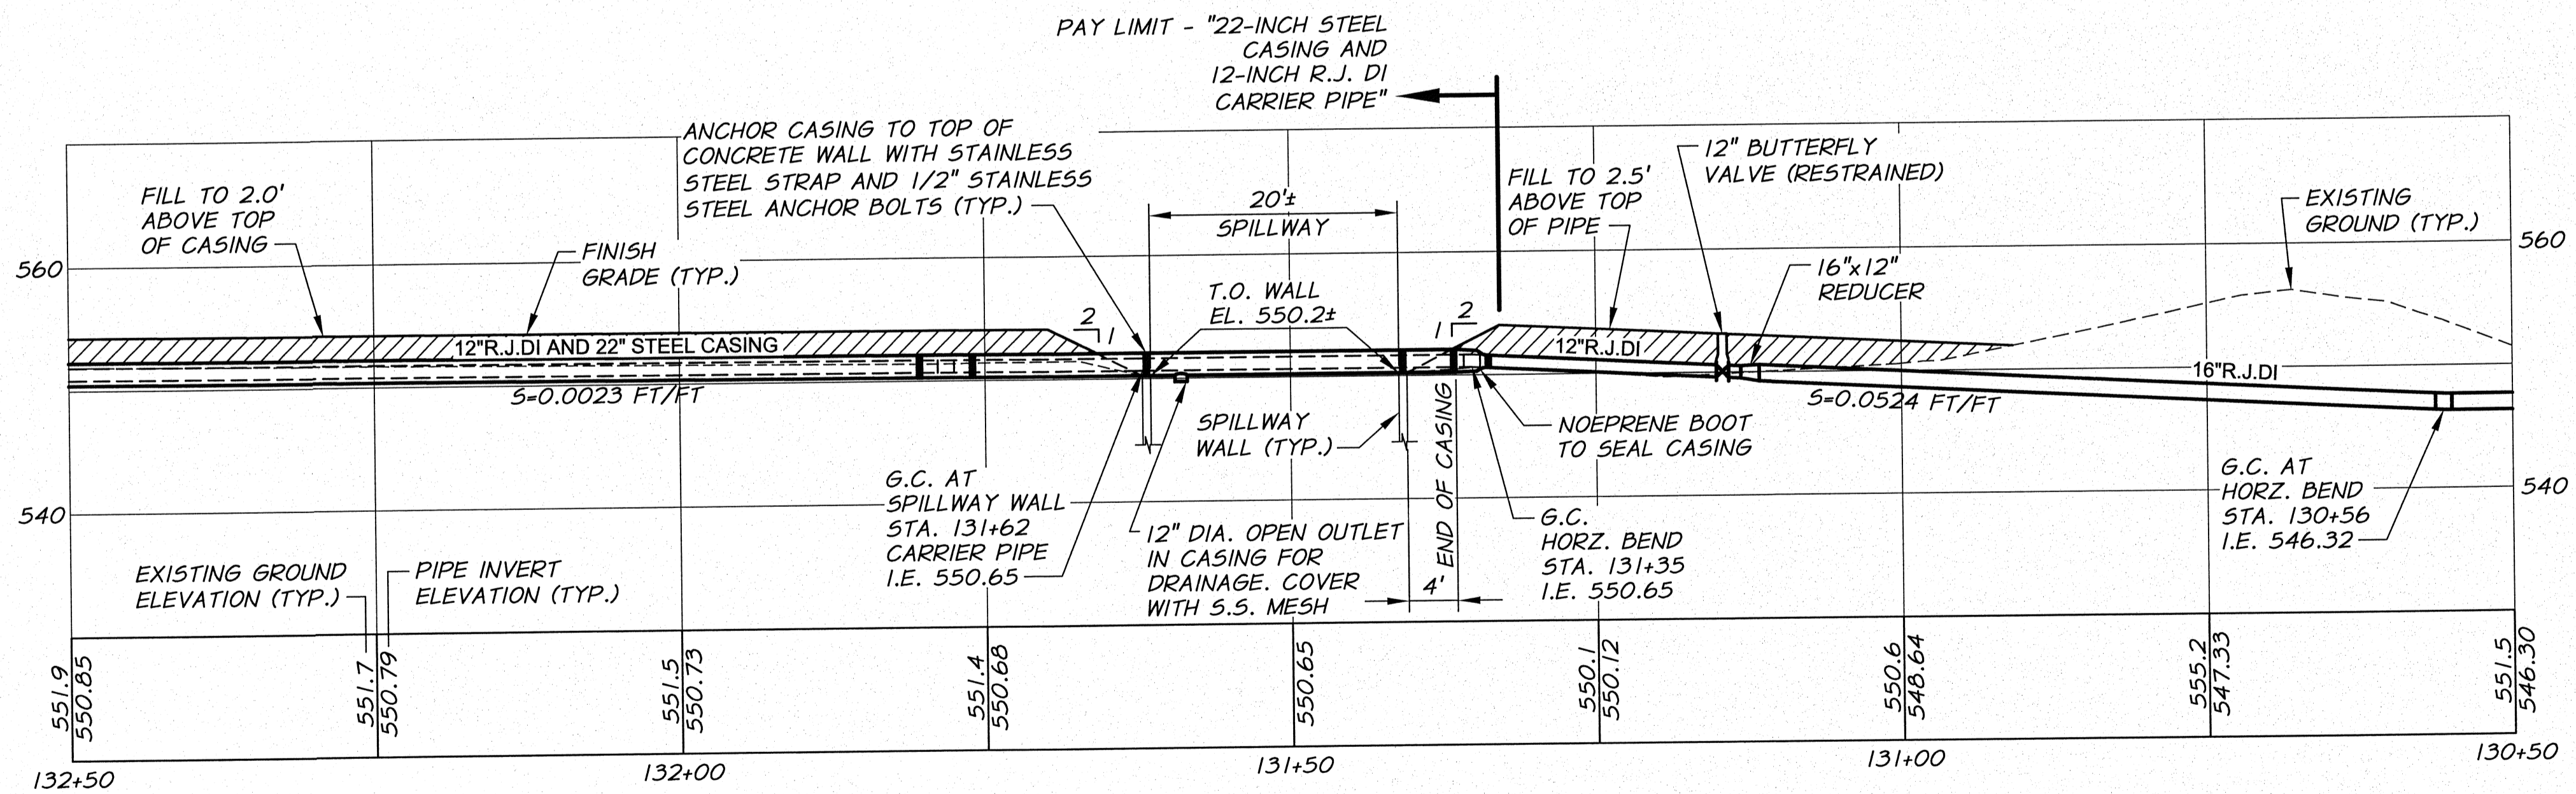


PROFILE
1"=10' HORZ.
1"=10' VERT.

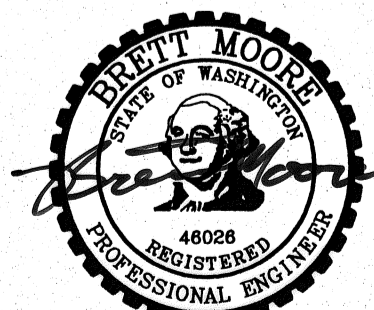


SIGNED 06-04-12
RECORD DRAWINGS

REVISION		BY	DATE	HORIZ. SCALE 1"=10'	VERT. SCALE 1"=10'
DESIGNED BY R. HARRIS		XREFS: TB-BID.dwg		JOB NUMBER 1199-336	DATE 2011
DRAWN BY D. CHRISTMAN		ACAD FILE SpillwayXing.dwg		COPYRIGHT 2011 BY ANDERSON-PERRY & ASSOC., INC.	
REVIEWED BY B. MOORE					

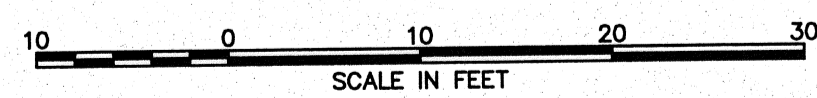

RECORD DRAWINGS

These record drawings have been prepared, in part, on the basis of information compiled and furnished by others. They may contain some discrepancies and omissions, and do not necessarily represent "exact" field conditions. The Owner and the Engineer accept no responsibility for their accuracy.

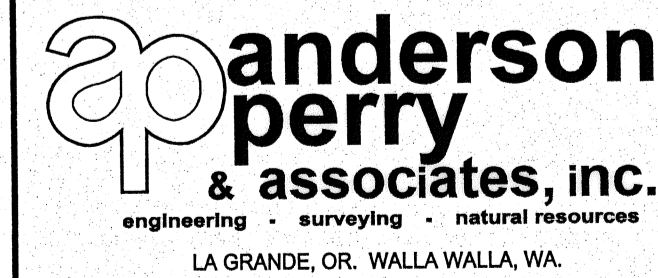


BENTON IRRIGATION DISTRICT
IRRIGATION SYSTEM IMPROVEMENTS
PHASE 2B


CHANDLER POWER STATION CROSSING
PLAN AND PROFILE

SHEET


35

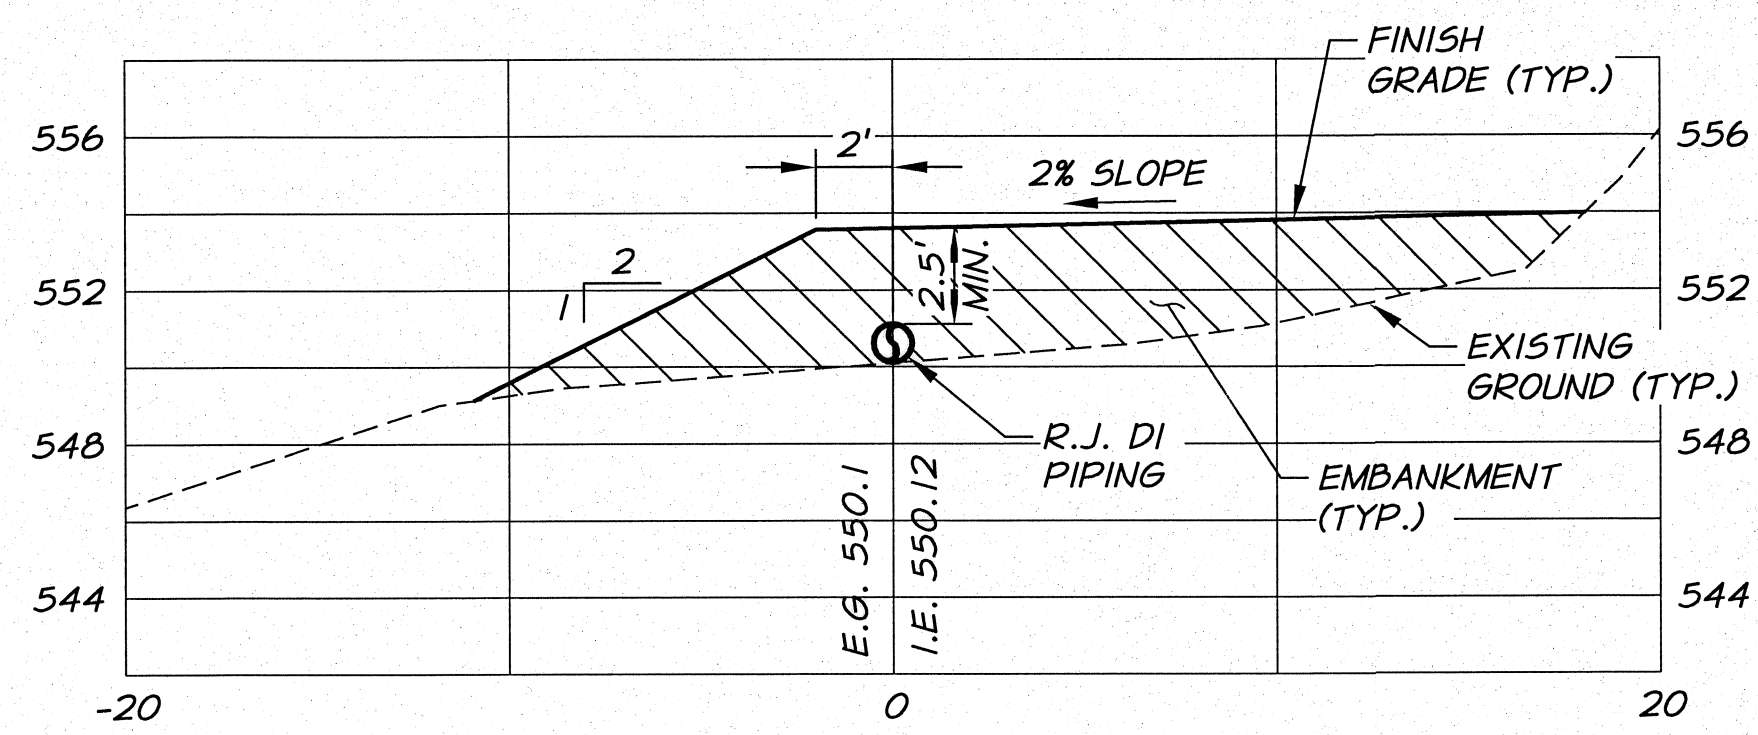




SECTION A
STA. 131+25
1"=5'

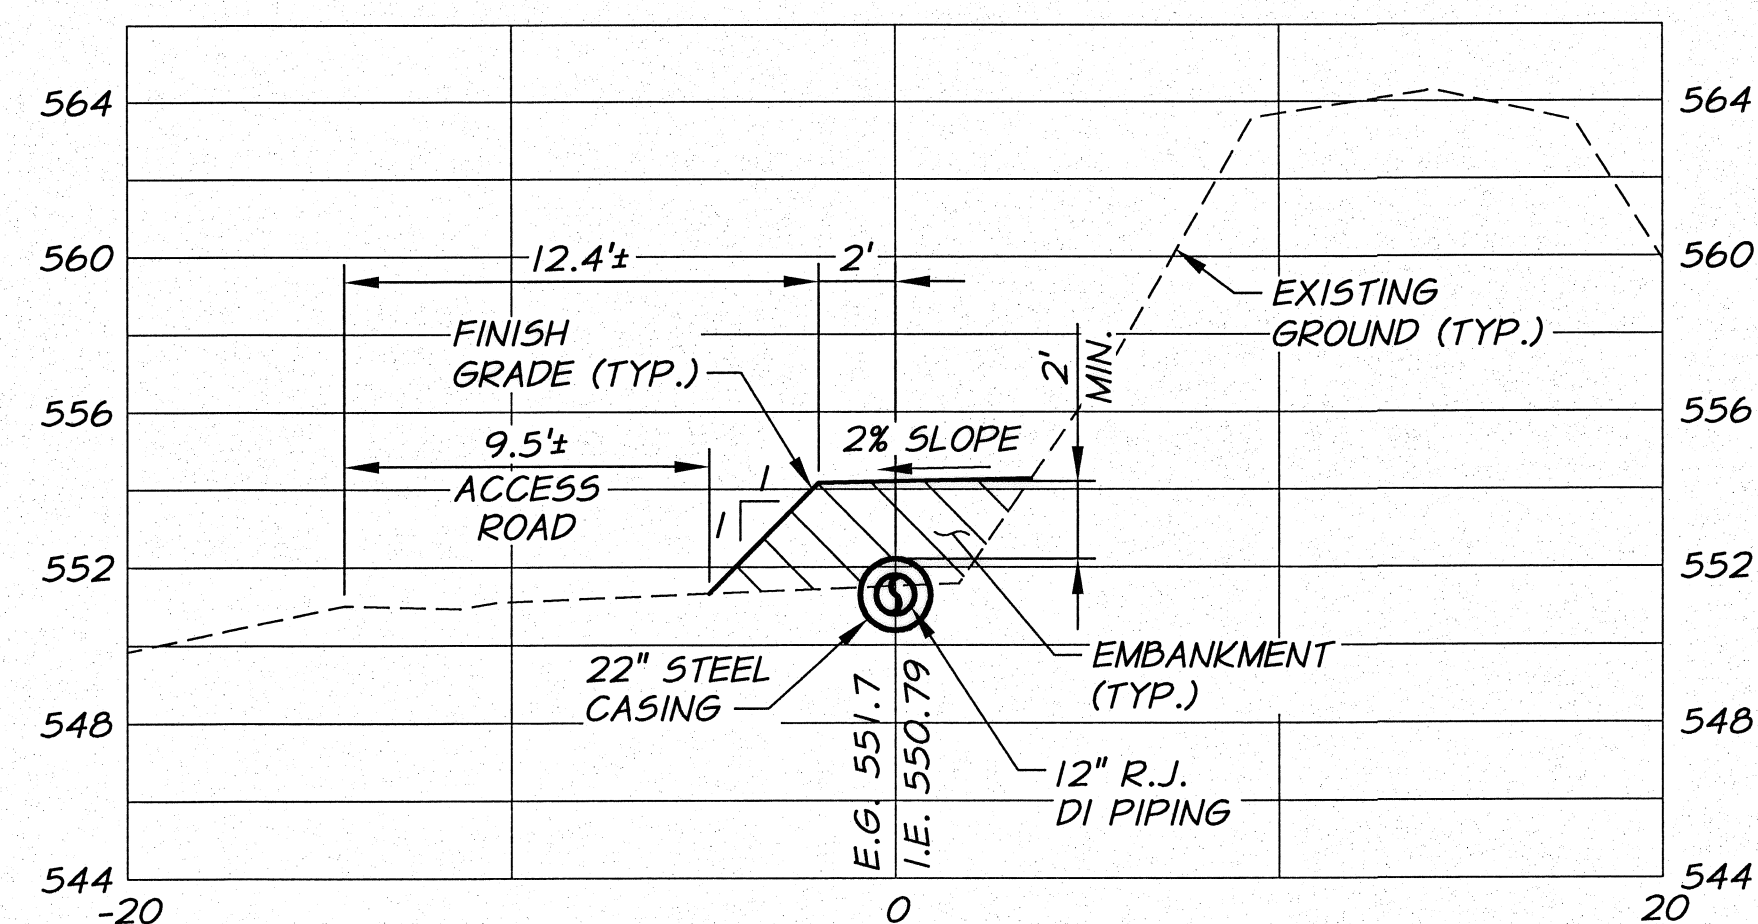

SECTION B
STA. 132+25
1"=5'

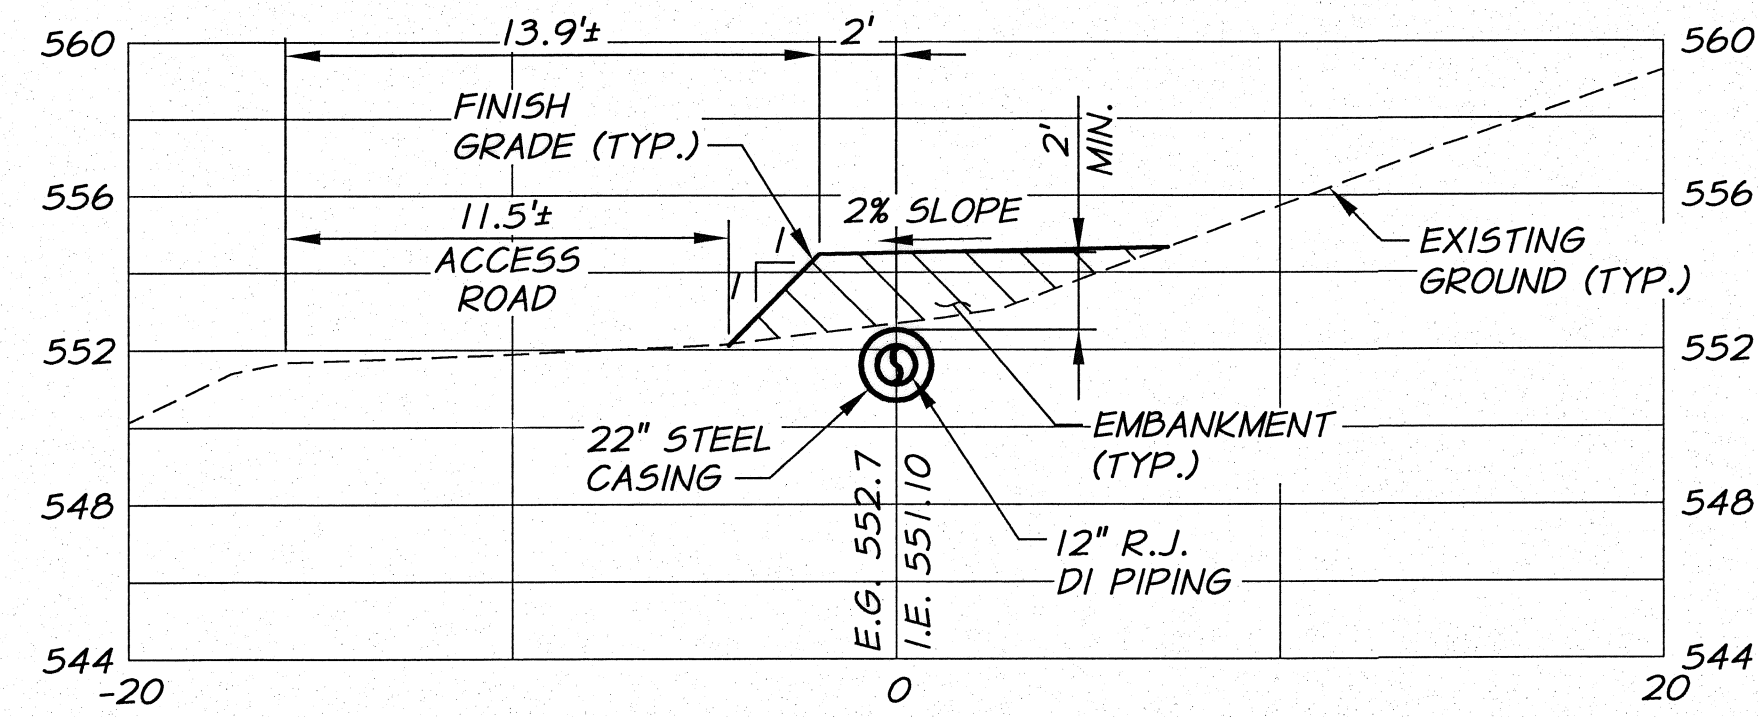

SECTION C
STA. 133+60
1"=5'

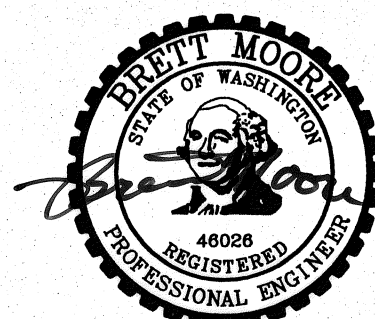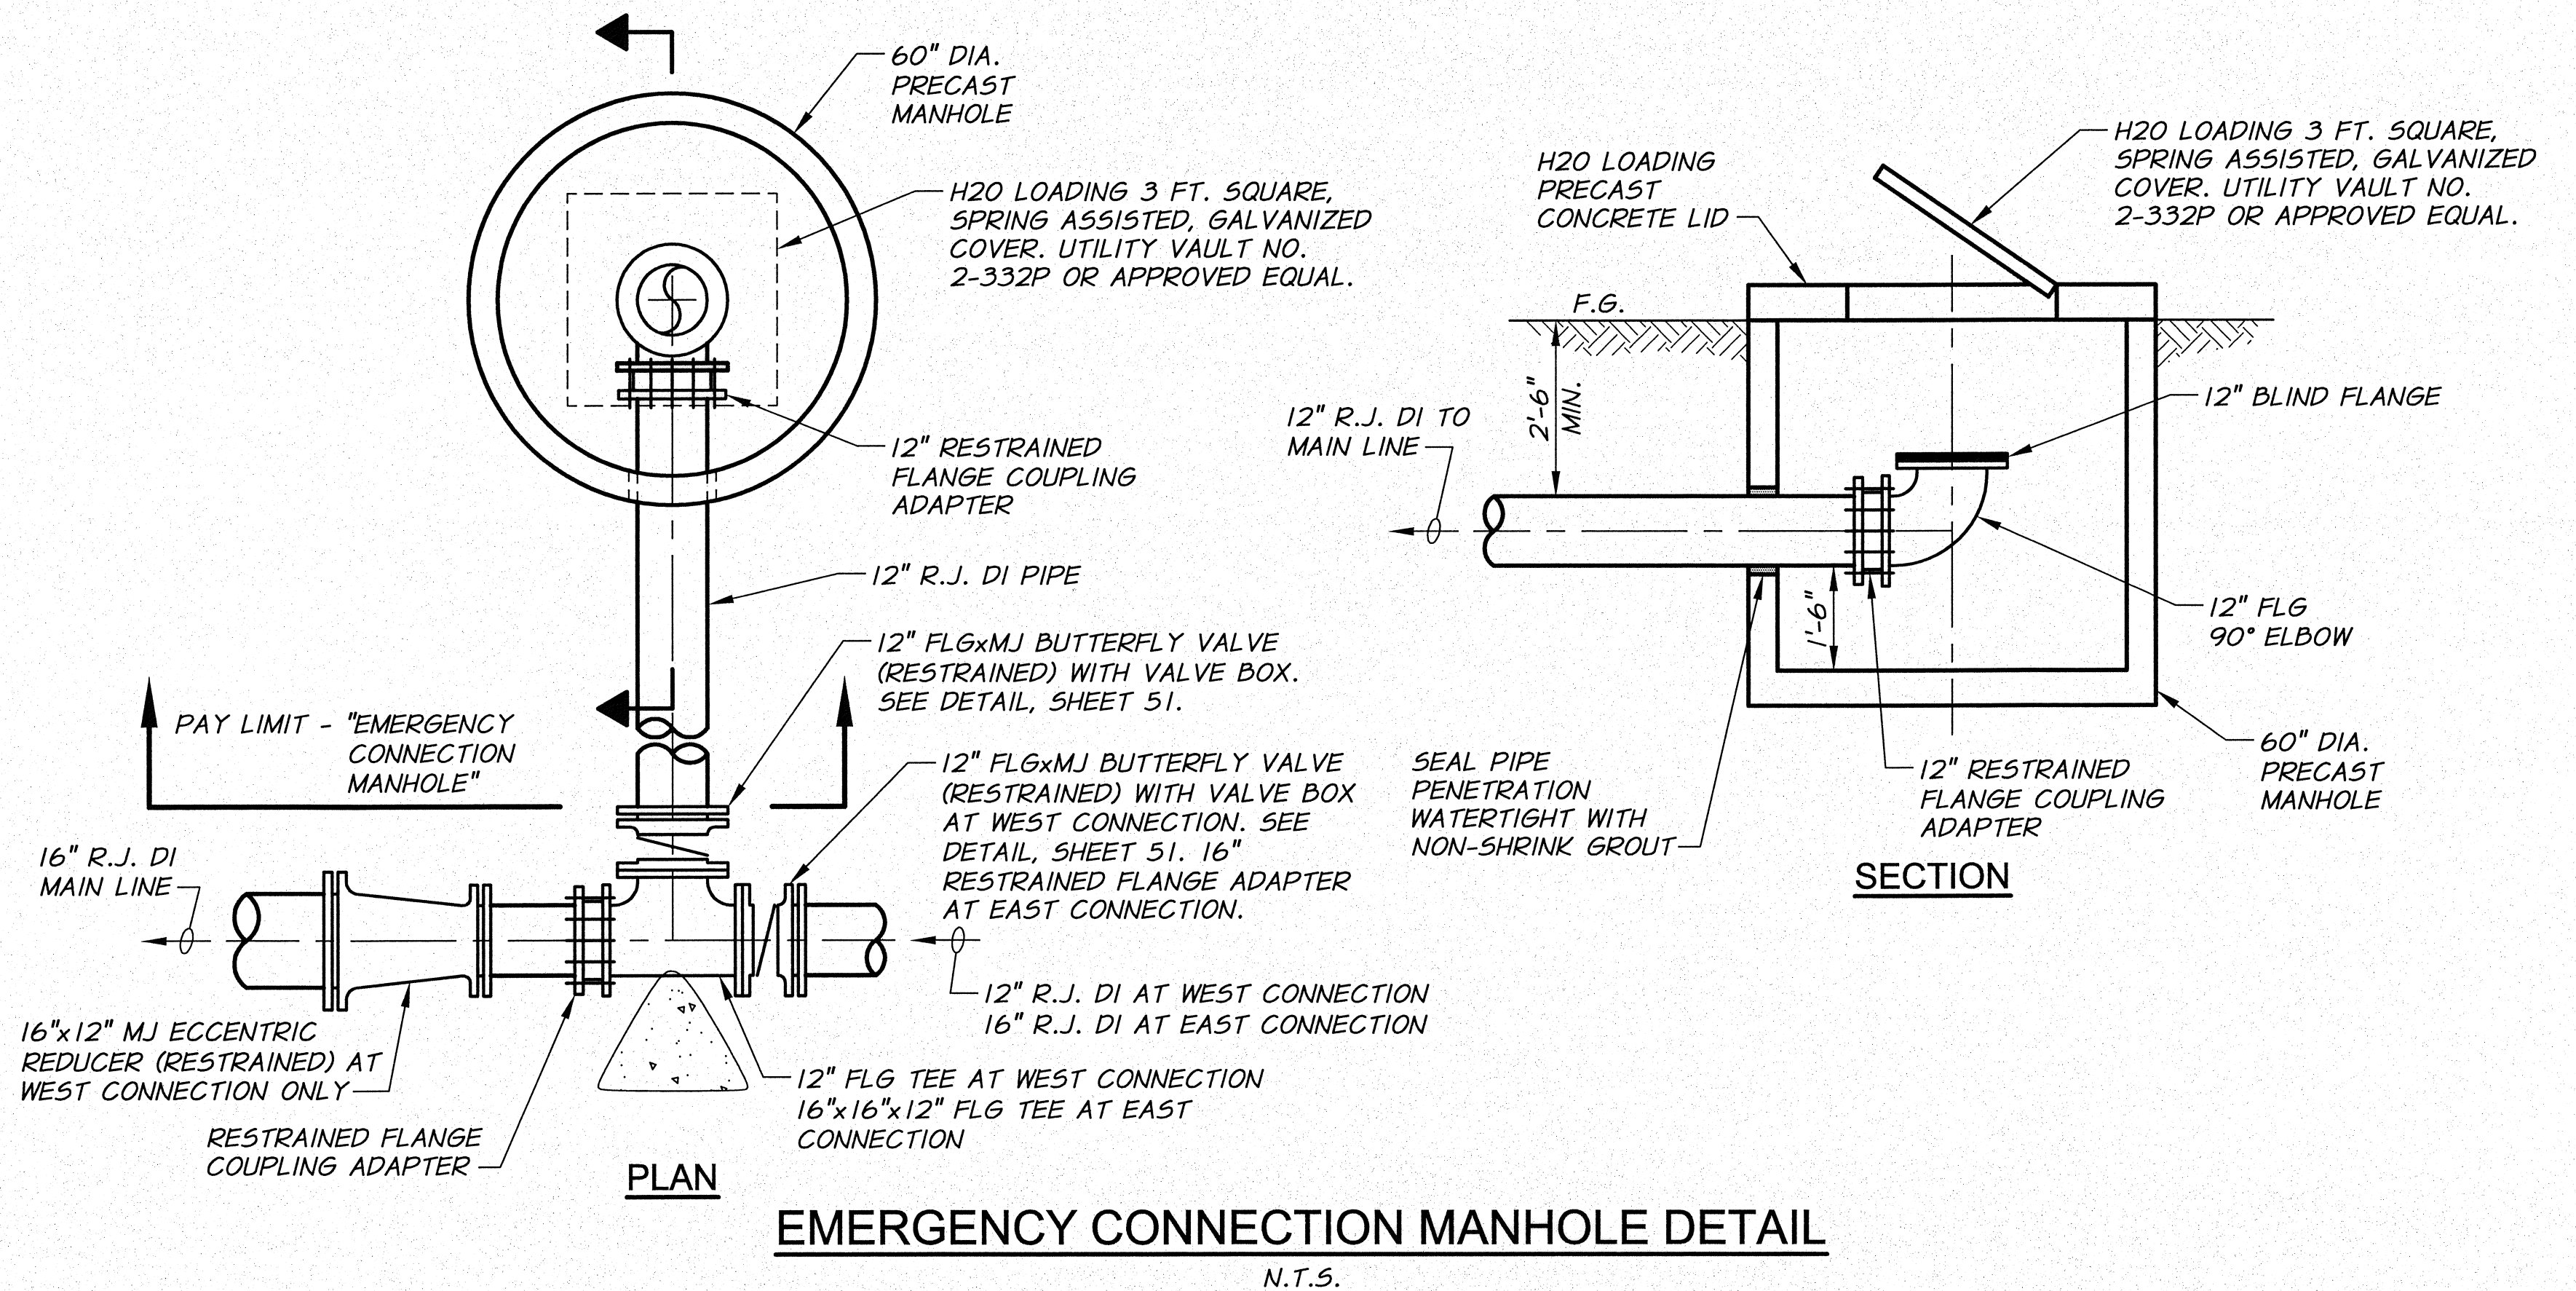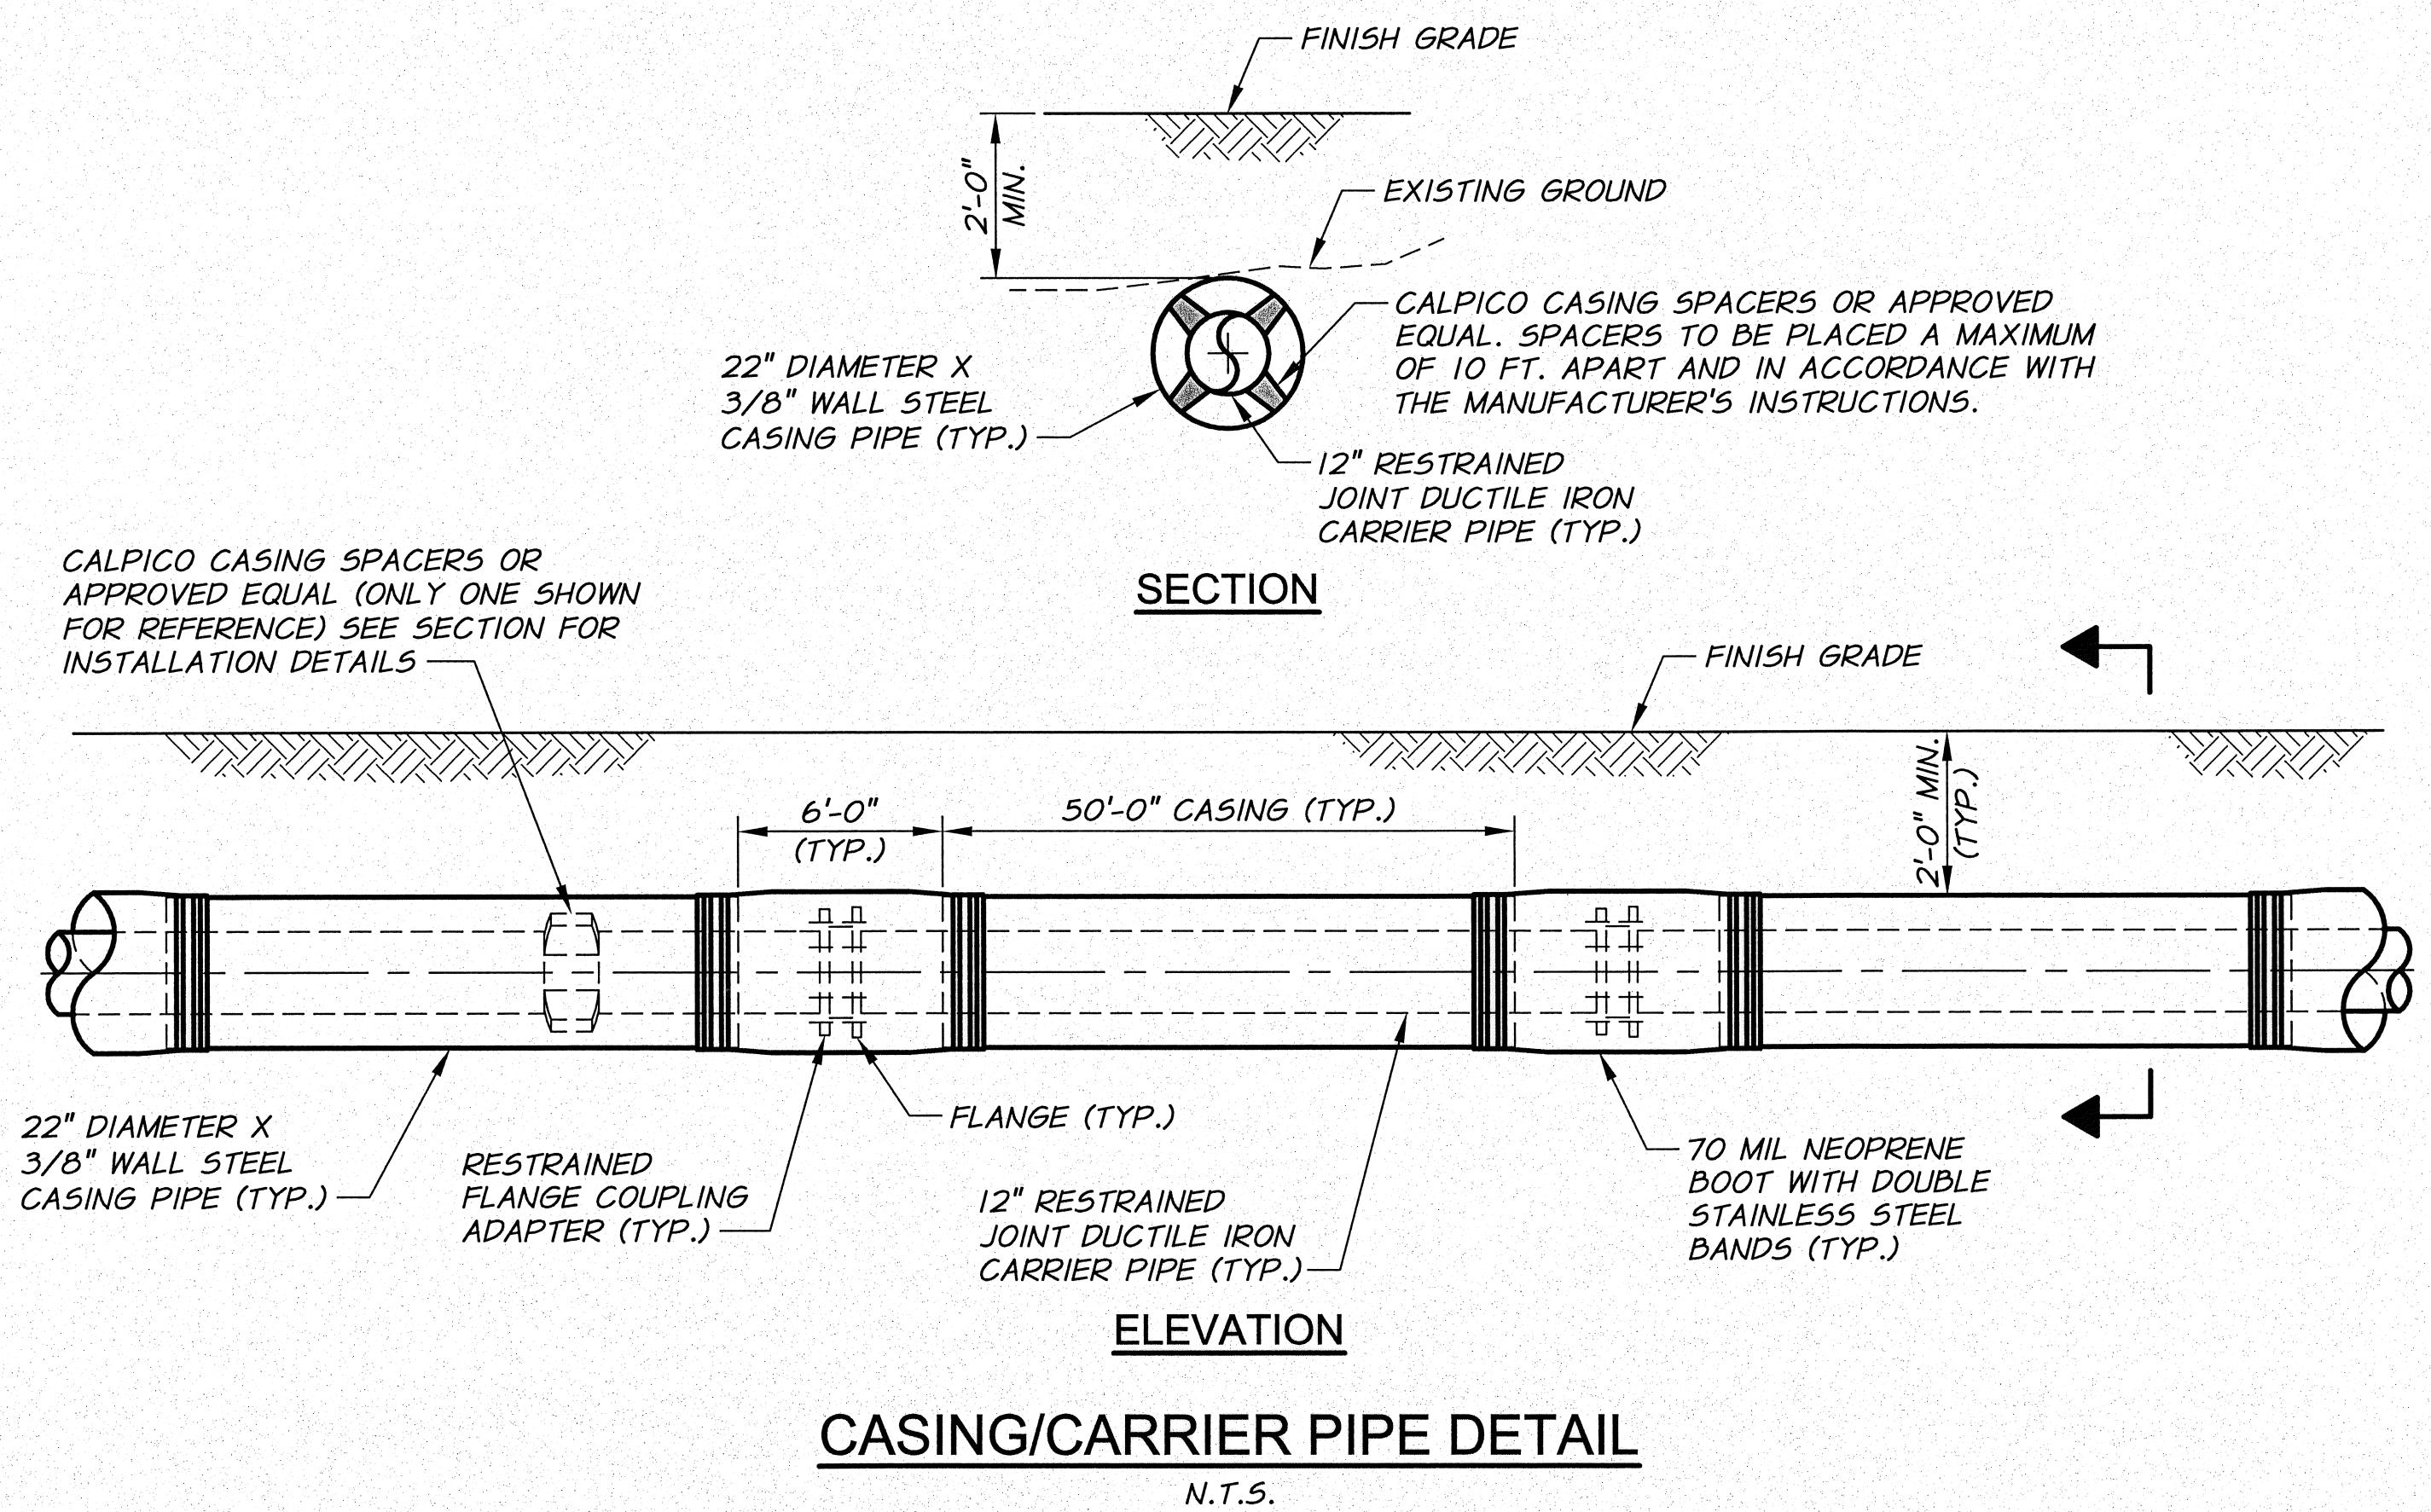


SIGNED 06-04-12
RECORD DRAWINGS

REVISION		BY	DATE	HORIZ. SCALE	AS NOTED	VERT. SCALE	
DESIGNED BY		R. HARRIS		JOB NUMBER	1199-336	DATE	2011
DRAWN BY		D. CHRISTMAN		ACAD FILE	SpillwayXing.dwg		
REVIEWED BY		B. MOORE		COPYRIGHT 2011 BY ANDERSON-PERRY & ASSOC., INC.			

RECORD DRAWINGS

These record drawings have been prepared, in part, on the basis of information compiled and furnished by others. They may contain some discrepancies and omissions, and do not necessarily represent "exact" field conditions. The Owner and the Engineer accept no responsibility for their accuracy.

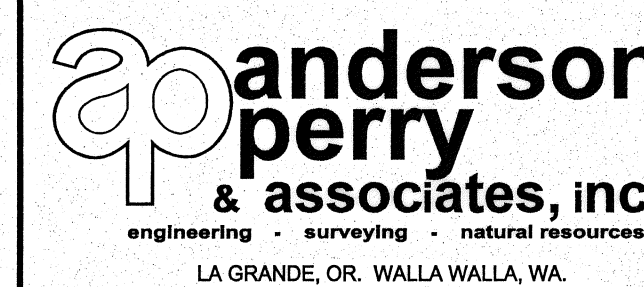


BENTON IRRIGATION DISTRICT
IRRIGATION SYSTEM IMPROVEMENTS
PHASE 2B

CHANDLER POWER STATION CROSSING
SECTIONS AND DETAILS


SHEET

36


ARCHIVED

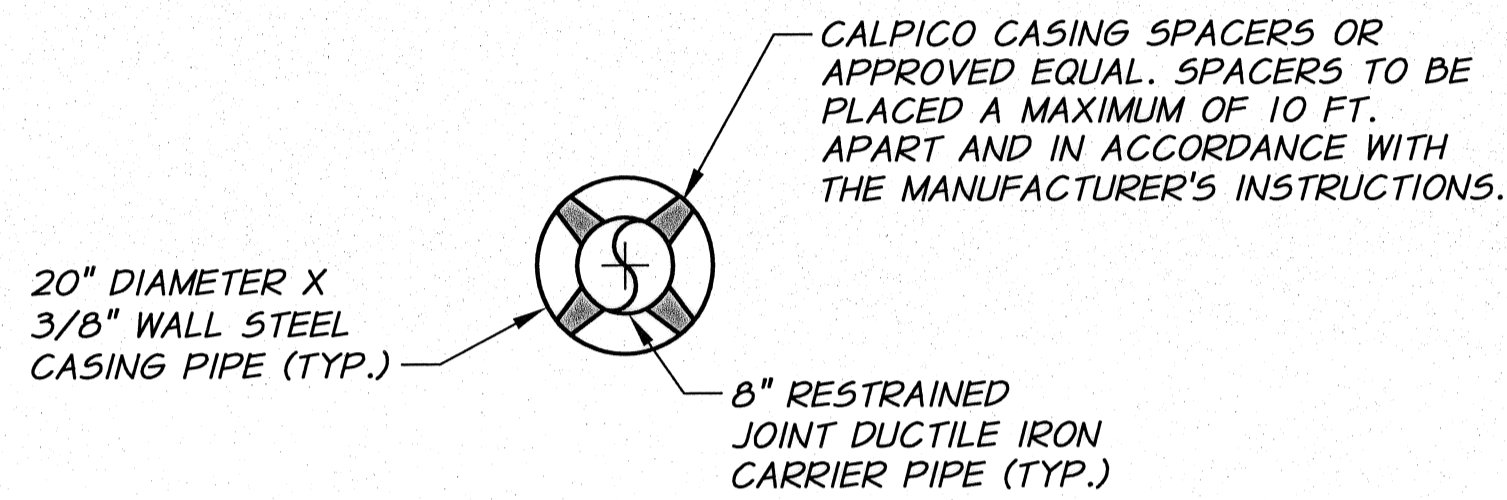


SECTION A
N.T.S.

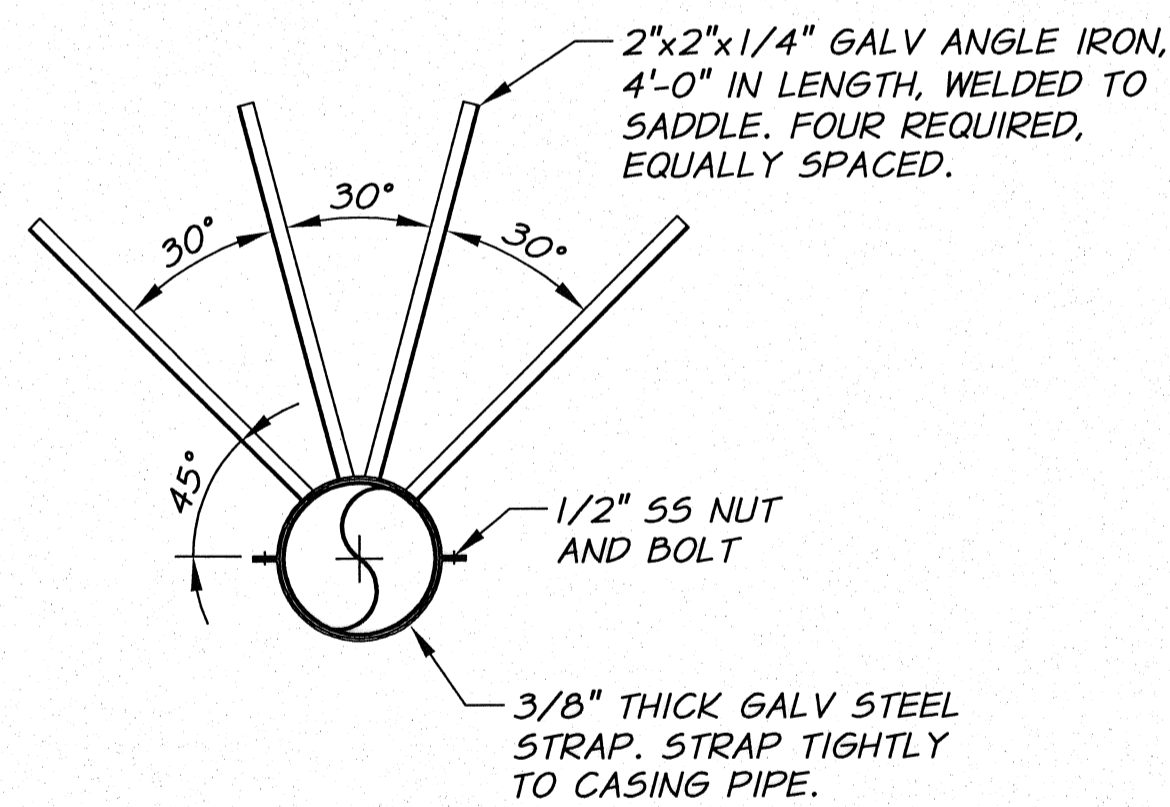


PIPE BARRIER
2 REQUIRED
N.T.S.

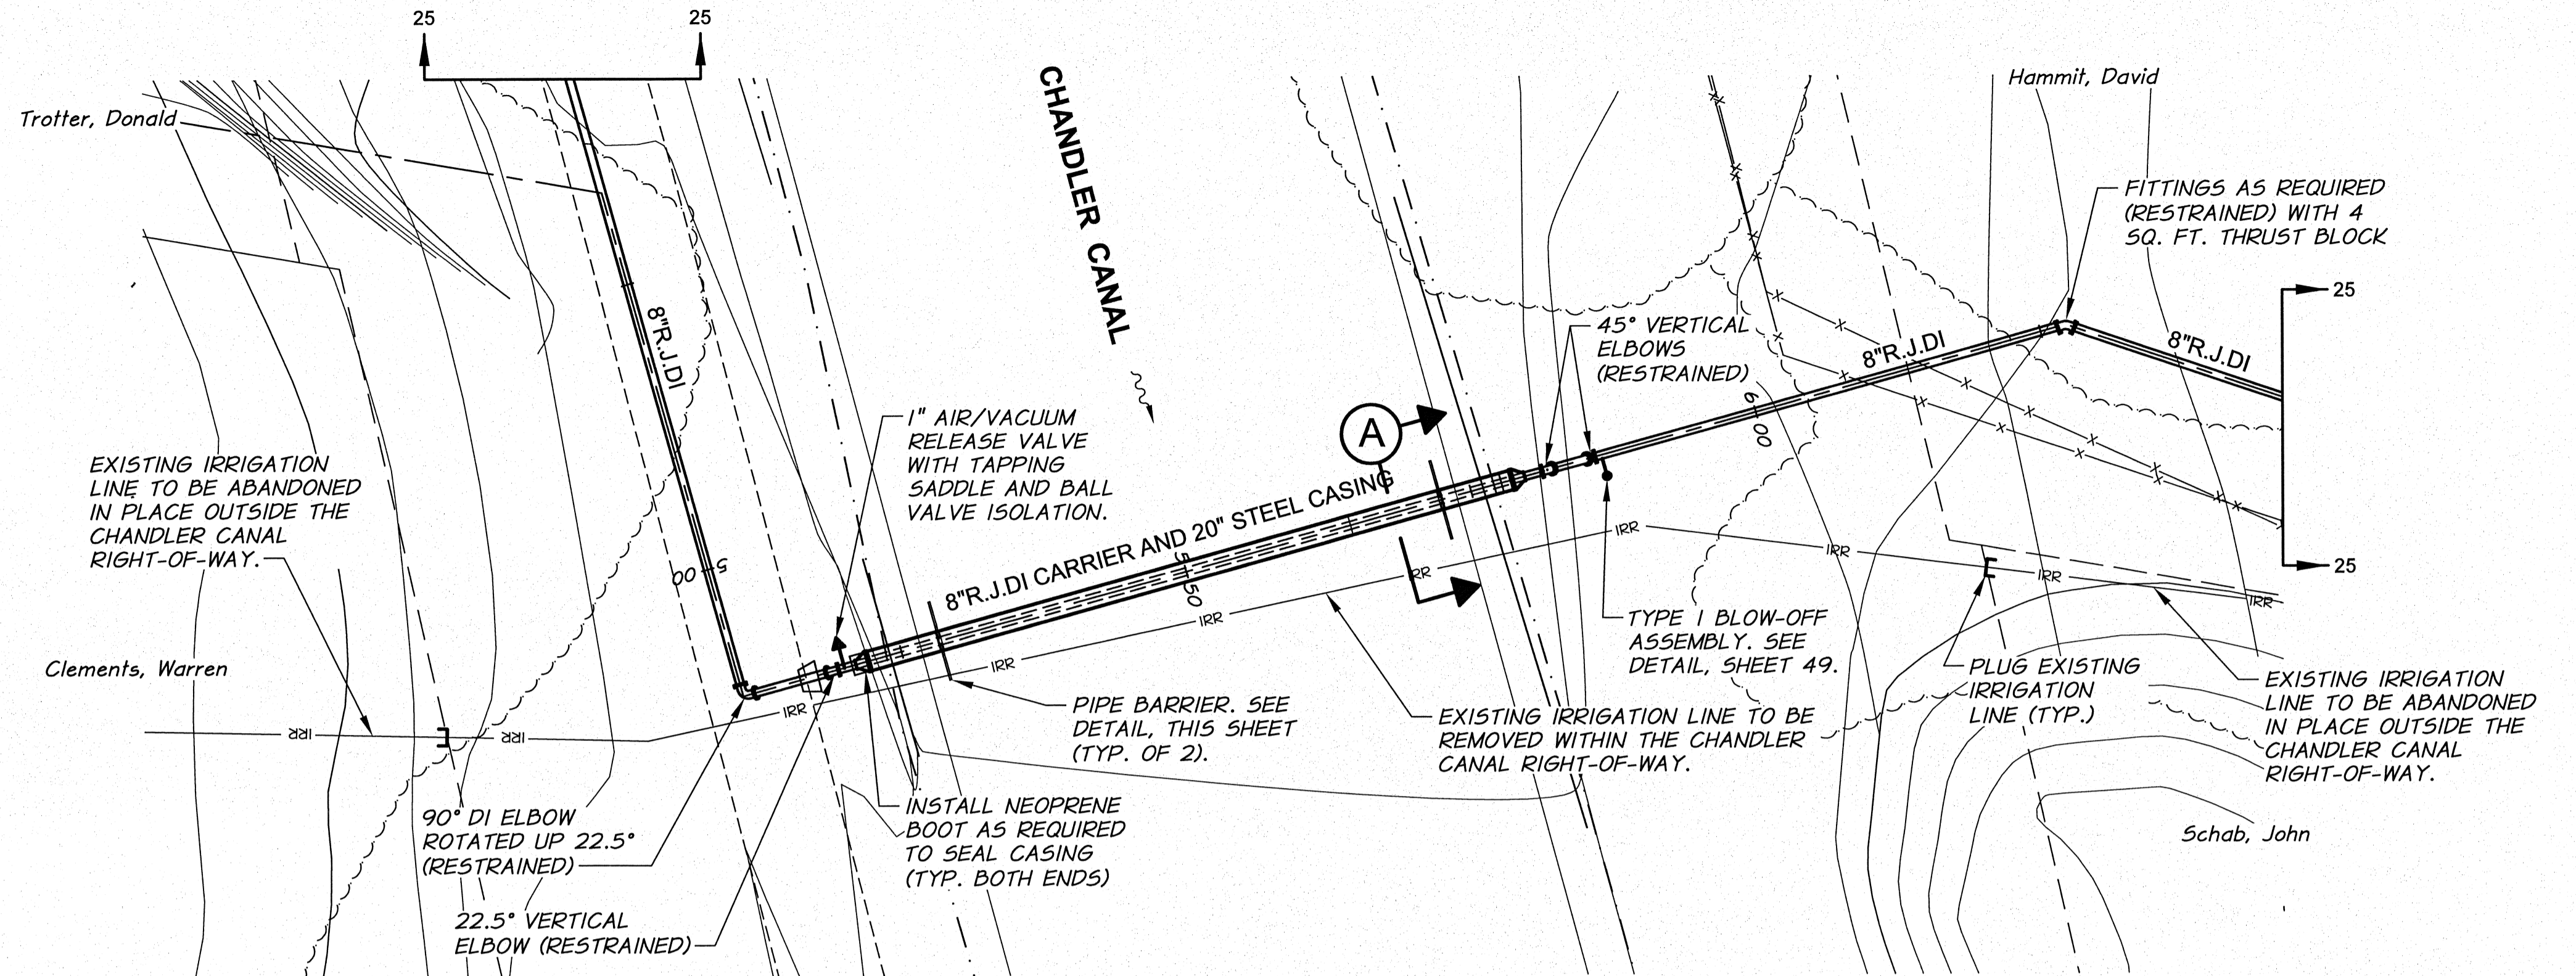

PLAN
1"=10'

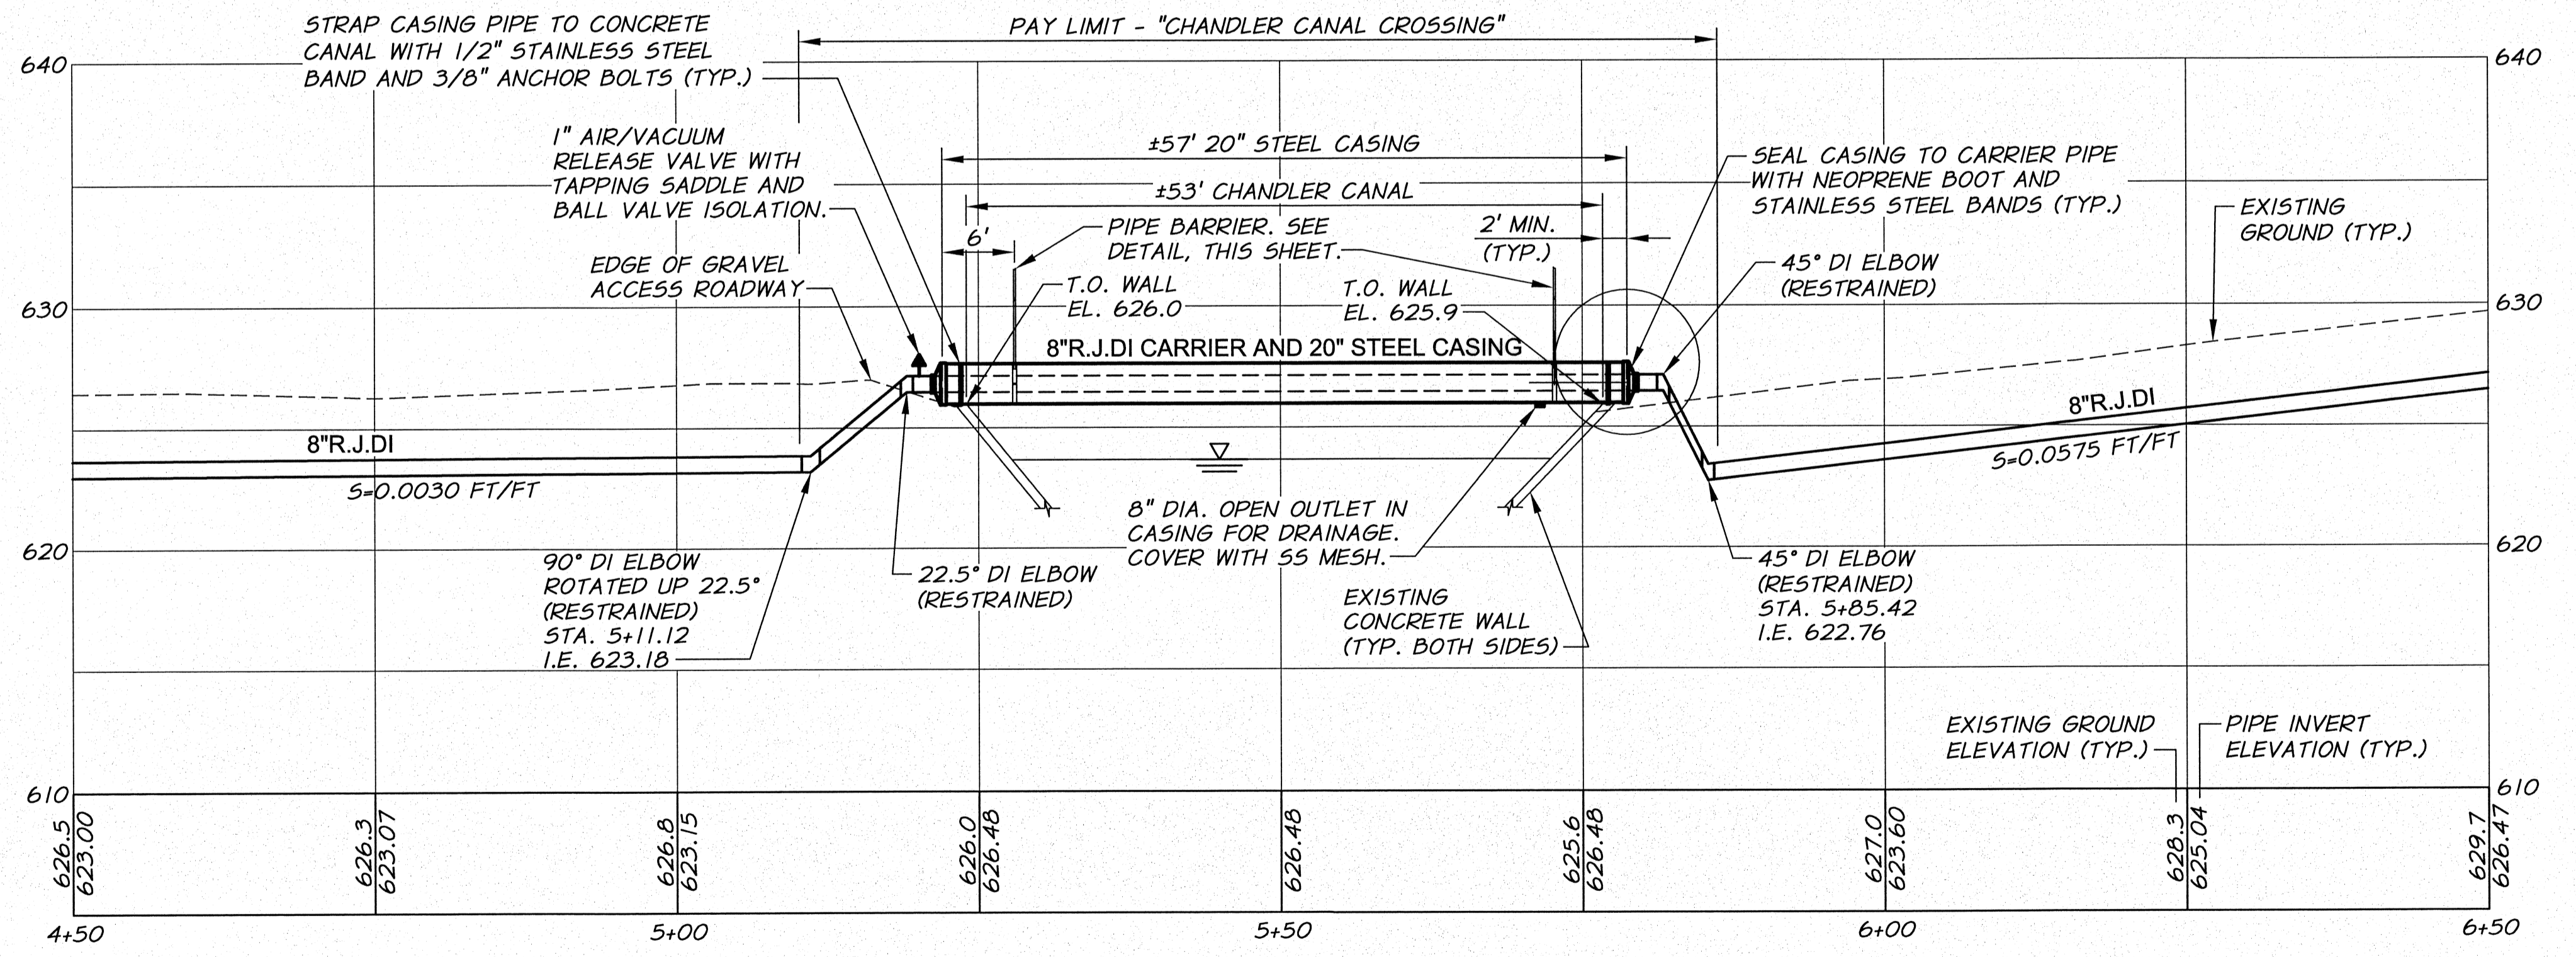


PROFILE
1"=10' HORZ.
1"=5' VERT.

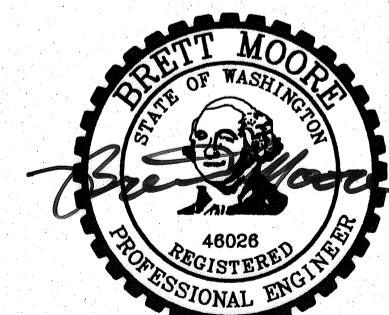


SIGNED 06-04-12
RECORD DRAWINGS

REVISION	BY	DATE	HORZ. SCALE 1"=10'	VERT. SCALE 1"=5"
DESIGNED BY R. HARRIS			JOB NUMBER 1199-336	DATE 2011
DRAWN BY D. CHRISTMAN			ACAD FILE: ChandlerCanalXing.dwg	
REVIEWED BY B. MOORE			COPYRIGHT 2011 BY ANDERSON-PERRY & ASSOC., INC.	

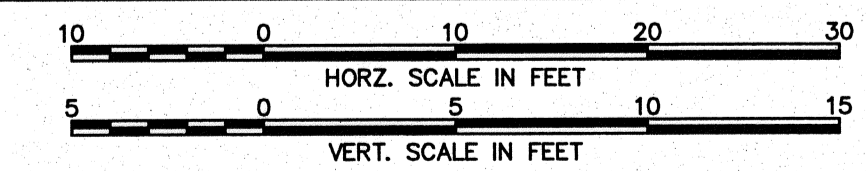

RECORD DRAWINGS

These record drawings have been prepared, in part, on the basis of information compiled and furnished by others. They may contain some discrepancies and omissions, and do not necessarily represent "exact" field conditions. The Owner and the Engineer accept no responsibility for their accuracy.

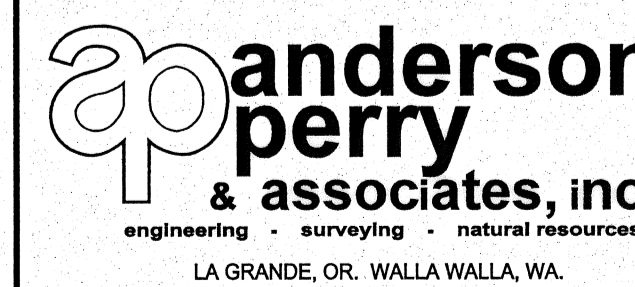

BENTON IRRIGATION DISTRICT
IRRIGATION SYSTEM IMPROVEMENTS
PHASE 2B

CHANDLER CANAL CROSSING
PLAN AND PROFILE

SHEET

37