
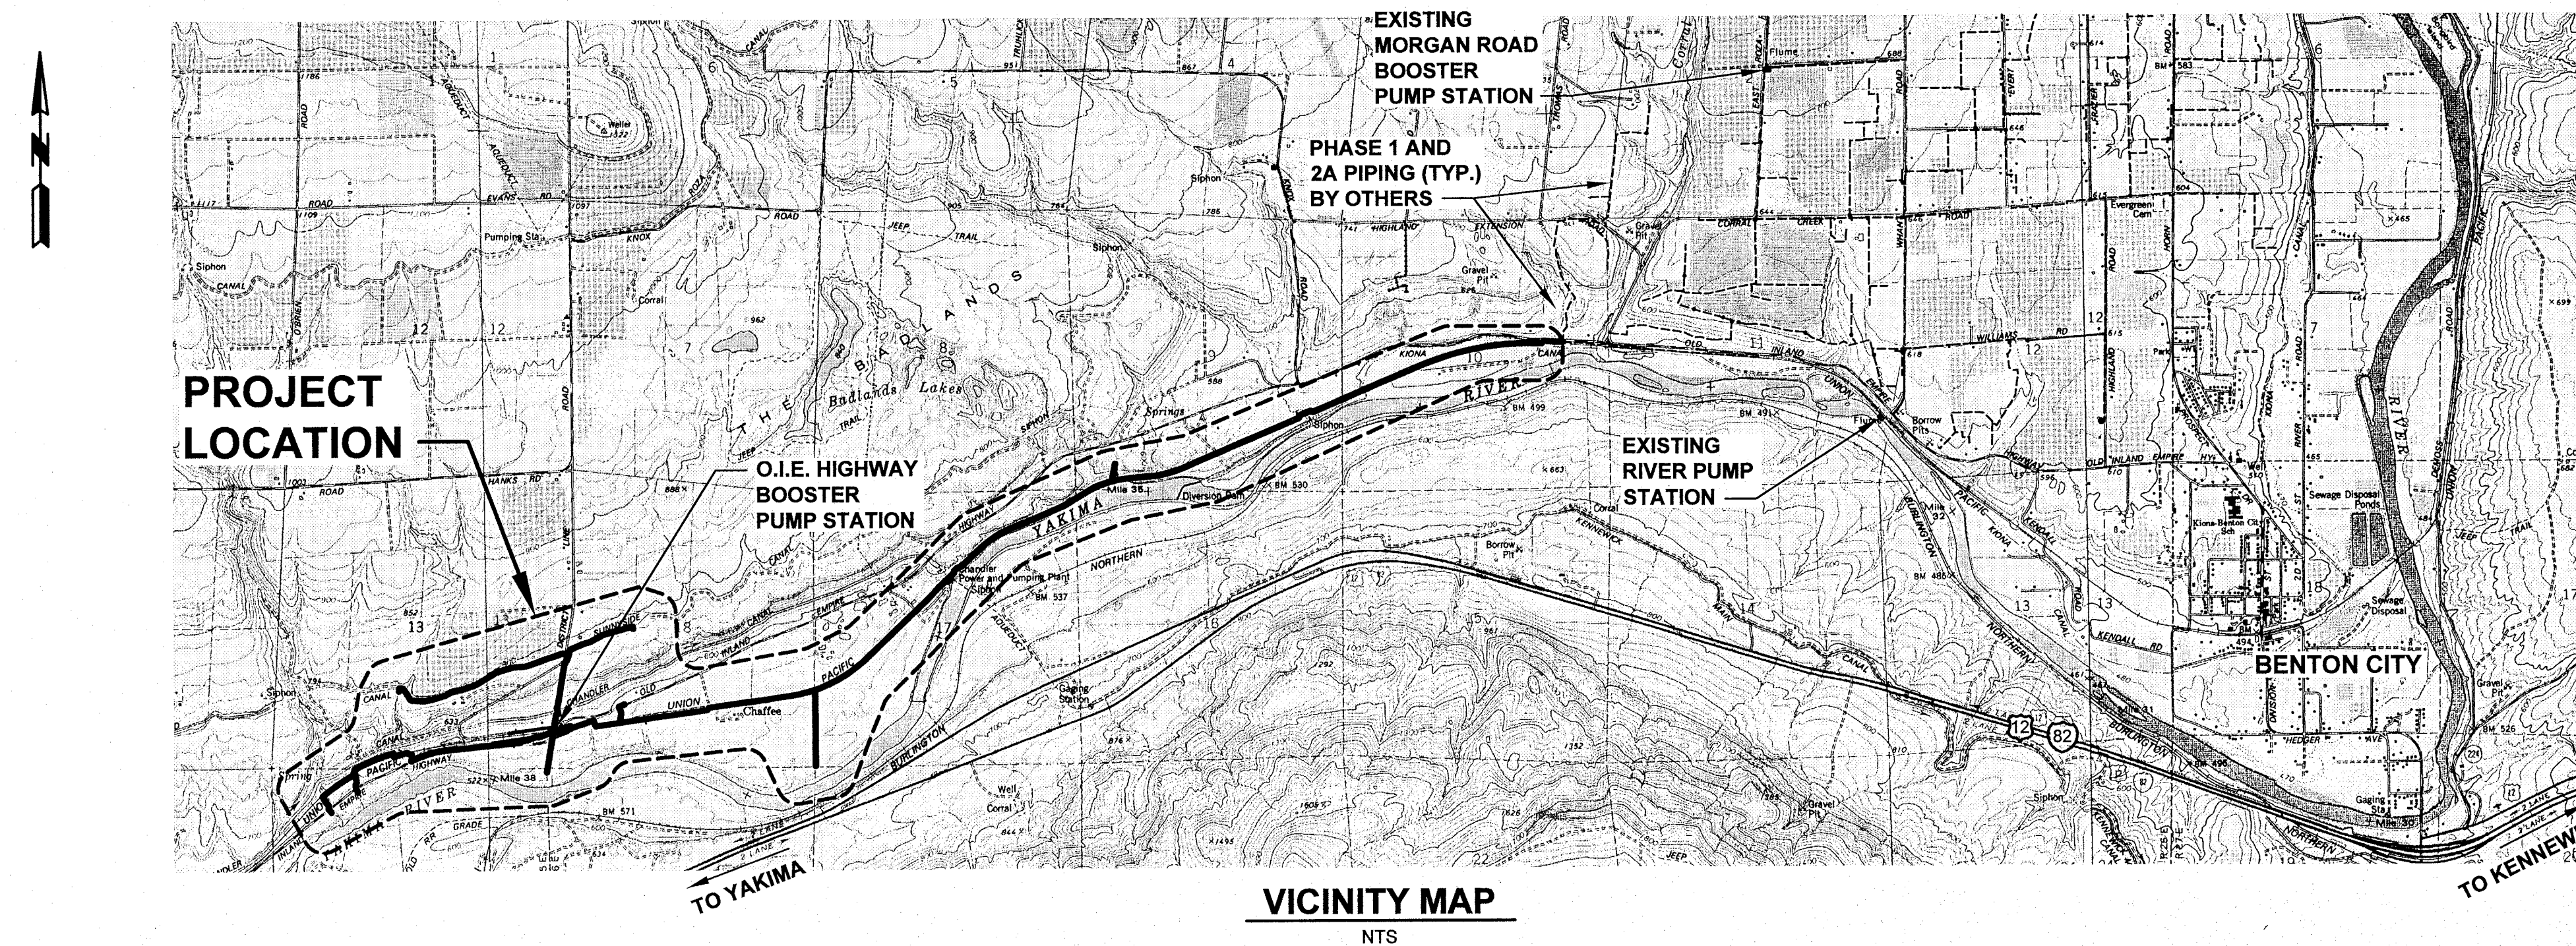


# BENTON IRRIGATION DISTRICT


## IRRIGATION SYSTEM IMPROVEMENTS

### PHASE 2B

#### 2011

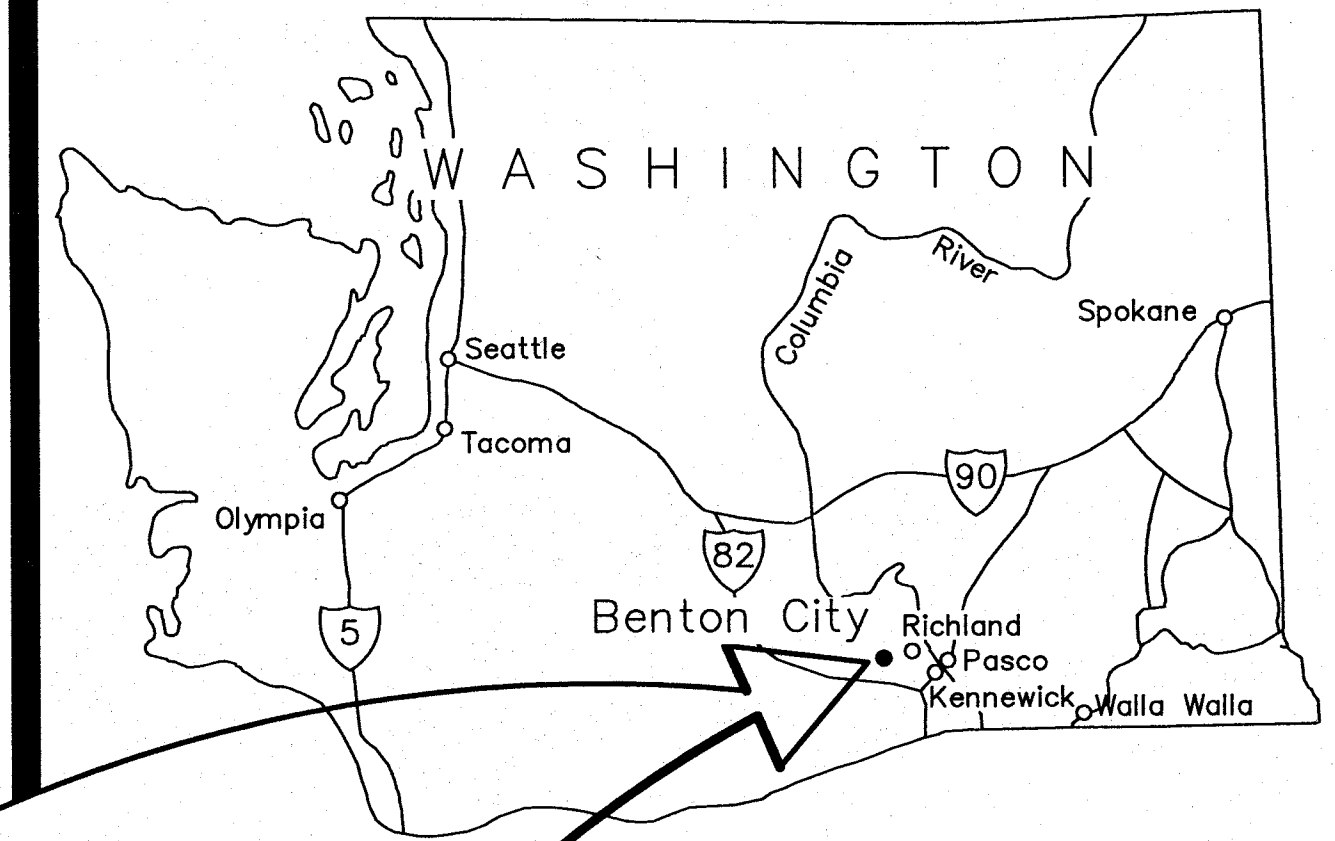

VICINITY MAP  
NTS

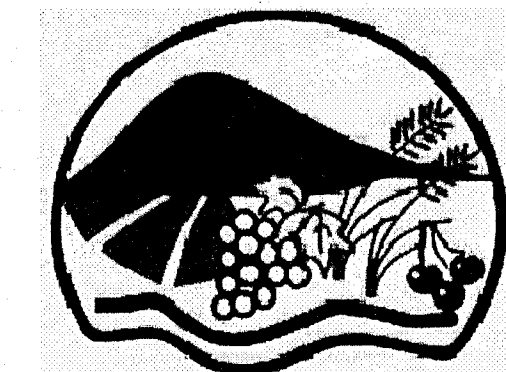

#### DISTRICT BOARD OF DIRECTORS


MELISSA GLODO  
ROBERT BUOY  
DICK MARTIN

#### INDEX

1	COVER	14	POWER PLANT TO O.I.E. HWY. PIPING	28	CANAL PIPING	38	DETAILS	54	O.I.E. PUMP STATION
2	LEGEND, NOTES, AND QUANTITIES	15	STA. 1+00 TO STA. 14+00	29	STA. 1+00 TO STA. 14+00	39	PIPE CONNECTION DETAILS	55	SITE PLAN
3	SHEET INDEX	16	STA. 14+00 TO STA. 28+00	30	STA. 14+00 TO STA. 28+00	40	SERVICE DETAILS I	56	SITE PIPING PLAN
<b>CORRAL CREEK TO POWER PLANT PIPING</b>		17	STA. 28+00 TO STA. 42+00	31	STA. 28+00 TO STA. 38+16	41	SERVICE DETAILS II	57	PIPING SECTIONS I
4	STA. 1+00 TO STA. 15+00	18	STA. 42+00 TO STA. 56+00	32	<b>BRANCH LINE PIPING</b>	42	SERVICE DETAILS III	58	PIPING SECTIONS II
5	STA. 15+00 TO STA. 29+00	19	STA. 56+00 TO STA. 70+00	33	STA. 1+00 TO STA. 8+50	43	SERVICE DETAILS IV	59	FLOOR PLAN
6	STA. 29+00 TO STA. 43+00	20	STA. 70+00 TO STA. 80+91.72	34	STA. 1+00 TO STA. 5+51	44	SERVICE DETAILS V	60	ELEVATIONS
7	STA. 43+00 TO STA. 57+00	21	<b>O.I.E. HWY. PIPING</b>	35	STA. 1+00 TO STA. 10+00	45	VALVE VAULT DETAILS I	61	MECHANICAL PLAN
8	STA. 57+00 TO STA. 71+00	22	STA. 1+00 TO STA. 14+00	36	STA. 10+00 TO STA. 15+95	46	VALVE VAULT DETAILS II	62	MECHANICAL SECTIONS
9	STA. 71+00 TO STA. 85+00	23	STA. 14+00 TO STA. 28+00	37	<b>CHANDLER POWER STATION CROSSING</b>	47	VALVE VAULT DETAILS III	63	ELECTRICAL SCHEMATIC
10	STA. 85+00 TO STA. 99+00	24	STA. 28+00 TO STA. 42+00	38	PLAN AND PROFILE	48	VALVE STATION DETAILS I	64	VAULT DETAILS
11	STA. 99+00 TO STA. 113+00	25	STA. 42+00 TO STA. 56+28	39	<b>O.I.E. HWY. TO CANAL PIPING</b>	49	VALVE STATION DETAILS II	65	PUMP HOIST PLAN AND DETAILS
12	STA. 113+00 TO STA. 127+50	26	STA. 1+00 TO STA. 4+95	40	STA. 1+00 TO STA. 9+00	50	MISCELLANEOUS DETAILS I	66	STRUCTURAL DETAILS I
13	STA. 127+50 TO STA. 142+13.91	27	STA. 9+00 TO STA. 17+00	41	STA. 17+00 TO STA. 31+69	51	MISCELLANEOUS DETAILS II	67	STRUCTURAL DETAILS II
14	STA. 1+00 TO STA. 14+00			42	<b>CHANDLER CANAL CROSSING</b>	52	MISCELLANEOUS DETAILS III	68	MISCELLANEOUS DETAILS
<b>POWER PLANT TO O.I.E. HWY. PIPING</b>				43	PLAN AND PROFILE	53	TRENCH DETAILS	69	PUMP CONTROL SCHEMATIC
15	STA. 1+00 TO STA. 14+00			44	<b>DETAILS</b>		THRUST BLOCK DETAILS		FENCE DETAILS

#### RECORD DRAWINGS

These record drawings have been prepared, in part, on the basis of information compiled and furnished by others. They may contain some discrepancies and omissions, and do not necessarily represent "exact" field conditions. The Owner and the Engineer accept no responsibility for their accuracy.

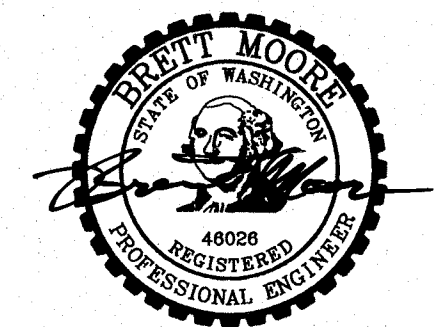


SIGNED 06-04-12  
RECORD DRAWINGS


**Anderson-Perry & Associates, Inc.**

engineering - surveying - natural resources  
1901 N. Fir Street - La Grande, OR 97850 Ph: (541)963-8309 Fax: (541)963-5456  
LA GRANDE, OR WALLA WALLA, WA


**PLAN LEGEND**

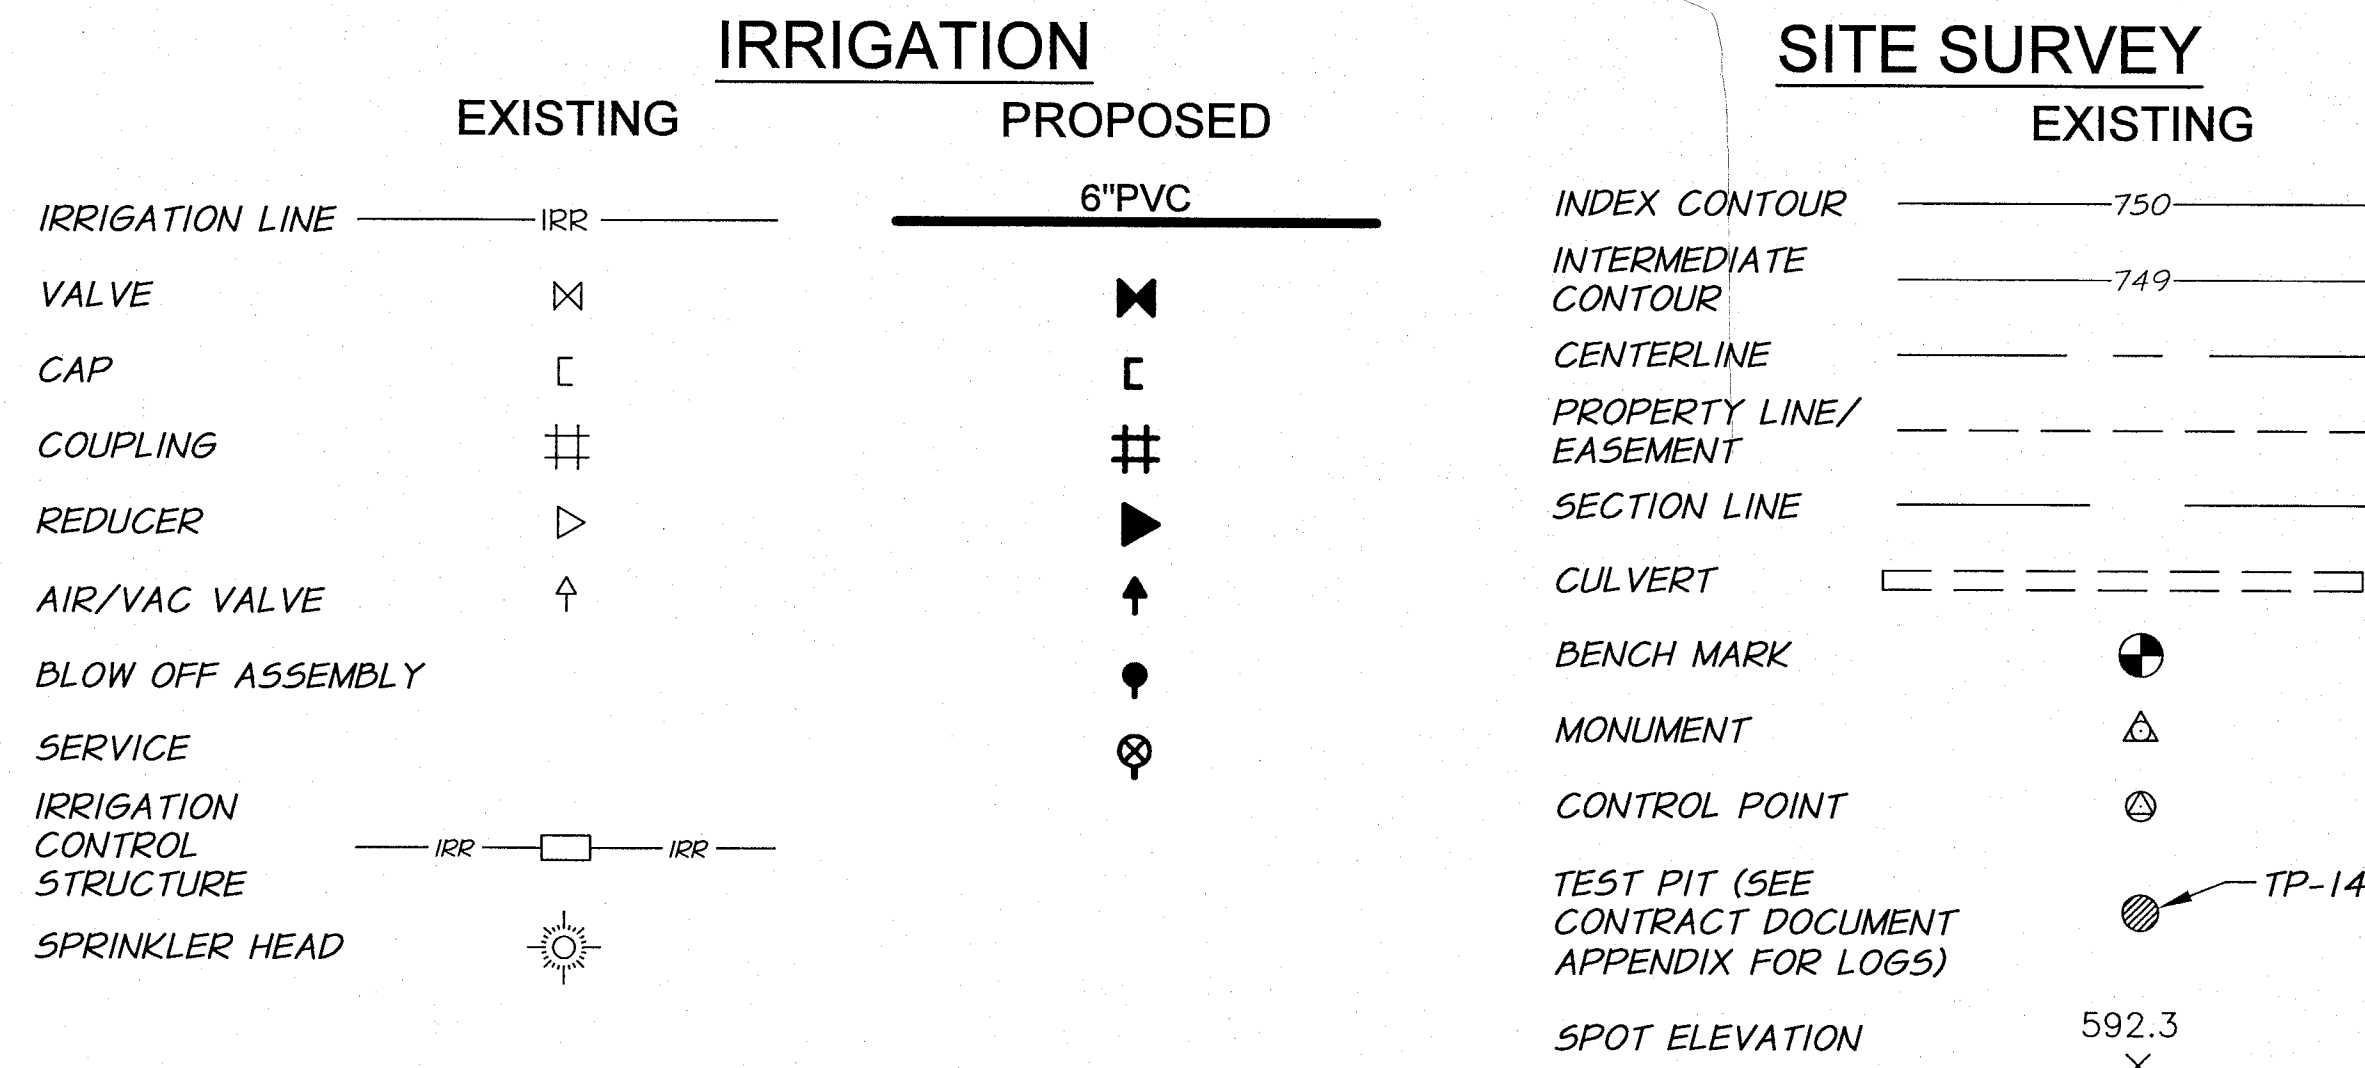


**MISCELLANEOUS UTILITIES**

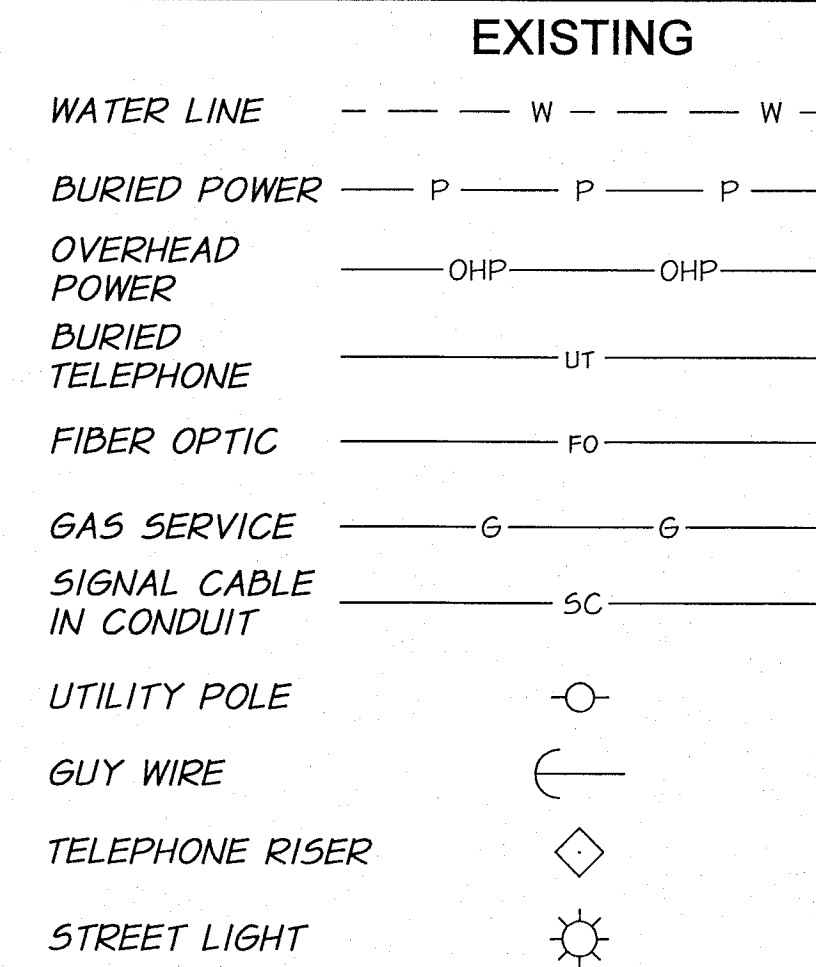


**GENERAL**

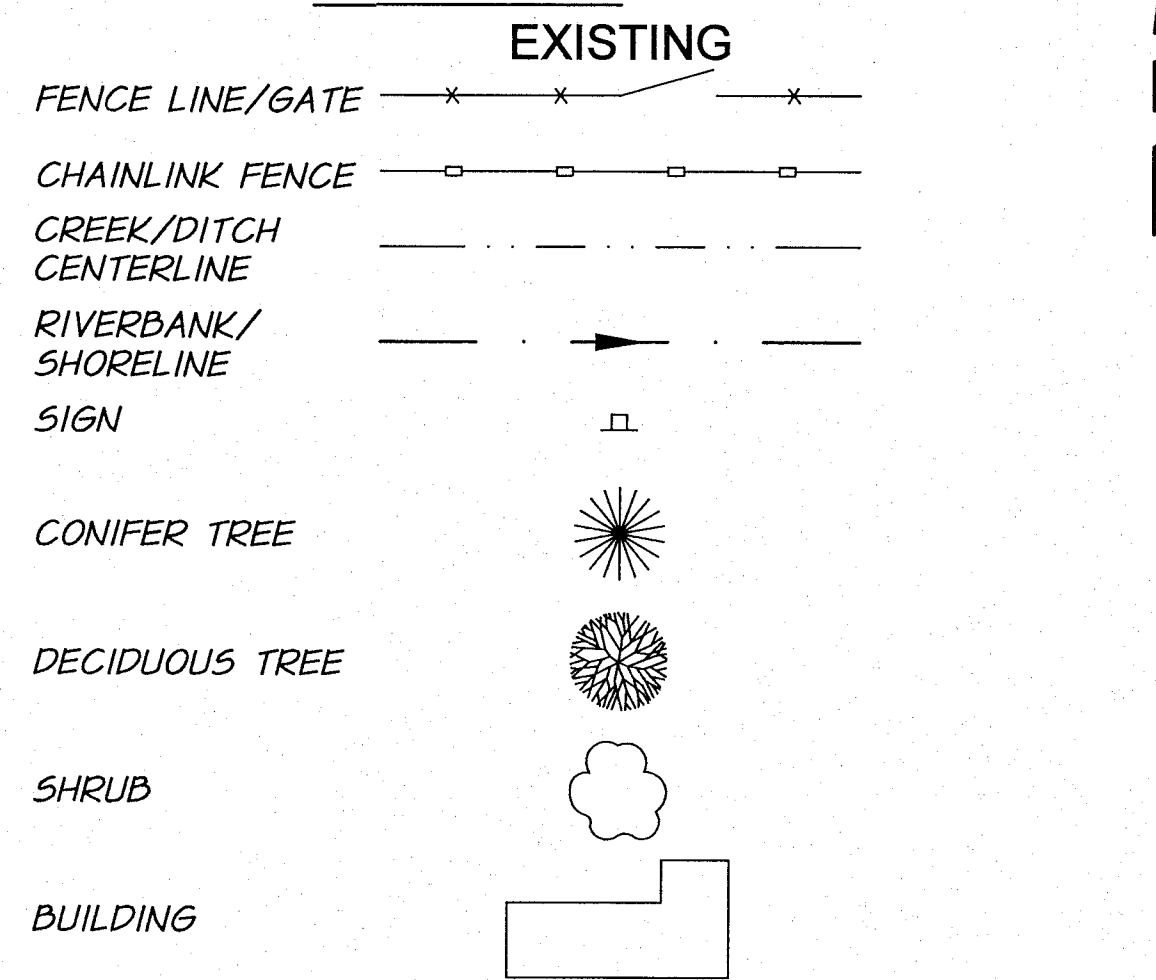



**STREET AND CURB**

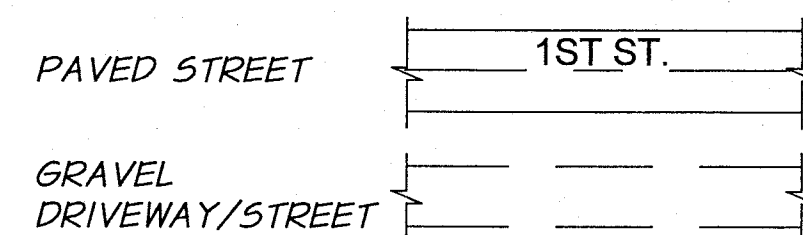

**PROFILE LEGEND**

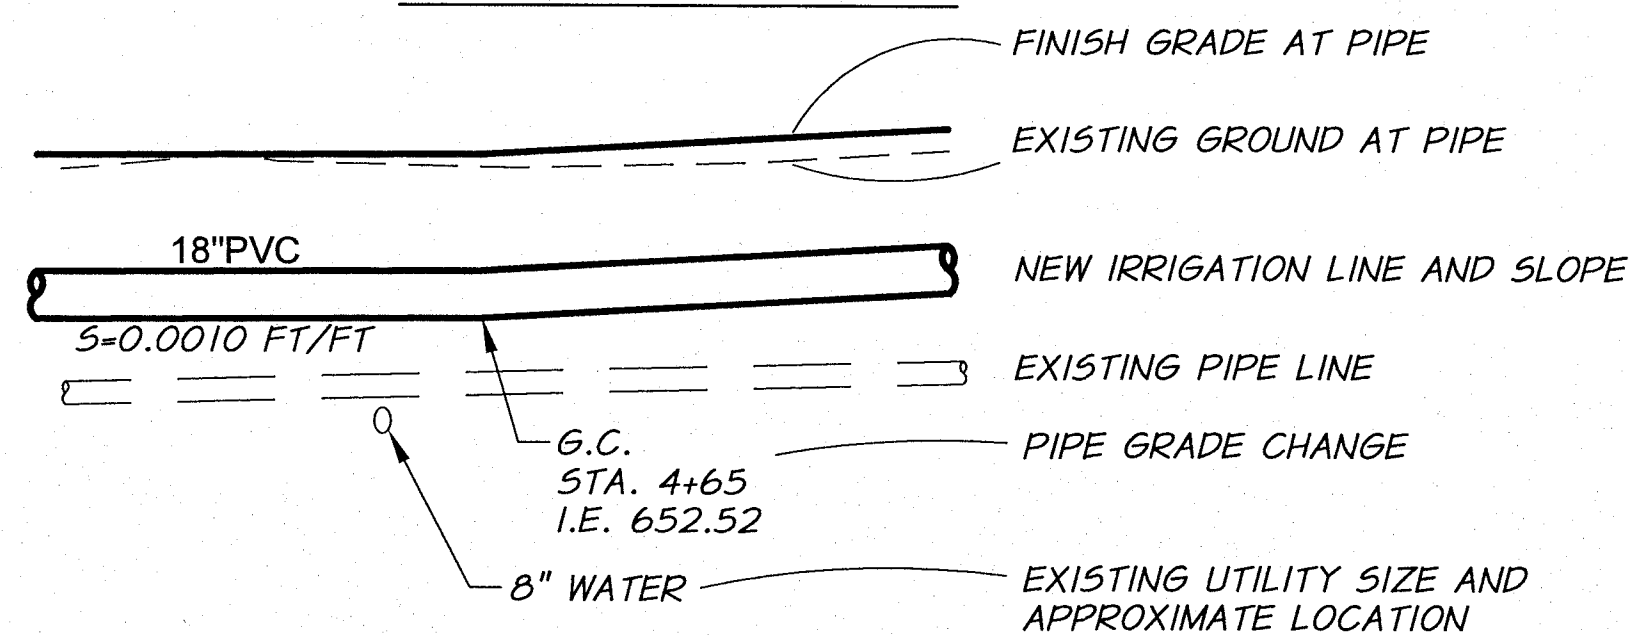

**DRAFTING**

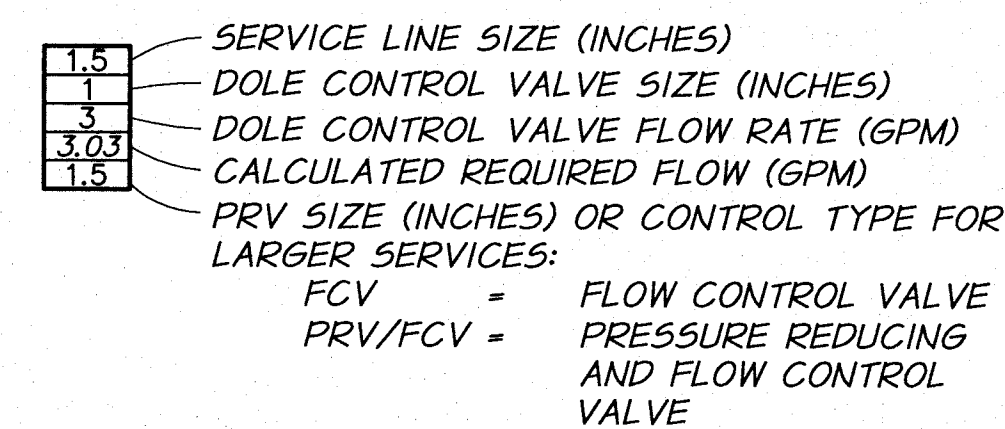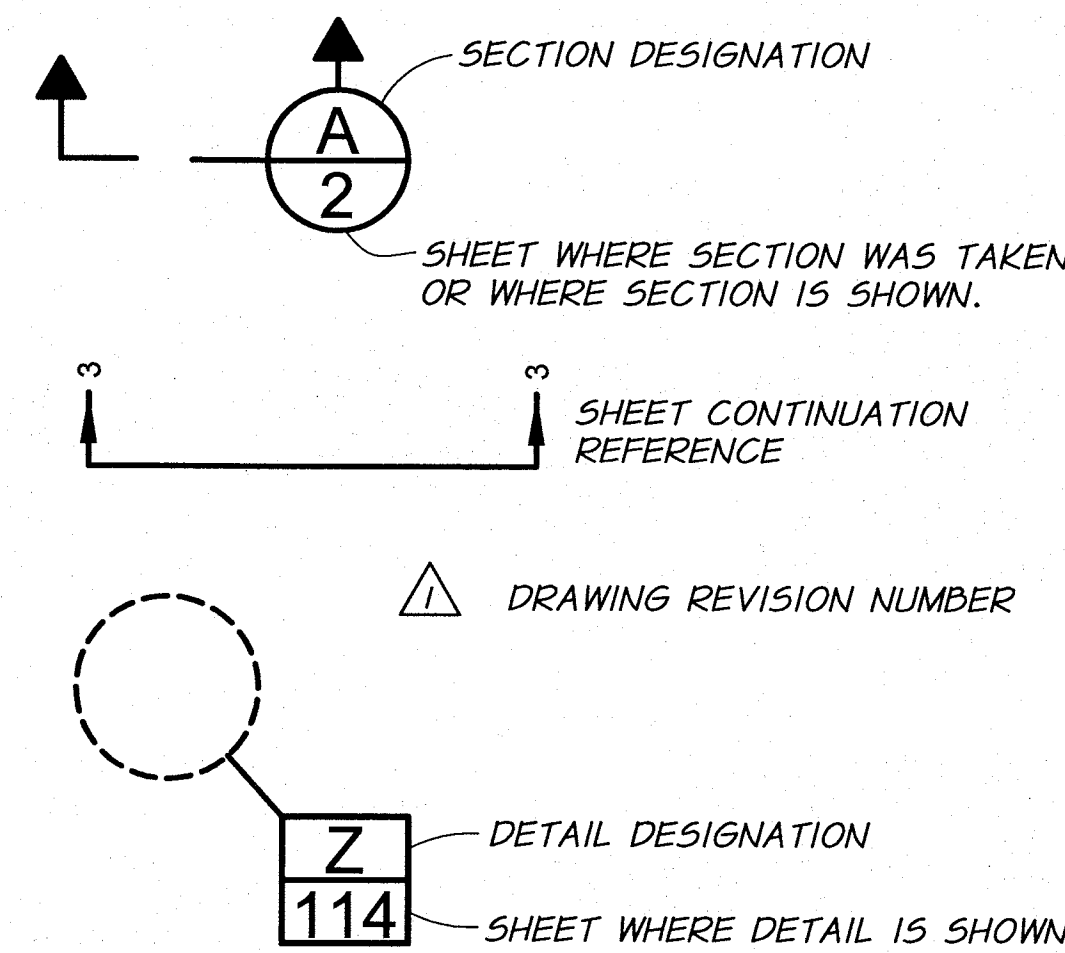

**NOTE:**  
A BLANK DOLE CONTROL VALVE SIZE AND FLOW FIELD INDICATES A FLOWMETER USED. A BLANK PRV SIZE FIELD INDICATES NO PRV VALVE REQUIRED.

**ESTIMATED QUANTITIES FOR ROCK EXCAVATION**

PHASE 2B: ±1,700 CUBIC YARDS


**NOTE:**  
REFER TO THE SPECIFICATIONS FOR DESCRIPTION OF ROCK EXCAVATION. THE QUANTITIES SHOWN ARE ESTIMATES PREPARED BY THE ENGINEER AND ARE BASED UPON FIELD SURVEY DATA PERFORMED BY THE ENGINEER, AND THE IMPROVEMENTS SHOWN ON THE DRAWINGS. THE CONTRACTOR SHALL MAKE HIS OWN DETERMINATION OF THE ACTUAL QUANTITIES TO COMPLETE THE WORK AS SHOWN ON THE DRAWINGS AND AS SPECIFIED FOR PREPARING HIS BID FOR THE PROJECT.

**TEST PIT NOTES**

- THE TEST PIT LOCATIONS ARE SHOWN ON THE DRAWINGS AND THE TEST PIT LOGS ARE PROVIDED IN THE APPENDIX OF THE SPECIFICATIONS.
- THE SOIL DATA, ROCK DATA, AND GROUND WATER CONDITIONS WHEN SHOWN ON THE DRAWINGS AND LOGS ARE PROVIDED SOLELY FOR THE CONTRACTOR'S INFORMATION. SUCH DATA IS NOT GUARANTEED AS TO ACCURACY OR COMPLETENESS WITH RESPECT TO THE ACTUAL SUBSURFACE CONDITIONS. INFORMATION SHOWN SHALL NOT RELIEVE THE CONTRACTOR FROM MAKING SUCH ADDITIONAL INVESTIGATIONS AS HE MAY ELECT TO FAMILIARIZE HIMSELF WITH THE ACTUAL CONDITIONS TO BE ENCOUNTERED IN EXECUTING THE WORK AND PREPARING HIS BID FOR THE PROJECT.
- THE CONTRACTOR SHALL COORDINATE HIS WORK WITH FRONTIER PRIOR TO CONSTRUCTION. FOR NEW IRRIGATION LINES THAT WILL CROSS FIBER OPTIC LINES, THE NEW IRRIGATION LINES SHALL BE INSTALLED UNDERNEATH THE FIBER OPTIC LINES, MAINTAINING A MINIMUM OF 12 INCHES CLEARANCE. ADJUSTMENTS TO THE IRRIGATION LINE VERTICAL GRADE MAY BE REQUIRED, INCLUDING FITTINGS AS REQUIRED. THIS ADJUSTMENT SHALL BE INCIDENTAL TO THE WORK.
- EXISTING GROUND ELEVATIONS SHOWN ON THE PROFILES ARE APPROXIMATE AND MAY VARY FROM ACTUAL EXISTING GROUND ELEVATIONS ENCOUNTERED DURING CONSTRUCTION. THERE SHALL BE NO ADDITIONAL PAYMENT MADE TO THE CONTRACTOR FOR EXCAVATION AND BACKFILL VARIATIONS CAUSED BY ELEVATION OF EXISTING GROUND DIFFERENCES FROM WHAT IS SHOWN ON THE DRAWINGS.
- BOTH HORIZONTAL DEFLECTIONS AND CHANGES OF VERTICAL GRADE ARE SHOWN ON THE DRAWINGS. IN SOME LOCATIONS FITTINGS ARE CALLED FOR ON THE DRAWINGS AT HORIZONTAL DEFLECTIONS AND CHANGES IN VERTICAL GRADE, BUT NOT AT ALL LOCATIONS THAT MAY REQUIRE FITTINGS. IF PIPE JOINT DEFLECTION OR BENDING THE PIPE AS DESCRIBED AND ALLOWED IN THE TECHNICAL SPECIFICATIONS DOES NOT MAINTAIN ALIGNMENT OR GRADE, FITTINGS SHALL BE USED WITH APPROPRIATE THRUST BLOCKING AND SHALL BE INCIDENTAL TO THE PIPELINE WORK. ADDITIONALLY, THE CONTRACTOR SHALL MAINTAIN THE 2.5-FOOT MINIMUM COVER OVER THE TOP OF PIPE DURING CONSTRUCTION FOR ALL AREAS EXCEPT DITCH LINES AND ROAD CROSSINGS. MINIMUM COVER FOR DITCH LINES AND ROAD CROSSINGS SHALL BE 3 FEET, UNLESS NOTED OTHERWISE.
- THE CONTRACTOR SHALL PERFORM EXPLORATORY WORK PRIOR TO CONSTRUCTION INCLUDING POTHOLES OF UTILITIES SUCH AS TELEPHONE, FIBER OPTIC, ELECTRICAL, WATER, ETC., AND IRRIGATION MAINS AND SERVICE LINES THAT LAY ADJACENT TO OR CROSS THE IMPROVEMENTS TO BE CONSTRUCTED. THIS WORK SHALL BE PERFORMED IN ORDER TO ACCURATELY LOCATE AND DETERMINE SIZES OF THE LINES AND TO DETERMINE ANY CONFLICTS THAT MAY EXIST THAT WILL REQUIRE ADJUSTMENT OF UTILITIES, COORDINATION WITH UTILITIES, OR ADJUSTMENT OF IMPROVEMENTS. SEE THE TECHNICAL SPECIFICATIONS FOR ADDITIONAL DETAILS. PAYMENT FOR EXPLORATORY WORK SHALL BE PAID UNDER THE BID ITEM "POTHOLES."
- THRUST BLOCKING REQUIRED FOR ALL TEES AND ELBOWS 11-1/4 DEGREES OR GREATER FOR PIPE SIZES 3-INCH OR GREATER.
- THE CONTRACTOR'S WORK SHALL BE LIMITED TO THE WIDTH OF THE IRRIGATION EASEMENT PLUS ANY ADDITIONAL TEMPORARY EASEMENT PROVIDED AND COUNTY ROAD RIGHT-OF-WAY AS SPECIFIED IN THE TECHNICAL SPECIFICATIONS. SEE THE TECHNICAL SPECIFICATIONS FOR DETAILS.
- SMUDGE POTS AND ACCESSORIES ADJACENT TO ORCHARDS SHALL BE MOVED BY PROPERTY OWNER PRIOR TO CONSTRUCTION.

**CONSTRUCTION NOTES**

- ALL ASPHALT RESTORATION REQUIRED WITHIN AREAS NOT SPECIFIED FOR ASPHALT RESTORATION SHALL BE COMPLETED AT THE CONTRACTOR'S EXPENSE AND AT NO COST TO THE OWNER.
- REMOVE EXISTING DRAINAGE CULVERTS TO CONSTRUCT IRRIGATION LINE. EXISTING CULVERTS TO BE REINSTALLED AFTER PIPELINE INSTALLATION IS COMPLETED. CULVERTS DAMAGED BY CONSTRUCTION TO BE REPLACED WITH NEW SAME TYPE AND SIZE AT CONTRACTOR'S EXPENSE AND AT NO COST TO THE OWNER UNLESS THE CULVERT AGE AND CONDITION ENSUED THE DAMAGE AS DETERMINED BY THE ENGINEER. THE ENGINEER MAY REQUIRE REPLACEMENT OF CULVERTS DUE TO AGE OF CULVERT AND EXISTING CONDITION. REPLACEMENT REQUIRED BY THE ENGINEER SHALL BE PAID UNDER THE "CULVERT REPLACEMENT" BID ITEM AND MUST HAVE PRIOR APPROVAL BEFORE REPLACEMENT.
- MAILBOXES, SIGNS, ETC., IN CONFLICT WITH WORK SHALL BE TEMPORARILY RELOCATED, AS REQUIRED BY THE ENGINEER, AND REINSTALLED TO THE ORIGINAL LOCATION AFTER THE IRRIGATION LINE IS CONSTRUCTED, UNLESS OTHERWISE DIRECTED BY THE ENGINEER. DAMAGED MAILBOXES, SIGNS, POSTS, ETC., CAUSED BY THE CONSTRUCTION SHALL BE REPLACED WITH NEW LIKE KIND AS REQUIRED BY THE ENGINEER AT THE CONTRACTOR'S EXPENSE AND AT NO COST TO THE OWNER UNLESS THE AGE AND CONDITION ENSUED THE DAMAGE AS DETERMINED BY THE ENGINEER. THE ENGINEER MAY REQUIRE REPLACEMENT OF POST DUE TO AGE OF POST AND EXISTING CONDITION. REPLACEMENT REQUIRED BY THE ENGINEER SHALL BE PAID UNDER THE "POST REPLACEMENT" BID ITEM.
- REMOVE EXISTING FENCING TO CONSTRUCT IRRIGATION LINES AS REQUIRED. EXISTING FENCING TO BE REINSTALLED TO THE SATISFACTION OF THE PROPERTY OWNERS AFTER PIPELINE INSTALLATION IS COMPLETED. FENCING DAMAGED BY CONSTRUCTION TO BE REPLACED WITH NEW SAME TYPE AND SIZE TO THE SATISFACTION OF THE PROPERTY OWNERS AT CONTRACTOR'S EXPENSE AND AT NO COST TO THE OWNER.
- LOCATION FOR ALL SERVICES, AIR/VAC VALVES AND BLOW OFF ASSEMBLIES TO BE FIELD VERIFIED WITH THE ENGINEER PRIOR TO CONSTRUCTION.
- FOR IRRIGATION LINE CONSTRUCTION DIRECTLY ADJACENT TO ORCHARDS, THE CONTRACTOR SHALL PROTECT ORCHARD LIMBS FROM DAMAGE AS REQUIRED DURING CONSTRUCTION. COMPENSATION FOR DAMAGED TREES AND/OR LIMBS CAUSED BY THE CONTRACTOR SHALL BE AT THE CONTRACTOR'S EXPENSE AND AT NO COST TO THE OWNER. SEE TECHNICAL SPECIFICATION FOR DETAIL.
- FRONTIER UNDERGROUND FIBER OPTIC LINES ARE LOCATED WITHIN THE PROJECT. THE CONTRACTOR SHALL COORDINATE HIS WORK WITH FRONTIER PRIOR TO CONSTRUCTION. FOR NEW IRRIGATION LINES THAT WILL CROSS FIBER OPTIC LINES, THE NEW IRRIGATION LINES SHALL BE INSTALLED UNDERNEATH THE FIBER OPTIC LINES, MAINTAINING A MINIMUM OF 12 INCHES CLEARANCE. ADJUSTMENTS TO THE IRRIGATION LINE VERTICAL GRADE MAY BE REQUIRED, INCLUDING FITTINGS AS REQUIRED. THIS ADJUSTMENT SHALL BE INCIDENTAL TO THE WORK.
- EXISTING GROUND ELEVATIONS SHOWN ON THE PROFILES ARE APPROXIMATE AND MAY VARY FROM ACTUAL EXISTING GROUND ELEVATIONS ENCOUNTERED DURING CONSTRUCTION. THERE SHALL BE NO ADDITIONAL PAYMENT MADE TO THE CONTRACTOR FOR EXCAVATION AND BACKFILL VARIATIONS CAUSED BY ELEVATION OF EXISTING GROUND DIFFERENCES FROM WHAT IS SHOWN ON THE DRAWINGS.
- BOTH HORIZONTAL DEFLECTIONS AND CHANGES OF VERTICAL GRADE ARE SHOWN ON THE DRAWINGS. IN SOME LOCATIONS FITTINGS ARE CALLED FOR ON THE DRAWINGS AT HORIZONTAL DEFLECTIONS AND CHANGES IN VERTICAL GRADE, BUT NOT AT ALL LOCATIONS THAT MAY REQUIRE FITTINGS. IF PIPE JOINT DEFLECTION OR BENDING THE PIPE AS DESCRIBED AND ALLOWED IN THE TECHNICAL SPECIFICATIONS DOES NOT MAINTAIN ALIGNMENT OR GRADE, FITTINGS SHALL BE USED WITH APPROPRIATE THRUST BLOCKING AND SHALL BE INCIDENTAL TO THE PIPELINE WORK. ADDITIONALLY, THE CONTRACTOR SHALL MAINTAIN THE 2.5-FOOT MINIMUM COVER OVER THE TOP OF PIPE DURING CONSTRUCTION FOR ALL AREAS EXCEPT DITCH LINES AND ROAD CROSSINGS. MINIMUM COVER FOR DITCH LINES AND ROAD CROSSINGS SHALL BE 3 FEET, UNLESS NOTED OTHERWISE.
- THE CONTRACTOR SHALL PERFORM EXPLORATORY WORK PRIOR TO CONSTRUCTION INCLUDING POTHOLES OF UTILITIES SUCH AS TELEPHONE, FIBER OPTIC, ELECTRICAL, WATER, ETC., AND IRRIGATION MAINS AND SERVICE LINES THAT LAY ADJACENT TO OR CROSS THE IMPROVEMENTS TO BE CONSTRUCTED. THIS WORK SHALL BE PERFORMED IN ORDER TO ACCURATELY LOCATE AND DETERMINE SIZES OF THE LINES AND TO DETERMINE ANY CONFLICTS THAT MAY EXIST THAT WILL REQUIRE ADJUSTMENT OF UTILITIES, COORDINATION WITH UTILITIES, OR ADJUSTMENT OF IMPROVEMENTS. SEE THE TECHNICAL SPECIFICATIONS FOR ADDITIONAL DETAILS. PAYMENT FOR EXPLORATORY WORK SHALL BE PAID UNDER THE BID ITEM "POTHOLES."
- THRUST BLOCKING REQUIRED FOR ALL TEES AND ELBOWS 11-1/4 DEGREES OR GREATER FOR PIPE SIZES 3-INCH OR GREATER.
- THE CONTRACTOR'S WORK SHALL BE LIMITED TO THE WIDTH OF THE IRRIGATION EASEMENT PLUS ANY ADDITIONAL TEMPORARY EASEMENT PROVIDED AND COUNTY ROAD RIGHT-OF-WAY AS SPECIFIED IN THE TECHNICAL SPECIFICATIONS. SEE THE TECHNICAL SPECIFICATIONS FOR DETAILS.
- SMUDGE POTS AND ACCESSORIES ADJACENT TO ORCHARDS SHALL BE MOVED BY PROPERTY OWNER PRIOR TO CONSTRUCTION.

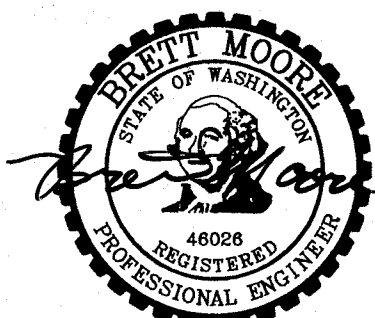


SIGNED 06-04-12  
RECORD DRAWINGS

REVISION	BY	DATE	HORIZ. SCALE NONE	VERT. SCALE
DESIGNED BY R. HARRIS			JOB NUMBER 1199-336	DATE 2011
DRAWN BY D. CHRISTMAN			ACAD FILE: LEGEND-Ph2B.dwg	
REVIEWED BY B. MOORE			XREFS: TB-BID.dwg	
COPYRIGHT 2011 BY ANDERSON-PERRY & ASSOC., INC.				

**RECORD DRAWINGS**

These record drawings have been prepared, in part, on the basis of information compiled and furnished by others. They may contain some discrepancies and omissions, and do not necessarily represent "exact" field conditions. The Owner and the Engineer accept no responsibility for their accuracy.

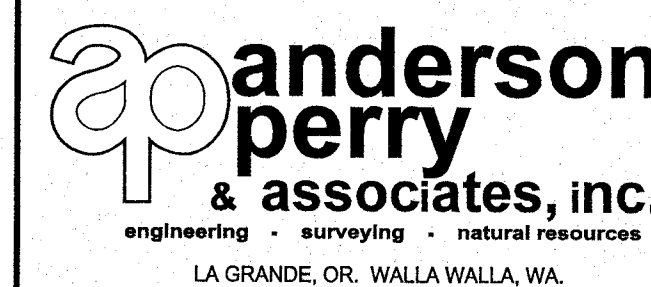


**BENTON IRRIGATION DISTRICT**  
IRRIGATION SYSTEM IMPROVEMENTS  
PHASE 2B

LEGEND, NOTES, AND QUANTITIES

SHEET

1


ARCHIVED

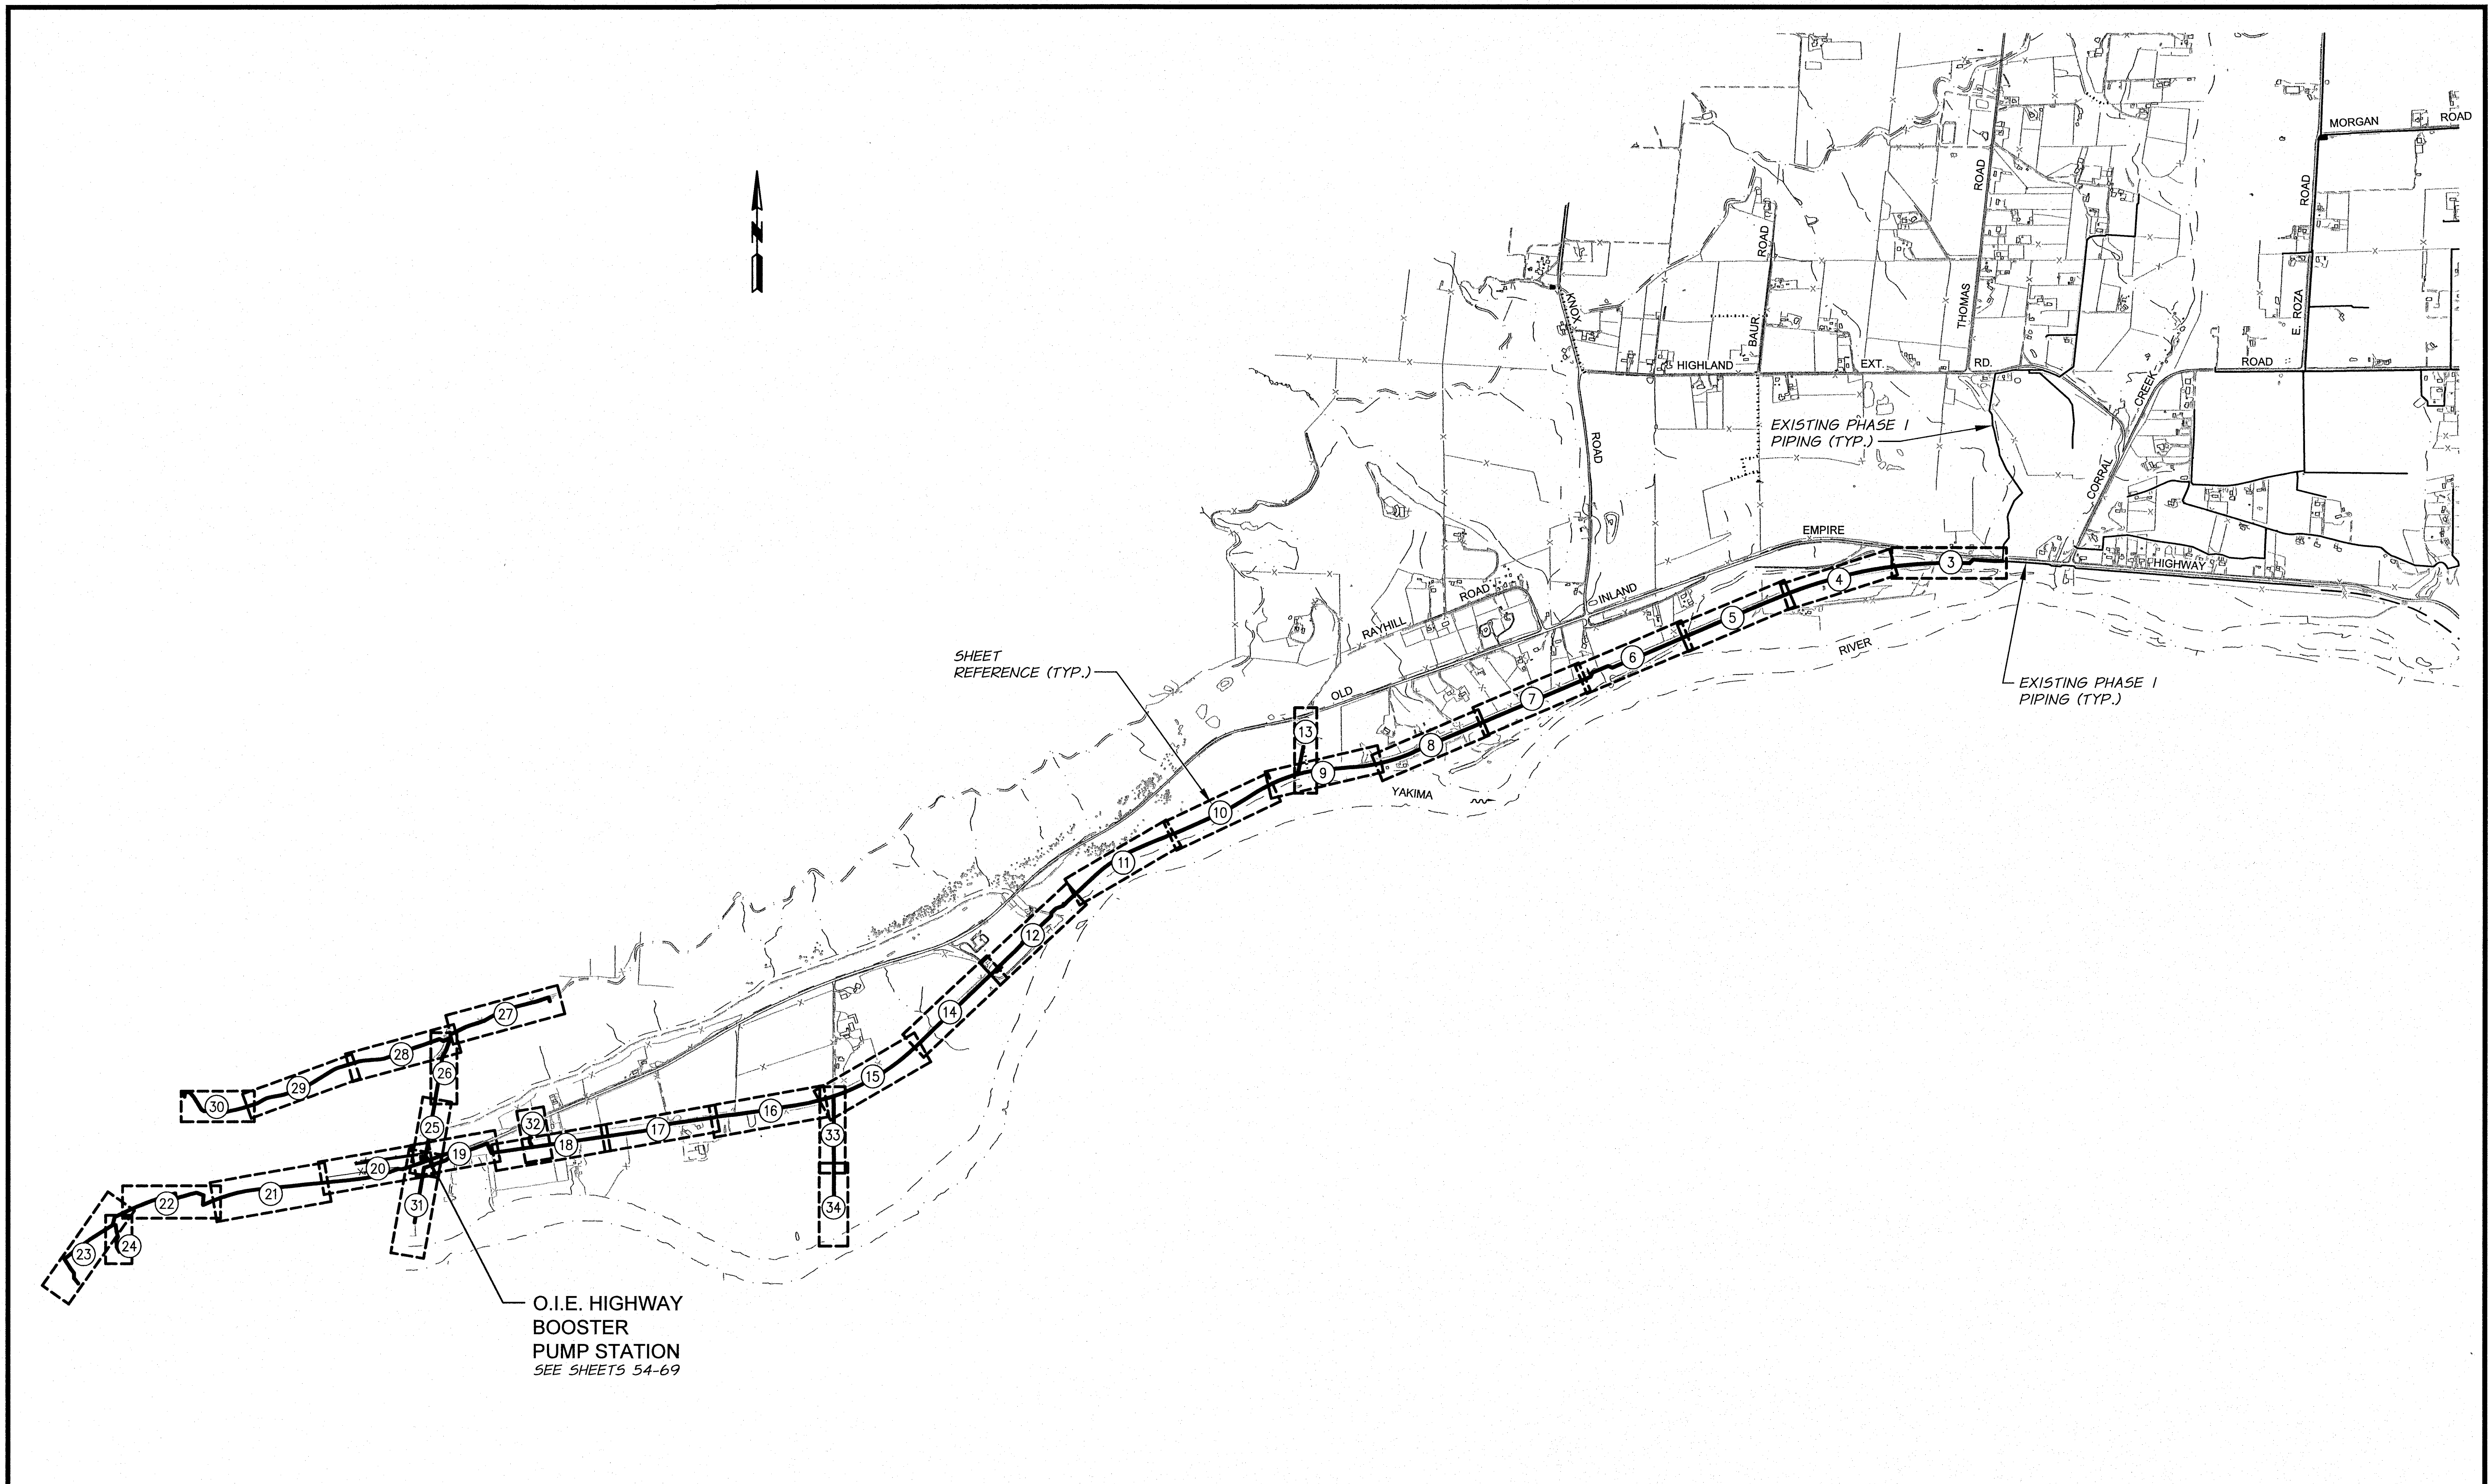

  
 SIGNED 06-04-12  
 RECORD DRAWINGS


REVISION		BY	DATE	HORIZ. SCALE 1"=1000'		VERT. SCALE	
DESIGNED BY R. HARRIS		XREFS: TB-BID.dwg		JOB NUMBER 1199-336		DATE 2011	
DRAWN BY D. CHRISTMAN		ACAD FILE: SheetIndexPH2B.dwg		COPYRIGHT 2011 BY ANDERSON-PERRY & ASSOC., INC.			
REVIEWED BY B. MOORE							

**RECORD DRAWINGS**  
 These record drawings have been prepared, in part, on the basis of information compiled and furnished by others. They may contain some discrepancies and omissions, and do not necessarily represent "exact" field conditions. The Owner and the Engineer accept no responsibility for their accuracy.

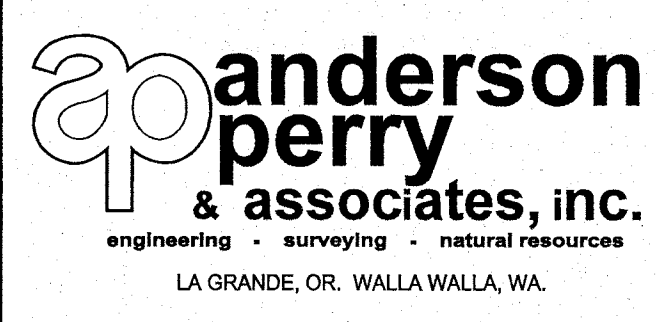


**BENTON IRRIGATION DISTRICT**  
 IRRIGATION SYSTEM IMPROVEMENTS  
 PHASE 2B  
 SHEET INDEX


SHEET  
**2**

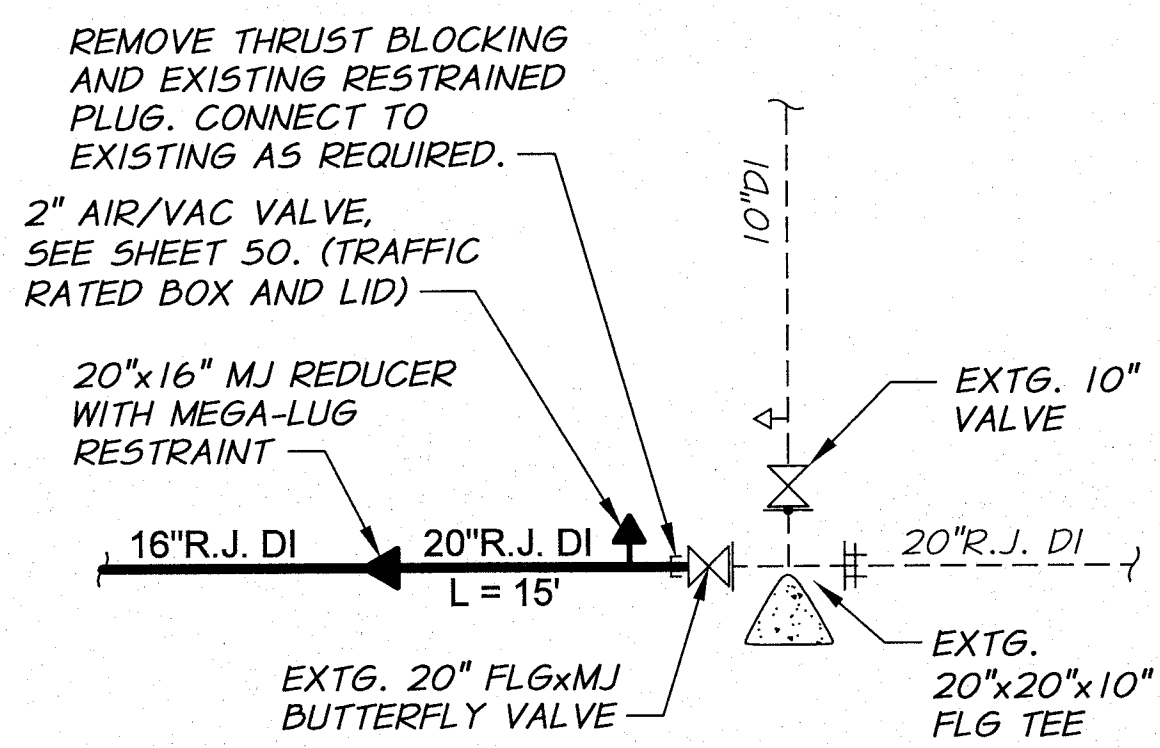


**DETAIL AA**  
REFERENCE SHEET: 3

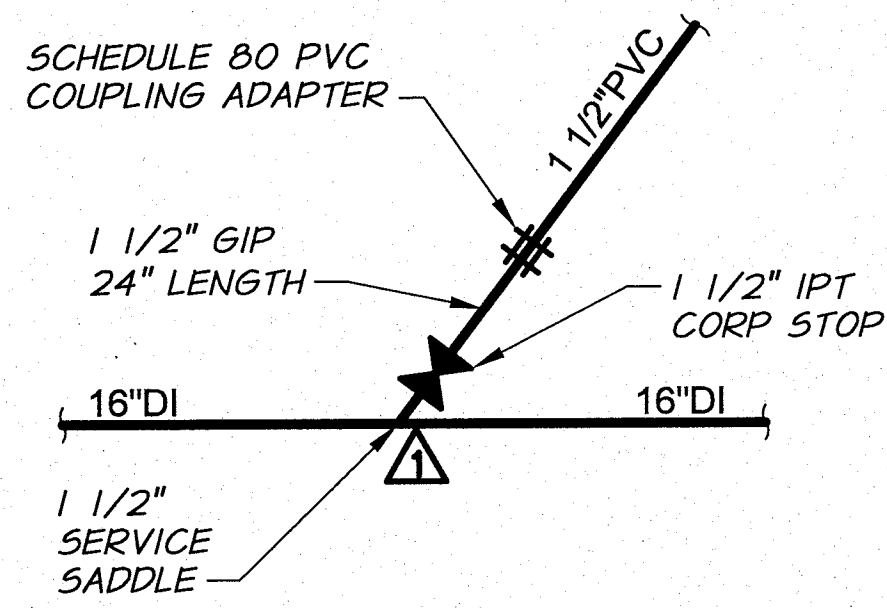


**DETAIL AB**  
REFERENCE SHEET: 9, 13

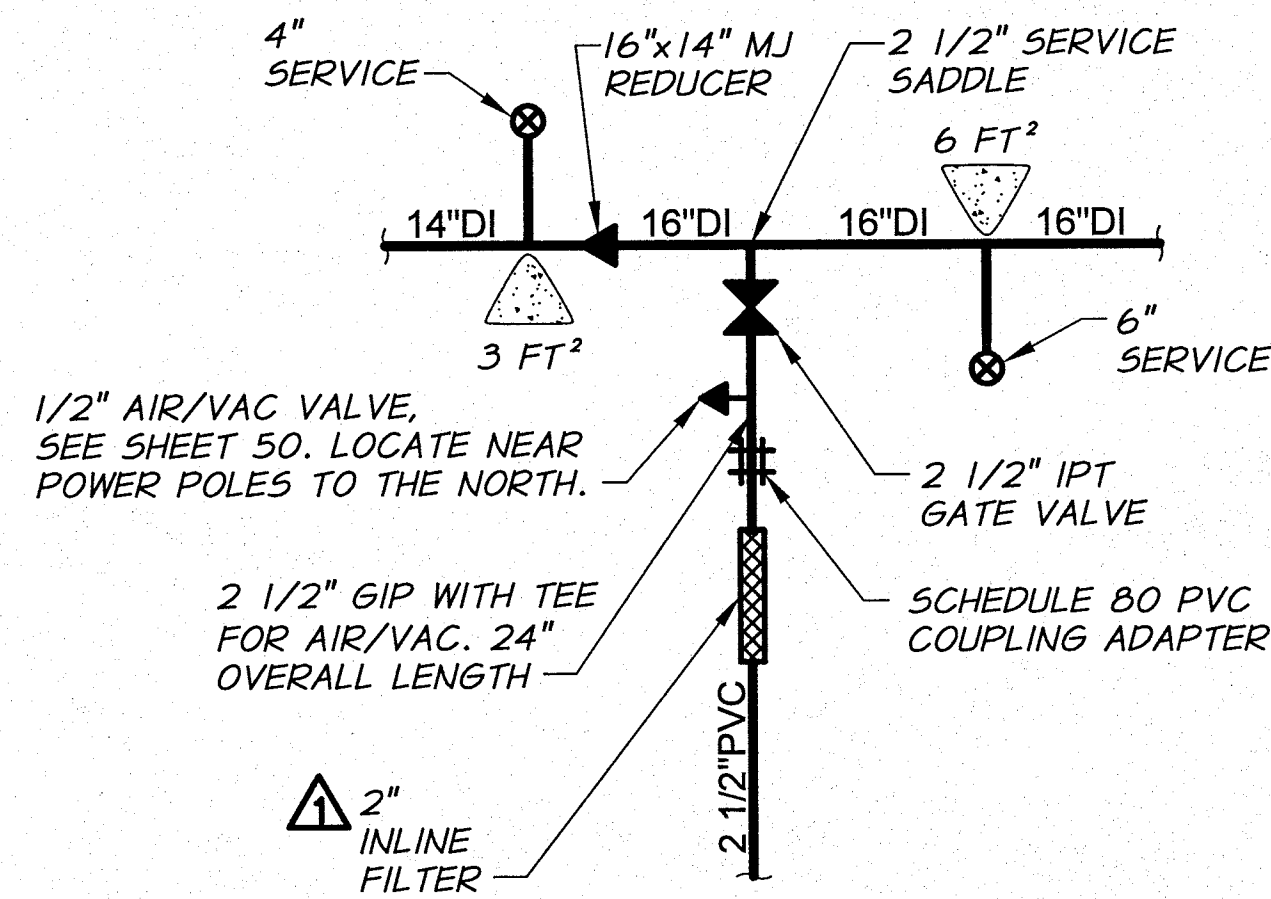


**DETAIL AC**  
REFERENCE SHEET: 15, 33

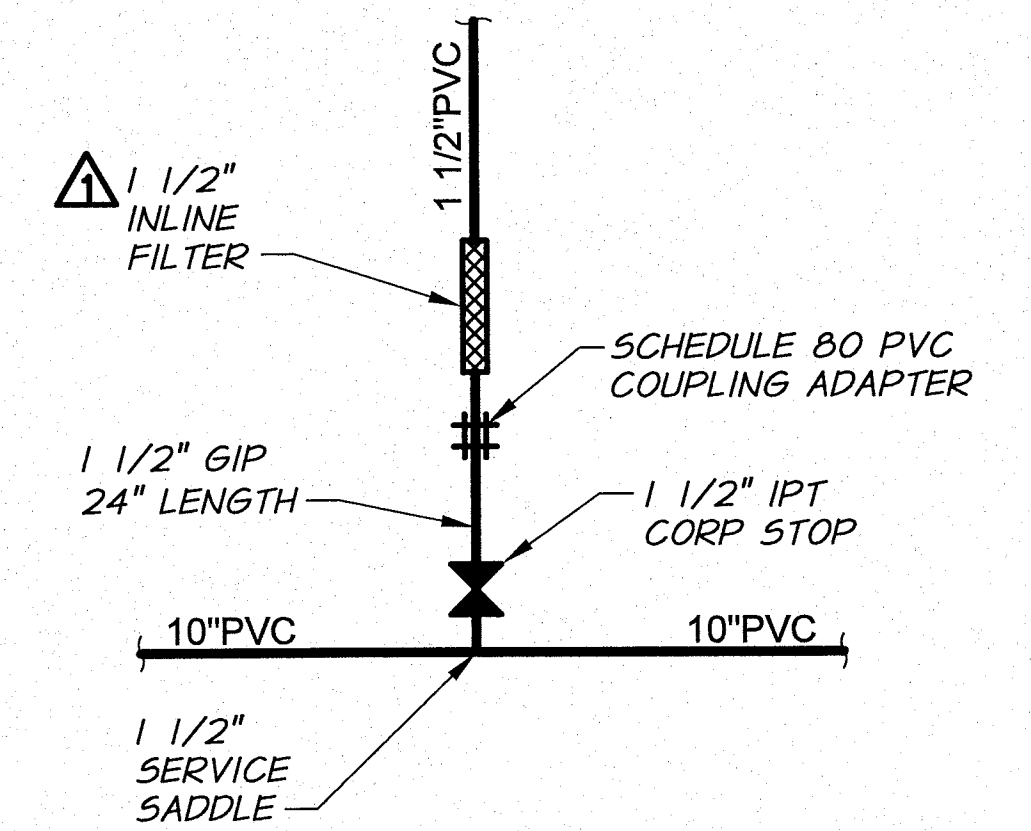


**DETAIL AD**  
REFERENCE SHEET: 18, 32

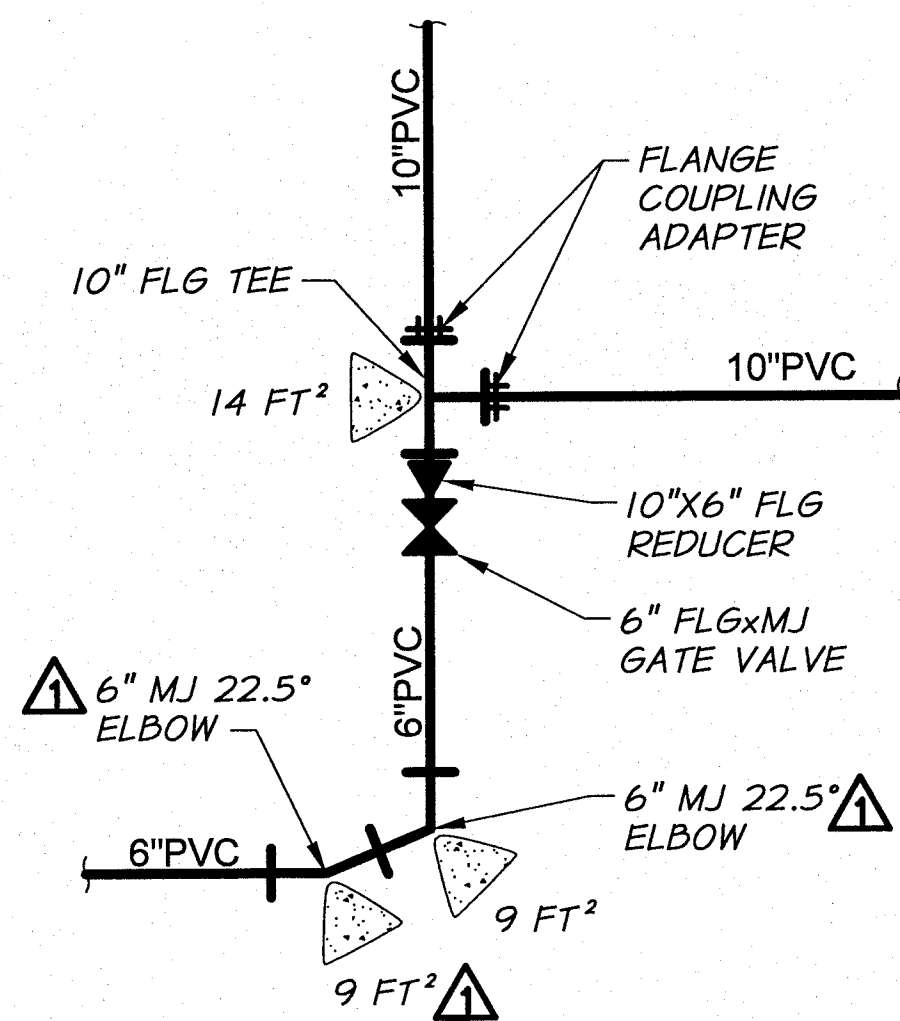


**DETAIL AE**  
REFERENCE SHEET: 19, 31

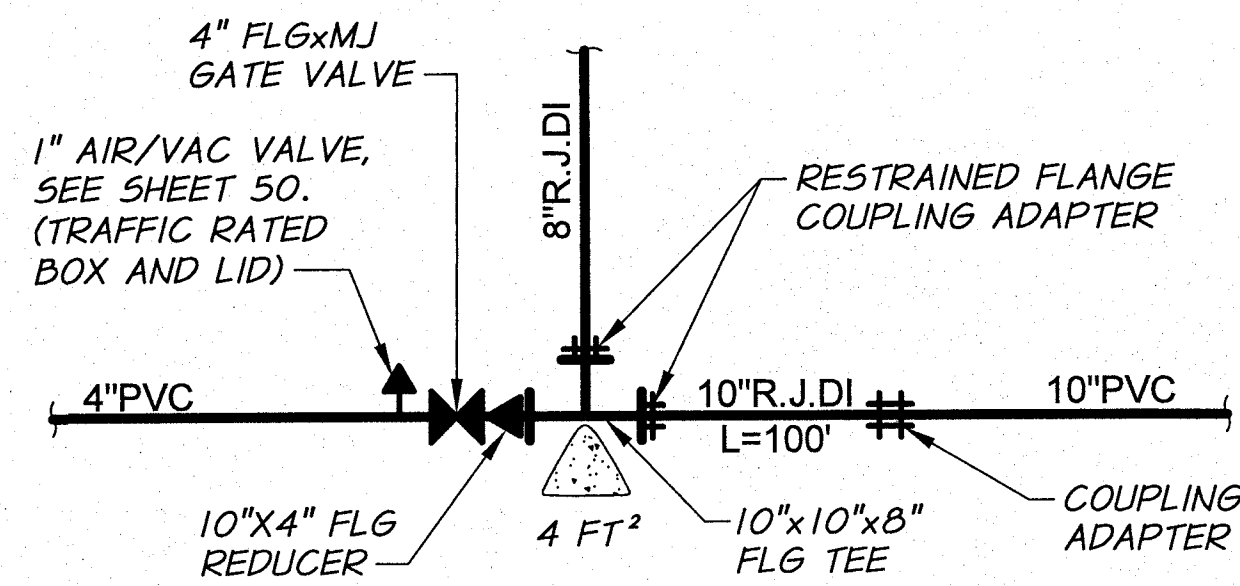


**DETAIL AF**  
REFERENCE SHEET: 19, 20, 25

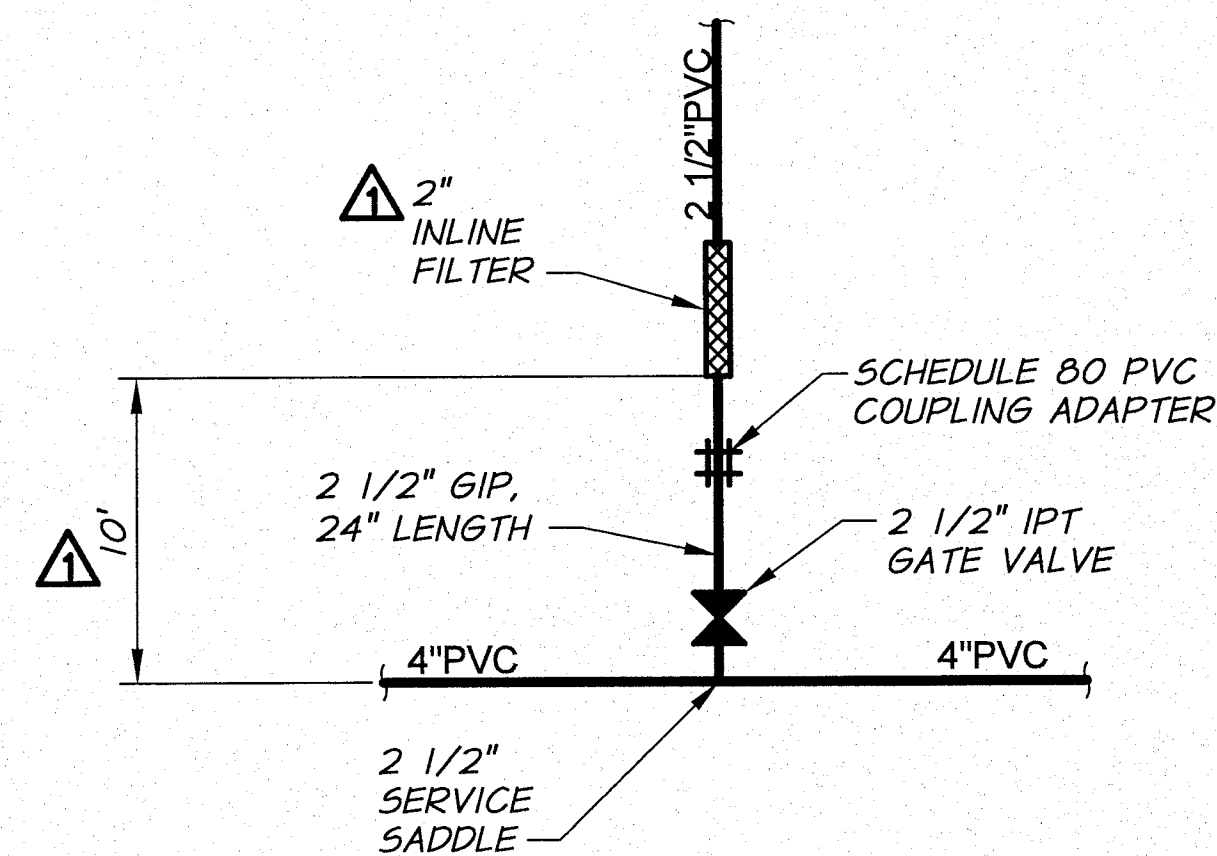


**DETAIL AG**  
REFERENCE SHEET: 20

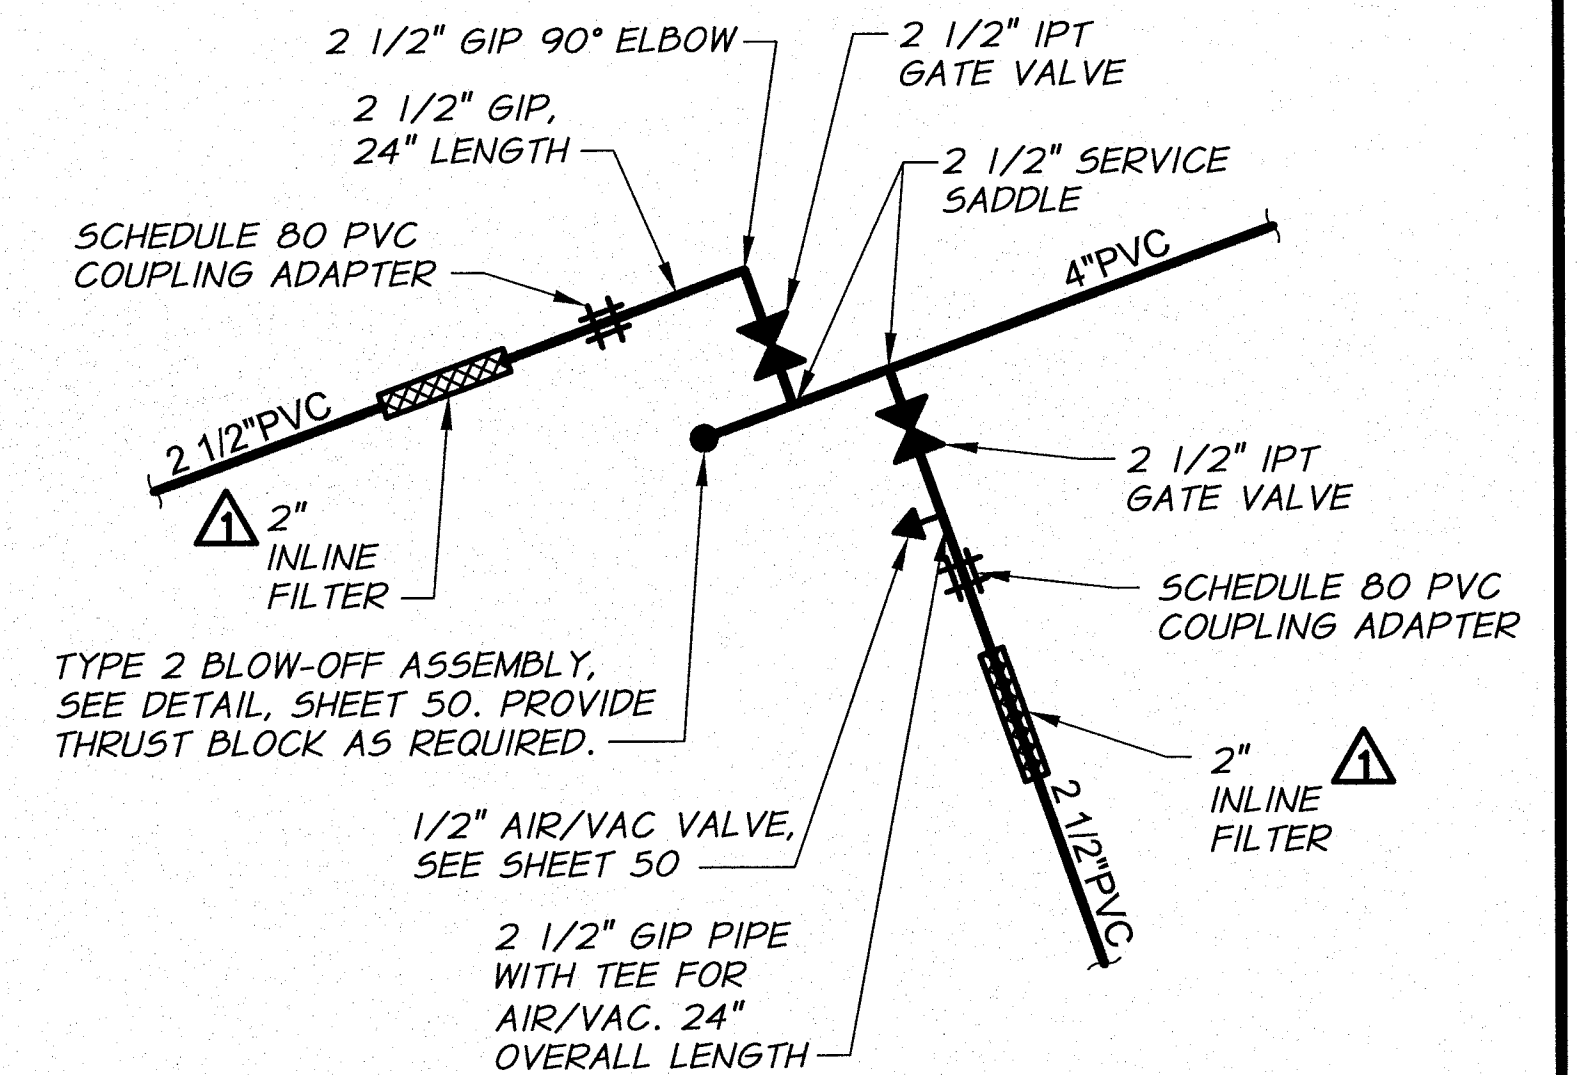

**DETAIL AH**  
REFERENCE SHEET: 23, 24

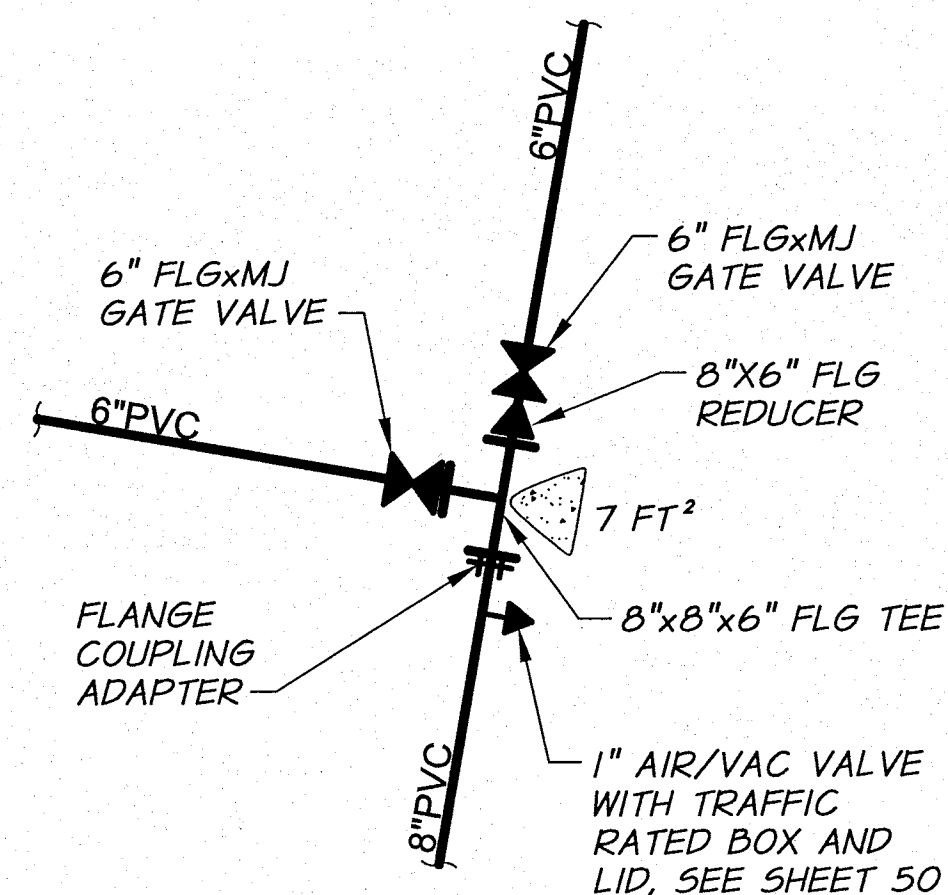

**DETAIL AJ**  
REFERENCE SHEET: 26, 27, 28

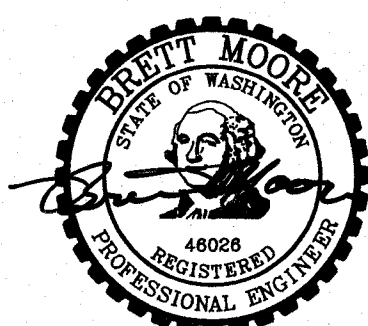


SIGNED 06-04-12  
RECORD DRAWINGS

RECORD DRAWINGS		BY	B.M.	DATE	5/12
DESIGNED BY	R. HARRIS	XREFS:	TB-BID.dwg		
DRAWN BY	D. CHRISTMAN	HORIZ. SCALE	NONE	VERT. SCALE	
REVIEWED BY	B. MOORE	JOB NUMBER	1199-336	DATE	2011
		ACAD FILE:	PipeConnDets-Ph2B.dwg		
		COPYRIGHT 2011 BY ANDERSON-PERRY & ASSOC., INC.			

**RECORD DRAWINGS**

These record drawings have been prepared in part, on the basis of information compiled and furnished by others. They may contain some discrepancies and omissions, and do not necessarily represent "exact" field conditions. The Owner and the Engineer accept no responsibility for their accuracy.

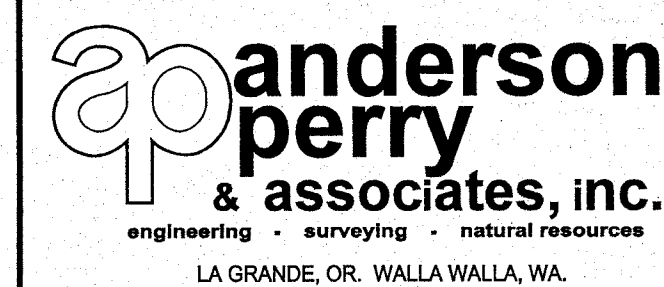


**BENTON IRRIGATION DISTRICT**  
IRRIGATION SYSTEM IMPROVEMENTS  
PHASE 2B

PIPE CONNECTION DETAILS


SHEET

38

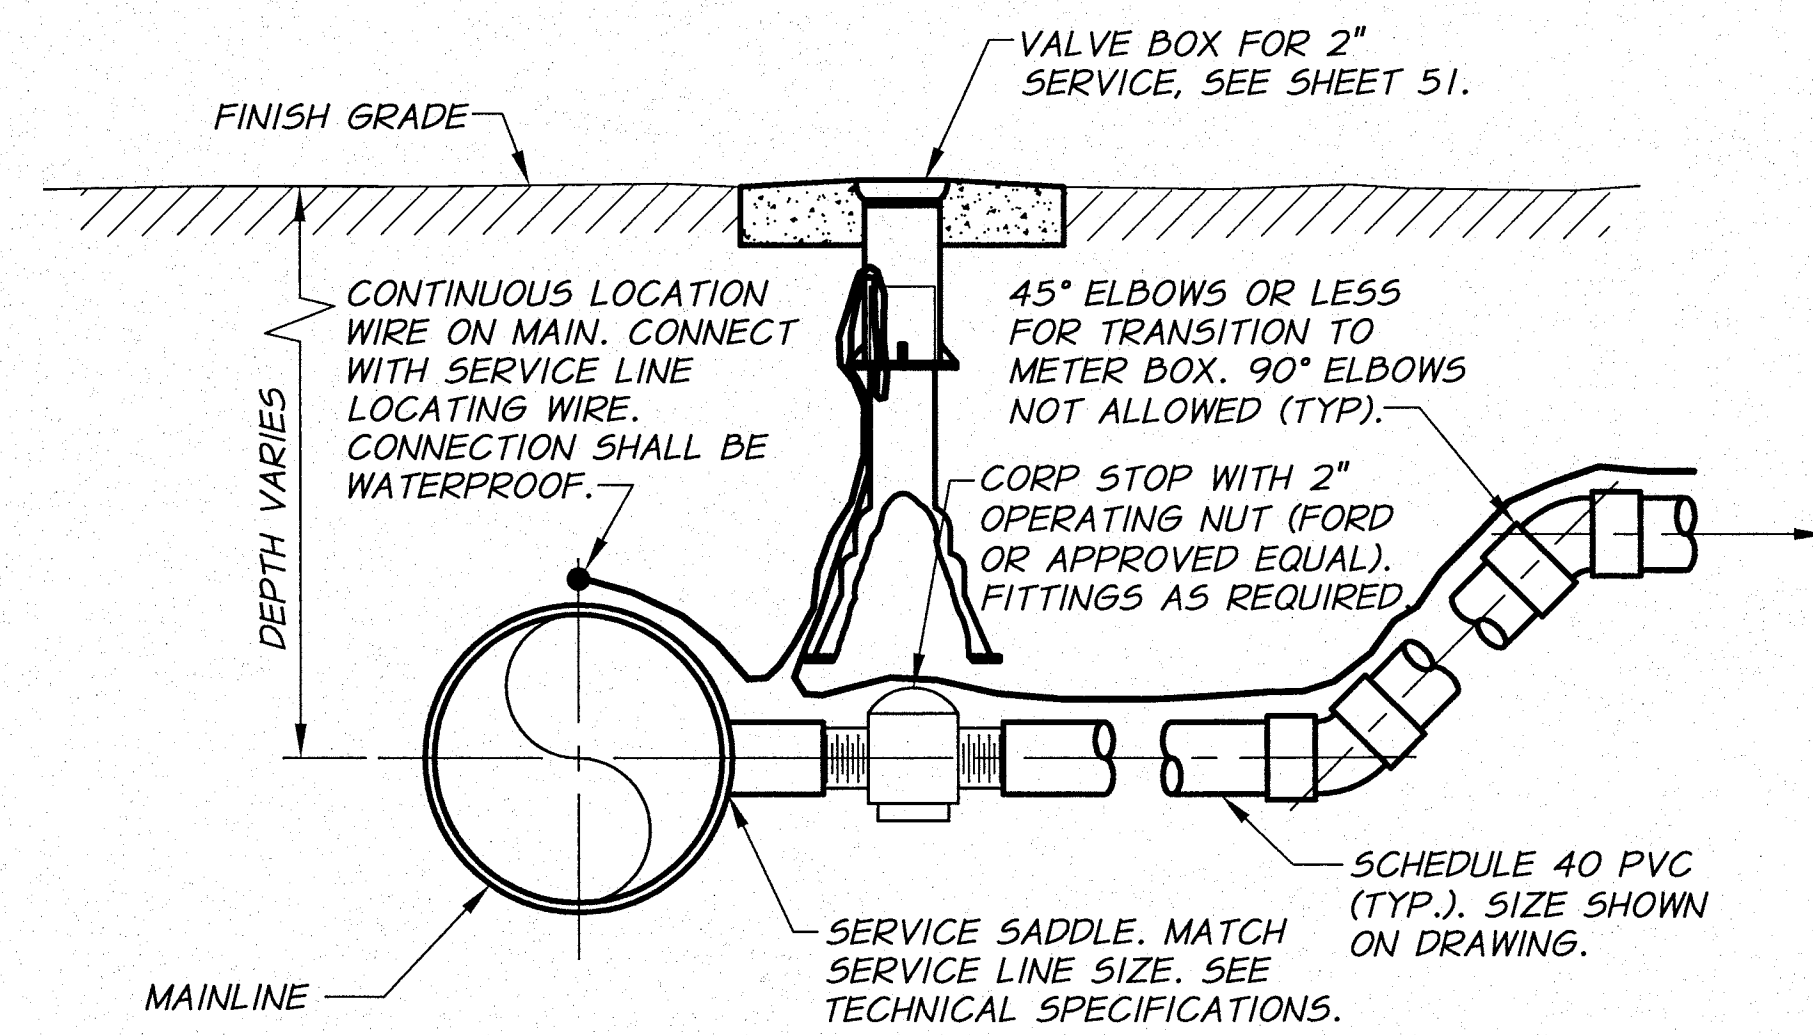


NOTE:  
COORDINATE THE LOCATION OF SERVICE LINE CONNECTION WITH  
B.I.D. PRIOR TO CONSTRUCTION AND INSTALLATION.

**MAIN LINE SERVICE CONNECTION**  
FOR 1.5" AND 2" SERVICE  
N.T.S.

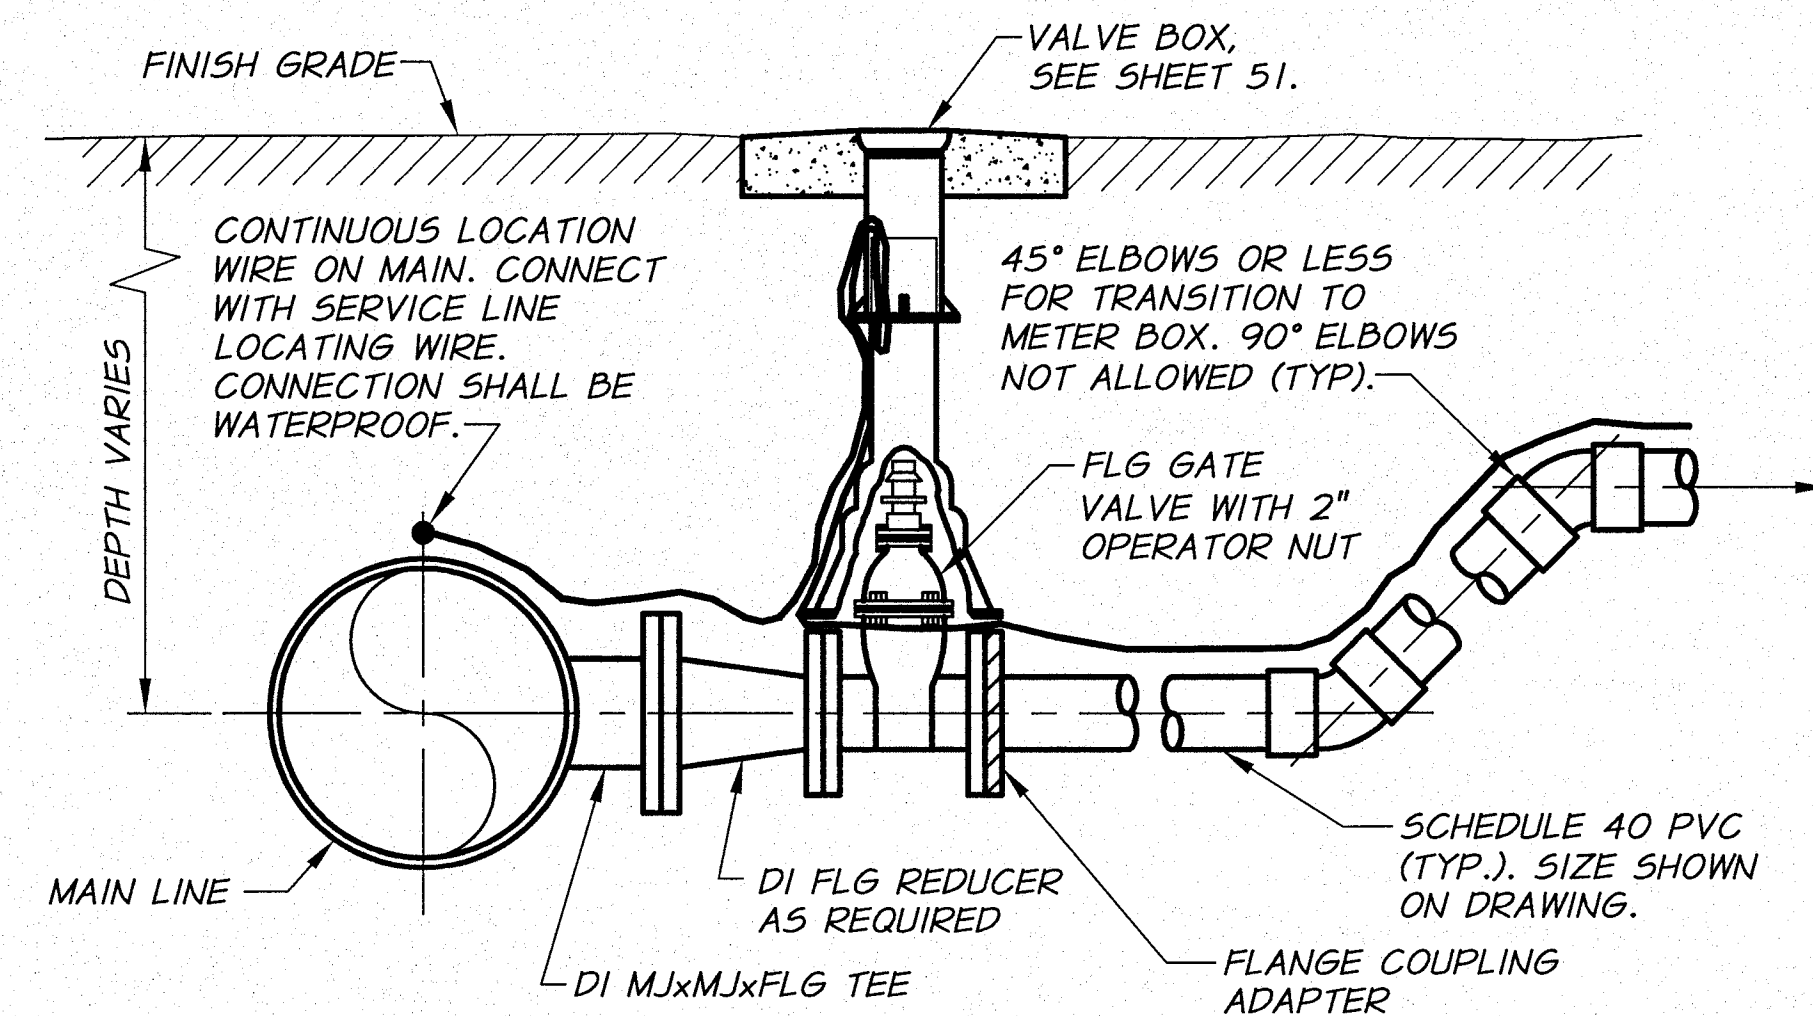

NOTE:  
COORDINATE THE LOCATION OF SERVICE LINE CONNECTION WITH  
B.I.D. PRIOR TO CONSTRUCTION AND INSTALLATION.

**MAIN LINE SERVICE CONNECTION**  
FOR 2.5" AND 3" SERVICE  
N.T.S.

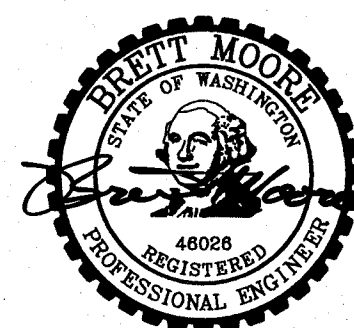


SIGNED 06-04-12  
RECORD DRAWINGS

REVISION	BY	DATE	HORIZ. SCALE	VERT. SCALE
DESIGNED BY	R. HARRIS	XREFS: TB-BID.dwg	JOB NUMBER	1199-336
DRAWN BY	D. CHRISTMAN		DATE	2011
REVIEWED BY	B. MOORE		ACAD FILE	ServiceDets-Ph2B.dwg
COPYRIGHT 2011 BY ANDERSON-PERRY & ASSOC., INC.				

**RECORD DRAWINGS**

These record drawings have been prepared, in part, on the basis of information compiled and furnished by others. They may contain some discrepancies and omissions, and do not necessarily represent "exact" field conditions. The Owner and the Engineer accept no responsibility for their accuracy.

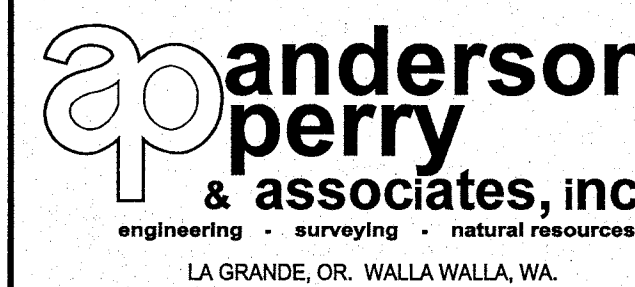


engineering • surveying • natural resources  
LA GRANDE, OR. WALLA WALLA, WA.

**BENTON IRRIGATION DISTRICT**  
IRRIGATION SYSTEM IMPROVEMENTS  
PHASE 2B

SERVICE DETAILS I

SHEET

39

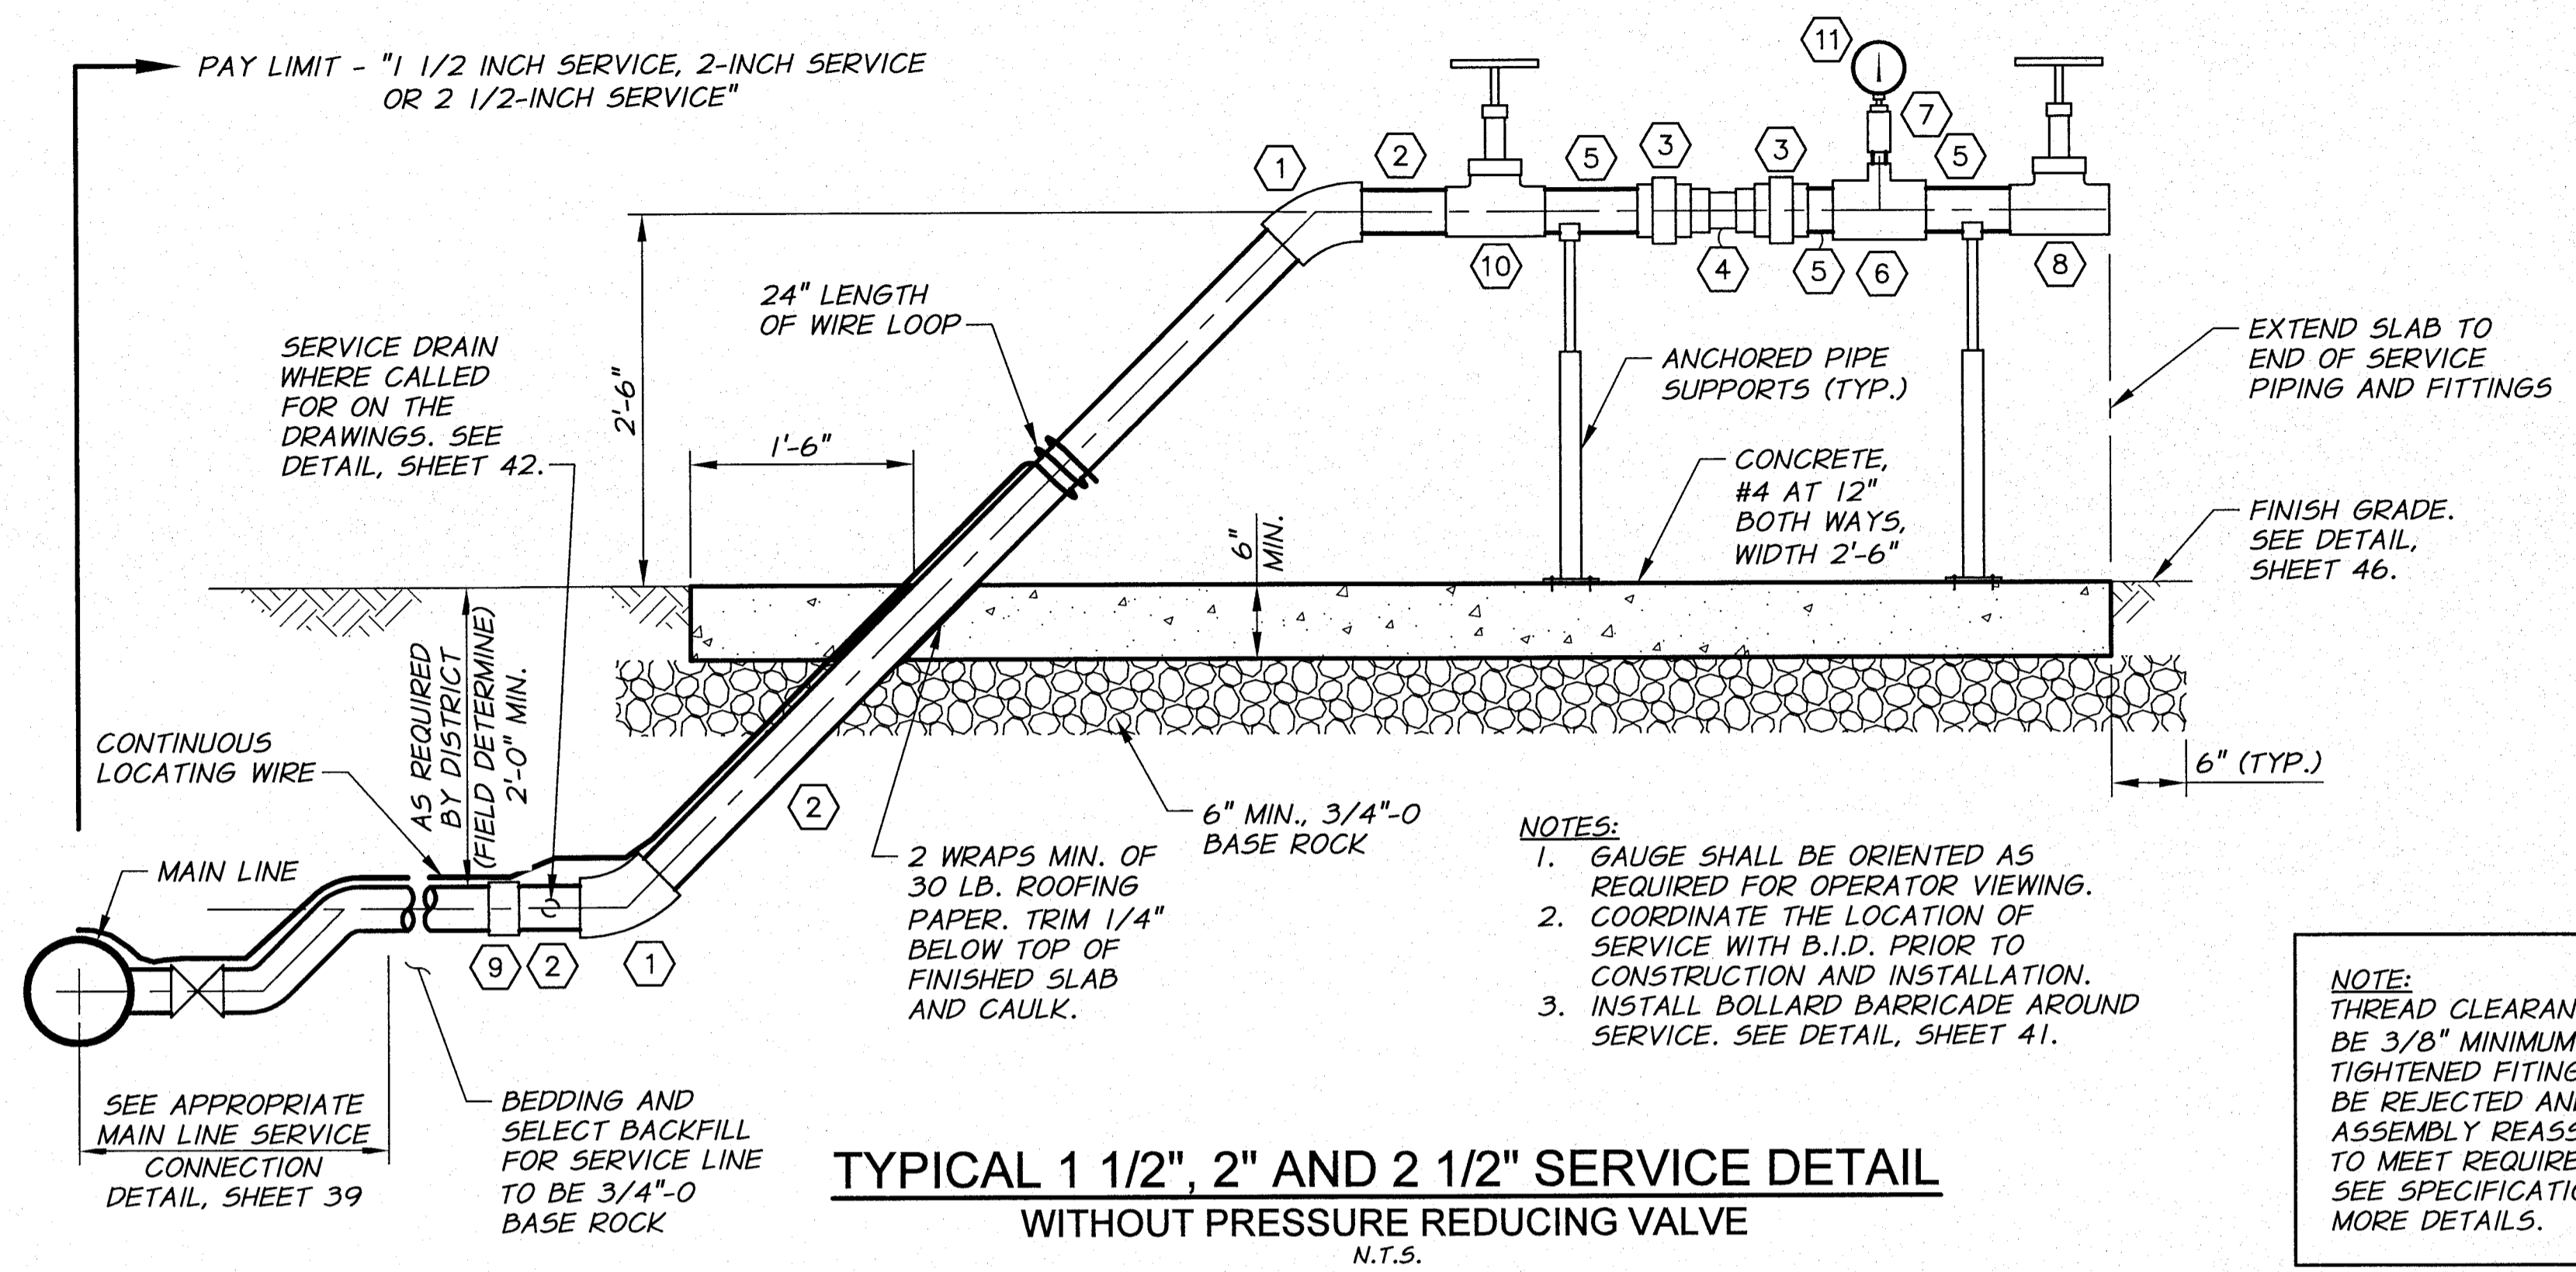


**TYPICAL 1 1/2", 2" AND 2 1/2" SERVICE DETAIL**  
 WITHOUT PRESSURE REDUCING VALVE  
 N.T.S.

- NOTES:**
1. GAUGE SHALL BE ORIENTED AS REQUIRED FOR OPERATOR VIEWING.
  2. COORDINATE THE LOCATION OF SERVICE WITH B.I.D. PRIOR TO CONSTRUCTION AND INSTALLATION.
  3. INSTALL BOLLARD BARRICADE AROUND SERVICE. SEE DETAIL, SHEET 41.

**NOTE:**  
 THREAD CLEARANCE SHALL BE 3/8" MINIMUM. OVER TIGHTENED FITTINGS WILL BE REJECTED AND PIPING ASSEMBLY REASSEMBLED TO MEET REQUIREMENTS. SEE SPECIFICATIONS FOR MORE DETAILS.

**SERVICE FITTING SCHEDULE**

- ① G.I.P. 45° ELBOW
- ② SCH. 40 G.I.P. PIPE
- ③ G.I.P. UNION
- ④ DOLE FLOW CONTROL VALVE. SIZE AS SHOWN ON PLANS. INSTALL WITH FLOW RATE LABEL FACING UPWARDS AND NO WRENCH MARKS ON VALVE.
- ⑤ THREADED SCH. 40 G.I.P. SPOOL, LENGTH AS REQUIRED.
- ⑥ SIZE x 3/4" G.I.P. TEE
- ⑦ 3/4" THREADED BRASS BALL VALVE WITH 3/4"x1/4" BUSHING AND BRASS QUICK COUPLING PLUG (UNVALVED)
- ⑧ BRASS THREADED GATE VALVE
- ⑨ SCH 80 PVC TRANSITION COUPLING AND FITTINGS AS REQ'D. FEMALE CONNECTION TO GIP.
- ⑩ LOCKING THREADED BRASS GATE VALVE WITH BUSHINGS AS REQ'D. USE 1 1/2" VALVE FOR 1 1/2" SERVICE, USE 2" VALVE FOR 2" OR 2 1/2" SERVICE
- ⑪ BRASS QUICK COUPLING SOCKET (UNVALVED). GAUGE BY OWNER

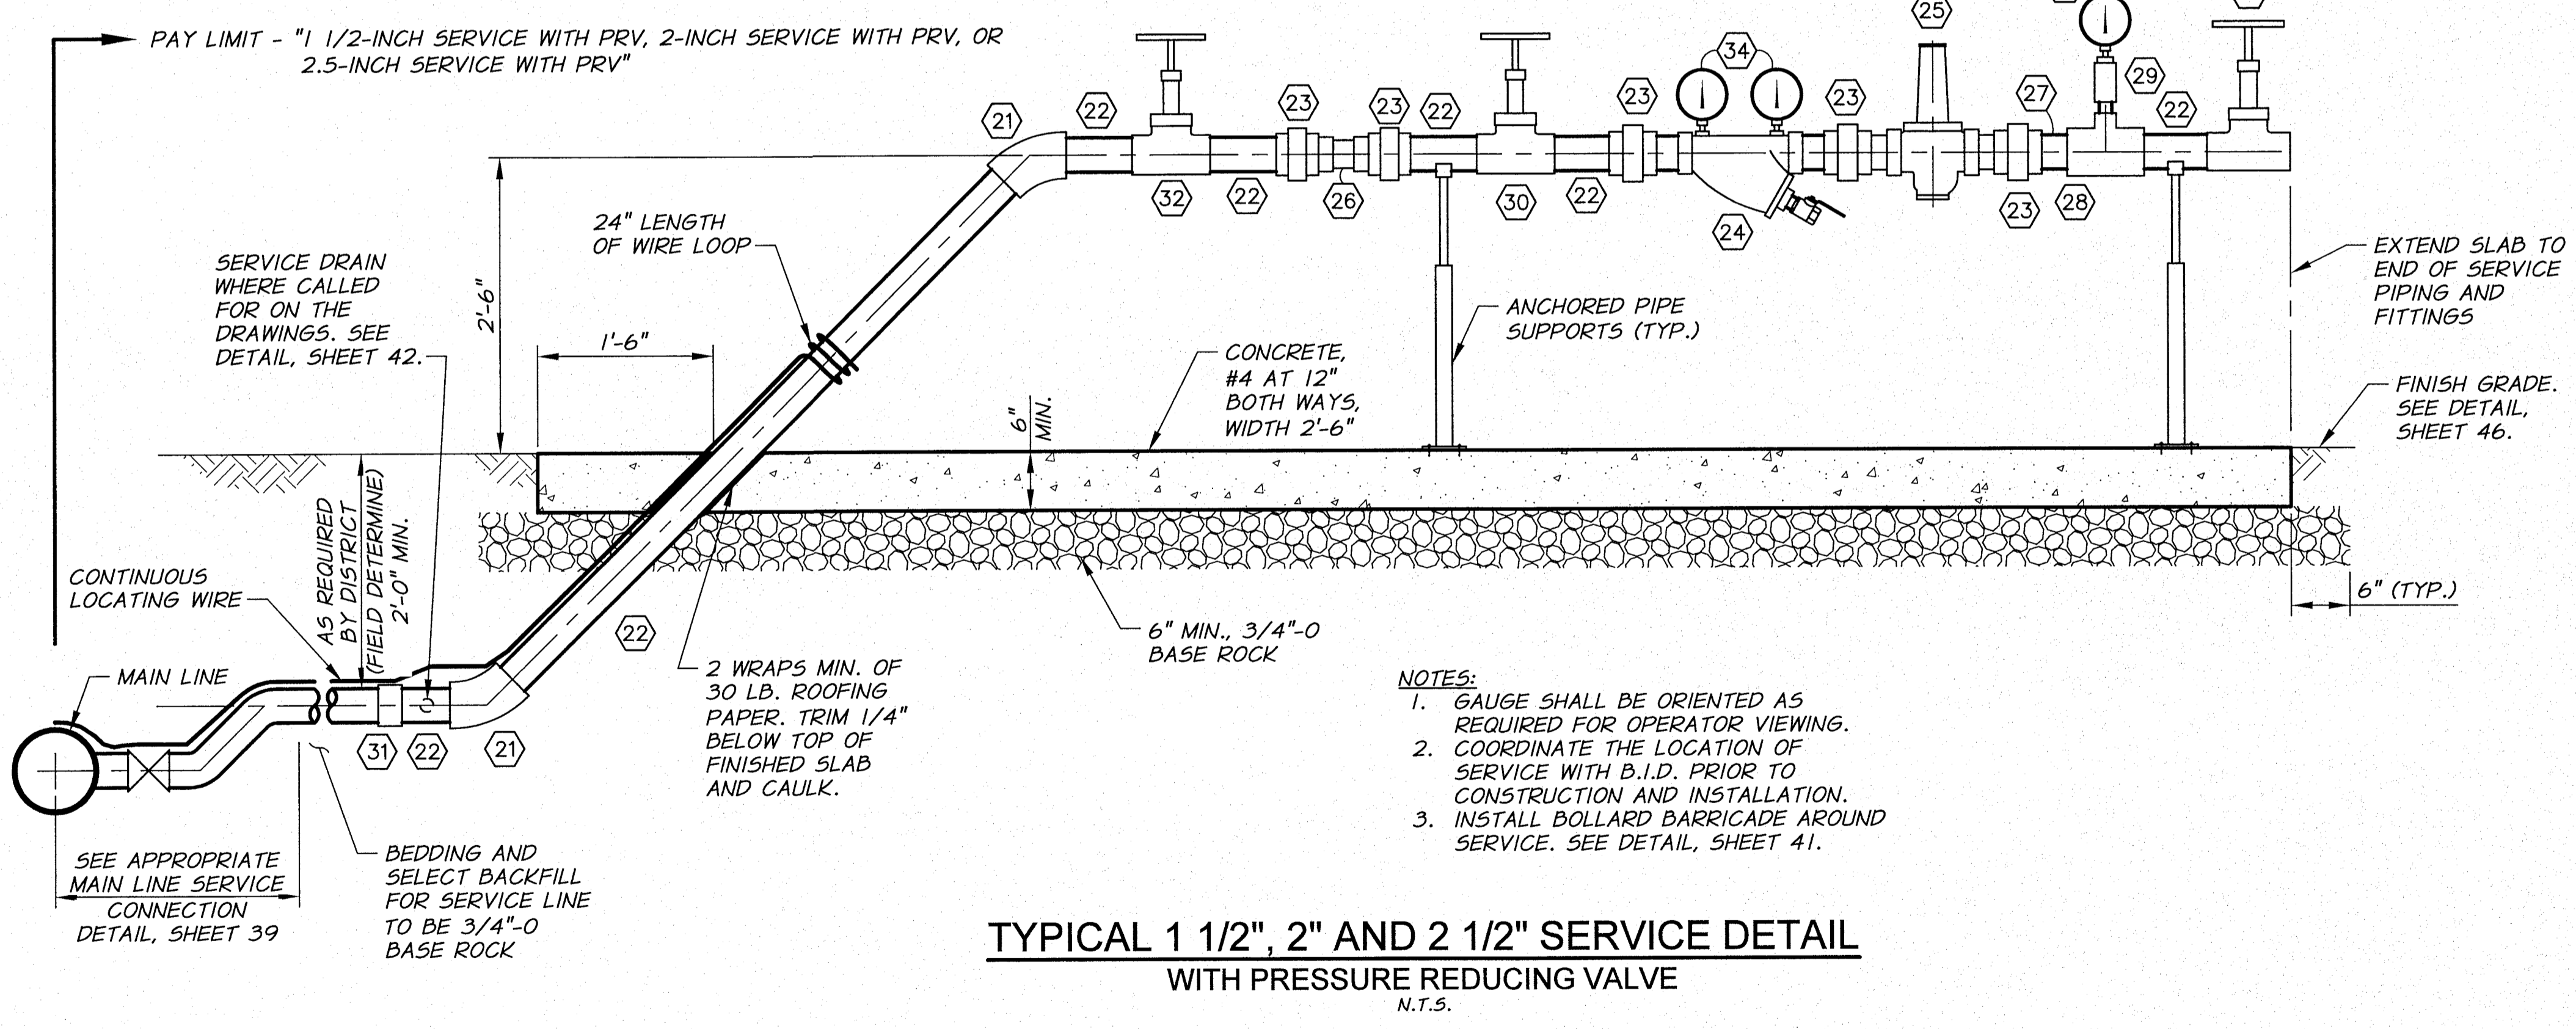


**TYPICAL 1 1/2", 2" AND 2 1/2" SERVICE DETAIL**  
 WITH PRESSURE REDUCING VALVE  
 N.T.S.

- NOTES:**
1. GAUGE SHALL BE ORIENTED AS REQUIRED FOR OPERATOR VIEWING.
  2. COORDINATE THE LOCATION OF SERVICE WITH B.I.D. PRIOR TO CONSTRUCTION AND INSTALLATION.
  3. INSTALL BOLLARD BARRICADE AROUND SERVICE. SEE DETAIL, SHEET 41.

**SERVICE FITTING SCHEDULE**


- ⑲ G.I.P. 45° ELBOW
- ⑳ SCH. 40 G.I.P. PIPE
- ㉓ G.I.P. UNION OR G.I.P. REDUCING UNION AS REQUIRED
- ㉔ SONNTAG ALUMINUM Y-FILTER WITH 40 MESH FILTER SCREEN. 1 1/4" FOR 1 1/2" SERVICE, 2" FOR 2" SERVICE, 3" FOR 2.5" SERVICE WITH FITTINGS AS REQUIRED
- ㉕ CLA-VAL 990 PRESSURE REDUCING VALVE. SIZE AS SHOWN ON PLANS. SEE TECHNICAL SPECIFICATIONS FOR DETAILS.
- ㉖ DOLE FLOW CONTROL VALVE. SIZE AS SHOWN ON PLANS. INSTALL WITH FLOW RATE LABEL FACING UPWARDS AND NO WRENCH MARKS ON VALVE.
- ㉗ SCH. 40 G.I.P. SPOOL
- ㉘ SIZE x 3/4" G.I.P. TEE
- ㉙ 3/4" THREADED BRASS BALL VALVE WITH 3/4"x1/4" BUSHING AND BRASS QUICK COUPLING PLUG (UNVALVED)
- ㉚ BRASS THREADED GATE VALVE
- ㉛ SCH 80 PVC TRANSITION COUPLING AND FITTINGS AS REQ'D. FEMALE CONNECTION TO GIP.
- ㉜ LOCKING THREADED BRASS GATE VALVE WITH BUSHINGS AS REQ'D. USE 1 1/2" VALVE FOR 1 1/2" SERVICE, USE 2" VALVE FOR 2" OR 2 1/2" SERVICE
- ㉝ BRASS QUICK COUPLING SOCKET (UNVALVED) GAUGE BY OWNER.
- ㉞ 4" 55 GLYCERIN FILLED PRESSURE GAUGE, FITTINGS AS REQUIRED

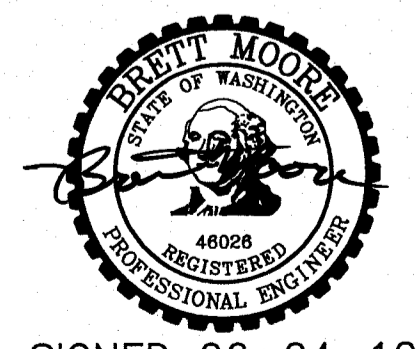

SIGNED 06-04-12  
 RECORD DRAWINGS


REVISION	BY	DATE	HORIZ. SCALE	NONE	VERT. SCALE
DESIGNED BY	R. HARRIS	XREFS: TB-BID.dwg	JOB NUMBER	1199-336	DATE
DRAWN BY	D. CHRISTMAN		ACAD FILE	ServiceDets-Ph2B.dwg	
REVIEWED BY	B. MOORE		COPYRIGHT 2011 BY ANDERSON-PERRY & ASSOC., INC.		

**RECORD DRAWINGS**  
 These record drawings have been prepared, in part, on the basis of information compiled and furnished by others. They may contain some discrepancies and omissions, and do not necessarily represent "exact" field conditions. The Owner and the Engineer accept no responsibility for their accuracy.

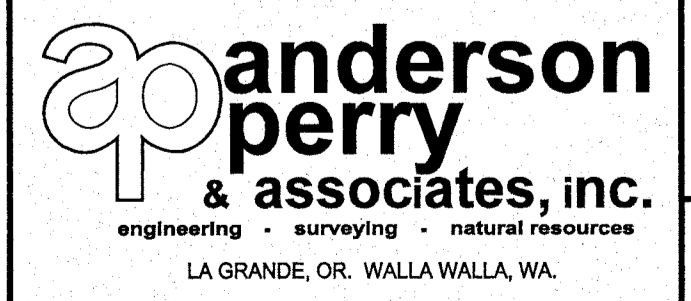

**BENTON IRRIGATION DISTRICT**  
 IRRIGATION SYSTEM IMPROVEMENTS  
 PHASE 2B  
 SERVICE DETAILS II


NOTE:  
THREAD CLEARANCE SHALL BE 3/8" MINIMUM. OVER TIGHTENED FITTINGS WILL BE REJECTED AND PIPING ASSEMBLY REASSEMBLED TO MEET REQUIREMENTS. SEE SPECIFICATIONS FOR MORE DETAILS.

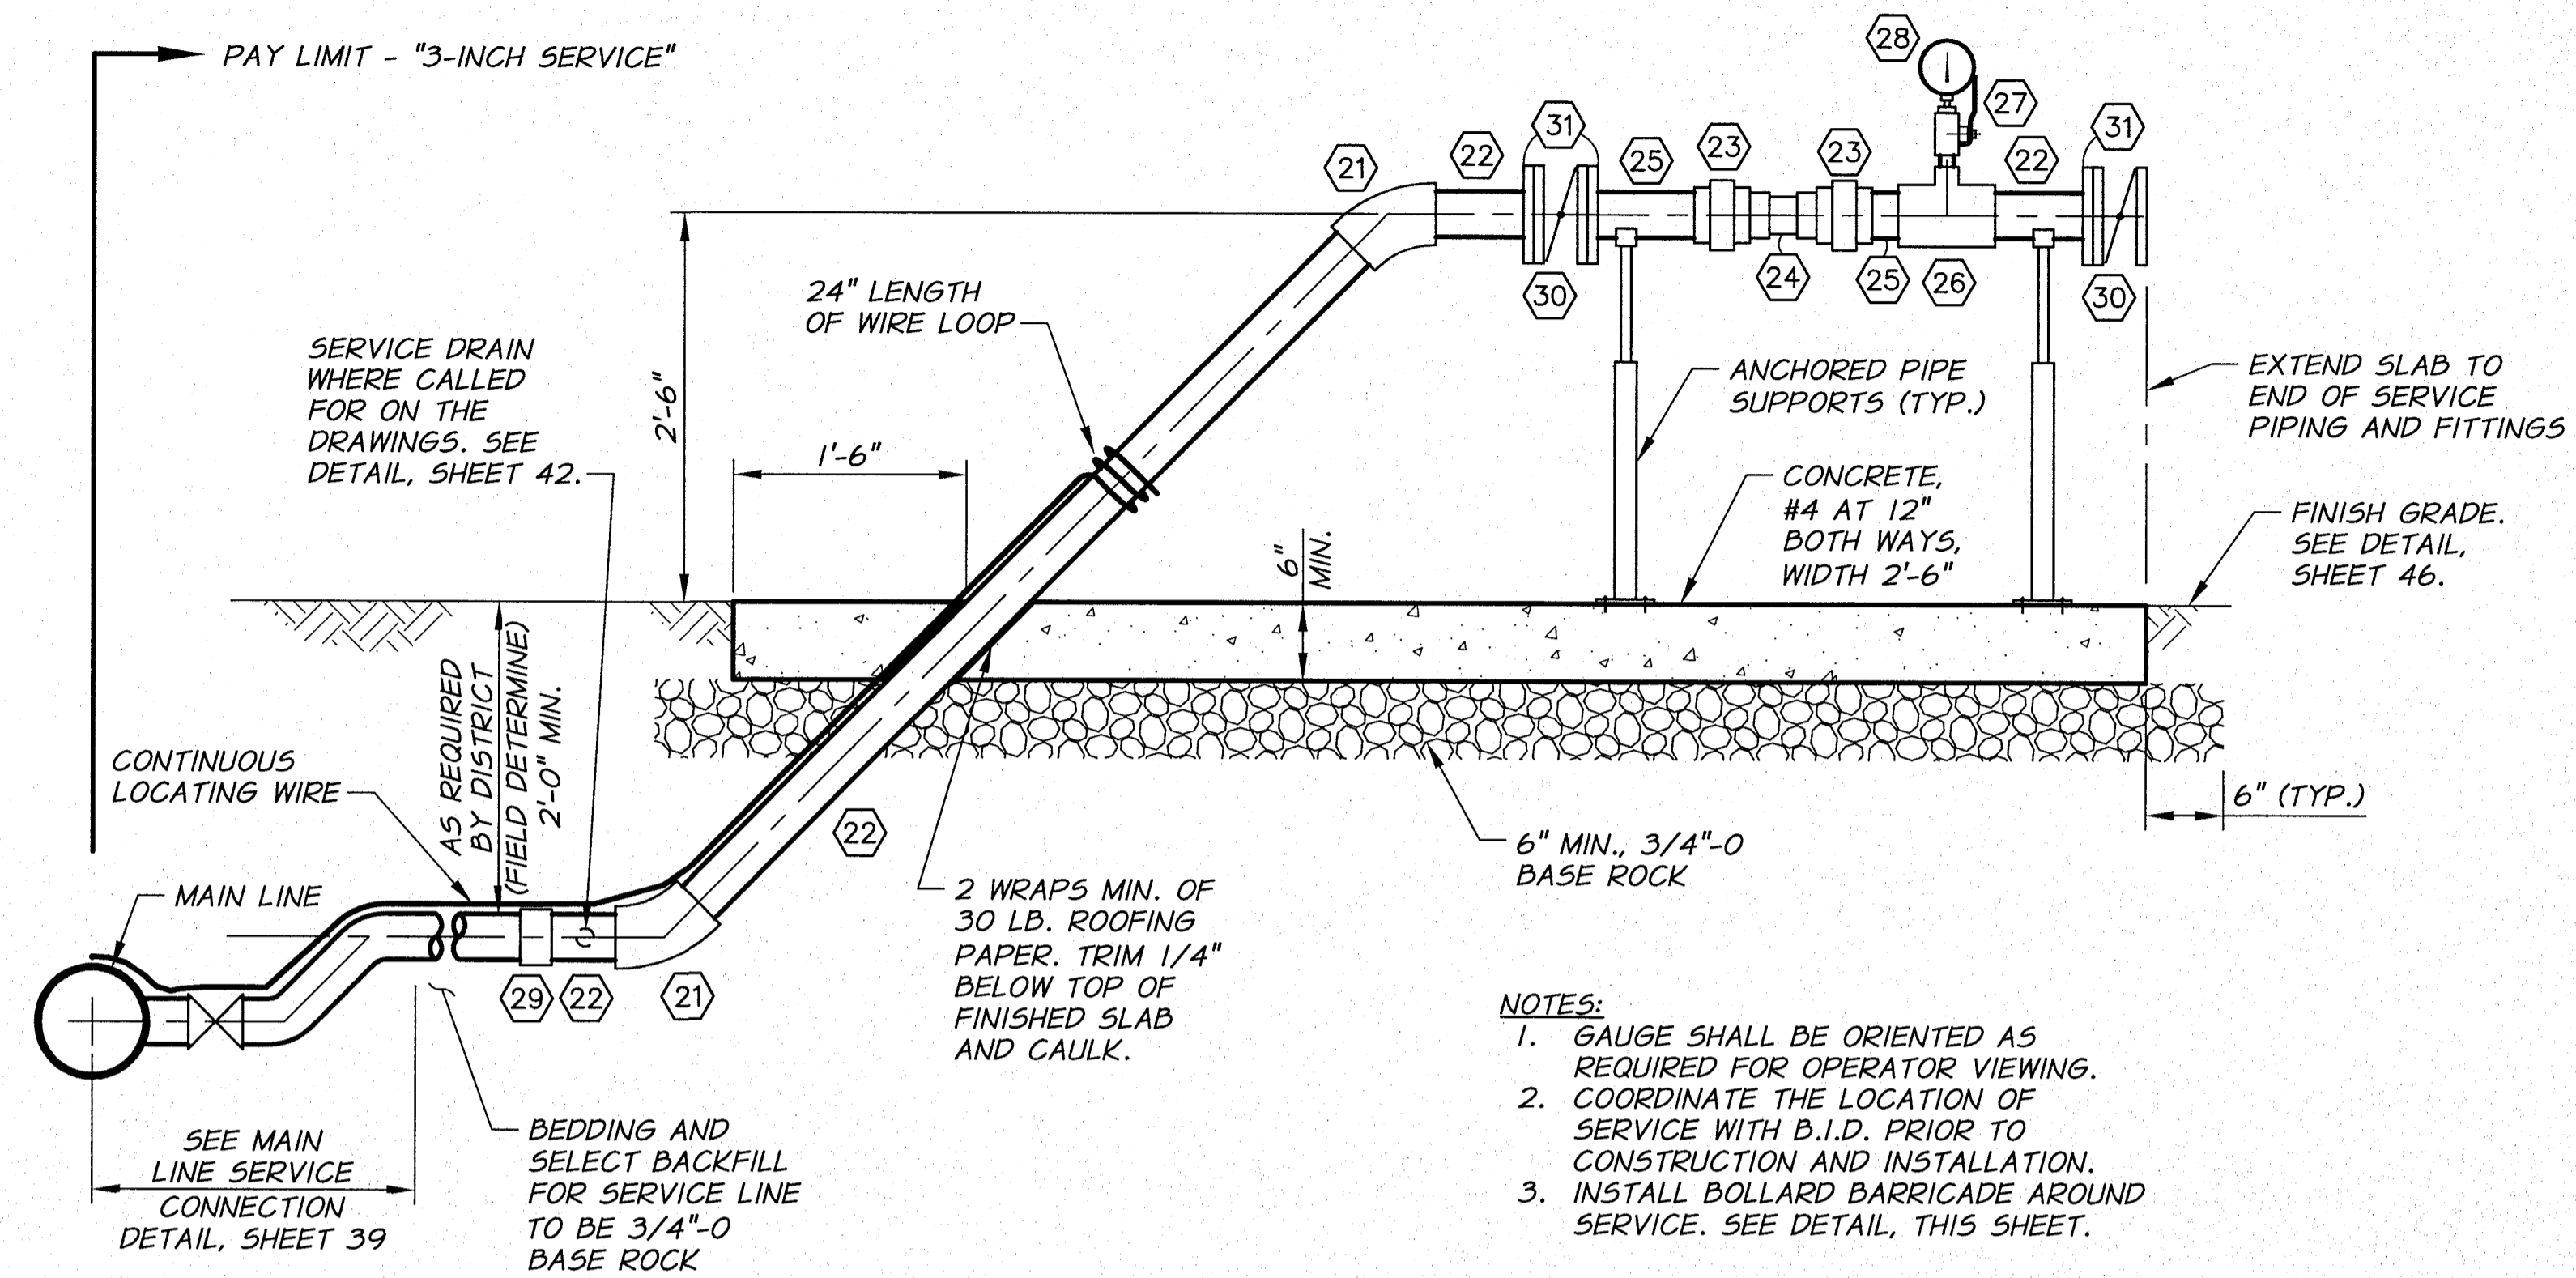


TYPICAL 3" SERVICE DETAIL  
WITHOUT PRESSURE REDUCING VALVE  
N.T.S.

SERVICE FITTING SCHEDULE

- (21) G.I.P. ELBOW
- (22) SCH. 40 G.I.P. PIPE
- (23) G.I.P. UNION OR G.I.P. REDUCING UNION AS REQUIRED
- (24) DOLE FLOW CONTROL VALVE. SIZE AS SHOWN ON PLANS. INSTALL WITH FLOW RATE LABEL FACING UPWARDS AND NO WRENCH MARKS ON VALVE.
- (25) THREADED SCH. 40 G.I.P. SPOOL, LENGTH AS REQUIRED.
- (26) SIZE x 3/4" G.I.P. TEE
- (27) 3/4" THREADED BRASS BALL VALVE WITH 3/4"x1/4" BUSHING AND BRASS QUICK COUPLING PLUG (UNVALVED)
- (28) BRASS QUICK COUPLING SOCKET (UNVALVED) GAUGE BY OWNER
- (29) SCH 80 PVC TRANSITION COUPLING AND FITTINGS AS REQ'D. FEMALE CONNECTION TO GIP.
- (30) 3" BUTTERFLY VALVE WITH WHEEL OPERATOR AND POSITION INDICATOR
- (31) FLG ADAPTER

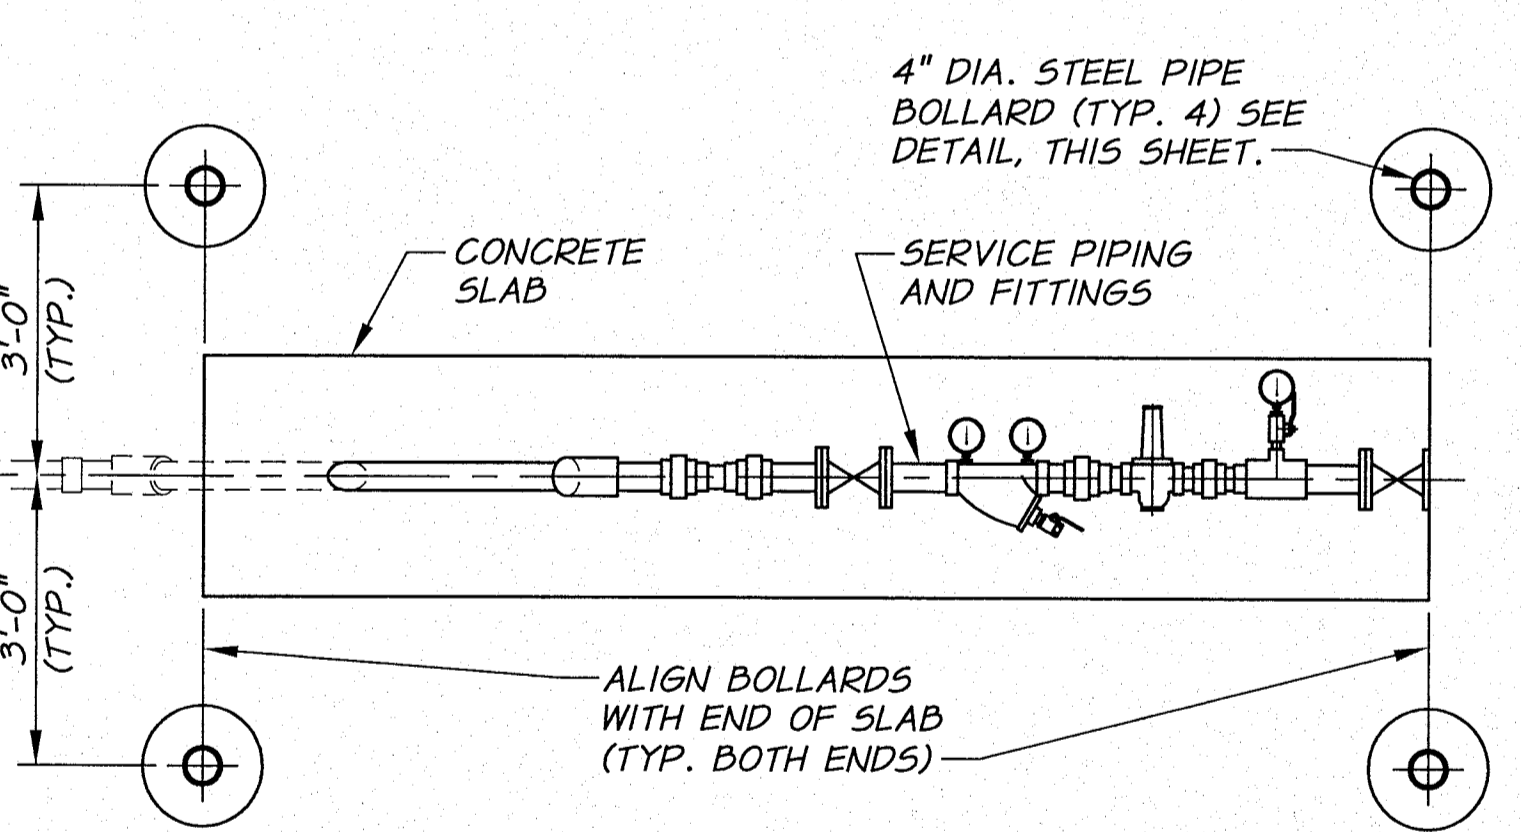


ABOVE GROUND SERVICE BARRICADE DETAIL  
PLAN  
N.T.S.

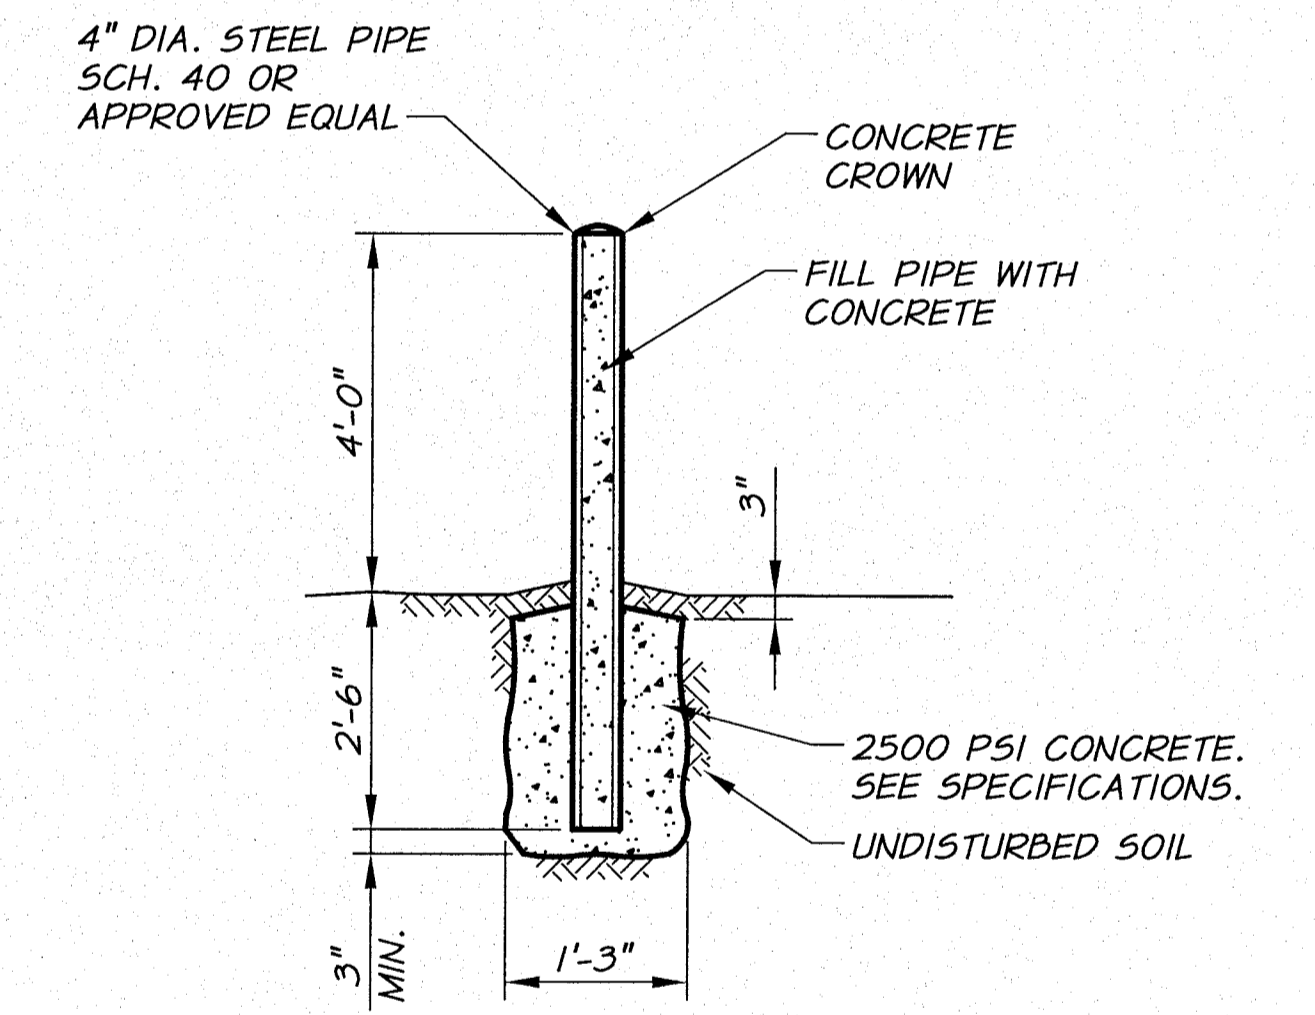


- NOTES:
- 4" DIA. STEEL PIPE SHALL BE PLUMB.
  - PAINTING SHALL BE DONE ONLY AFTER SURFACE IS FREE OF RUST, OIL, AND GREASE. THE METAL SHALL BE PRIMED AND TWO FINISH COATS APPLIED, YELLOW IN COLOR.

BOLLARD DETAIL  
N.T.S.

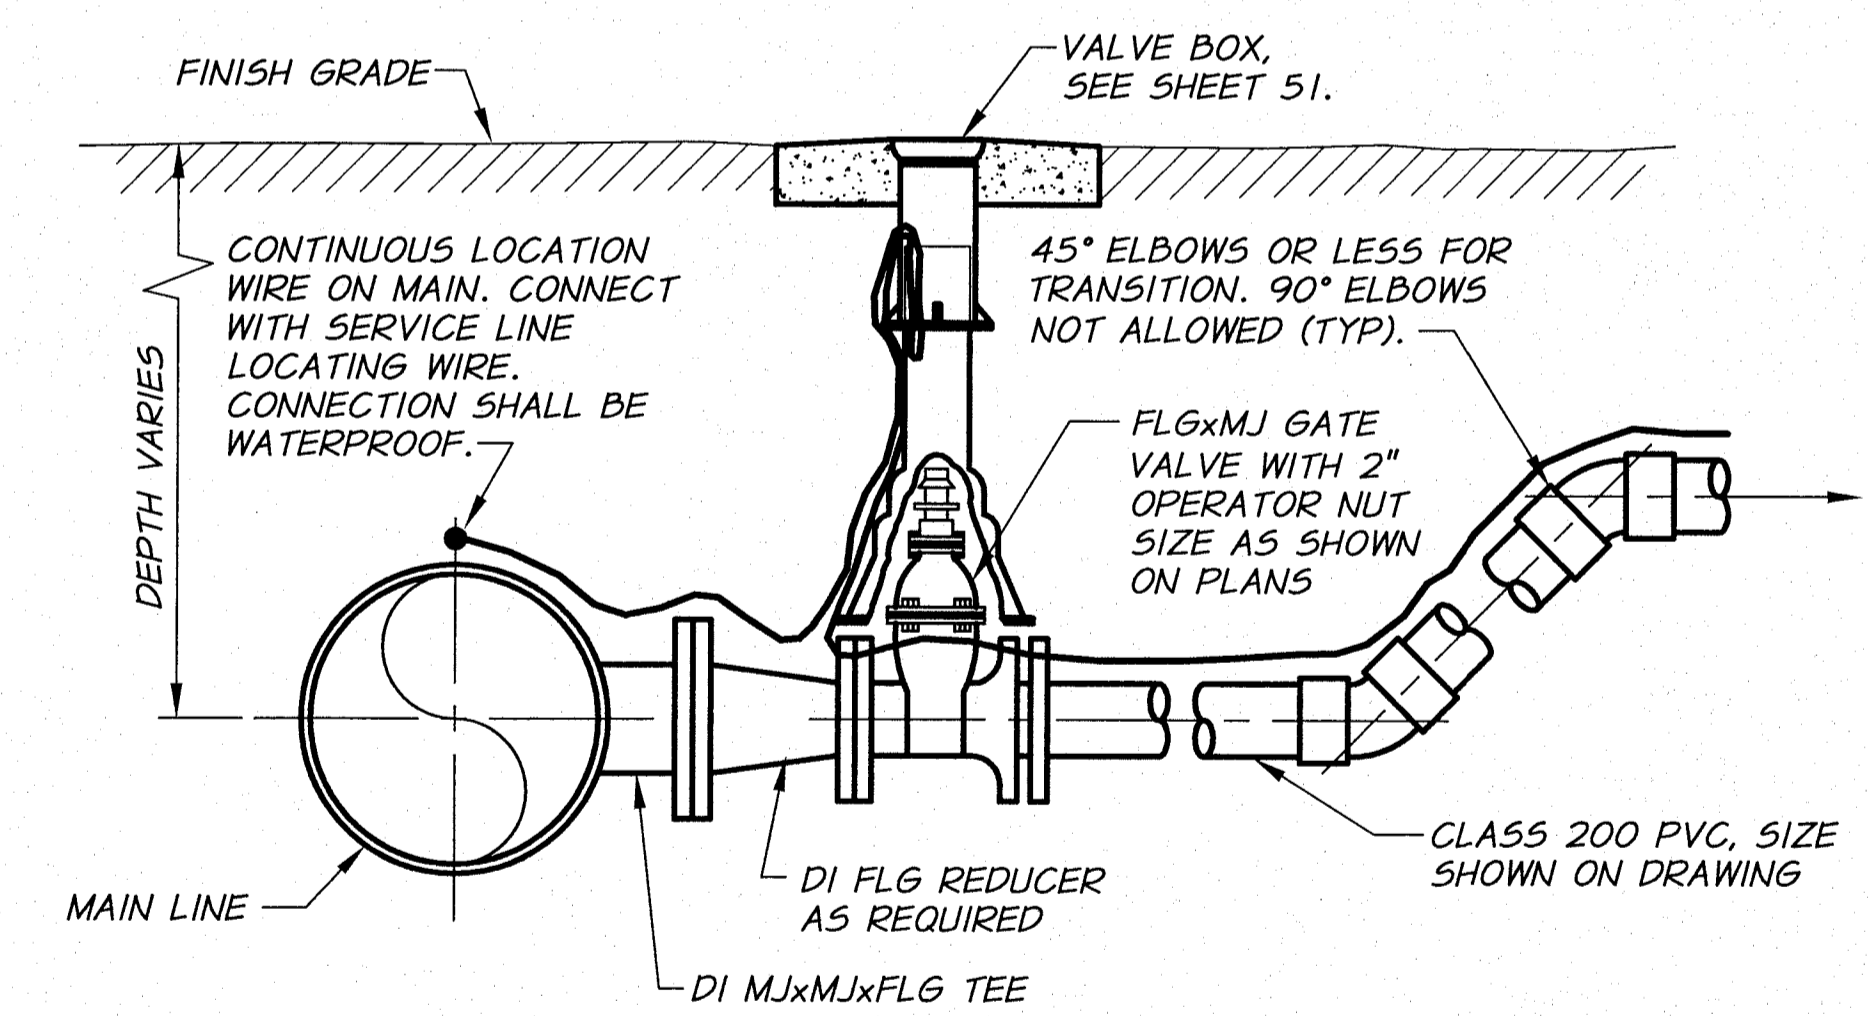

NOTE:  
COORDINATE THE LOCATION OF SERVICE LINE CONNECTION WITH B.I.D. PRIOR TO CONSTRUCTION AND INSTALLATION.


MAIN LINE SERVICE CONNECTION  
FOR 4" SERVICE AND LARGER  
N.T.S.

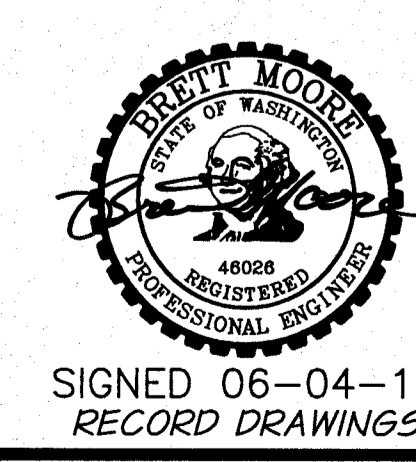


SIGNED 06-04-12  
RECORD DRAWINGS

REVISION	BY	DATE	HORIZ. SCALE NONE	VERT. SCALE
DESIGNED BY R. HARRIS	XREFS: TB-BID.dwg		JOB NUMBER 1199-336	DATE 2011
DRAWN BY D. CHRISTMAN			ACAD FILE: ServiceDets-Ph2B.dwg	
REVIEWED BY B. MOORE			COPYRIGHT 2011 BY ANDERSON-PERRY & ASSOC., INC.	

RECORD DRAWINGS  
These record drawings have been prepared, in part, on the basis of information compiled and furnished by others. They may contain some discrepancies and omissions, and do not necessarily represent "exact" field conditions. The Owner and the Engineer accept no responsibility for their accuracy.

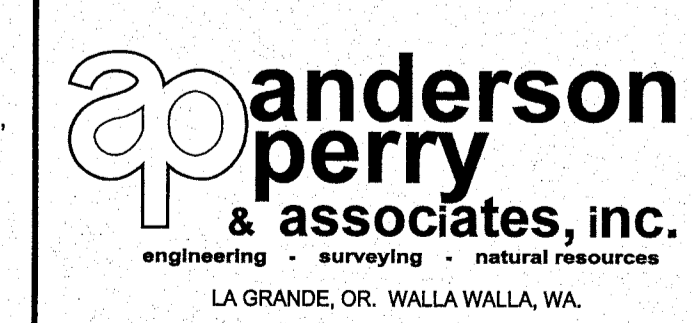

BENTON IRRIGATION DISTRICT  
IRRIGATION SYSTEM IMPROVEMENTS  
PHASE 2B  
SERVICE DETAILS III

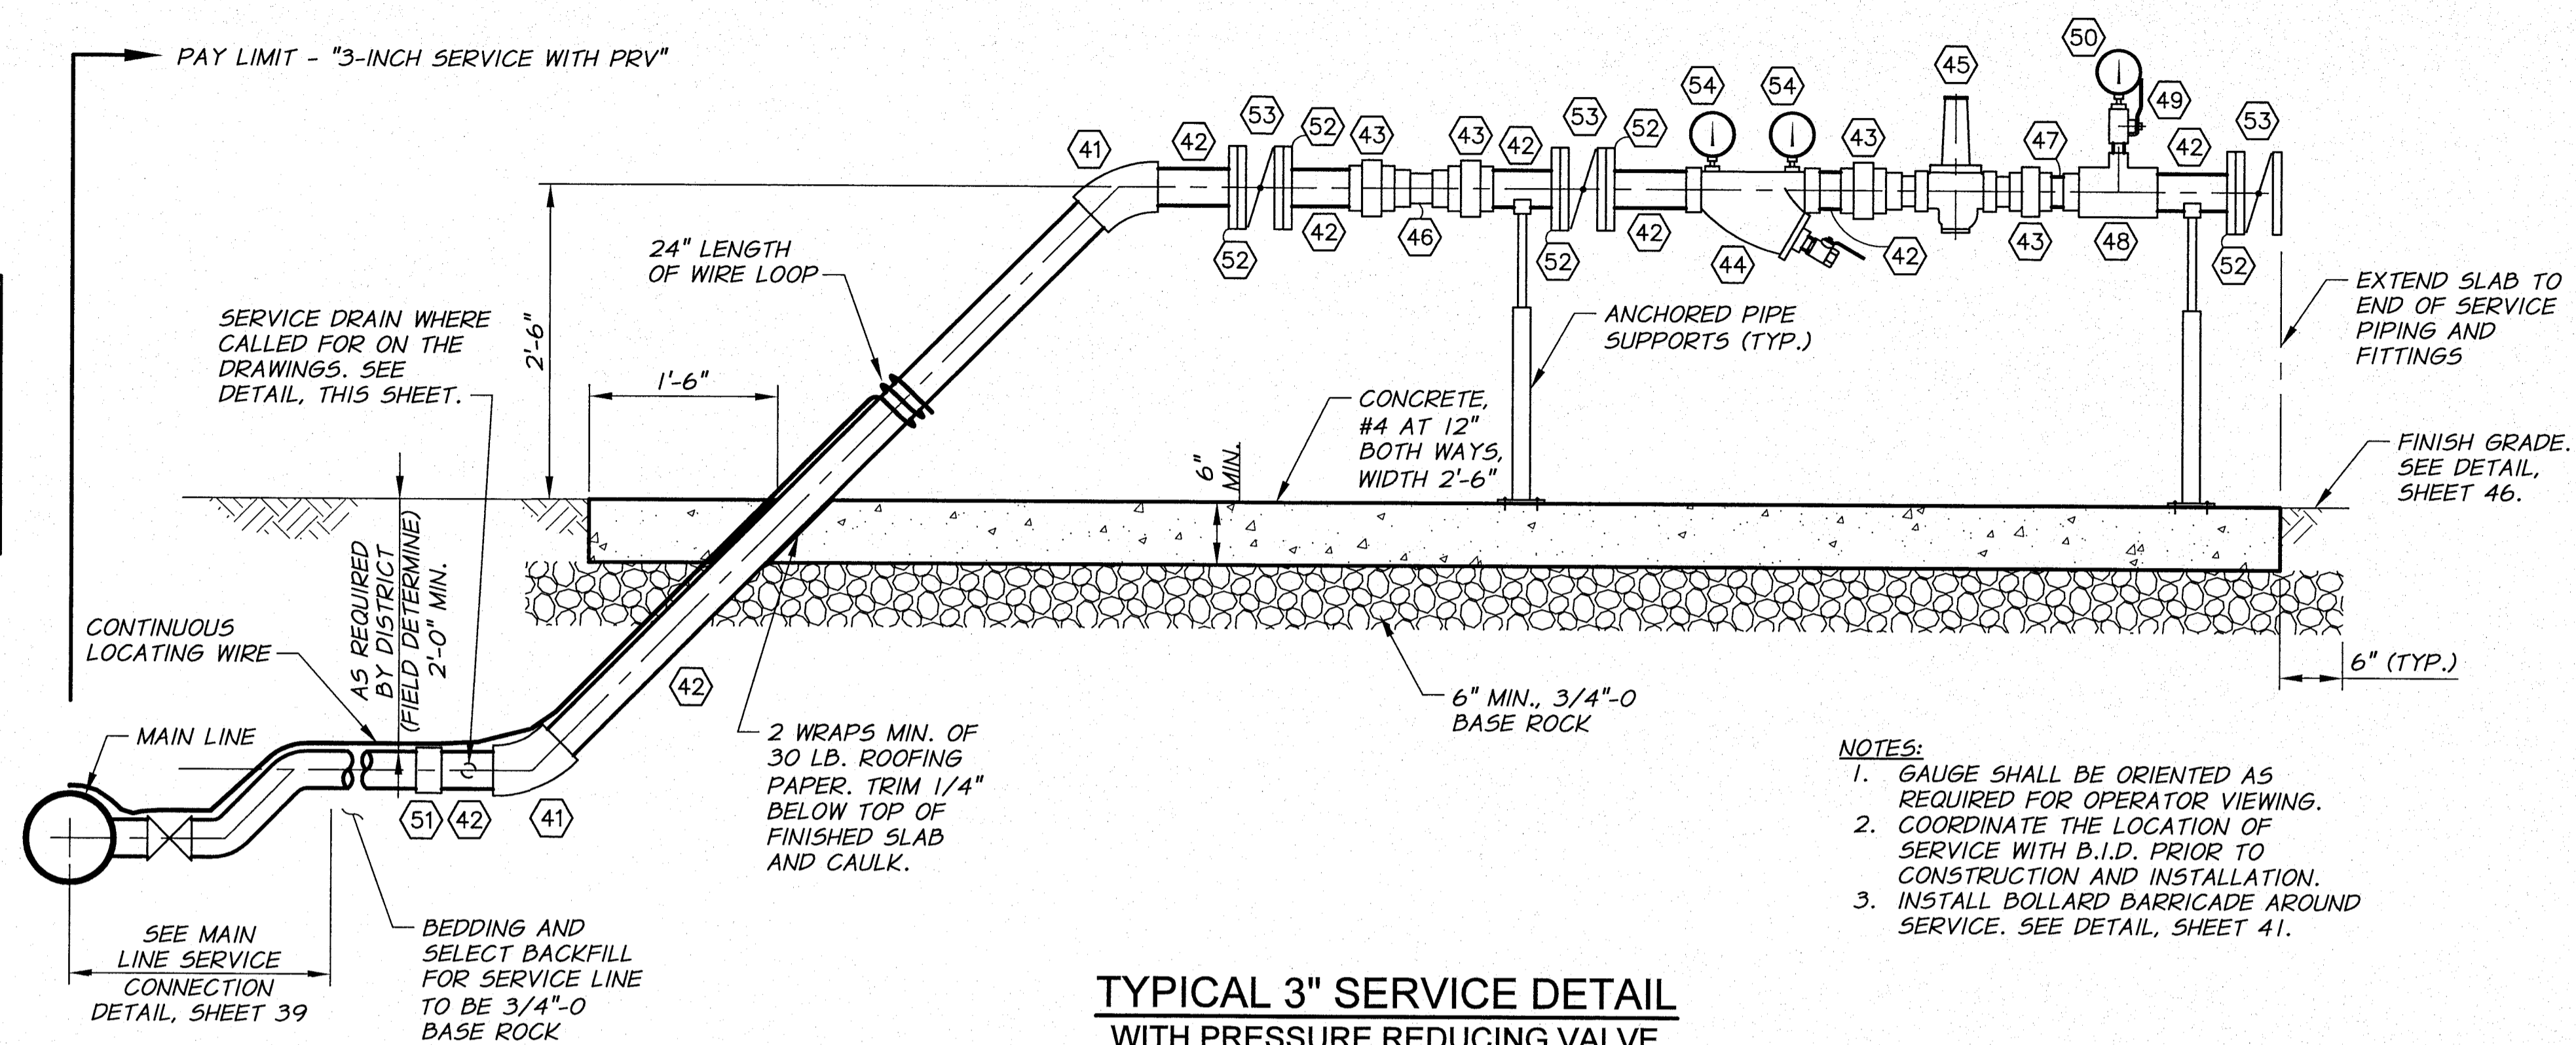


**TYPICAL 3" SERVICE DETAIL  
WITH PRESSURE REDUCING VALVE**  
N.T.S.

**SERVICE FITTING SCHEDULE**


- ④1 6.I.P. 45° ELBOW
- ④2 SCH. 40 6.I.P. PIPE
- ④3 6.I.P. UNION OR 6.I.P. REDUCING UNION AS REQUIRED
- ④4 3" SONNAG ALUMINUM Y-FILTER WITH 40 MESH FILTER SCREEN
- ④5 CLA-VAL 990 PRESSURE REDUCING VALVE. SIZE AS SHOWN ON PLANS. SEE TECHNICAL SPECIFICATIONS FOR DETAILS.
- ④6 DOLE FLOW CONTROL VALVE. SIZE AS SHOWN ON PLANS. INSTALL WITH FLOW RATE LABEL FACING UPWARDS AND NO WRENCH MARKS ON VALVE.
- ④7 SCH. 40 6.I.P. SPOOL
- ④8 3"x3/4" 6.I.P. TEE
- ④9 3/4" THREADED BRASS BALL VALVE WITH 3/4"x1/4" BUSHING AND BRASS QUICK COUPLING PLUG (UNVALVED)
- ⑤0 BRASS QUICK COUPLING SOCKET (UNVALVED) GAUGE BY OWNER
- ⑤1 SCH 80 PVC TRANSITION COUPLING AND FITTINGS AS REQ'D. FEMALE CONNECTION TO GIP.
- ⑤2 FLANGE ADAPTER
- ⑤3 3" FLG BUTTERFLY VALVE WITH WHEEL OPERATOR AND POSITION INDICATOR
- ⑤4 4" 55 GLYCERIN FILLED PRESSURE GAUGE. FITTINGS AS REQUIRED.

- NOTES:**
1. GAUGE SHALL BE ORIENTED AS REQUIRED FOR OPERATOR VIEWING.
  2. COORDINATE THE LOCATION OF SERVICE WITH B.I.D. PRIOR TO CONSTRUCTION AND INSTALLATION.
  3. INSTALL BOLLARD BARRICADE AROUND SERVICE. SEE DETAIL, SHEET 41.

**NOTE:**  
THREAD CLEARANCE SHALL BE 3/8" MINIMUM. OVER TIGHTENED FITTINGS WILL BE REJECTED AND PIPING ASSEMBLY REASSEMBLED TO MEET REQUIREMENTS. SEE SPECIFICATIONS FOR MORE DETAILS.

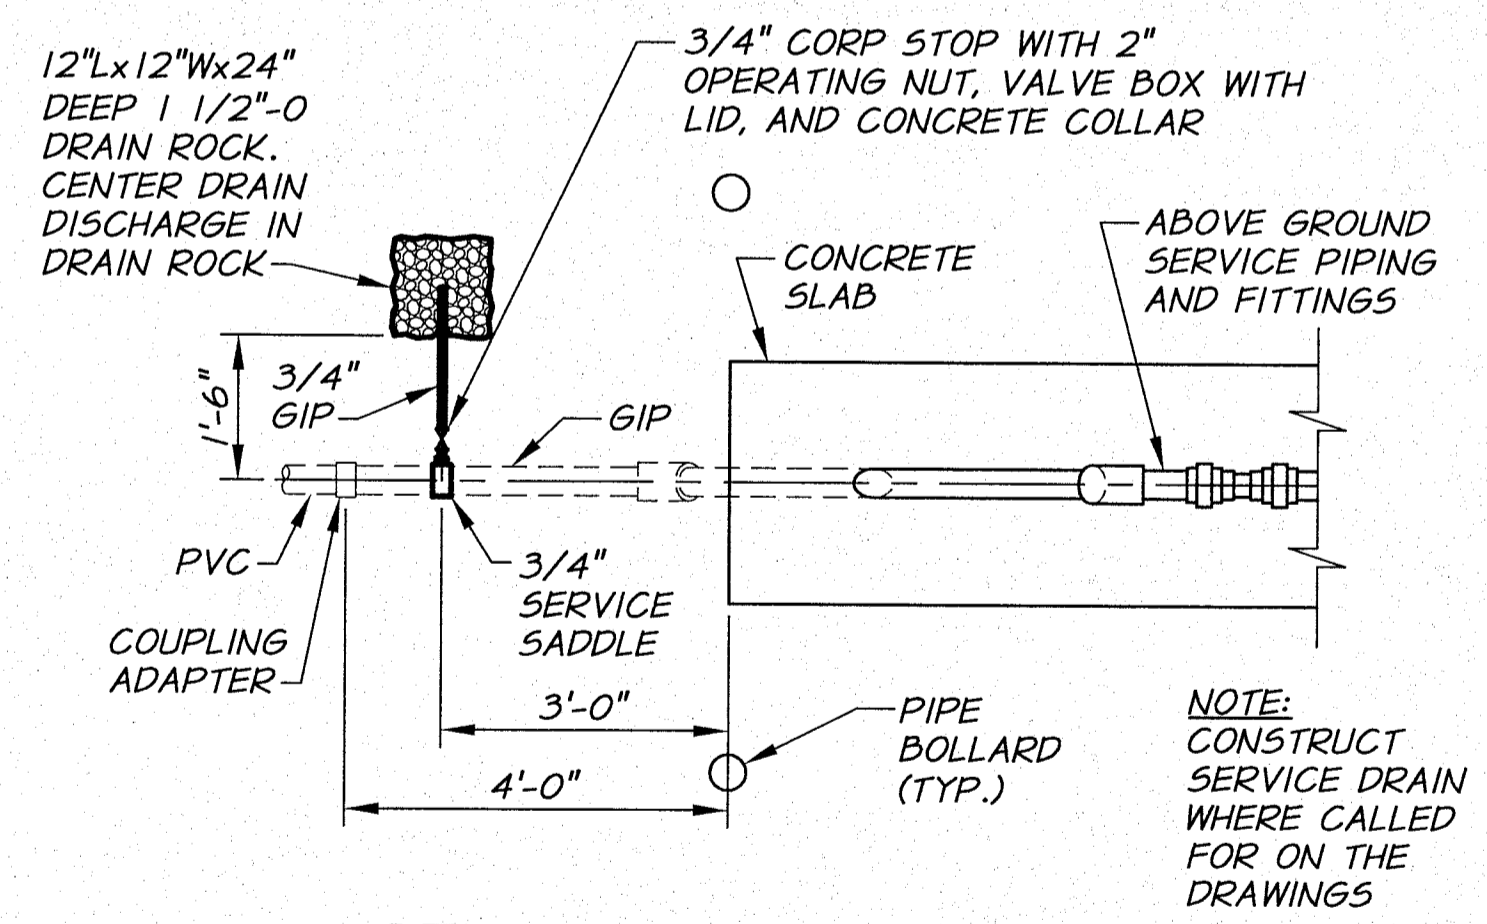


**SERVICE DRAIN DETAIL  
PLAN**  
N.T.S.

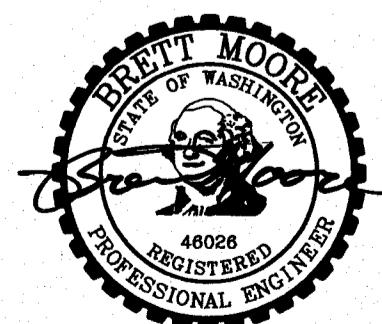

SIGNED 06-04-12  
RECORD DRAWINGS

REVISION	BY	DATE	HORIZ. SCALE	NONE	VERT. SCALE
DESIGNED BY	R. HARRIS		JOB NUMBER	1199-336	DATE
DRAWN BY	D. CHRISTMAN		ACAD FILE:	ServiceDets-Ph2B.dwg	
REVIEWED BY	B. MOORE		COPYRIGHT 2011 BY ANDERSON-PERRY & ASSOC., INC.		

**RECORD DRAWINGS**  
These record drawings have been prepared, in part, on the basis of information compiled and furnished by others. They may contain some discrepancies and omissions, and do not necessarily represent "exact" field conditions. The Owner and the Engineer accept no responsibility for their accuracy.

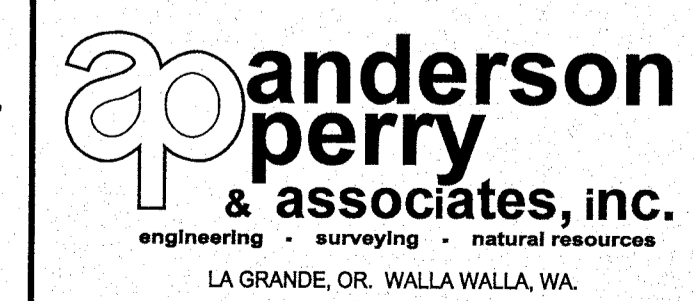


**BENTON IRRIGATION DISTRICT  
IRRIGATION SYSTEM IMPROVEMENTS  
PHASE 2B**  
  
SERVICE DETAILS IV

SHEET  
**42**


**FITTING SCHEDULE**

- 1 SERVICE LINE PVC PIPING
- 2 MJ ECCENTRIC REDUCER
- 3 CLASS 200 PVC PIPING (SAME SIZE AS CONTROL VALVE)
- 4 MJ GATE VALVE WITH VALVE BOX. SEE DETAIL, SHEET 51.
- 5 COUPLING
- 6 FLG X PE D.I. SPOOL, LENGTH AS REQUIRED (SAME SIZE AS CONTROL VALVE)
- 7 FOR 4" SERVICE: 3" FLG DI SPOOL X 1'-8" LG. FOR 6" SERVICE: 4" FLG GIP SPOOL X 4'-0" LG. FOR 8" SERVICE: 6" FLG DI SPOOL X 4'-0" LG.
- 8 FOR 4" SERVICE: 3" MICROMETER FLOWMETER MODEL MW500 FOR 6" SERVICE: 4" MICROMETER FLOWMETER MODEL LP22 FOR 8" SERVICE: 6" MICROMETER FLOWMETER MODEL LP32
- 9 FOR PRV/FCV SERVICE ONLY: 3/4" TAPPING SADDLE WITH 3/4" THREADED BRASS BALL VALVE, 3/4"x1/4" BUSHING, AND BRASS QUICK COUPLING PLUG (UNVALVED)
- 10 CLA-VAL 40-01 FLOW CONTROL OR 49-01 COMBINATION FLOW CONTROL AND PRESSURE REDUCING VALVE, TYPE AS SHOWN ON PLANS. SEE TABLE 1, THIS SHEET, AND SPECIFICATIONS FOR DETAILS.
- 11 RESTRAINED FLANGE COUPLING ADAPTER
- 12 BRASS QUICK COUPLING PLUG (UNVALVED) AND FITTINGS AS REQUIRED ON ORIFICE PILOT PIPING. PROVIDE ADDITIONAL ISOLATION VALVE.
- 13 PE DI SPOOL LENGTH AS REQUIRED (SAME SIZE AS CONTROL VALVE)
- 14 FLANGE COUPLING ADAPTER AND FITTINGS AS REQUIRED
- 15 FLG SIZExSIZExSIZE TEE, BRANCH NOT TO EXCEED 6"
- 16 FLGxMJ GATE VALVE WITH VALVE BOX. SEE DETAIL, SHEET 51.
- 17 ORIFICE PLATE
- 18 FLGxPE SPOOL, LENGTH AS REQUIRED, FITTINGS AS REQUIRED
- 19 MAINGUARD BLOW-OFF #7600 (SEE TABLE 1, THIS SHEET). ENCLOSURE TO BE CARSON INDUSTRIES MODEL H2436 TRAFFIC BEARING VAULT AND LID WITH EXTENSIONS AS REQUIRED.
- 20 OSHA APPROVED GALVANIZED STEEL LADDER WITH 4 FOOT REMOVABLE EXTENSION
- 21 PIPE SUPPORT. SEE TYPICAL PIPE SUPPORT DETAIL SHEET 49.
- 22 SEAL PIPE PENETRATIONS WATERTIGHT WITH NON-SHRINK GROUT
- 23 BRASS GRATED DRAIN WITH KNOCKOUT HOLE FOR DRAIN PIPE. DO NOT PROVIDE DRAIN IN HIGH GROUND WATER AREA.
- 24 FLG x PE DI SPOOL x 2 FT. LONG (SAME SIZE AS CONTROL VALVE)

SERVICE SIZE	CONTROL VALVE SIZE	BLOW-OFF INLET	BLOW-OFF OUTLET	GATE VALVE SIZE
4-INCH	3"	4"	4"	3"
6-INCH	4"	4"	4"	4"
8-INCH	6"	6"	4"	6"

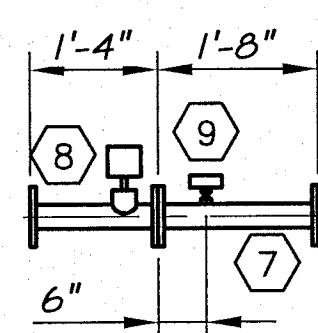


4" SERVICE

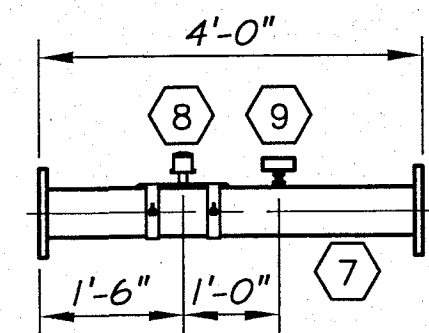


6" AND 8" SERVICE

**FLOWMETER PIPING DETAIL**

N.T.S.

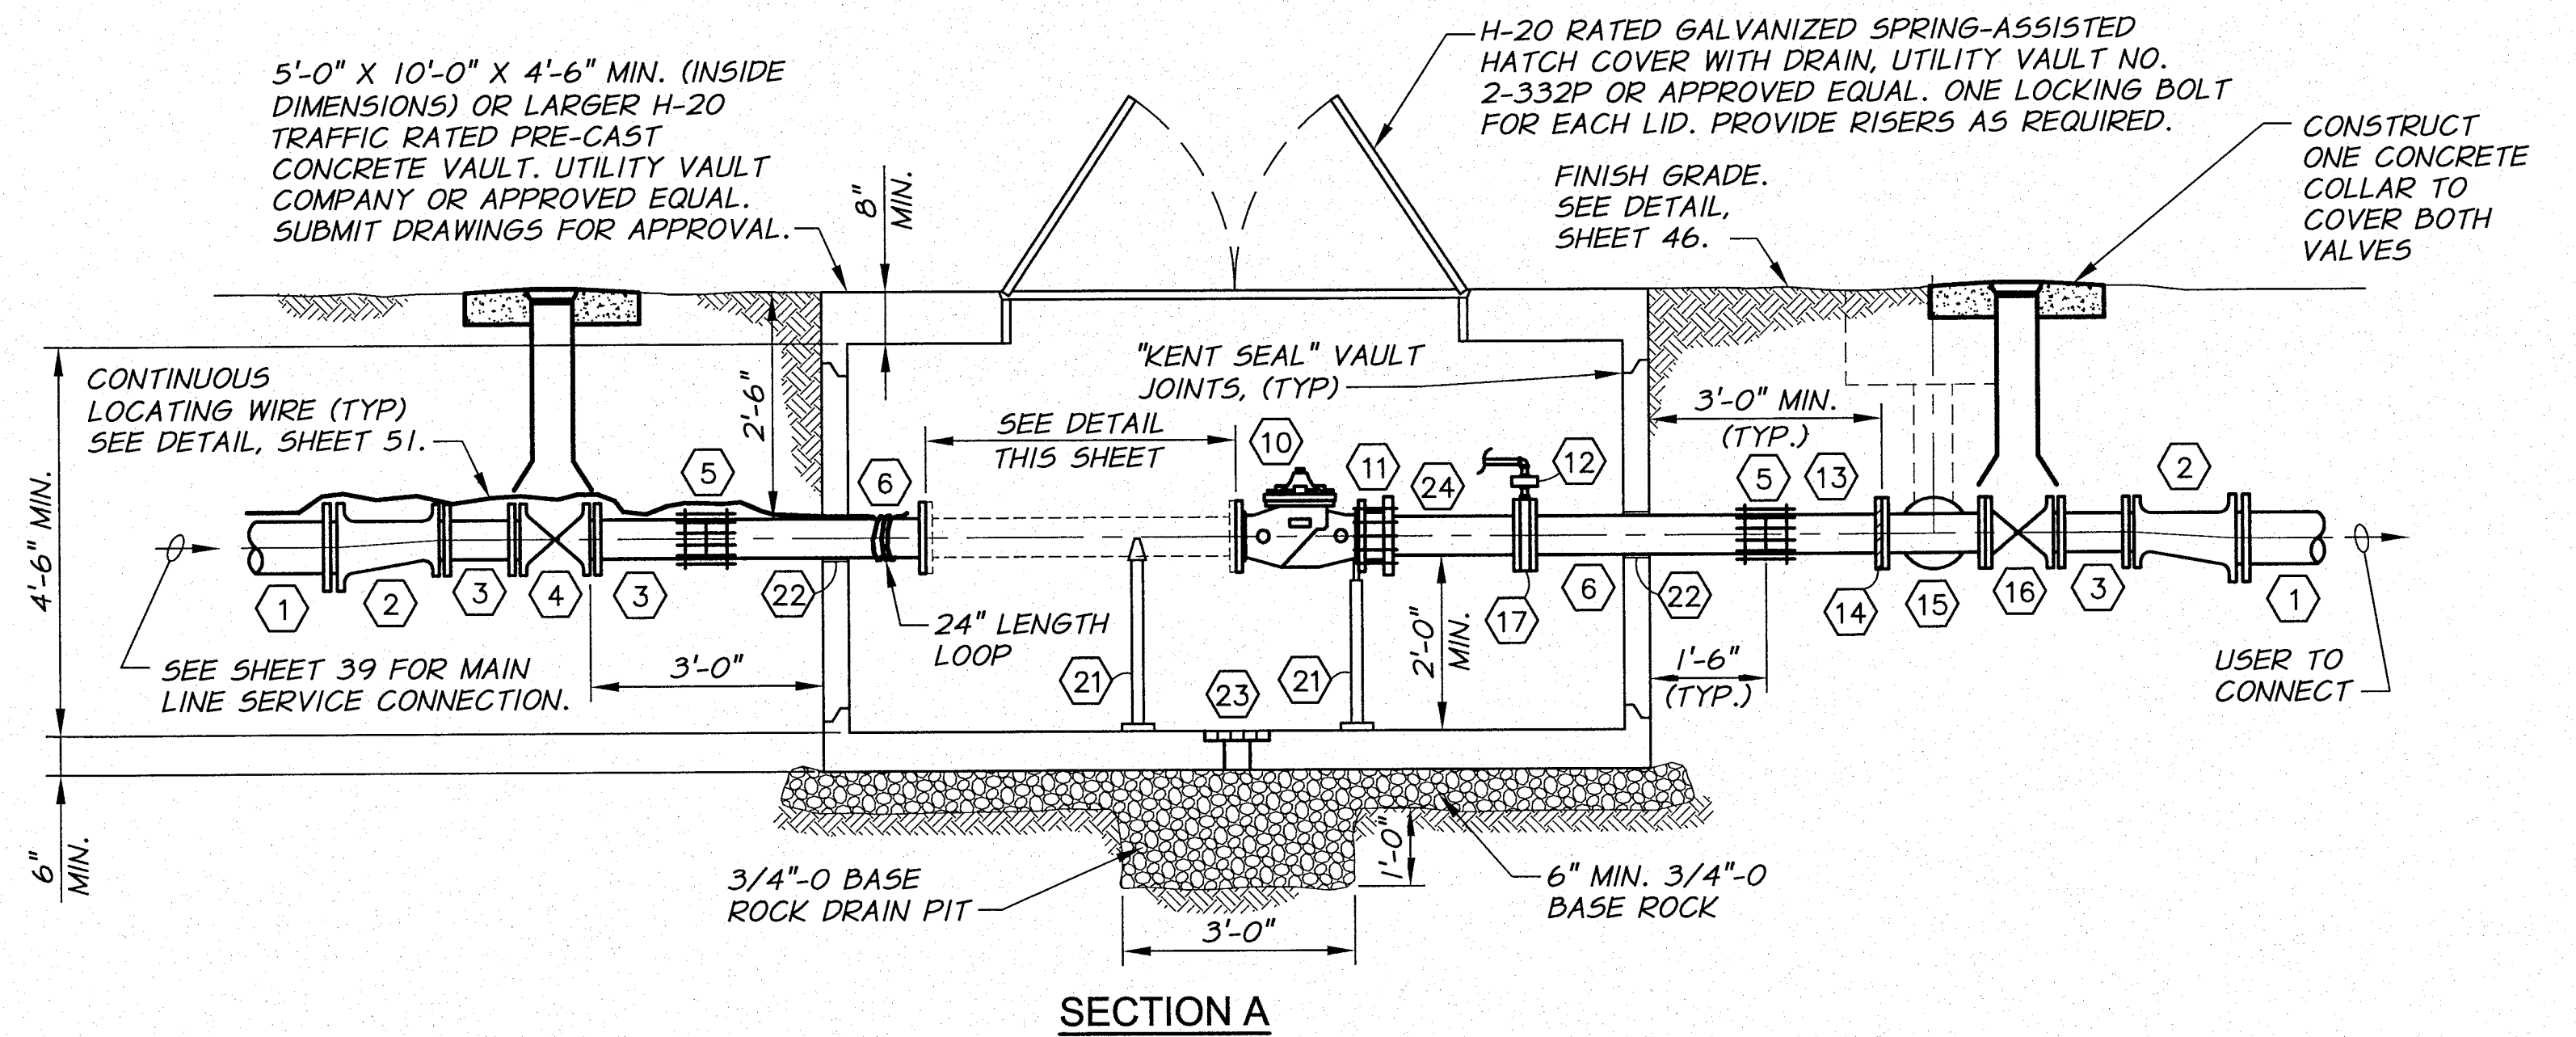

SECTION A

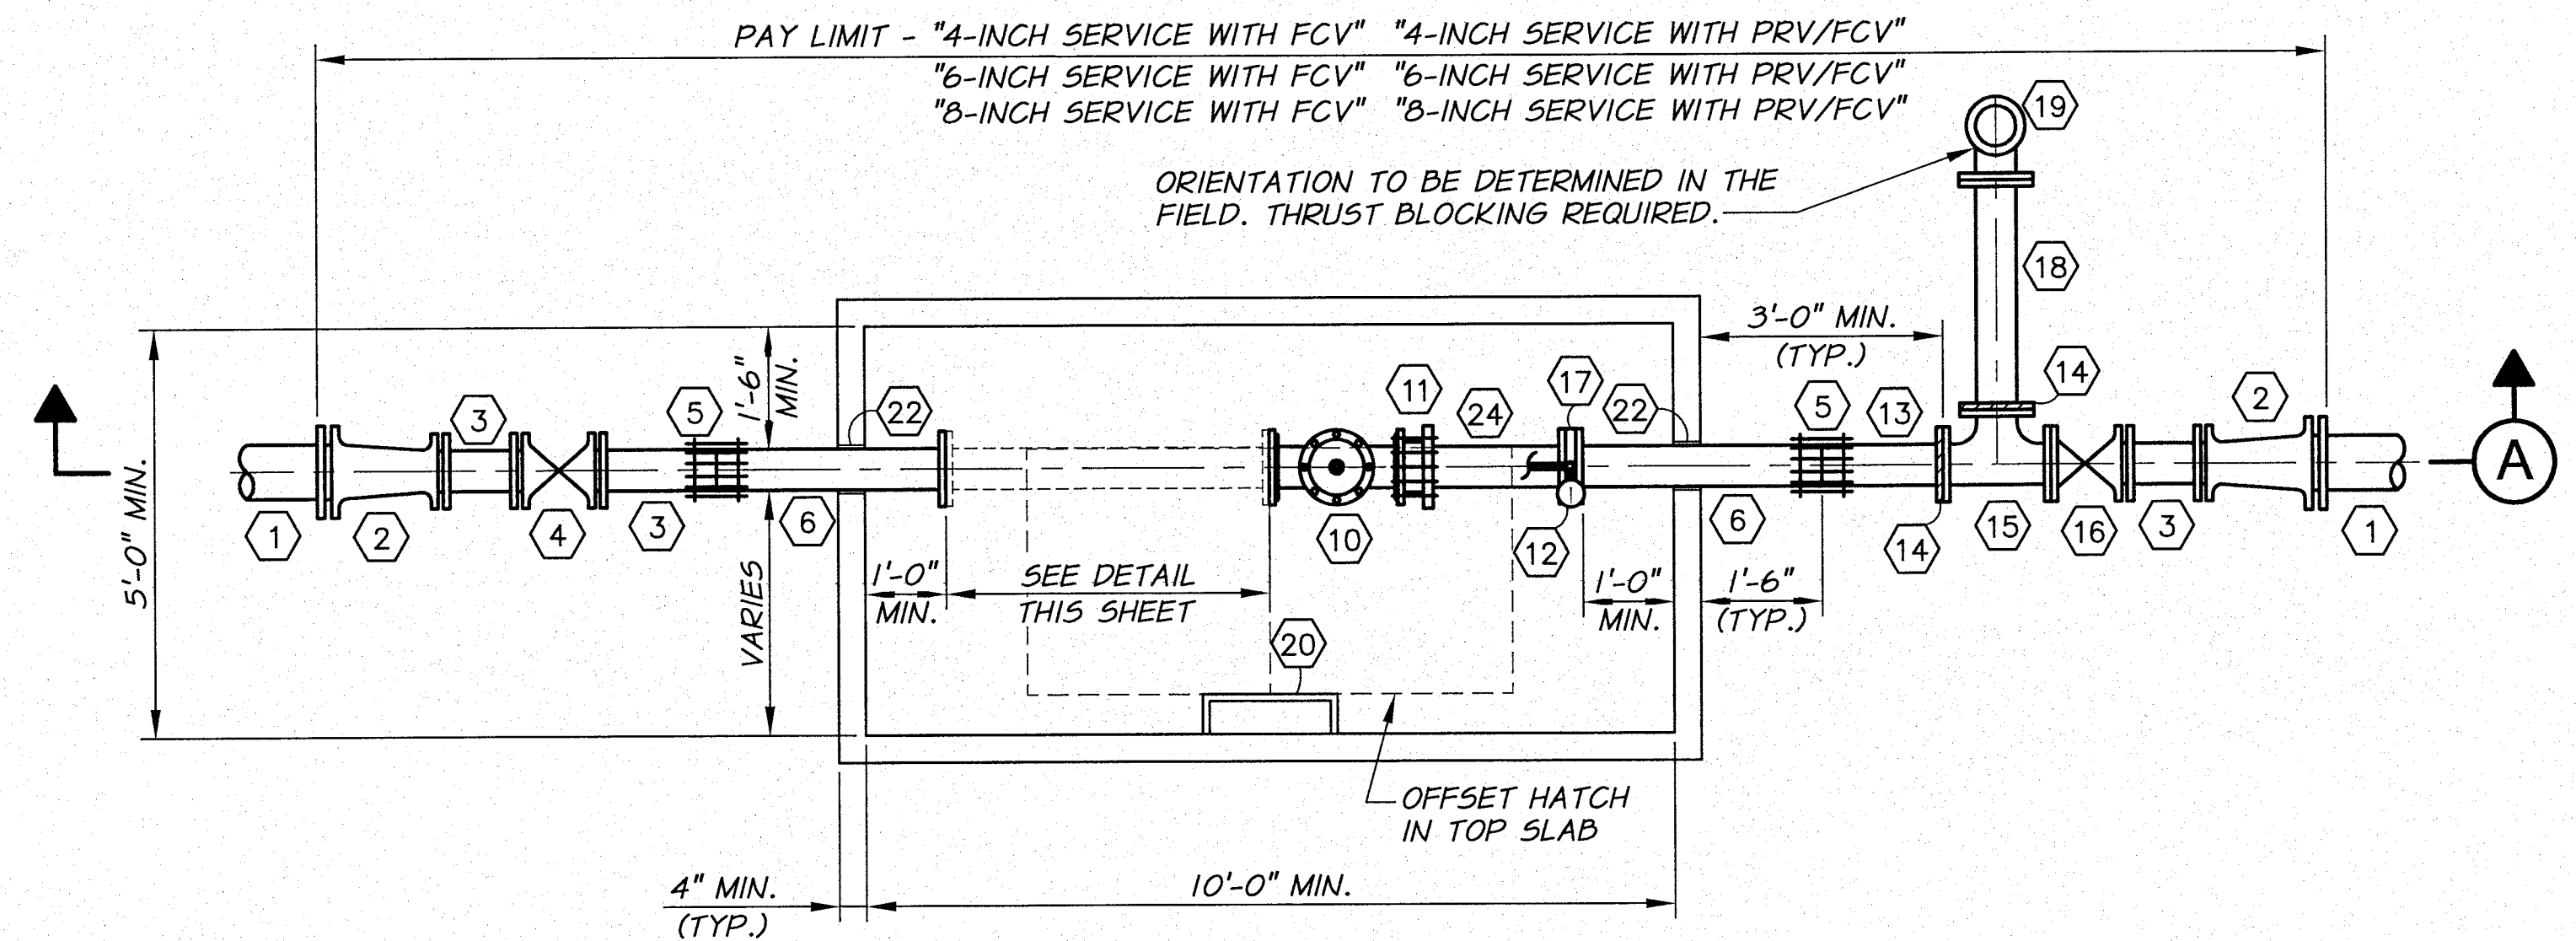


PLAN

**NOTES:**

1. PIPING SIZE TO MATCH CONTROL VALVE SIZE UNLESS OTHERWISE NOTED.
2. SET FRAME AND COVER TO GRADE AND PROVIDE GRADE RINGS AS REQUIRED.
3. PIPE SUPPORTS TO BE SIZED APPROPRIATELY FOR PIPE AND INSTALLED PER MANUFACTURER'S RECOMMENDATIONS.
4. ALL WORK SHOWN IN THIS DETAIL, INCLUDING ANY REQUIRED SURFACE RESTORATION, SHALL BE INCLUDED IN THE "\_\_\_-INCH SERVICE FCV" OR THE "\_\_\_-INCH SERVICE PRV/FCV" PAY ITEM.

**4", 6", AND 8" SERVICE WITH PRV/FCV OR FCV DETAIL**

N.T.S.

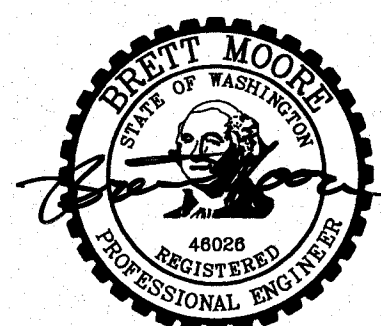


SIGNED 06-04-12  
RECORD DRAWINGS

REVISION	BY	DATE	HORIZ. SCALE 1/2" = 1'-0"	VERT. SCALE
DESIGNED BY R. HARRIS			JOB NUMBER 1199-336	DATE 2011
DRAWN BY D. CHRISTMAN			ACAD FILE: VaultDets-PH2B.dwg	
REVIEWED BY B. MOORE			COPYRIGHT 2011 BY ANDERSON-PERRY & ASSOC., INC.	

**RECORD DRAWINGS**

These record drawings have been prepared, in part, on the basis of information compiled and furnished by others. They may contain some discrepancies and omissions, and do not necessarily represent "exact" field conditions. The Owner and the Engineer accept no responsibility for their accuracy.

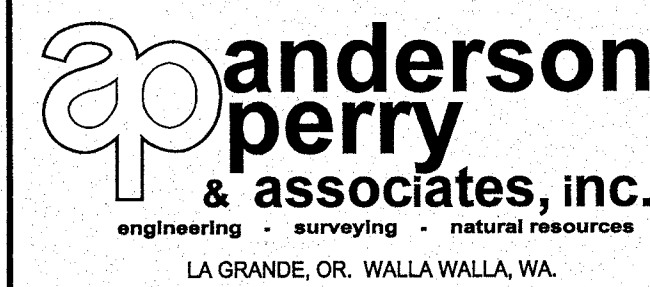

**BENTON IRRIGATION DISTRICT**  
IRRIGATION SYSTEM IMPROVEMENTS  
PHASE 2B

SERVICE DETAILS V

SHEET

43




4'-0" X 8'-6" X 4'-6" MIN. (INSIDE DIMENSIONS) OR LARGER H-20 TRAFFIC RATED PRE-CAST CONCRETE VAULT. UTILITY VAULT COMPANY OR APPROVED EQUAL. SUBMIT DRAWINGS FOR APPROVAL.


H-20 RATED GALVANIZED SPRING-ASSISTED HATCH COVER WITH DRAIN, UTILITY VAULT NO. 2-332P OR APPROVED EQUAL. ONE LOCKING BOLT FOR EACH LID. PROVIDE RISERS AS REQUIRED.

FINISH GRADE. SEE DETAIL, SHEET 46.

CONTINUOUS LOCATING WIRE (TYP) SEE DETAIL, SHEET 51.

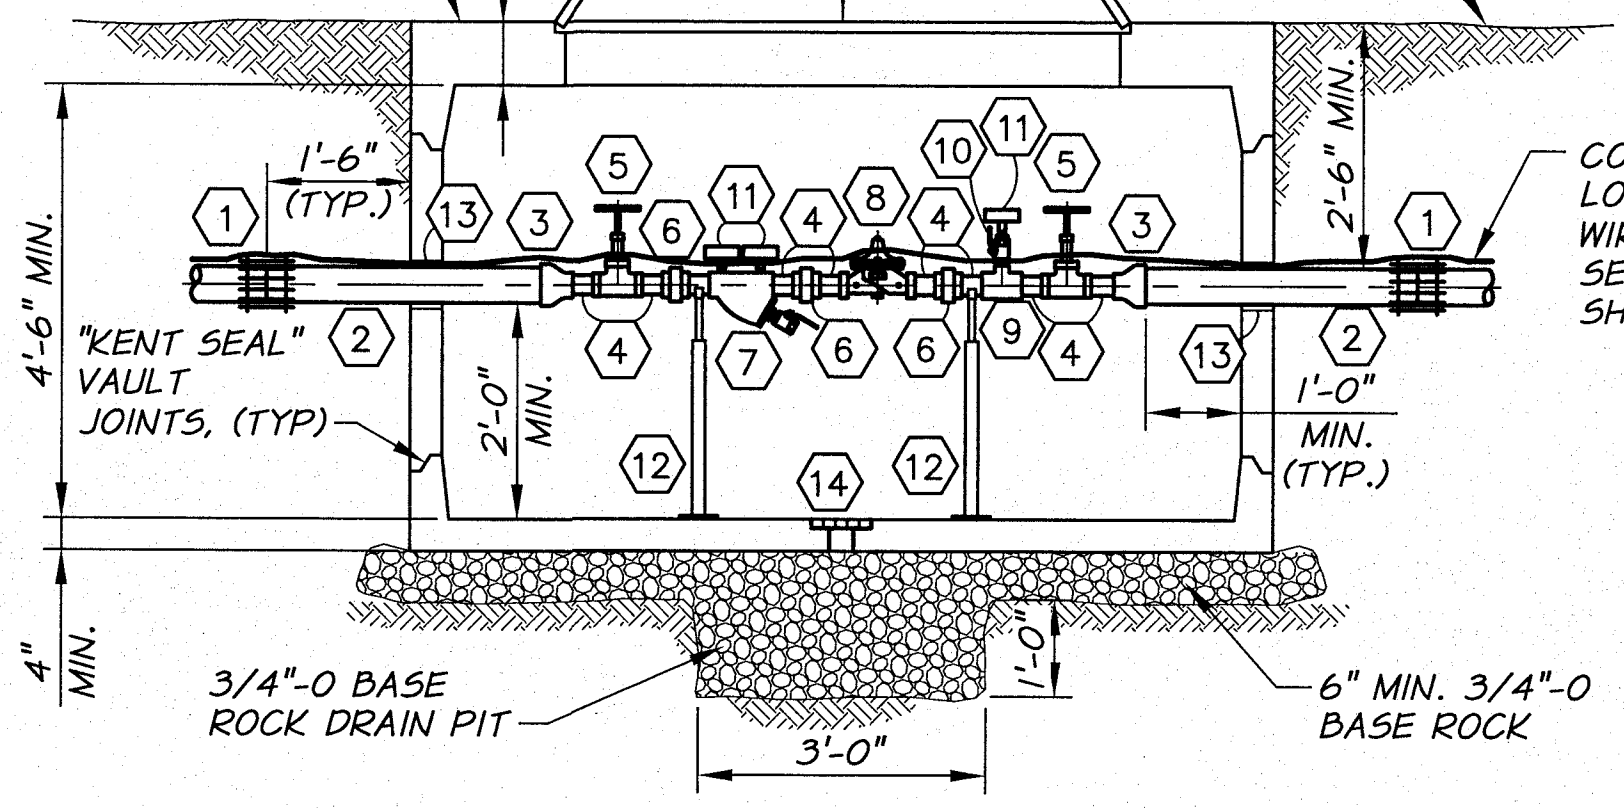

SECTION B

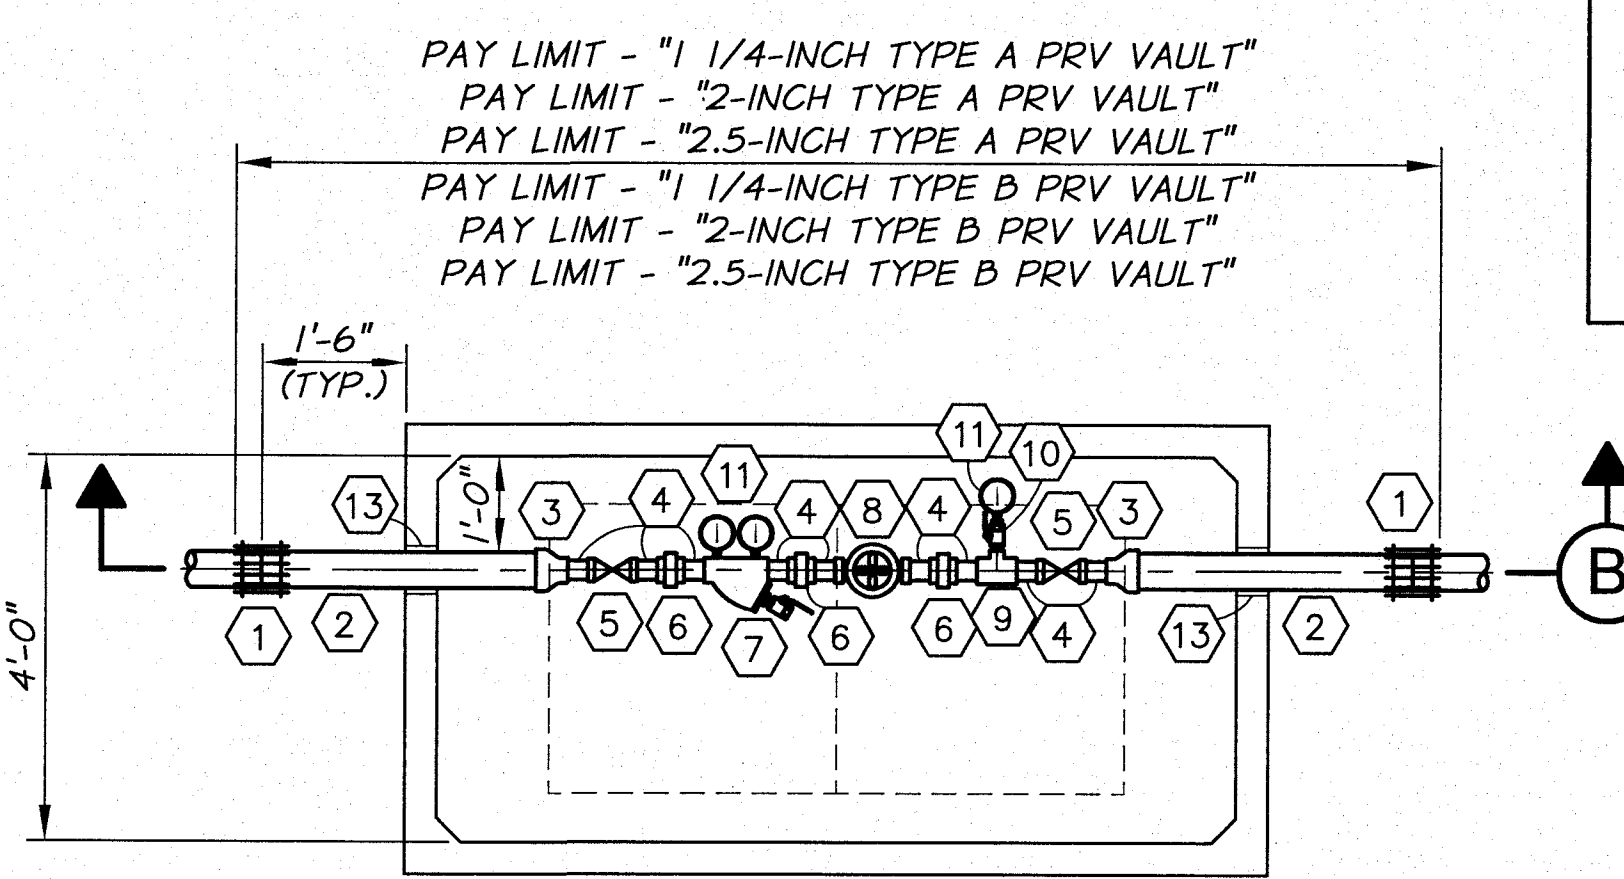

PLAN

**FITTING SCHEDULE**


- 1 TRANSITION COUPLING
- 2 GIP, SIZE AS SHOWN ON PLANS
- 3 THREADED GIP REDUCER WHERE REQUIRED
- 4 1 1/4", 2", OR 2 1/2" THREADED GIP
- 5 BRASS THREADED GATE VALVE
- 6 GIP UNION
- 7 SONNTAG ALUMINUM Y FILTER WITH 3/32 SCREEN
- 8 1 1/4", 2", OR 2 1/2" THREADED PRESSURE REDUCING VALVE, CLA-VAL 90-01 FOR TYPE A. 1 1/4", 2", OR 2 1/2" THREADED PRESSURE REDUCING VALVE, CLA-VAL 990 FOR TYPE B.
- 9 SIZE x 3/4" THREADED GIP TEE
- 10 3/4" THREADED BRASS BALL VALVE WITH 3/4"x1/4" NPT BUSHING AND QUICK COUPLING
- 11 4" S.S. GLYCERIN FILLED PRESSURE GAUGE WITH FITTINGS AS REQUIRED. ORIENT GAUGE SO THAT FACE IS CLEARLY VISIBLE FROM VAULT ACCESS OPENING.
- 12 PIPE SUPPORT. SEE DETAIL, SHEET 49.
- 13 SEAL PIPE PENETRATIONS WATERTIGHT WITH NON-SHRINK GROUT
- 14 BRASS GRATED DRAIN WITH KNOCKOUT HOLE FOR DRAIN PIPE. DO NOT PROVIDE DRAIN IN HIGH GROUND WATER AREA.

**NOTES:**


1. SET FRAME AND COVER TO GRADE AND PROVIDE GRADE RINGS AS REQUIRED.
2. PIPE SUPPORTS TO BE SIZED APPROPRIATELY FOR PIPE AND INSTALLED PER MANUFACTURER'S RECOMMENDATIONS.
3. ALL WORK SHOWN IN THIS DETAIL, INCLUDING ANY REQUIRED SURFACE RESTORATION, SHALL BE INCLUDED IN THE "\_\_\_-INCH TYPE A OR B PRESSURE REDUCING VALVE" PAY ITEM.

**1 1/4", 2", AND 2 1/2" PRESSURE REDUCING VALVE VAULT DETAIL**

TYPE A OR TYPE B  
N.T.S.

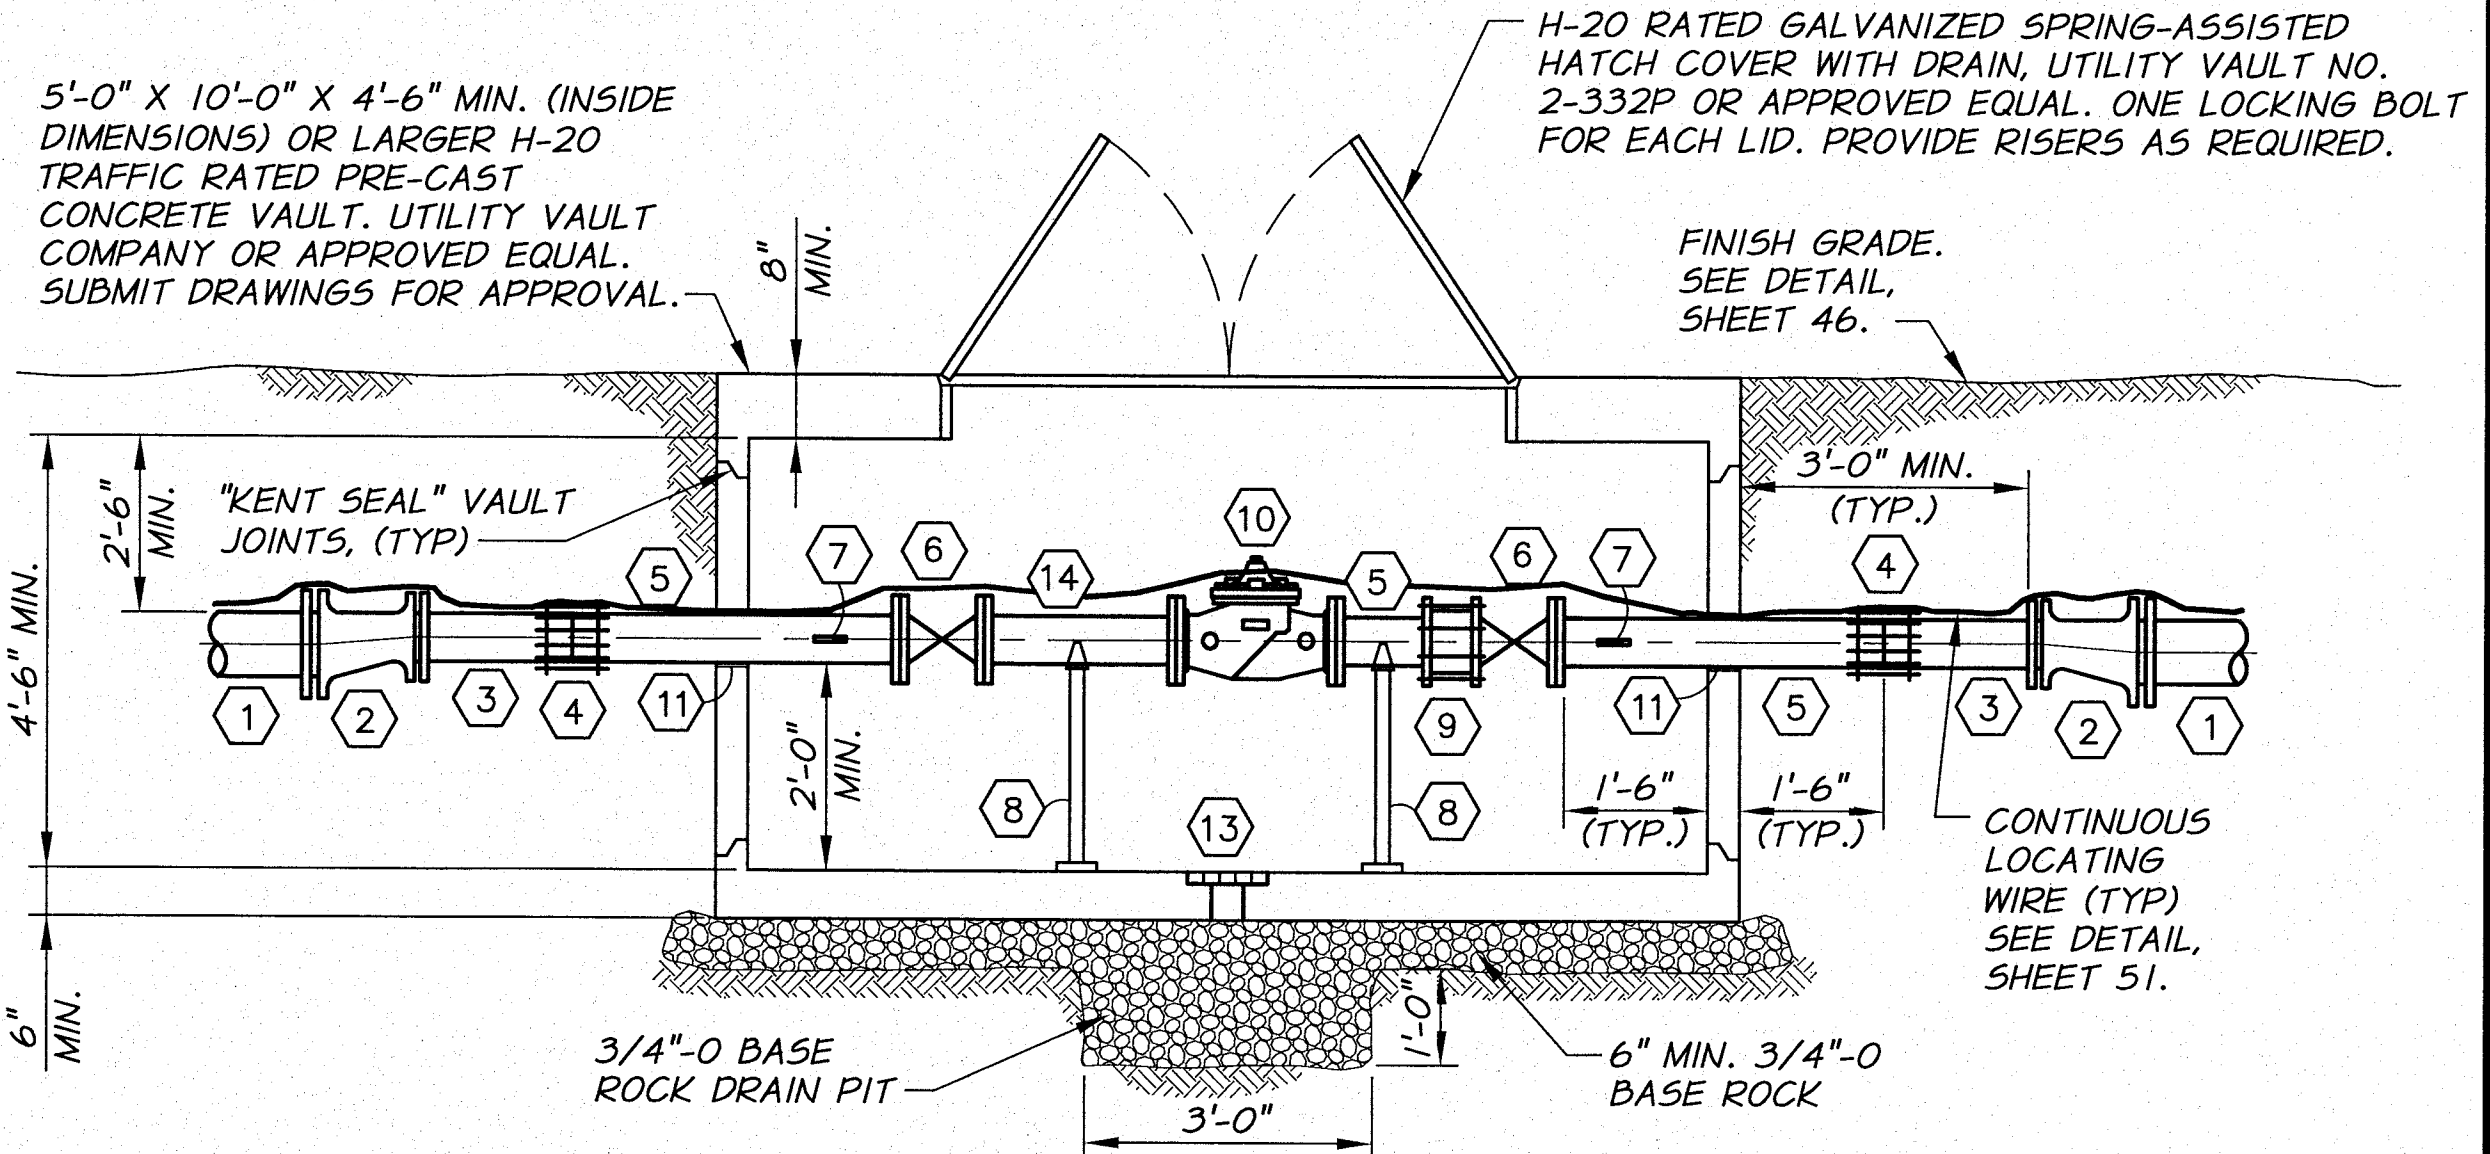

SECTION A

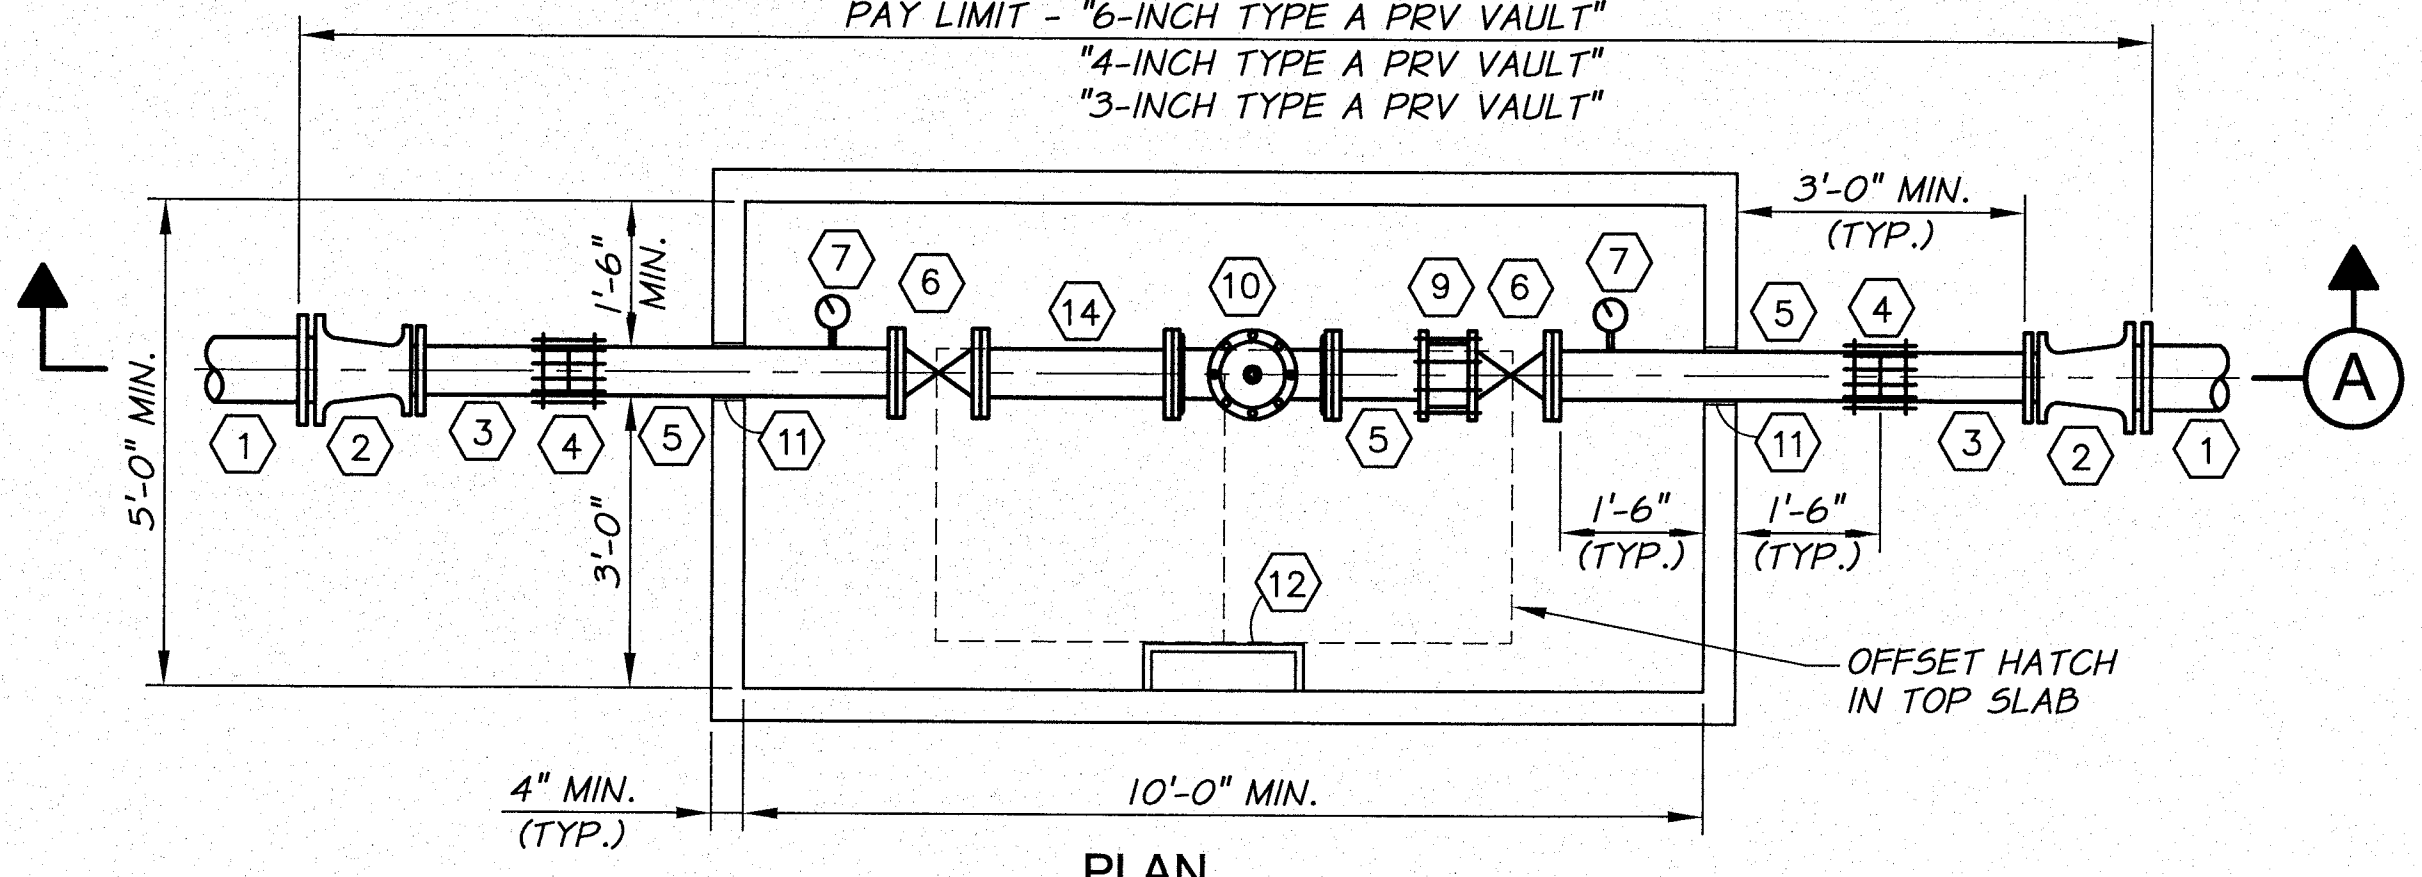

PLAN

**NOTES:**


1. PIPING SIZE TO MATCH CONTROL VALVE SIZE UNLESS OTHERWISE NOTED.
2. SET FRAME AND COVER TO GRADE AND PROVIDE GRADE RINGS AS REQUIRED.
3. PIPE SUPPORTS TO BE SIZED APPROPRIATELY FOR PIPE AND INSTALLED PER MANUFACTURER'S RECOMMENDATIONS.
4. ALL WORK SHOWN IN THIS DETAIL, INCLUDING ANY REQUIRED SURFACE RESTORATION, SHALL BE INCLUDED IN THE "\_\_\_-INCH PRESSURE REDUCING VALVE" PAY ITEM.

**FITTING SCHEDULE**

- 1 PVC PIPING, SIZE PER MAIN LINE
- 2 MJ ECCENTRIC REDUCER
- 3 PE D.I. SPOOL, LENGTH AS REQUIRED
- 4 COUPLING
- 5 FLG X PE D.I. SPOOL, LENGTH AS REQUIRED
- 6 FLG GATE VALVE WITH HANDWHEEL OPERATOR
- 7 4" S.S. PRESSURE GAUGE, GLYCERIN FILLED, 0-150 P.S.I. WITH 2 P.S.I. GRADUATIONS, ISOLATION VALVE AND FITTINGS AS REQUIRED. TAP D.I. PIPE AS REQUIRED. ORIENT GAUGE SO THAT FACE IS CLEARLY VISIBLE FROM VAULT ACCESS OPENING.
- 8 PIPE SUPPORT. SEE TYPICAL PIPE SUPPORT DETAIL SHEET 49.
- 9 RESTRAINED FLANGE COUPLING ADAPTER
- 10 FLG PRESSURE REDUCING VALVE, CLA-VAL MODEL 90-01 FLANGED, OR APPROVED EQUAL.
- 11 SEAL PIPE PENETRATIONS WATERTIGHT WITH NON-SHRINK GROUT
- 12 OSHA APPROVED GALVANIZED STEEL LADDER WITH 4 FOOT REMOVABLE EXTENSION
- 13 BRASS GRATED DRAIN WITH KNOCKOUT HOLE FOR DRAIN PIPE. DO NOT PROVIDE DRAIN IN HIGH GROUND WATER AREAS.
- 14 FLG DI SPOOL X 2 FT. LONG

**3", 4", AND 6" TYPE A PRESSURE REDUCING VALVE VAULT DETAIL**

N.T.S.

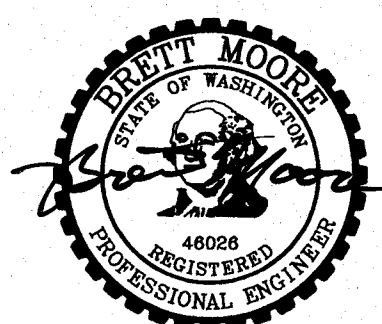


SIGNED 06-04-12  
RECORD DRAWINGS

REVISION	BY	DATE	HORIZ. SCALE NONE	VERT. SCALE
DESIGNED BY R. HARRIS			JOB NUMBER 1199-336	DATE 2011
DRAWN BY D. CHRISTMAN			ACAD FILE: VaultDets-PH2B.dwg	
REVIEWED BY B. MOORE			COPYRIGHT 2011 BY ANDERSON-PERRY & ASSOC., INC.	

**RECORD DRAWINGS**

These record drawings have been prepared, in part, on the basis of information compiled and furnished by others. They may contain some discrepancies and omissions, and do not necessarily represent "exact" field conditions. The Owner and the Engineer accept no responsibility for their accuracy.

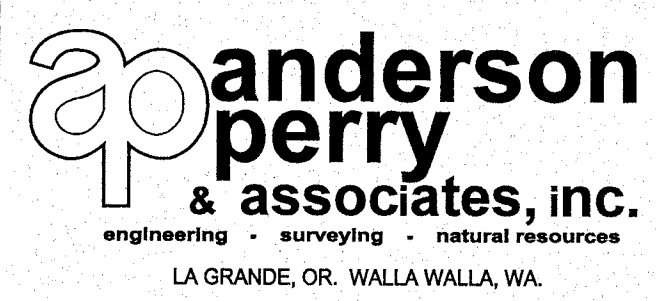

**BENTON IRRIGATION DISTRICT**  
IRRIGATION SYSTEM IMPROVEMENTS  
PHASE 2B

VALVE VAULT DETAILS I

SHEET

44

H-20 TRAFFIC RATED PRE-CAST CONCRETE VAULT. UTILITY VAULT COMPANY OR APPROVED EQUAL. SUBMIT DRAWINGS FOR APPROVAL. 4'-0" X 8'-6" X 4'-6" MIN. (INSIDE DIMENSIONS) FOR 1 1/4" VALVE AND 4'-0" X 10'-6" X 4'-6" MIN. (INSIDE DIMENSIONS) FOR 2" AND 2 1/2" VALVE


H-20 RATED GALVANIZED SPRING-ASSISTED HATCH COVER WITH DRAIN, UTILITY VAULT NO. 2-332P OR APPROVED EQUAL. ONE LOCKING BOLT FOR EACH LID. PROVIDE RISERS AS REQUIRED.

H-20 TRAFFIC RATED PRE-CAST CONCRETE VAULT. UTILITY VAULT COMPANY OR APPROVED EQUAL. SUBMIT DRAWINGS FOR APPROVAL. 4'-6" X 10'-0" X 4'-6" MIN. (INSIDE DIMENSIONS)


H-20 RATED GALVANIZED SPRING-ASSISTED HATCH COVER WITH DRAIN, UTILITY VAULT NO. 2-332P OR APPROVED EQUAL. ONE LOCKING BOLT FOR EACH LID. PROVIDE RISERS AS REQUIRED.

**FITTING SCHEDULE**

- 1 TRANSITION COUPLING
- 2 GIP, SIZE AS SHOWN ON PLANS
- 3 THREADED GIP REDUCER WHERE REQUIRED
- 4 1 1/4", 2", OR 2 1/2" THREADED GIP
- 5 BRASS THREADED GATE VALVE
- 6 GIP UNION
- 7 SONNTAG ALUMINUM Y FILTER WITH 3/32 SCREEN
- 8 1 1/4", 2", OR 2 1/2" THREADED PRESSURE REDUCING VALVE, CLA-VAL 90-01 FOR TYPE A. 1 1/4", 2", OR 2 1/2" THREADED PRESSURE REDUCING VALVE, CLA-VAL 990 FOR TYPE B.
- 9 SIZE x 3/4" THREADED GIP TEE
- 10 3/4" THREADED BRASS BALL VALVE WITH 3/4"x1/4" NPT BUSHING AND QUICK COUPLING
- 11 4" 55 GLYCERIN FILLED PRESSURE GAUGE WITH FITTINGS AS REQUIRED. ORIENT GAUGE SO THAT FACE IS CLEARLY VISIBLE FROM VAULT ACCESS OPENING.
- 12 PIPE SUPPORT. SEE DETAIL, SHEET 49.
- 13 SEAL PIPE PENETRATIONS WATERTIGHT WITH NON-SHRINK GROUT
- 14 BRASS GRATED DRAIN WITH KNOCKOUT HOLE FOR DRAIN PIPE. DO NOT PROVIDE DRAIN IN HIGH GROUND WATER AREA.
- 15 DOLE FLOW CONTROL VALVE. SIZE AS SHOWN ON PLANS
- 16 THREADED RAISED FACE FLANGE WITH GASKET MATCHING FACE OF FLANGE. 4 EA. STAINLESS STEEL BOLTS AND NUTS. BOLT LENGTH AS REQUIRED TO PASS THROUGH ALL FLANGES.

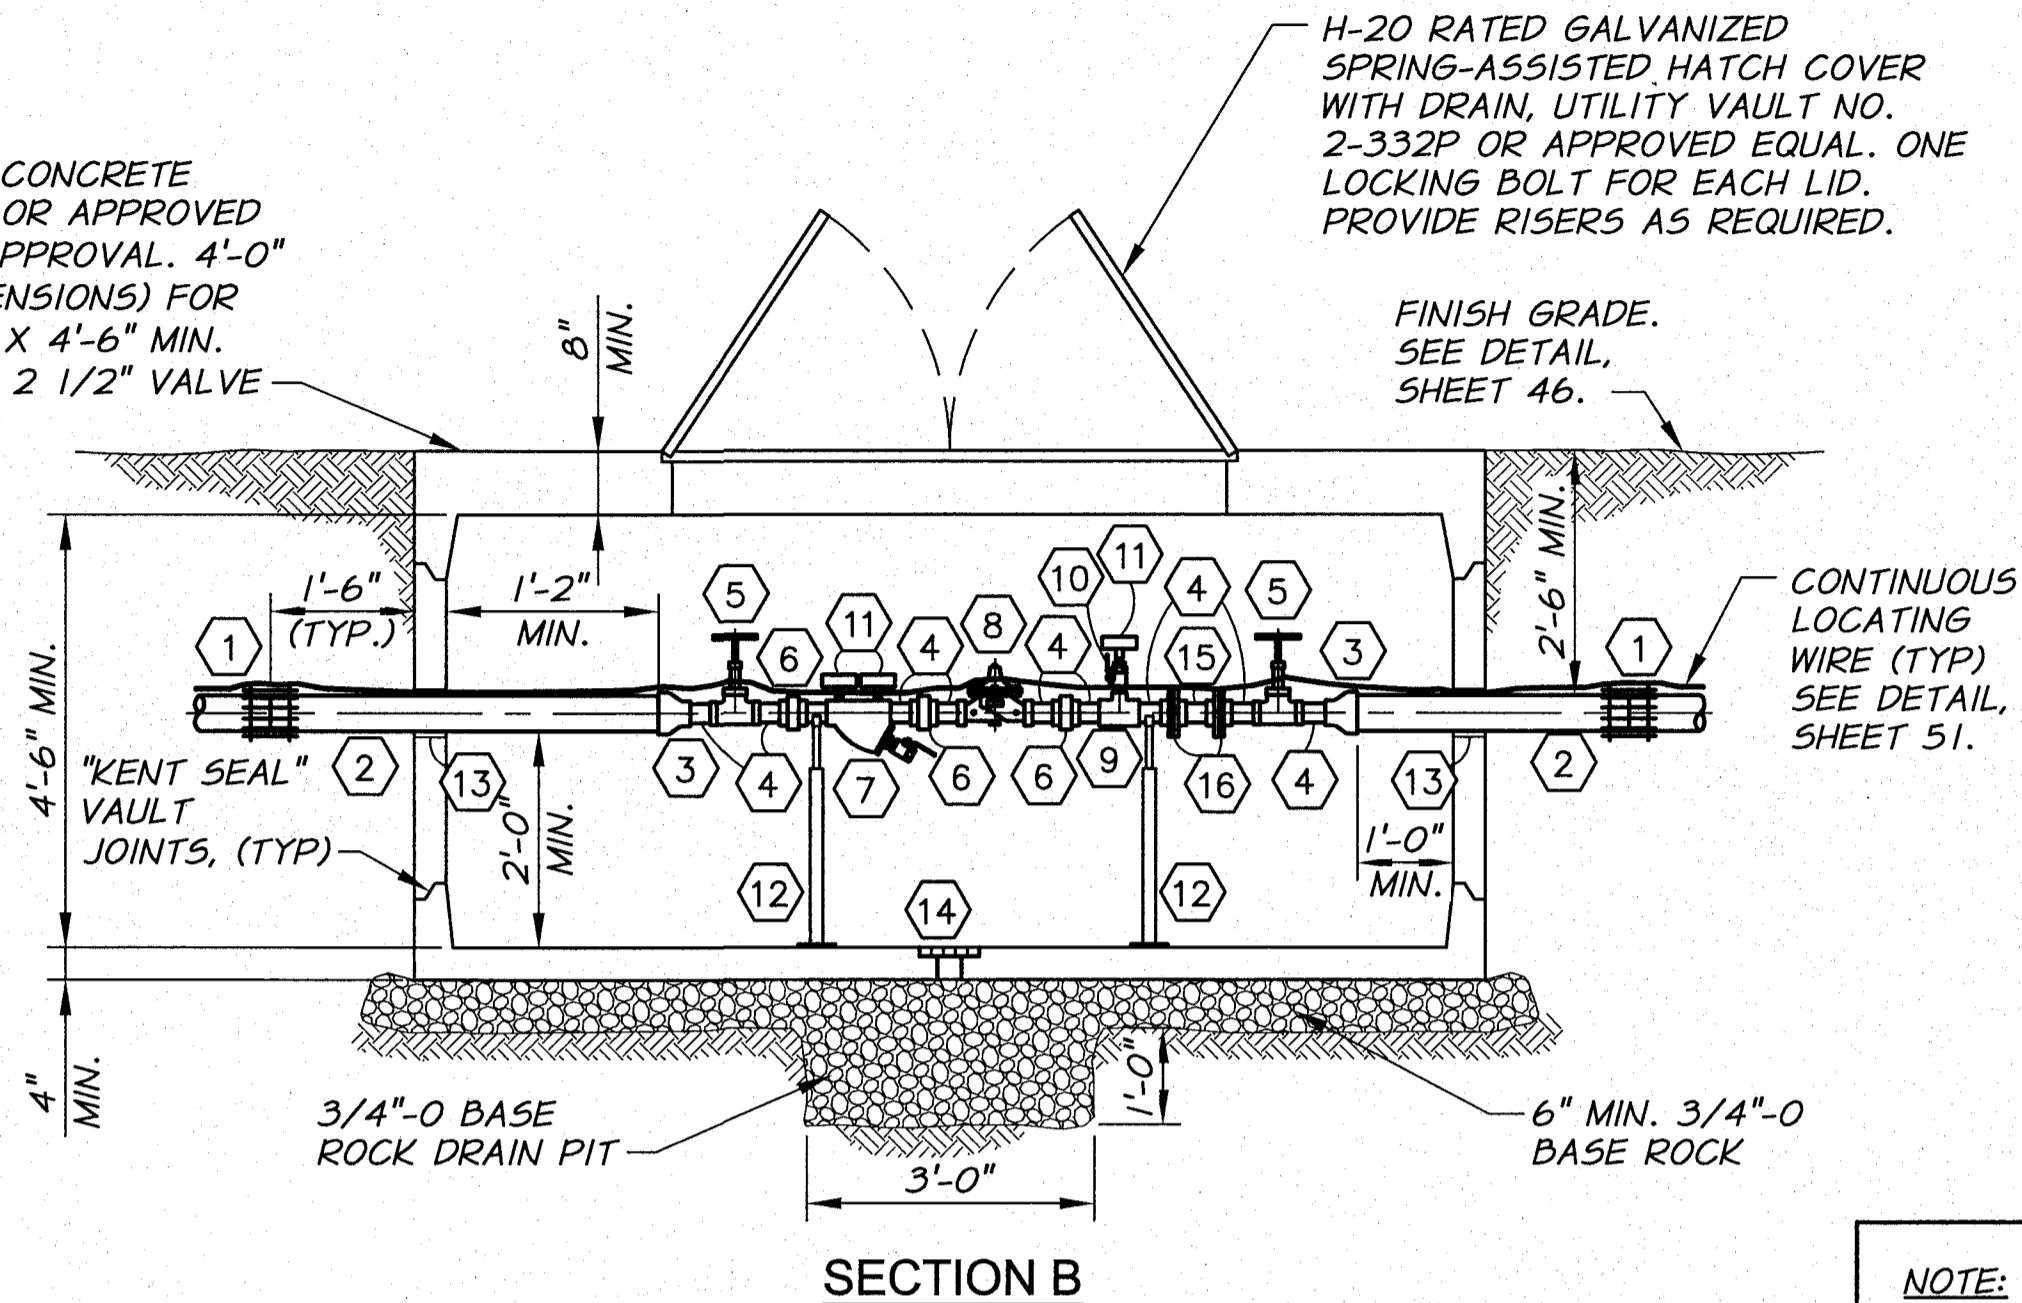

PAY LIMIT - "1 1/4-INCH TYPE A PRV VAULT WITH DOLE"  
 PAY LIMIT - "2-INCH TYPE A PRV VAULT WITH DOLE"  
 PAY LIMIT - "2.5-INCH TYPE A PRV VAULT WITH DOLE"  
 PAY LIMIT - "1 1/4-INCH TYPE B PRV VAULT WITH DOLE"  
 PAY LIMIT - "2-INCH TYPE B PRV VAULT WITH DOLE"  
 PAY LIMIT - "2.5-INCH TYPE B PRV VAULT WITH DOLE"

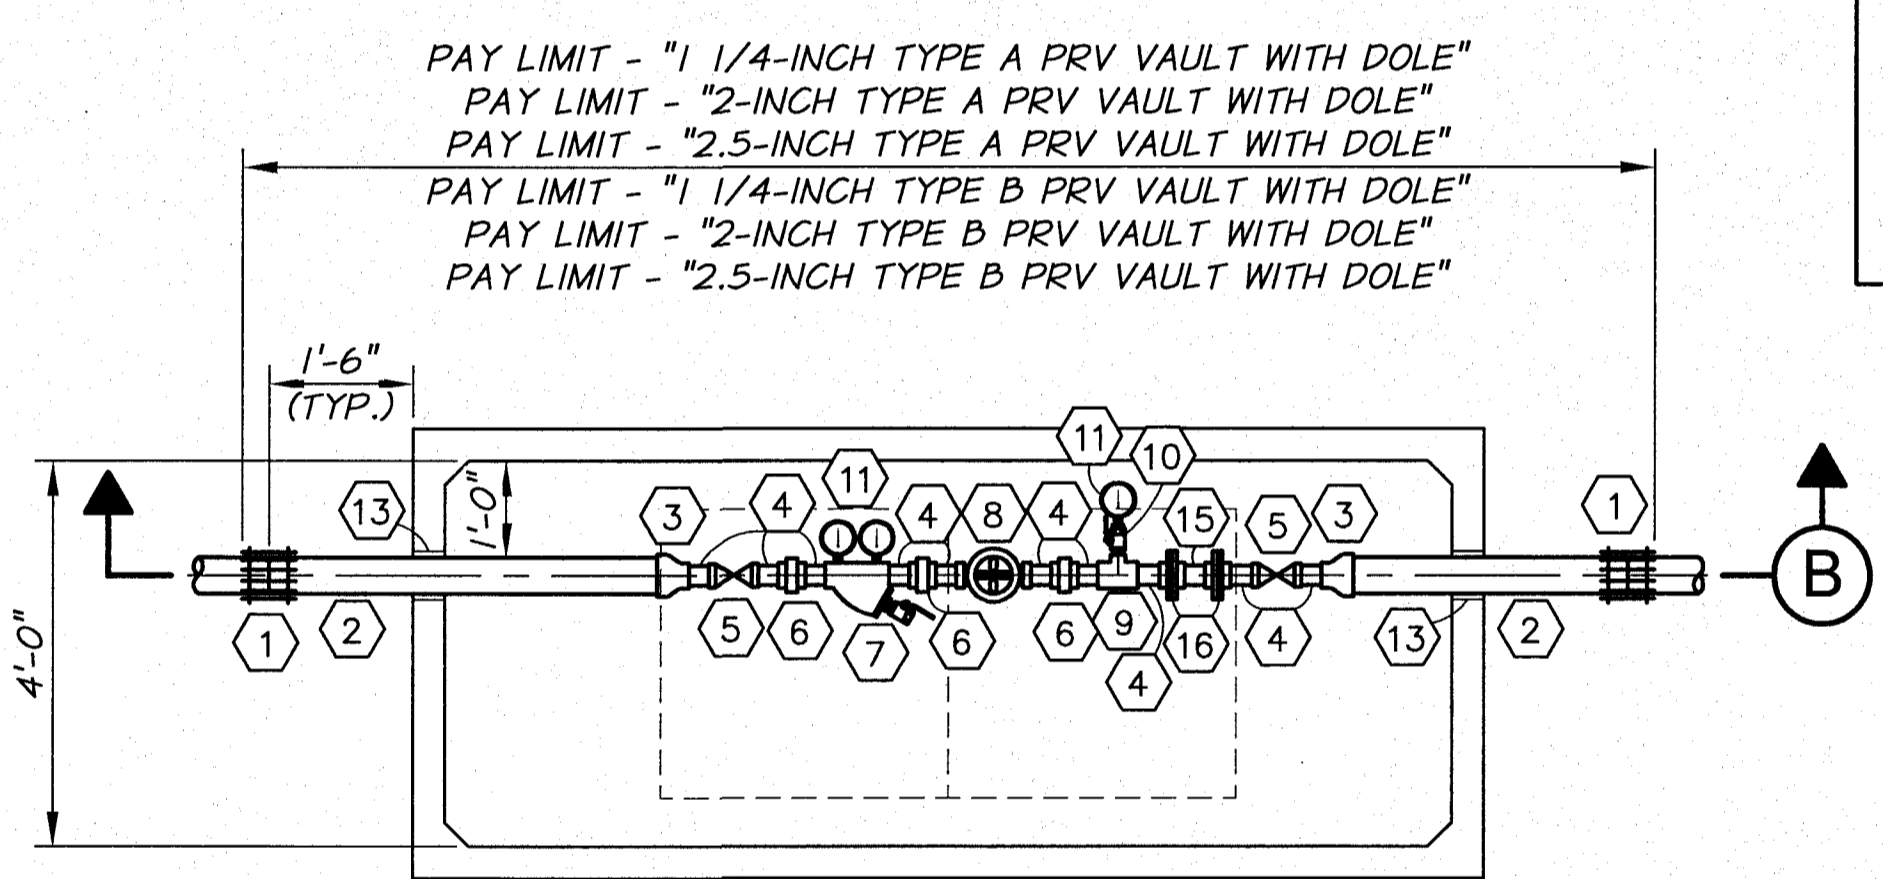


**NOTES:**

1. SET FRAME AND COVER TO GRADE AND PROVIDE GRADE RINGS AS REQUIRED.
2. PIPE SUPPORTS TO BE SIZED APPROPRIATELY FOR PIPE AND INSTALLED PER MANUFACTURER'S RECOMMENDATIONS.
3. ALL WORK SHOWN IN THIS DETAIL, INCLUDING ANY REQUIRED SURFACE RESTORATION, SHALL BE INCLUDED IN THE "...-INCH TYPE A OR B PRV VAULT WITH DOLE" PAY ITEM.

**1 1/4", 2", AND 2 1/2" PRV VAULT WITH DOLE FCV DETAIL**

TYPE A OR TYPE B  
 N.T.S.

**NOTE:**  
 THREAD CLEARANCE SHALL BE 3/8" MINIMUM. OVER TIGHTENED FITTINGS WILL BE REJECTED AND PIPING ASSEMBLY REASSEMBLED TO MEET REQUIREMENTS. SEE SPECIFICATIONS FOR MORE DETAILS.

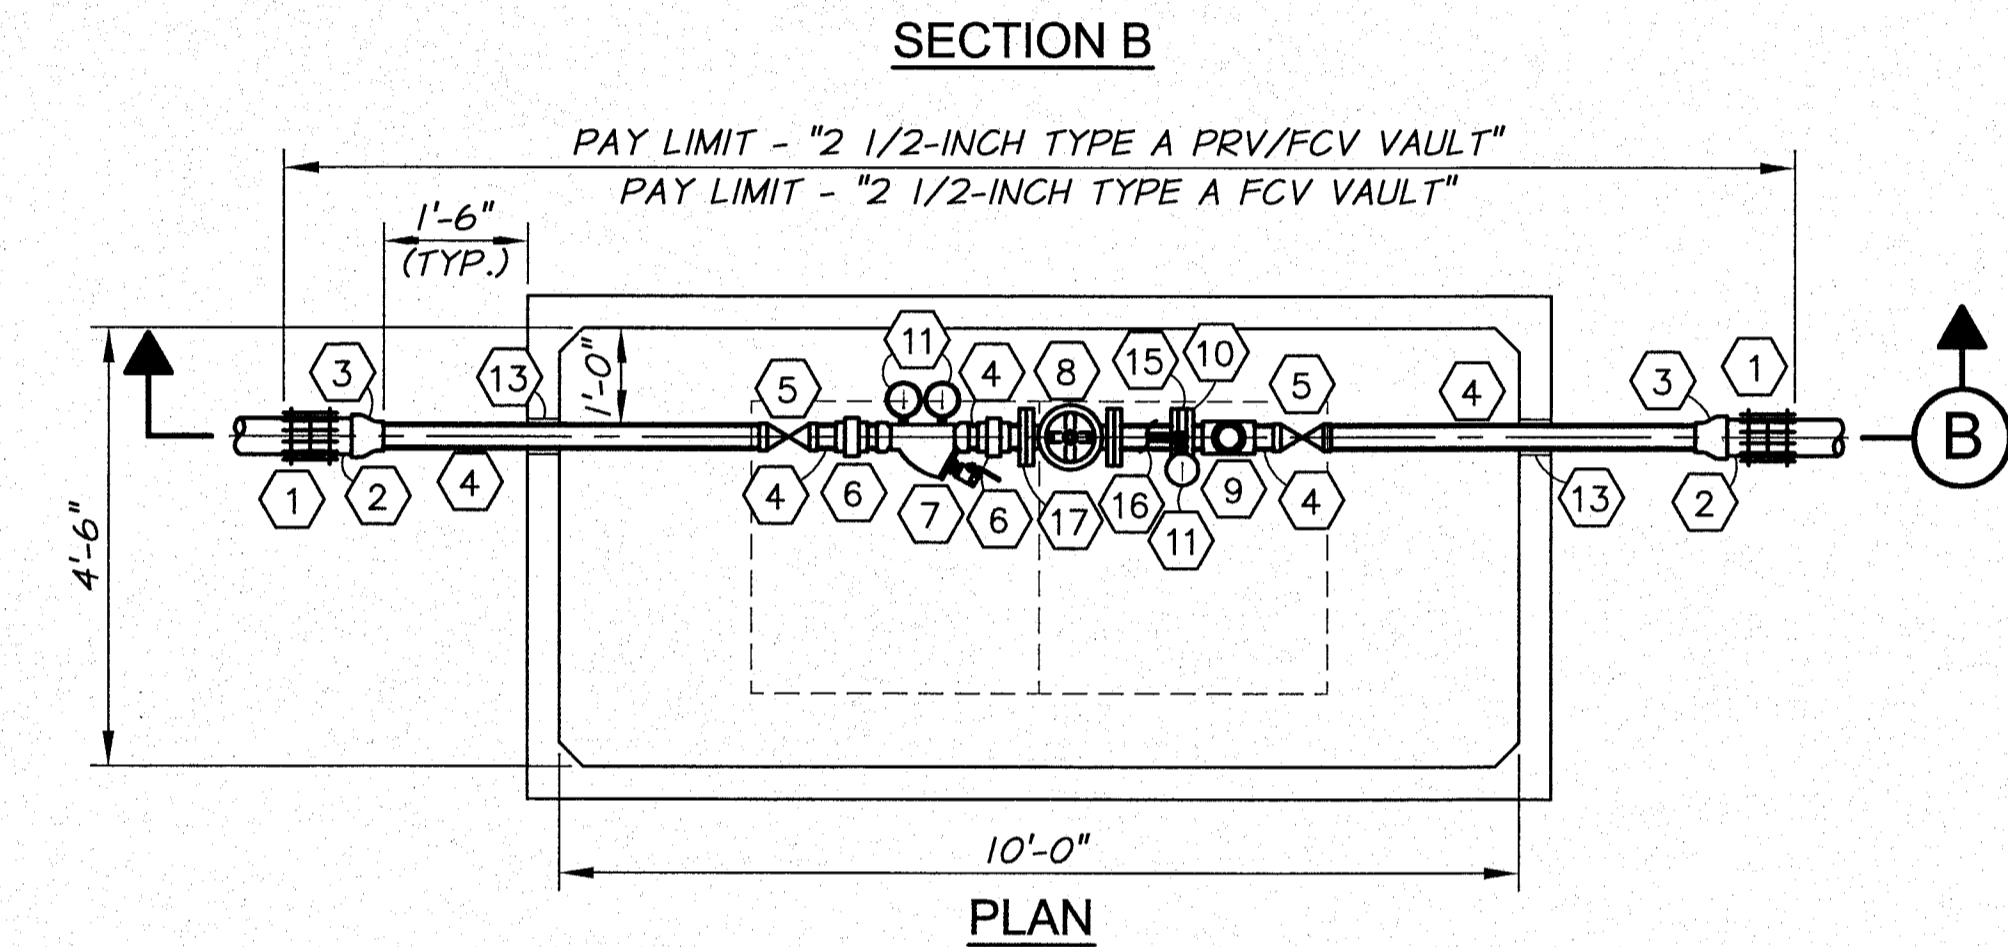

- NOTES:**
1. SET FRAME AND COVER TO GRADE AND PROVIDE GRADE RINGS AS REQUIRED.
  2. PIPE SUPPORTS TO BE SIZED APPROPRIATELY FOR PIPE AND INSTALLED PER MANUFACTURER'S RECOMMENDATIONS.
  3. ALL WORK SHOWN IN THIS DETAIL, INCLUDING ANY REQUIRED SURFACE RESTORATION, SHALL BE INCLUDED IN THE PAY ITEM.

**FITTING SCHEDULE**

- 1 TRANSITION COUPLING
- 2 GIP, SIZE AS SHOWN ON PLANS
- 3 THREADED GIP REDUCER WHERE REQUIRED
- 4 2 1/2" THREADED GIP
- 5 BRASS THREADED GATE VALVE
- 6 GIP UNION AND BUSHINGS AS REQUIRED
- 7 3" SONNTAG ALUMINUM Y FILTER WITH 3/32 SCREEN, FITTINGS AS REQUIRED
- 8 2 1/2" FLANGED PRESSURE REDUCING/FLOW CONTROL VALVE, CLA-VAL MODEL 496-01AB. FOR FLOW CONTROL ONLY, USE CLA-VAL MODEL 406-01AB.
- 9 THREADED 2 1/2" GIP TEE WITH BALL VALVE, GIP, AND CAM-LOCK ADAPTER AND CAP
- 10 RAISED FACE FLANGE X THREADED GIP SPOOL
- 11 4" 55 GLYCERIN FILLED PRESSURE GAUGE AND ISOLATION VALVE WITH FITTINGS AS REQUIRED ON ORIFICE PILOT PIPING. ORIENT GAUGE SO THAT FACE IS CLEARLY VISIBLE FROM VAULT ACCESS OPENING.
- 12 PIPE SUPPORT. SEE DETAIL, SHEET 49.
- 13 SEAL PIPE PENETRATIONS WATERTIGHT WITH NON-SHRINK GROUT
- 14 BRASS GRATED DRAIN WITH KNOCKOUT HOLE FOR DRAIN PIPE. DO NOT PROVIDE DRAIN IN HIGH GROUND WATER AREA.
- 15 ORIFICE PLATE
- 16 FLG X RAISED FACE FLG GIP SPOOL X 8" LG.
- 17 FLG X THREADED GIP SPOOL

**2 1/2" TYPE A PRV/FCV AND FCV VAULT DETAIL**


N.T.S.




SIGNED 06-04-12  
 RECORD DRAWINGS

REVISION	BY	DATE	HORIZ. SCALE	VERT. SCALE
DESIGNED BY R. HARRIS	XREFS: TB-BID.dwg		NONE	
DRAWN BY D. CHRISTMAN			JOB NUMBER 1199-336	DATE 2011
REVIEWED BY B. MOORE			ACAD FILE: VaultDets-PH2B.dwg	
COPYRIGHT 2011 BY ANDERSON-PERRY & ASSOC., INC.				


**RECORD DRAWINGS**  
 These record drawings have been prepared, in part, on the basis of information compiled and furnished by others. They may contain some discrepancies and omissions, and do not necessarily represent "exact" field conditions. The Owner and the Engineer accept no responsibility for their accuracy.

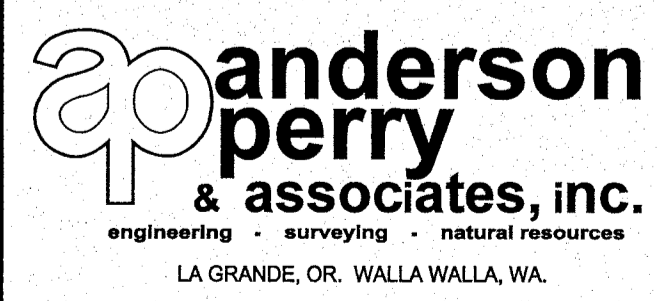


**BENTON IRRIGATION DISTRICT**  
 IRRIGATION SYSTEM IMPROVEMENTS  
 PHASE 2B  
 VALVE VAULT DETAILS II

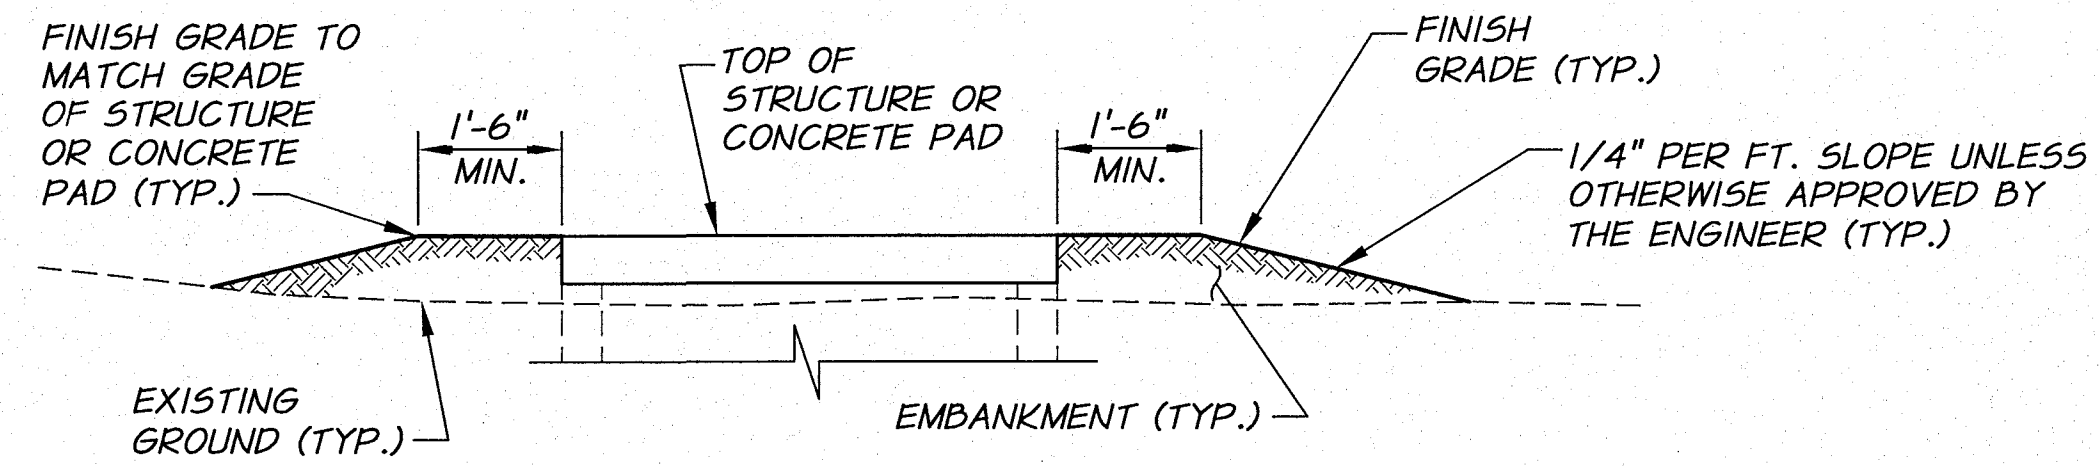

SECTION B

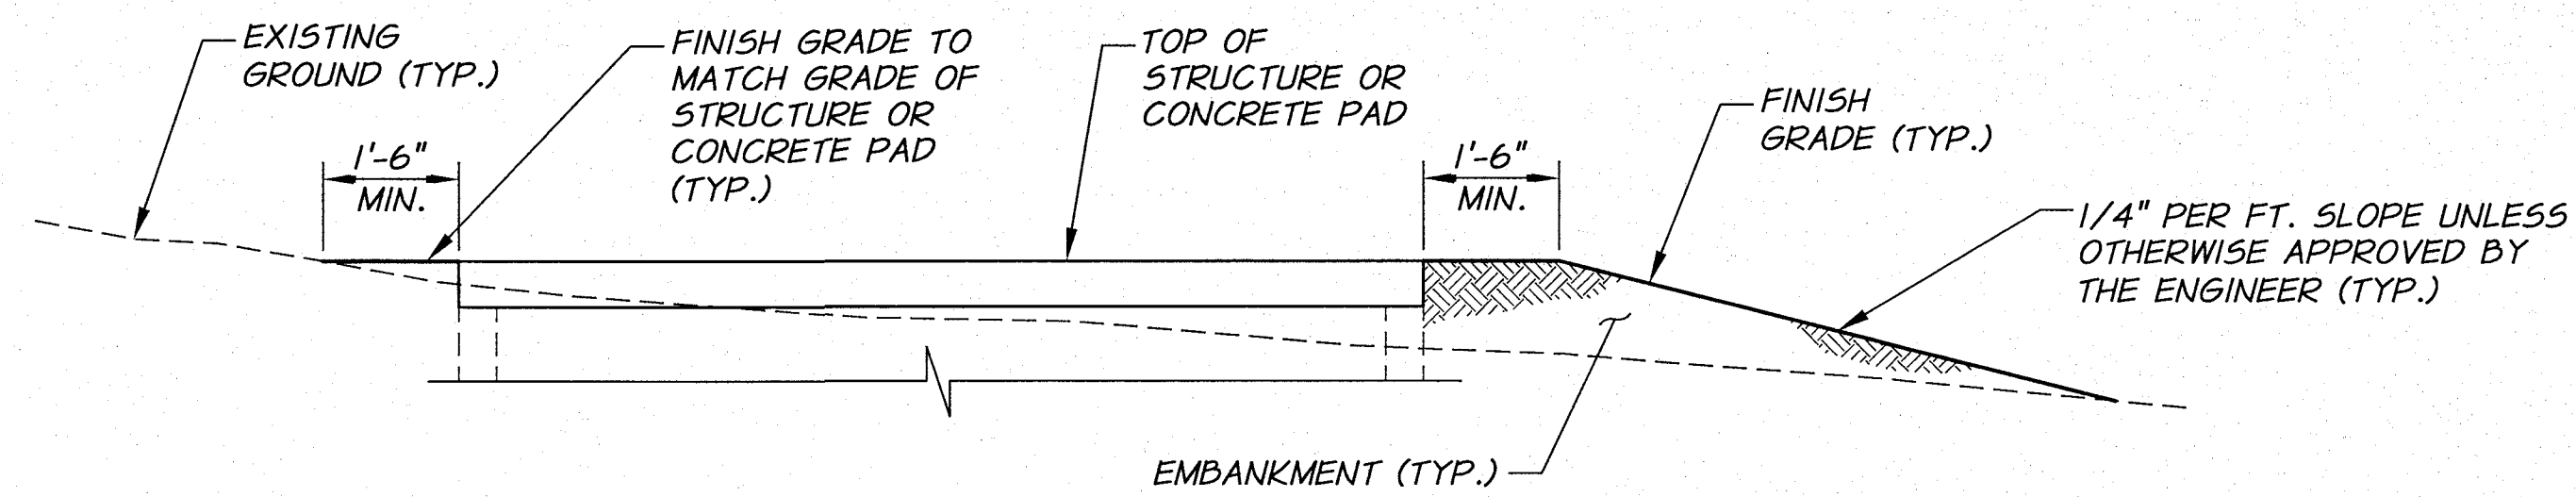


SECTION A

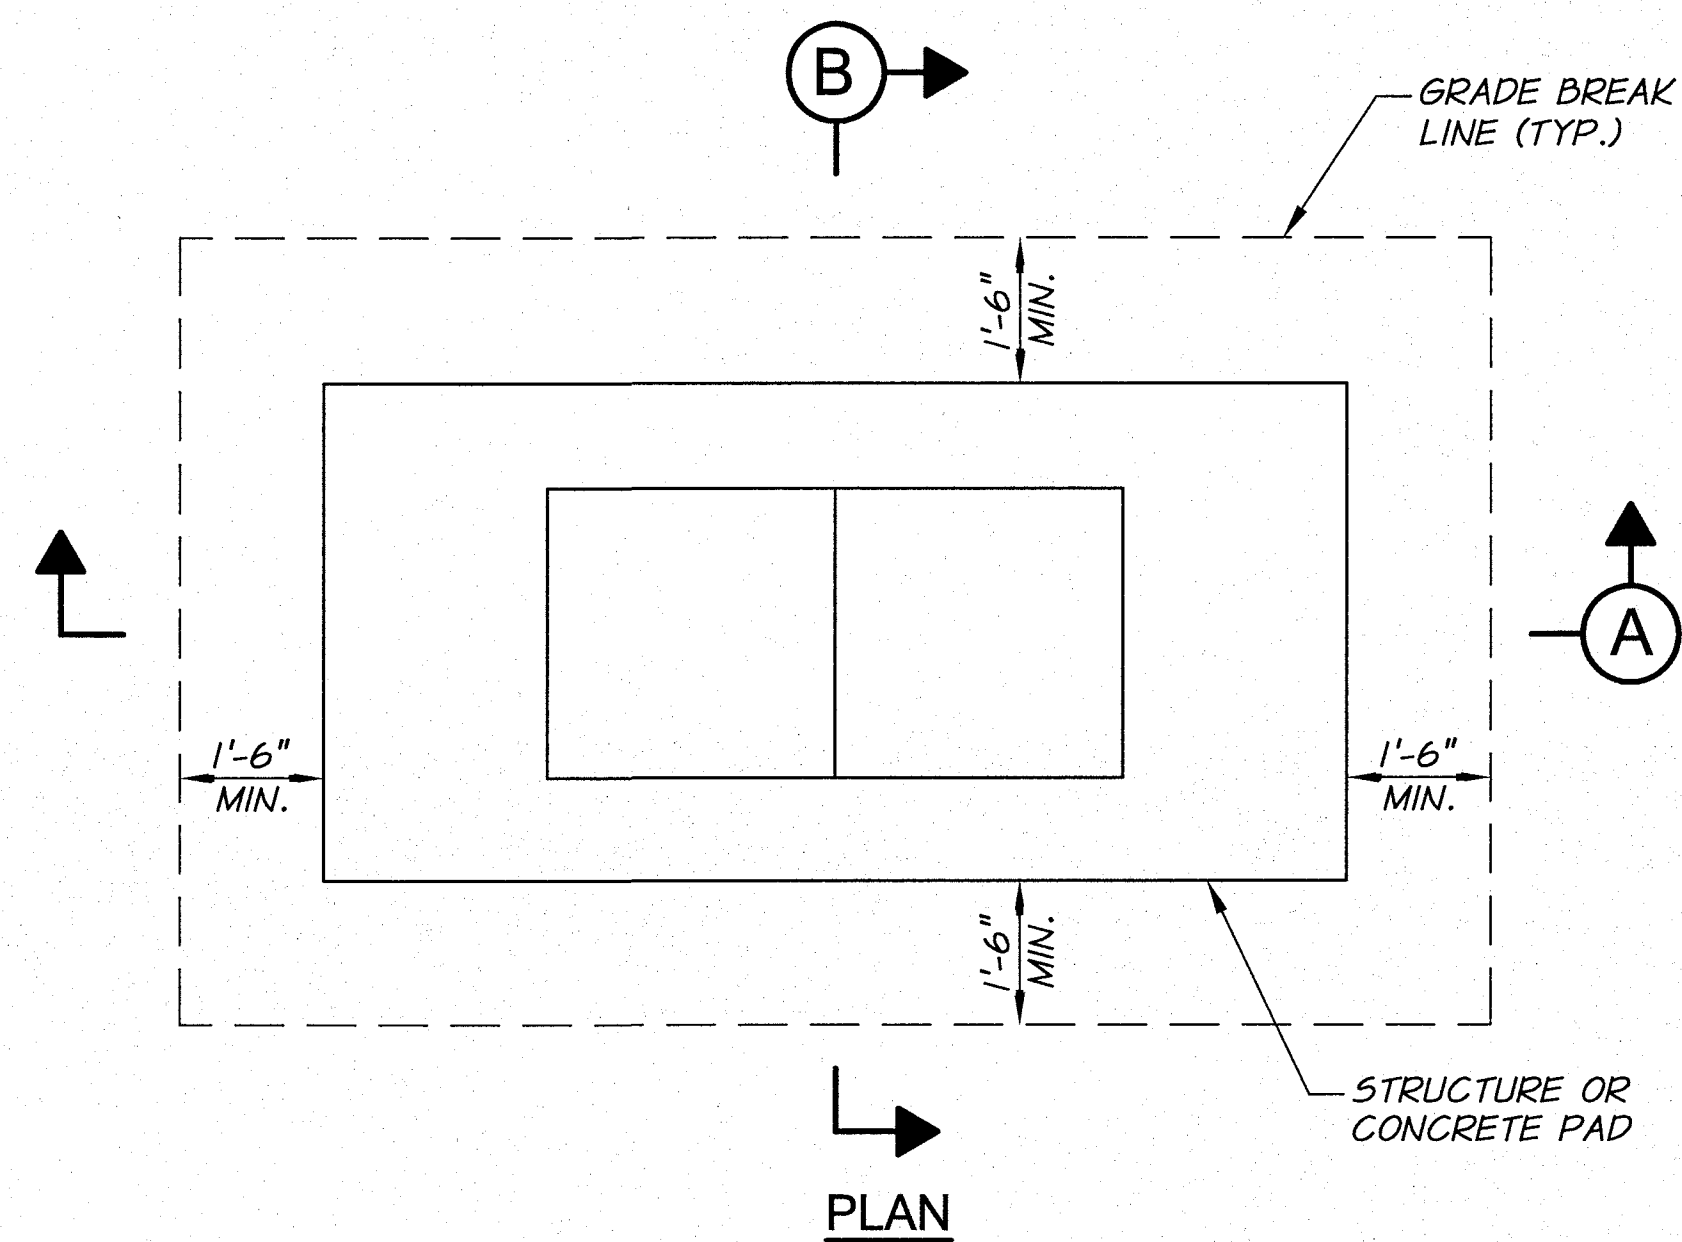


GRADING DETAIL  
N.T.S.

FITTING SCHEDULE

- (51) PVC MAIN PIPING
- (52) COUPLING ADAPTER
- (53) GIP, SIZE OF MAIN
- (54) BRASS THREADED GATE VALVE
- (55) THREADED RAISED FACE FLANGE WITH GASKET MATCHING FACE OF FLANGE. 4 EA. STAINLESS STEEL BOLTS AND NUTS. BOLT LENGTH AS REQUIRED TO PASS THROUGH ALL FLANGES.
- (56) DOLE FLOW CONTROL VALVE, SIZE SPECIFIED ON DRAWINGS
- (57) 54" PRECAST MANHOLE WITH H2O TRAFFIC RATED FLAT TOP AND 24" MANHOLE COVER WITH FRAME CAST INTO SLAB
- (58) SEAL PIPE PENETRATIONS WATERTIGHT WITH NON-SHRINK GROUT

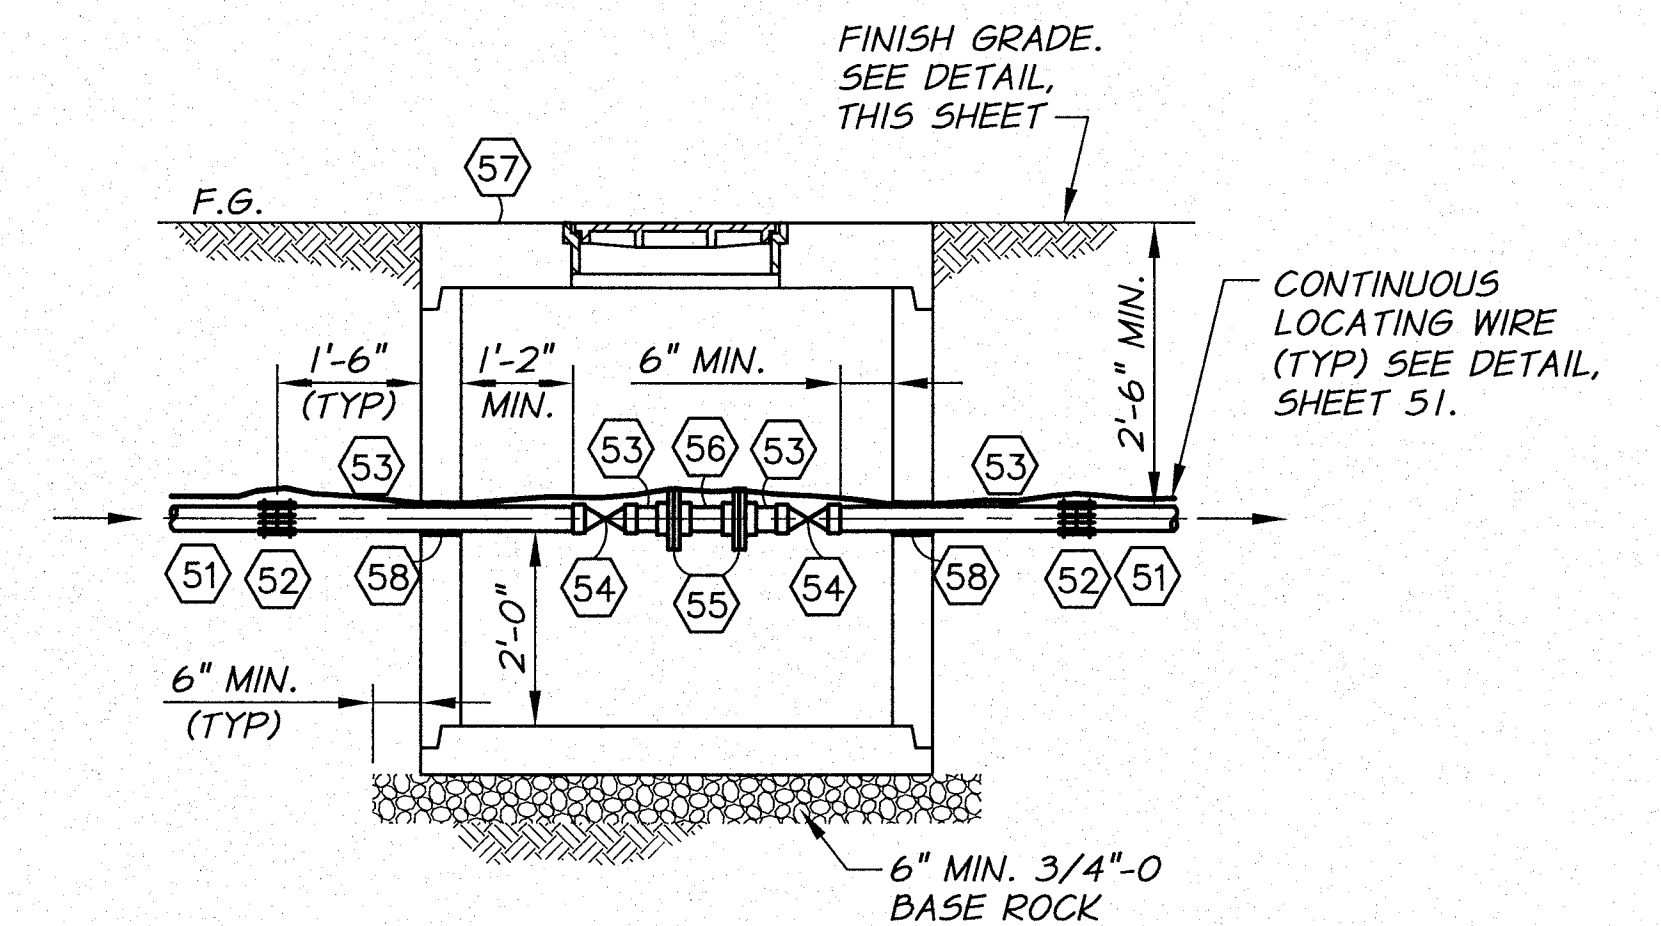

SECTION B

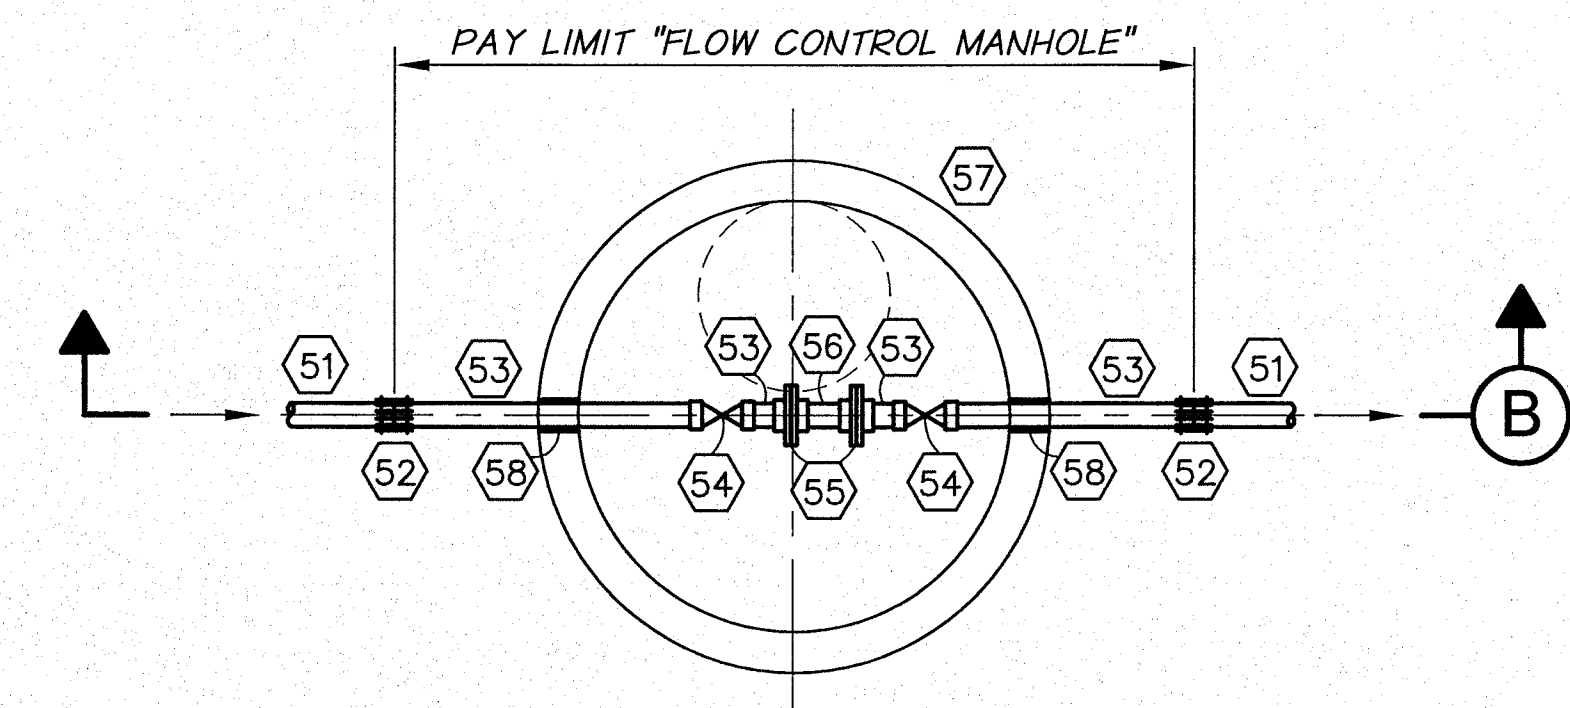


FLOW CONTROL MANHOLE DETAIL  
N.T.S.



SIGNED 06-04-12  
RECORD DRAWINGS

REVISION	BY	DATE	HORIZ. SCALE	VERT. SCALE
DESIGNED BY	R. HARRIS		NONE	
DRAWN BY	D. CHRISTMAN		JOB NUMBER	1199-336
REVIEWED BY	B. MOORE		ACAD FILE	VaultDets-PH2B.dwg
			DATE	2011
			COPYRIGHT 2011 BY ANDERSON-PERRY & ASSOC., INC.	

**RECORD DRAWINGS**  
These record drawings have been prepared, in part, on the basis of information compiled and furnished by others. They may contain some discrepancies and omissions, and do not necessarily represent "exact" field conditions. The Owner and the Engineer accept no responsibility for their accuracy.

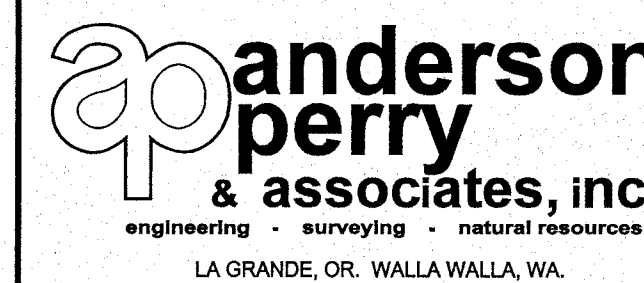

**BENTON IRRIGATION DISTRICT**  
IRRIGATION SYSTEM IMPROVEMENTS  
PHASE 2B



VALVE VAULT DETAILS III

SHEET


46

**FITTING SCHEDULE**

- 1 PVC PIPING, SIZE PER MAIN LINE
- 2 MJ ECCENTRIC REDUCER
- 3 PVC PIPING (SAME SIZE AS CONTROL VALVE)
- 4 MJ GATE VALVE WITH VALVE BOX. SEE DETAIL, SHEET 51.
- 5 COUPLING
- 6 FLG X PE D.I. SPOOL, LENGTH AS REQUIRED (SAME SIZE AS CONTROL VALVE)
- 7 FOR 3" STATION: FLG DI SPOOL x 4'-0" LONG  
FOR 4" STATION: FLG GIP SPOOL x 5'-6" LONG  
FOR 6" AND 8" STATIONS: FLG DI SPOOL x 5'-6" LONG
- 8 FOR 3" STATION: MICROMETER FLOWMETER MODEL MW500  
FOR 4" STATION: MICROMETER FLOWMETER MODEL LP22  
FOR 6" AND 8" STATION: MICROMETER FLOWMETER MODEL LP32
- 9 3/4" TAPPING SADDLE WITH 3/4" THREADED BRASS BALL VALVE, 3/4"x1/4" BUSHING, AND BRASS QUICK COUPLING PLUG (UNVALVED)
- 10 WAFER STYLE 800 SERIES NELSON FLOW CONTROL VALVE. SEE SPECIFICATIONS FOR DETAILS. PROVIDE LONG BOLTS FOR FLANGES AS REQUIRED. LOCATE PADDLE 6" UPSTREAM OF VALVE. 1-INCH TAPPING SADDLE REQUIRED.
- 11 RESTRAINED FLANGE COUPLING ADAPTER
- 12 BRASS GRATED DRAIN WITH KNOCKOUT HOLE FOR DRAIN PIPE. DO NOT PROVIDE DRAIN IN HIGH GROUND WATER AREA.
- 13 PE DI SPOOL LENGTH AS REQUIRED (SAME SIZE AS CONTROL VALVE)
- 14 FLANGE COUPLING ADAPTER
- 15 FLG SIZExSIZExSIZE TEE, BRANCH NOT TO EXCEED 6"
- 16 FLGxMJ GATE VALVE WITH VALVE BOX. SEE DETAIL, SHEET 51.
- 17 SEAL PIPE PENETRATIONS WATERTIGHT WITH NON-SHRINK GROUT
- 18 FLGxPE SPOOL, LENGTH AS REQUIRED, FITTINGS AS REQUIRED
- 19 MAINGUARD BLOW-OFF #7600 FOR 4-INCH, 6-INCH AND 8-INCH CONTROL VALVE STATIONS. ECLIPSE NO. 85 BLOW-OFF HYDRANT FOR 3-INCH CONTROL VALVE STATIONS (SEE TABLE 1, THIS SHEET). ENCLOSURE TO BE CARSON INDUSTRIES MODEL H2436 TRAFFIC BEARING VAULT AND LID WITH EXTENSIONS AS REQUIRED.
- 20 OSHA APPROVED GALVANIZED STEEL LADDER WITH 4 FOOT REMOVABLE EXTENSION
- 21 PIPE SUPPORT. SEE TYPICAL PIPE SUPPORT DETAIL SHEET 49.

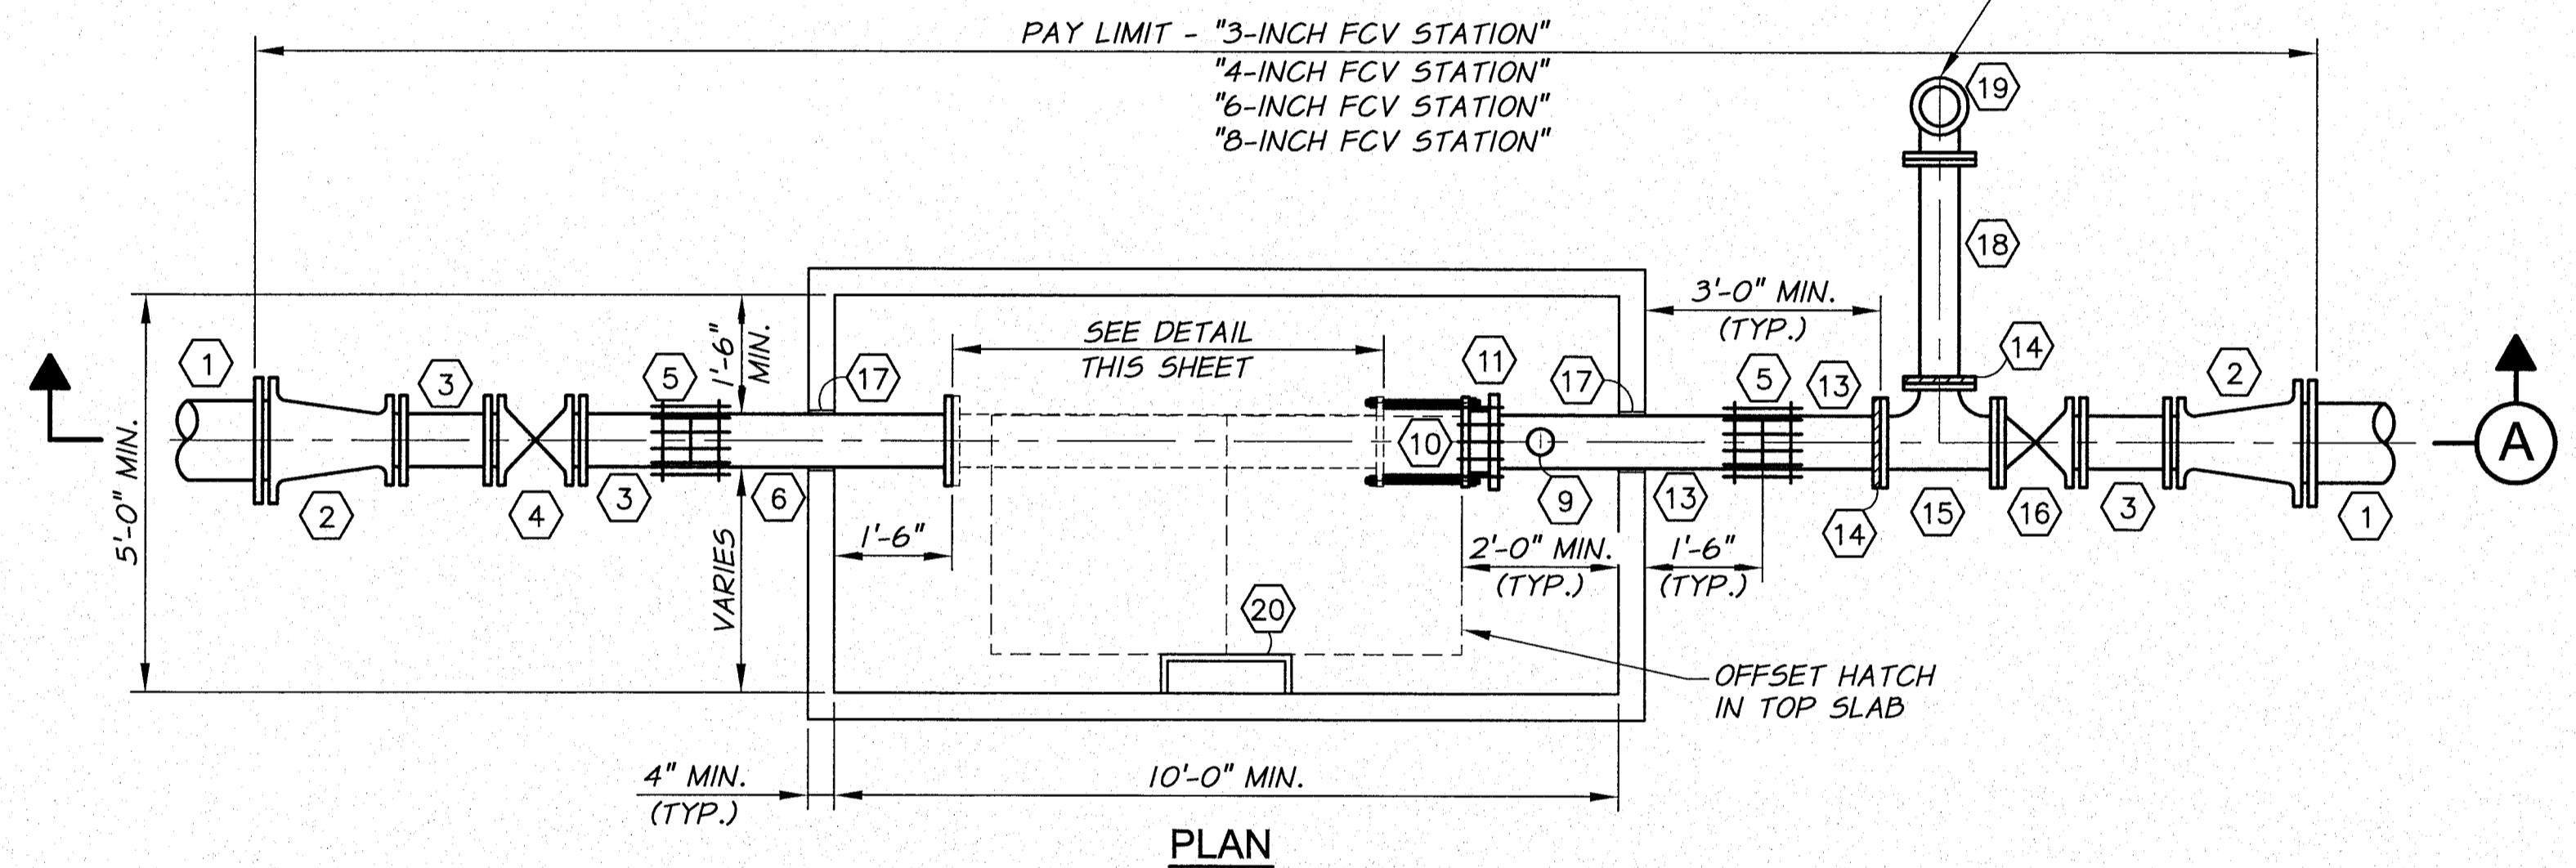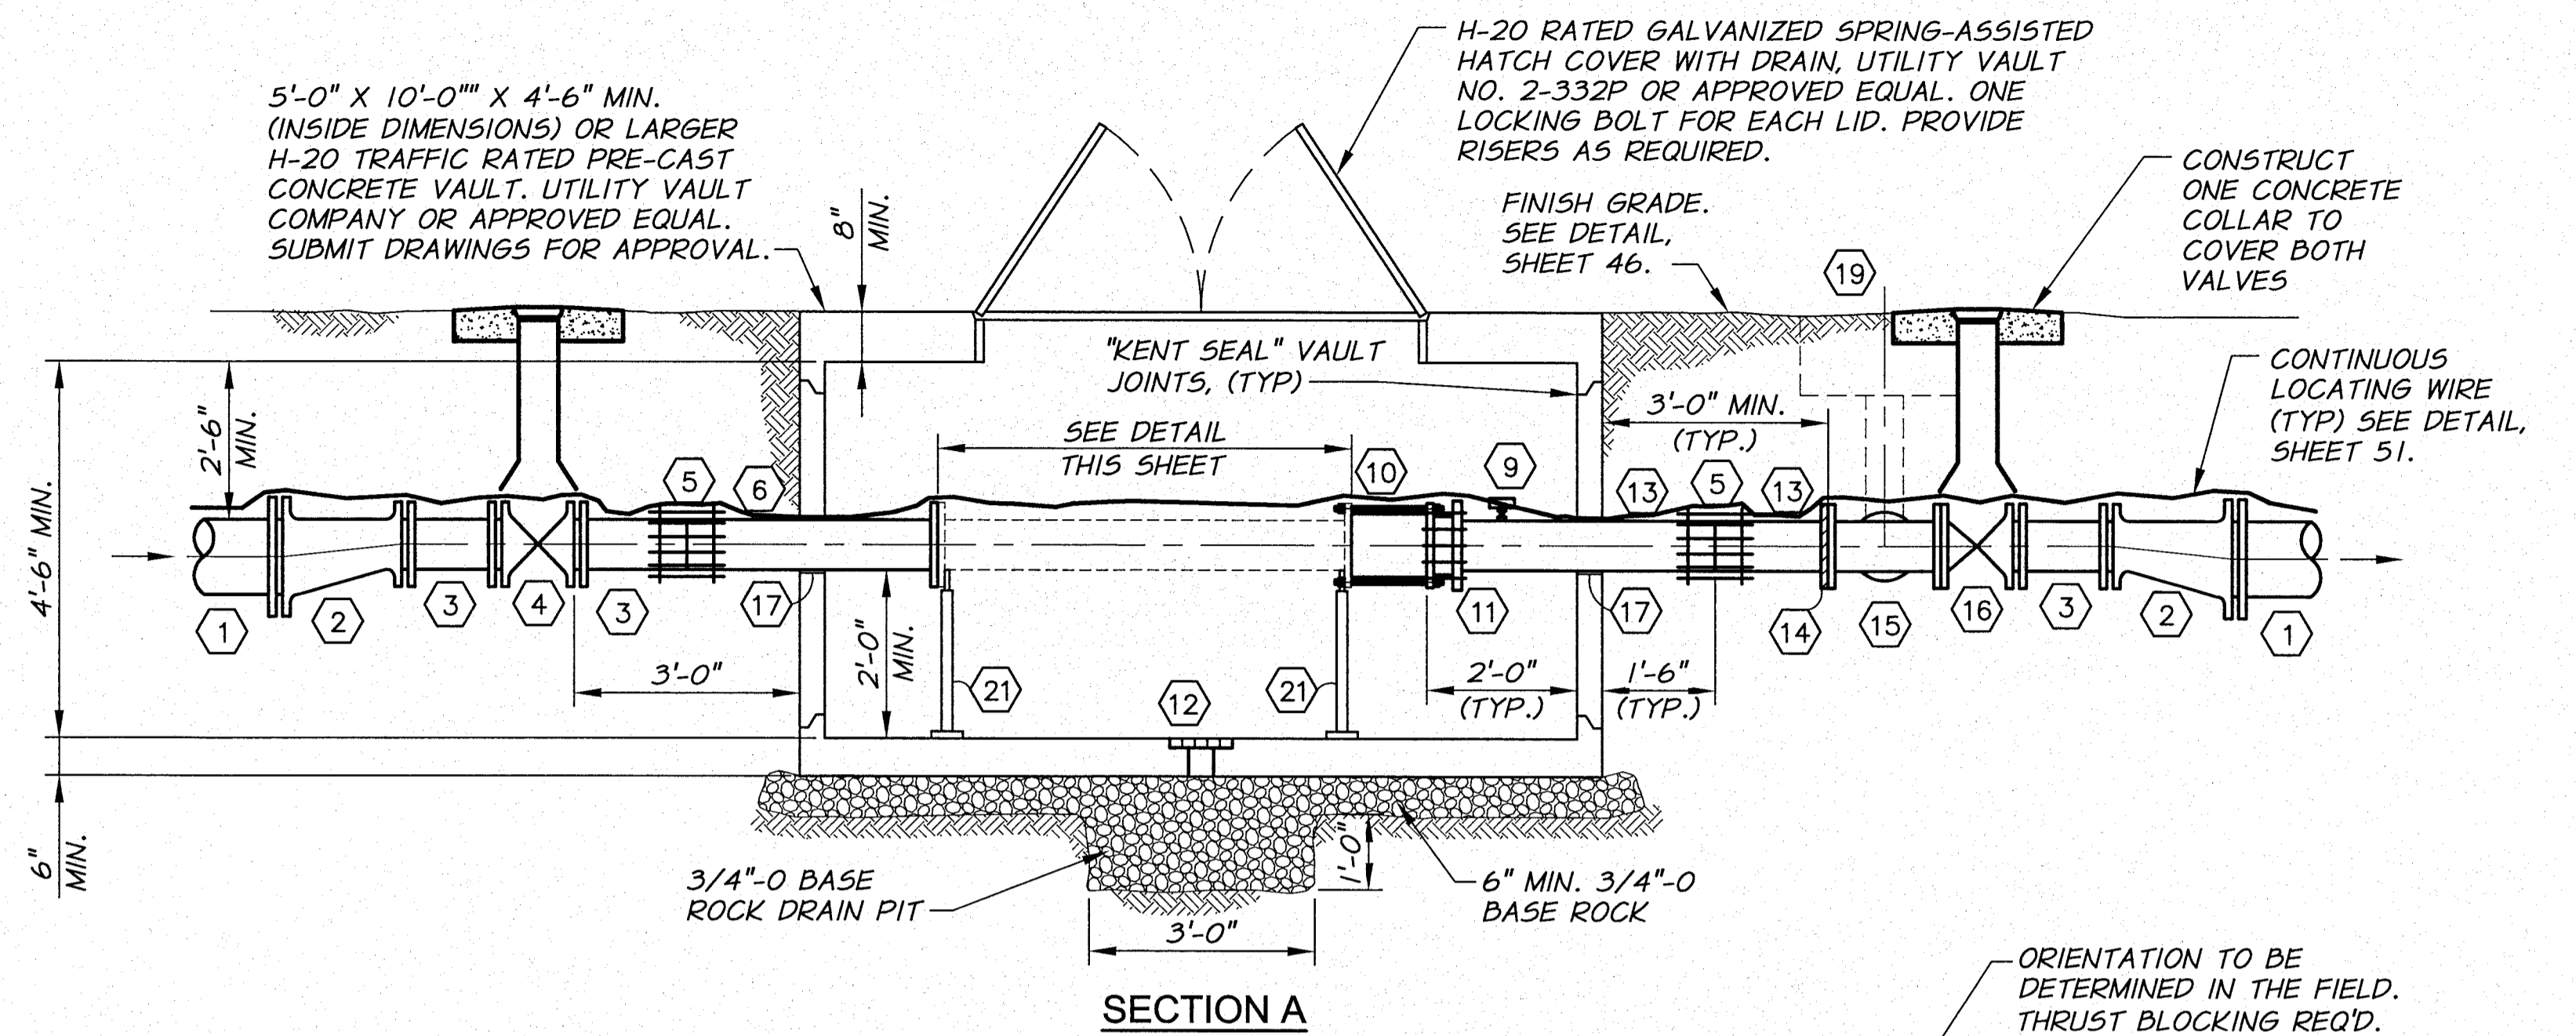

- NOTES:**
1. PIPING SIZE TO MATCH CONTROL VALVE SIZE UNLESS OTHERWISE NOTED.
  2. SET FRAME AND COVER TO GRADE AND PROVIDE GRADE RINGS AS REQUIRED.
  3. PIPE SUPPORTS TO BE SIZED APPROPRIATELY FOR PIPE AND INSTALLED PER MANUFACTURER'S RECOMMENDATIONS.
  4. ALL WORK SHOWN IN THIS DETAIL, INCLUDING ANY REQUIRED SURFACE RESTORATION, SHALL BE INCLUDED IN THE "...-INCH FCV STATION"

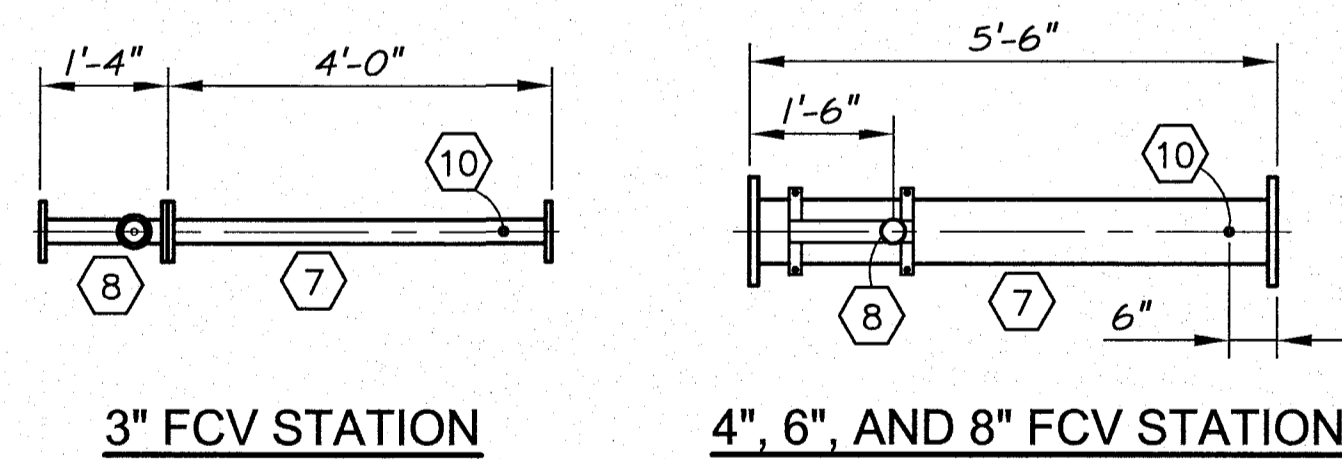


**FLOWMETER PIPING DETAIL**

N.T.S.

CONTROL VALVE SIZE	BLOW-OFF TYPE	INLET	OUTLET
3-INCH	ECLIPSE NO. 85 BLOW-OFF HYDRANT	3"	2 1/2 NST
4-INCH	MAINGUARD BLOW-OFF #7600	4"	4"
6-INCH	MAINGUARD BLOW-OFF #7600	6"	4"
8-INCH	MAINGUARD BLOW-OFF #7600	6"	4"

**3", 4", 6" AND 8" FCV STATION DETAIL**

N.T.S.

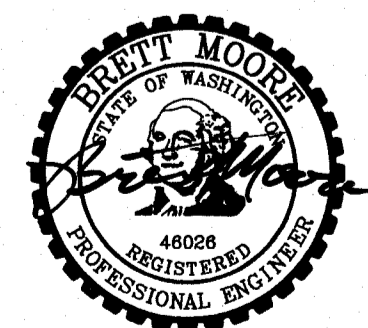


SIGNED 06-04-12  
RECORD DRAWINGS

REVISION	BY	DATE	HORIZ. SCALE NONE	VERT. SCALE
DESIGNED BY R. HARRIS	XREFS: TB-BID.dwg		JOB NUMBER 1199-336	DATE 2011
DRAWN BY D. CHRISTMAN			ACAD FILE: VaultDets-PH2B.dwg	
REVIEWED BY D. MOORE			COPYRIGHT 2011 BY ANDERSON-PERRY & ASSOC., INC.	

**RECORD DRAWINGS**

These record drawings have been prepared, in part, on the basis of information compiled and furnished by others. They may contain some discrepancies and omissions, and do not necessarily represent "exact" field conditions. The Owner and the Engineer accept no responsibility for their accuracy.

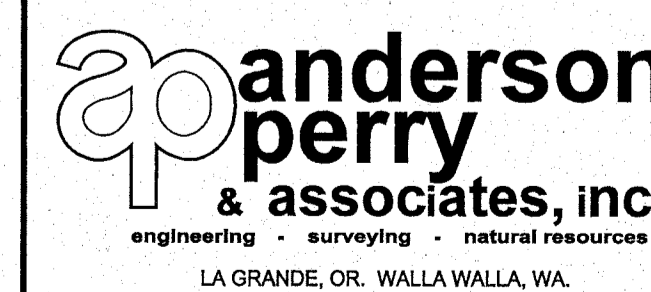

**BENTON IRRIGATION DISTRICT**  
IRRIGATION SYSTEM IMPROVEMENTS  
PHASE 2B

VALVE STATION DETAILS I

SHEET


47

ARCHIVED


**FITTING SCHEDULE**

- ① SERVICE LINE PVC PIPING
- ② MJ ECCENTRIC REDUCER
- ③ CLASS 200 PVC PIPING (SAME SIZE AS CONTROL VALVE)
- ④ MJ GATE VALVE WITH VALVE BOX. SEE DETAIL, SHEET 51.
- ⑤ COUPLING
- ⑥ FLG X PE D.I. SPOOL, LENGTH AS REQUIRED (SAME SIZE AS CONTROL VALVE)
- ⑦ FOR 3" STATION: 3" FLG DI SPOOL X 1'-8" LG.  
FOR 4" STATION: 4" FLG GIP SPOOL X 4'-0" LG.  
FOR 6" STATION: 6" FLG DI SPOOL X 4'-0" LG.  
FOR 8" STATION: 8" FLG DI SPOOL X 4'-0" LG.
- ⑧ FOR 3" STATION: 3" MICROMETER FLOWMETER MODEL MW500  
FOR 4" STATION: 4" MICROMETER FLOWMETER MODEL LP22  
FOR 6" STATION: 6" MICROMETER FLOWMETER MODEL LP32  
FOR 8" STATION: 8" MICROMETER FLOWMETER MODEL LP32
- ⑨ FOR PRV/FCV SERVICE ONLY: 3/4" TAPPING SADDLE WITH 3/4" THREADED BRASS BALL VALVE, 3/4"x1/4" BUSHING, AND BRASS QUICK COUPLING PLUG (UNVALVED)
- ⑩ CLA-VAL 40-01 FLOW CONTROL OR 49-01 COMBINATION FLOW CONTROL AND PRESSURE REDUCING VALVE, TYPE AS SHOWN ON PLANS. SEE TABLE 1, THIS SHEET, AND SPECIFICATIONS FOR DETAILS.
- ⑪ RESTRAINED FLANGE COUPLING ADAPTER
- ⑫ BRASS QUICK COUPLING PLUG (UNVALVED) AND FITTINGS AS REQUIRED ON ORIFICE PILOT PIPING. PROVIDE ADDITIONAL ISOLATION VALVE.
- ⑬ PE DI SPOOL LENGTH AS REQUIRED (SAME SIZE AS CONTROL VALVE)
- ⑭ FLANGE COUPLING ADAPTER AND FITTINGS AS REQUIRED
- ⑮ FLG SIZExSIZExSIZE TEE, BRANCH NOT TO EXCEED 6"
- ⑯ FLGxMJ GATE VALVE WITH VALVE BOX. SEE DETAIL, SHEET 51.
- ⑰ ORIFICE PLATE
- ⑱ FLGxPE SPOOL, LENGTH AS REQUIRED, FITTINGS AS REQUIRED
- ⑲ MAINGUARD BLOW-OFF #7600 (SEE TABLE 1, THIS SHEET). ENCLOSURE TO BE CARSON INDUSTRIES MODEL H2436 TRAFFIC BEARING VAULT AND LID WITH EXTENSIONS AS REQUIRED.
- ⑳ OSHA APPROVED GALVANIZED STEEL LADDER WITH 4 FOOT REMOVABLE EXTENSION
- ㉑ PIPE SUPPORT. SEE TYPICAL PIPE SUPPORT DETAIL SHEET 49.
- ㉒ SEAL PIPE PENETRATIONS WATERTIGHT WITH NON-SHRINK GROUT
- ㉓ BRASS GRATED DRAIN WITH KNOCKOUT HOLE FOR DRAIN PIPE. DO NOT PROVIDE DRAIN IN HIGH GROUND WATER AREA.
- ㉔ FLG x PE DI SPOOL x 2 FT. LONG (SAME SIZE AS CONTROL VALVE)

STATION SIZE	CONTROL VALVE SIZE	BLOW-OFF INLET	BLOW-OFF OUTLET	GATE VALVE SIZE
3-INCH	3"	4"	4"	3"
4-INCH	4"	4"	4"	4"
6-INCH	6"	6"	4"	6"
8-INCH	8"	6"	4"	8"

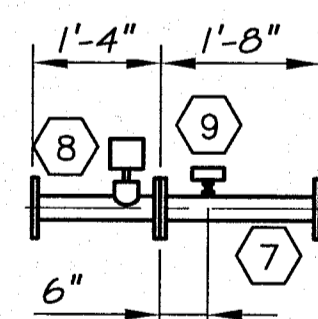


4" SERVICE

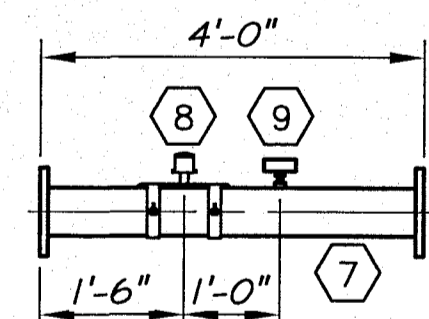


6" AND 8" SERVICE

**FLOWMETER PIPING DETAIL**

N.T.S.

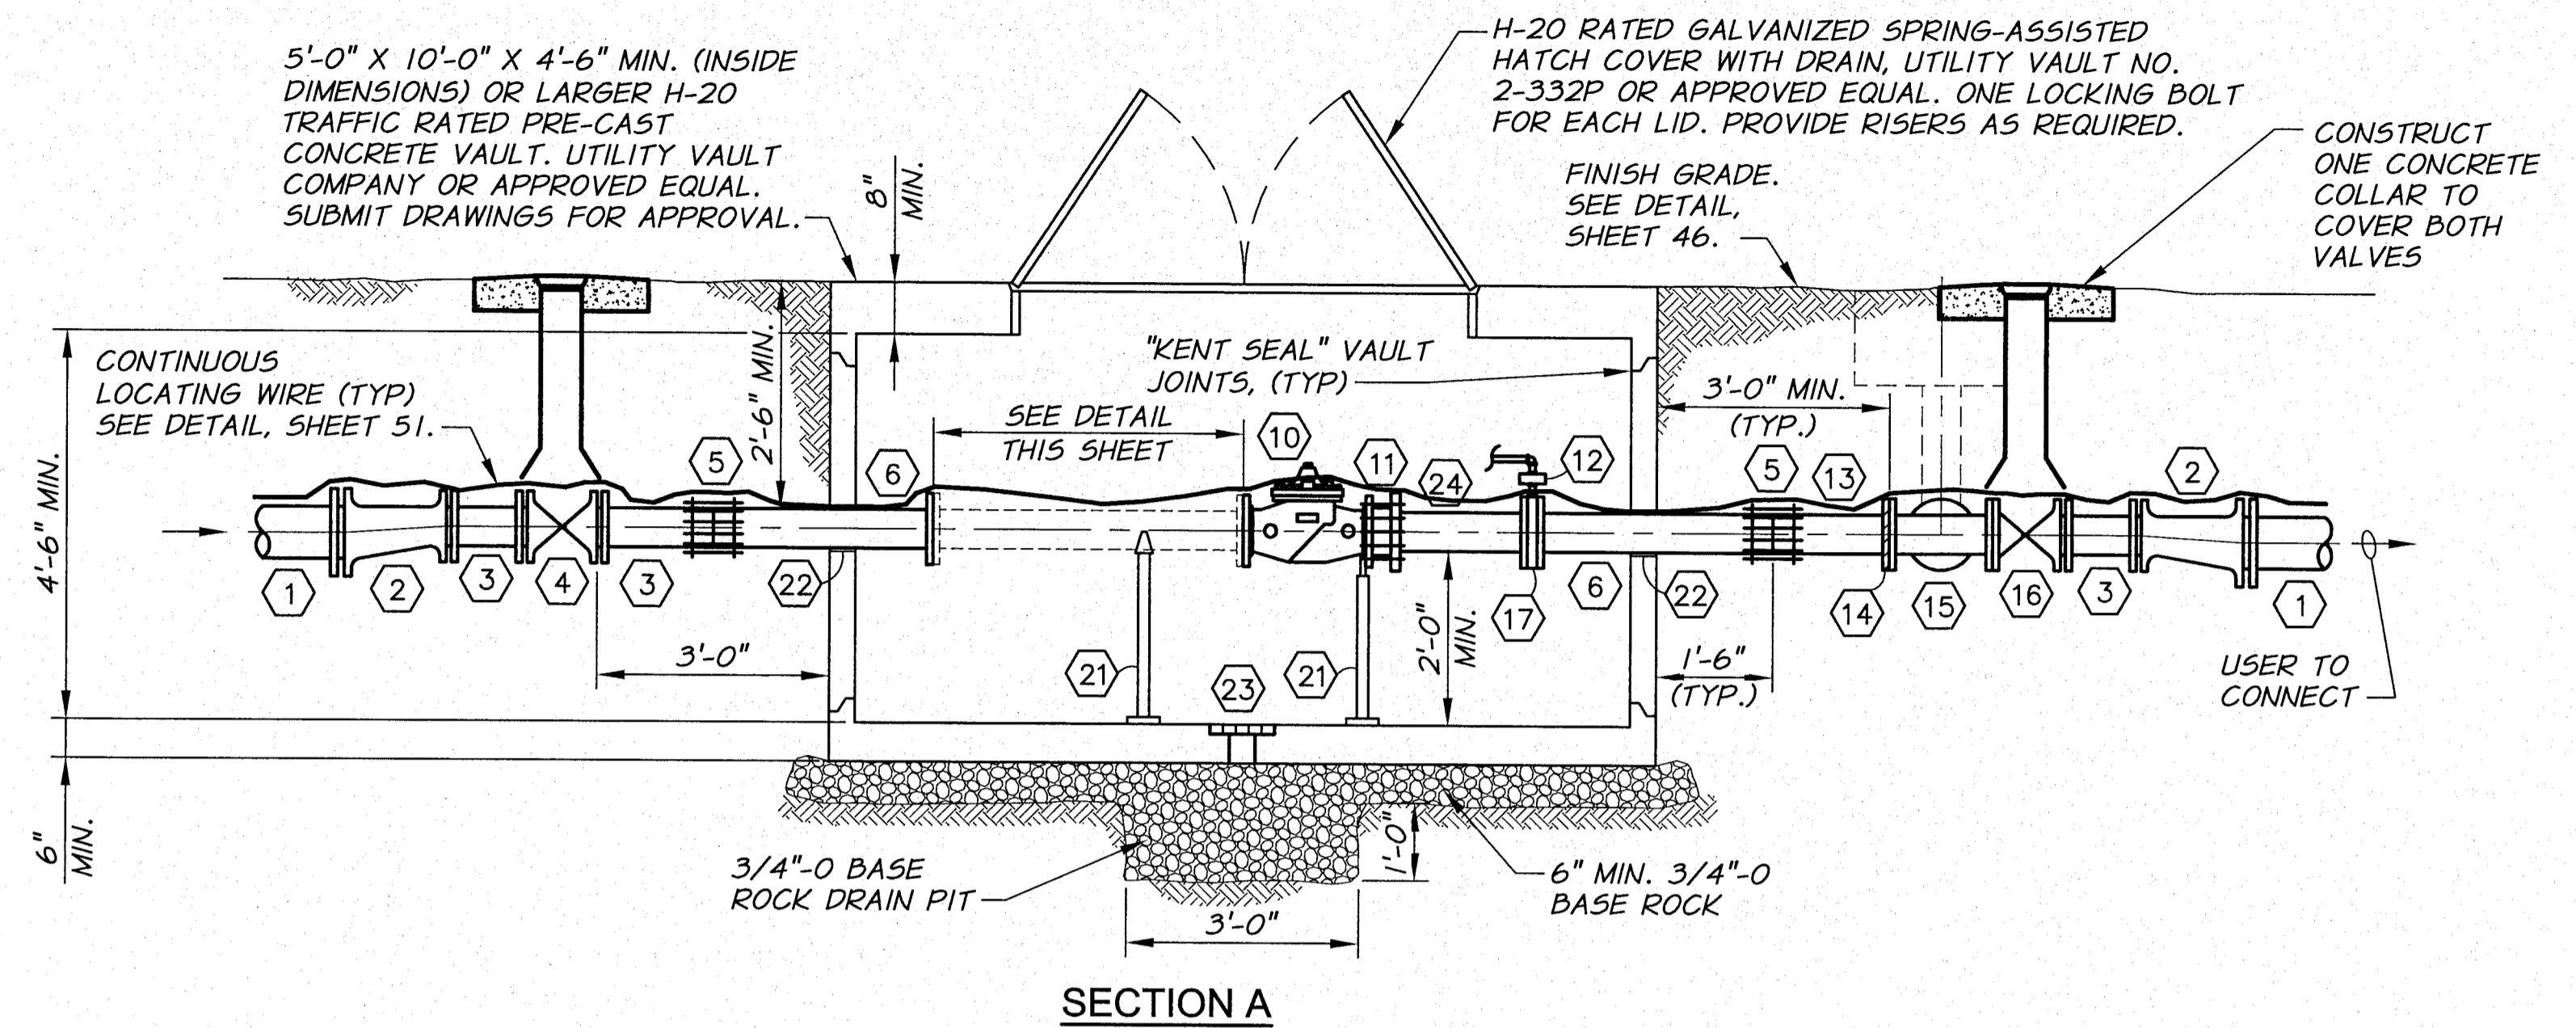

SECTION A

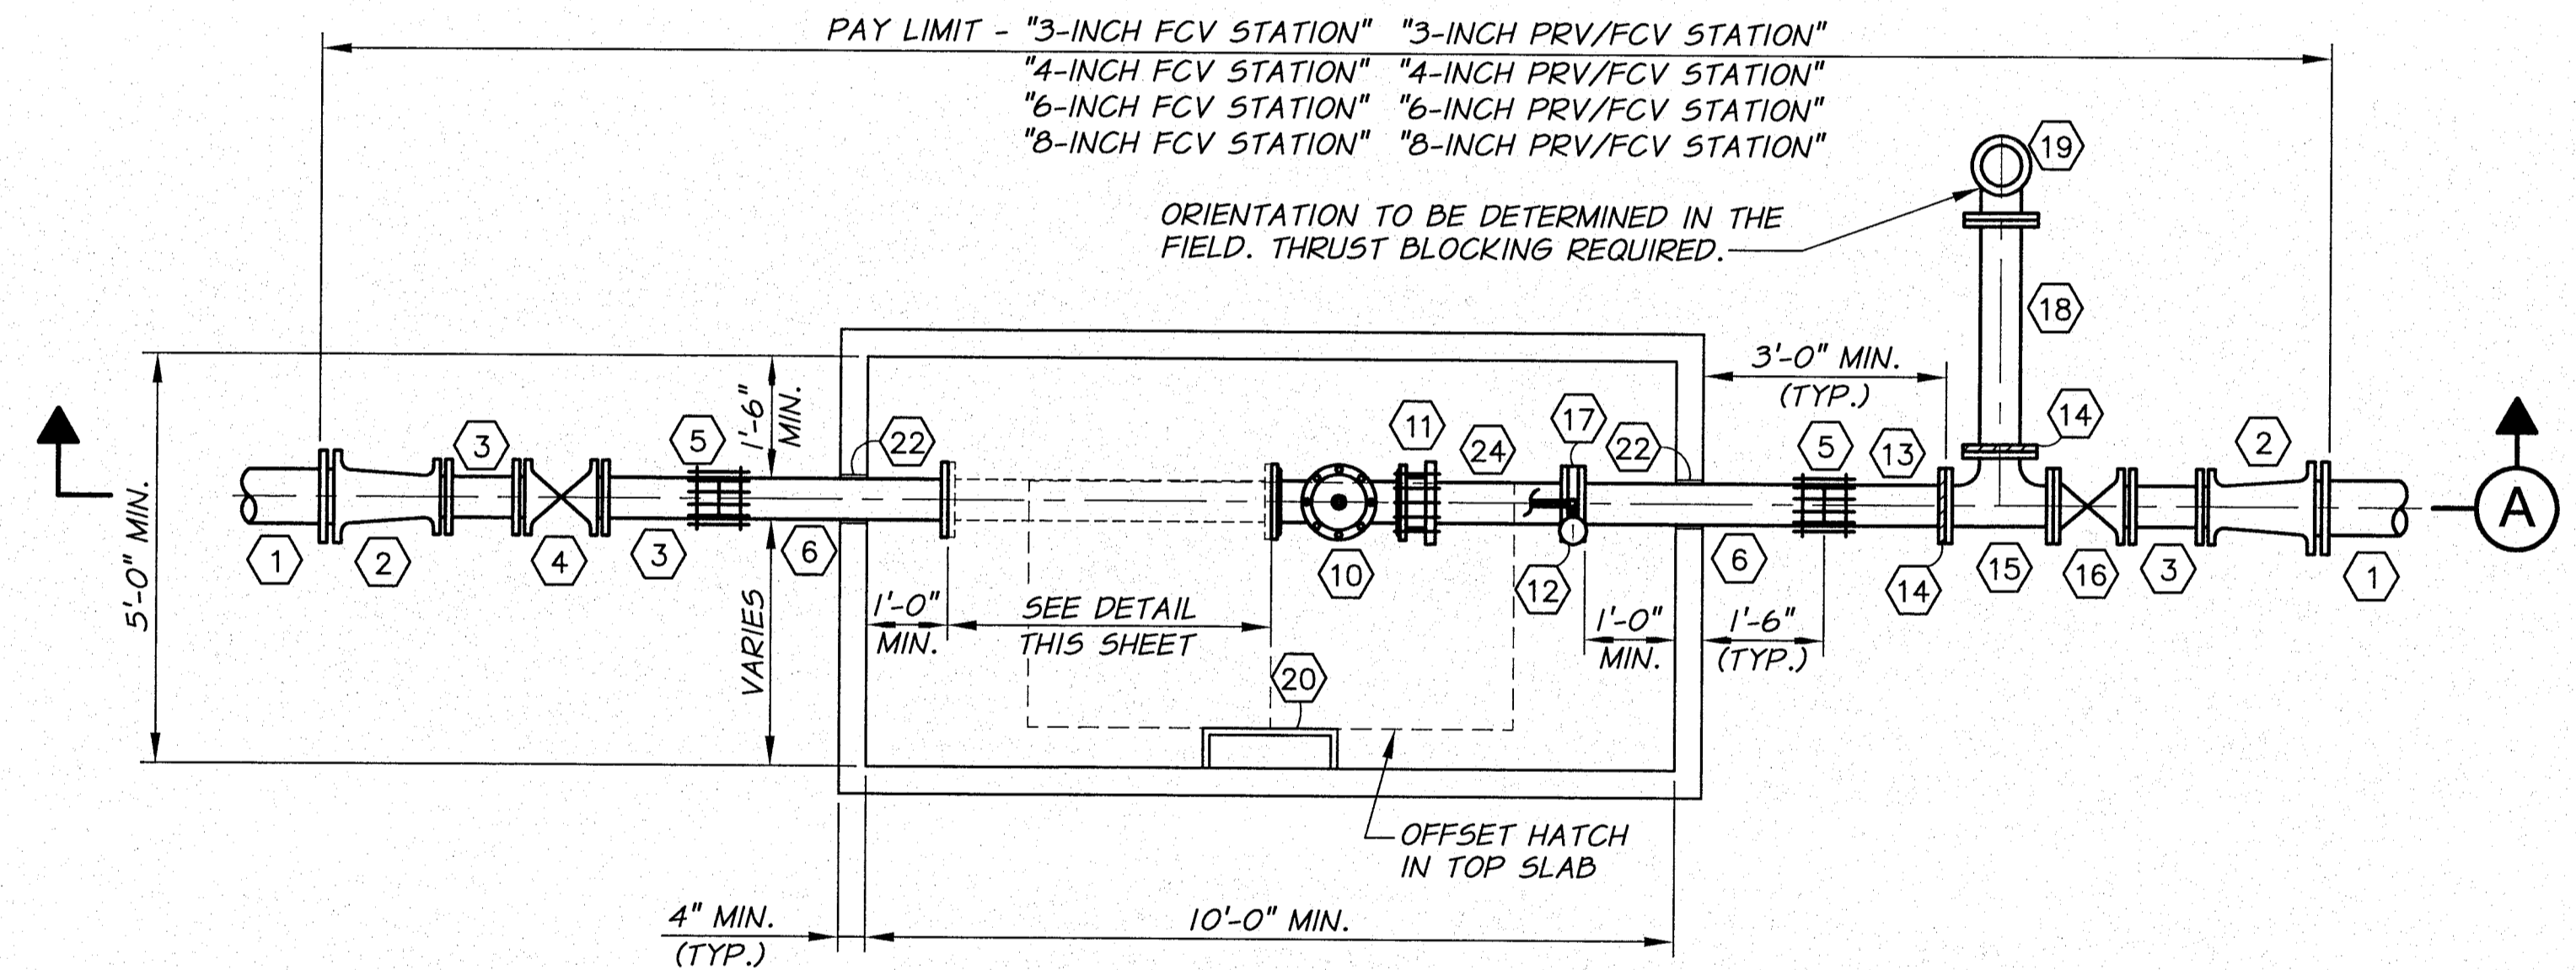

PLAN

- NOTES:**
1. PIPING SIZE TO MATCH CONTROL VALVE SIZE UNLESS OTHERWISE NOTED.
  2. SET FRAME AND COVER TO GRADE AND PROVIDE GRADE RINGS AS REQUIRED.
  3. PIPE SUPPORTS TO BE SIZED APPROPRIATELY FOR PIPE AND INSTALLED PER MANUFACTURER'S RECOMMENDATIONS.
  4. ALL WORK SHOWN IN THIS DETAIL, INCLUDING ANY REQUIRED SURFACE RESTORATION, SHALL BE INCLUDED IN THE "-INCH FCV STATION" OR THE "-INCH PRV/FCV STATION" PAY ITEM.

**3", 4", 6", AND 8" FCV AND PRV/FCV STATION DETAIL**

N.T.S.




SIGNED 06-04-12  
RECORD DRAWINGS

REVISION	BY	DATE	HORIZ. SCALE 1/2"=1'-0"	VERT. SCALE
DESIGNED BY R. HARRIS	XREFS: TB-BID.dwg	JOB NUMBER 1199-336	DATE 2011	
DRAWN BY D. CHRISTMAN		ACAD FILE: VaultDets-PH2B.dwg		
REVIEWED BY B. MOORE		COPYRIGHT 2011 BY ANDERSON-PERRY & ASSOC., INC.		

**RECORD DRAWINGS**

These record drawings have been prepared, in part, on the basis of information compiled and furnished by others. They may contain some discrepancies and omissions, and do not necessarily represent "exact" field conditions. The Owner and the Engineer accept no responsibility for their accuracy.

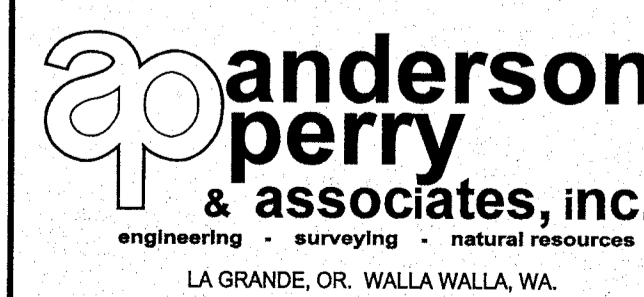


**BENTON IRRIGATION DISTRICT  
IRRIGATION SYSTEM IMPROVEMENTS  
PHASE 2B**

VALVE STATION DETAILS II


SHEET

48

ARCHIVED

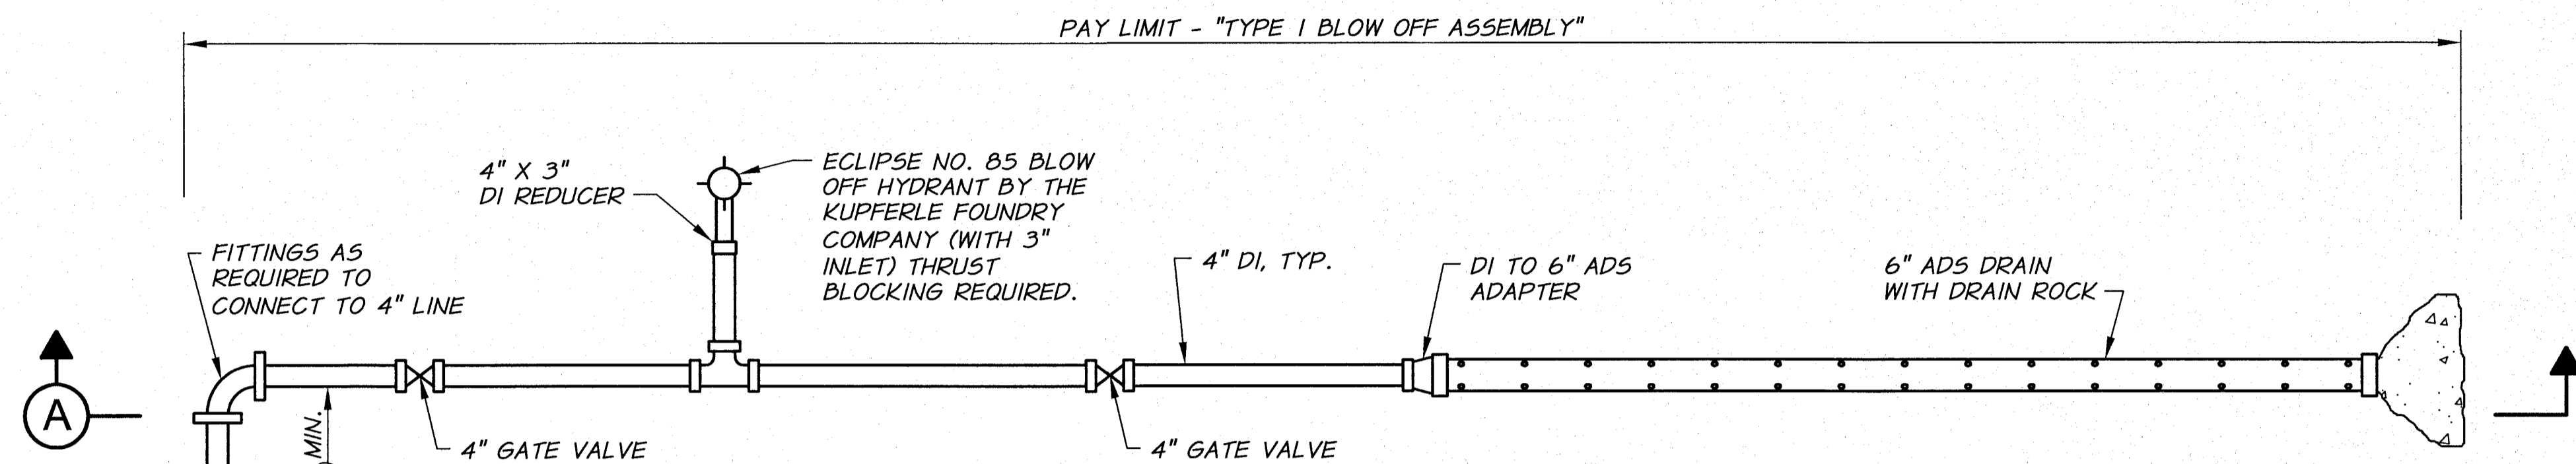


PLAN

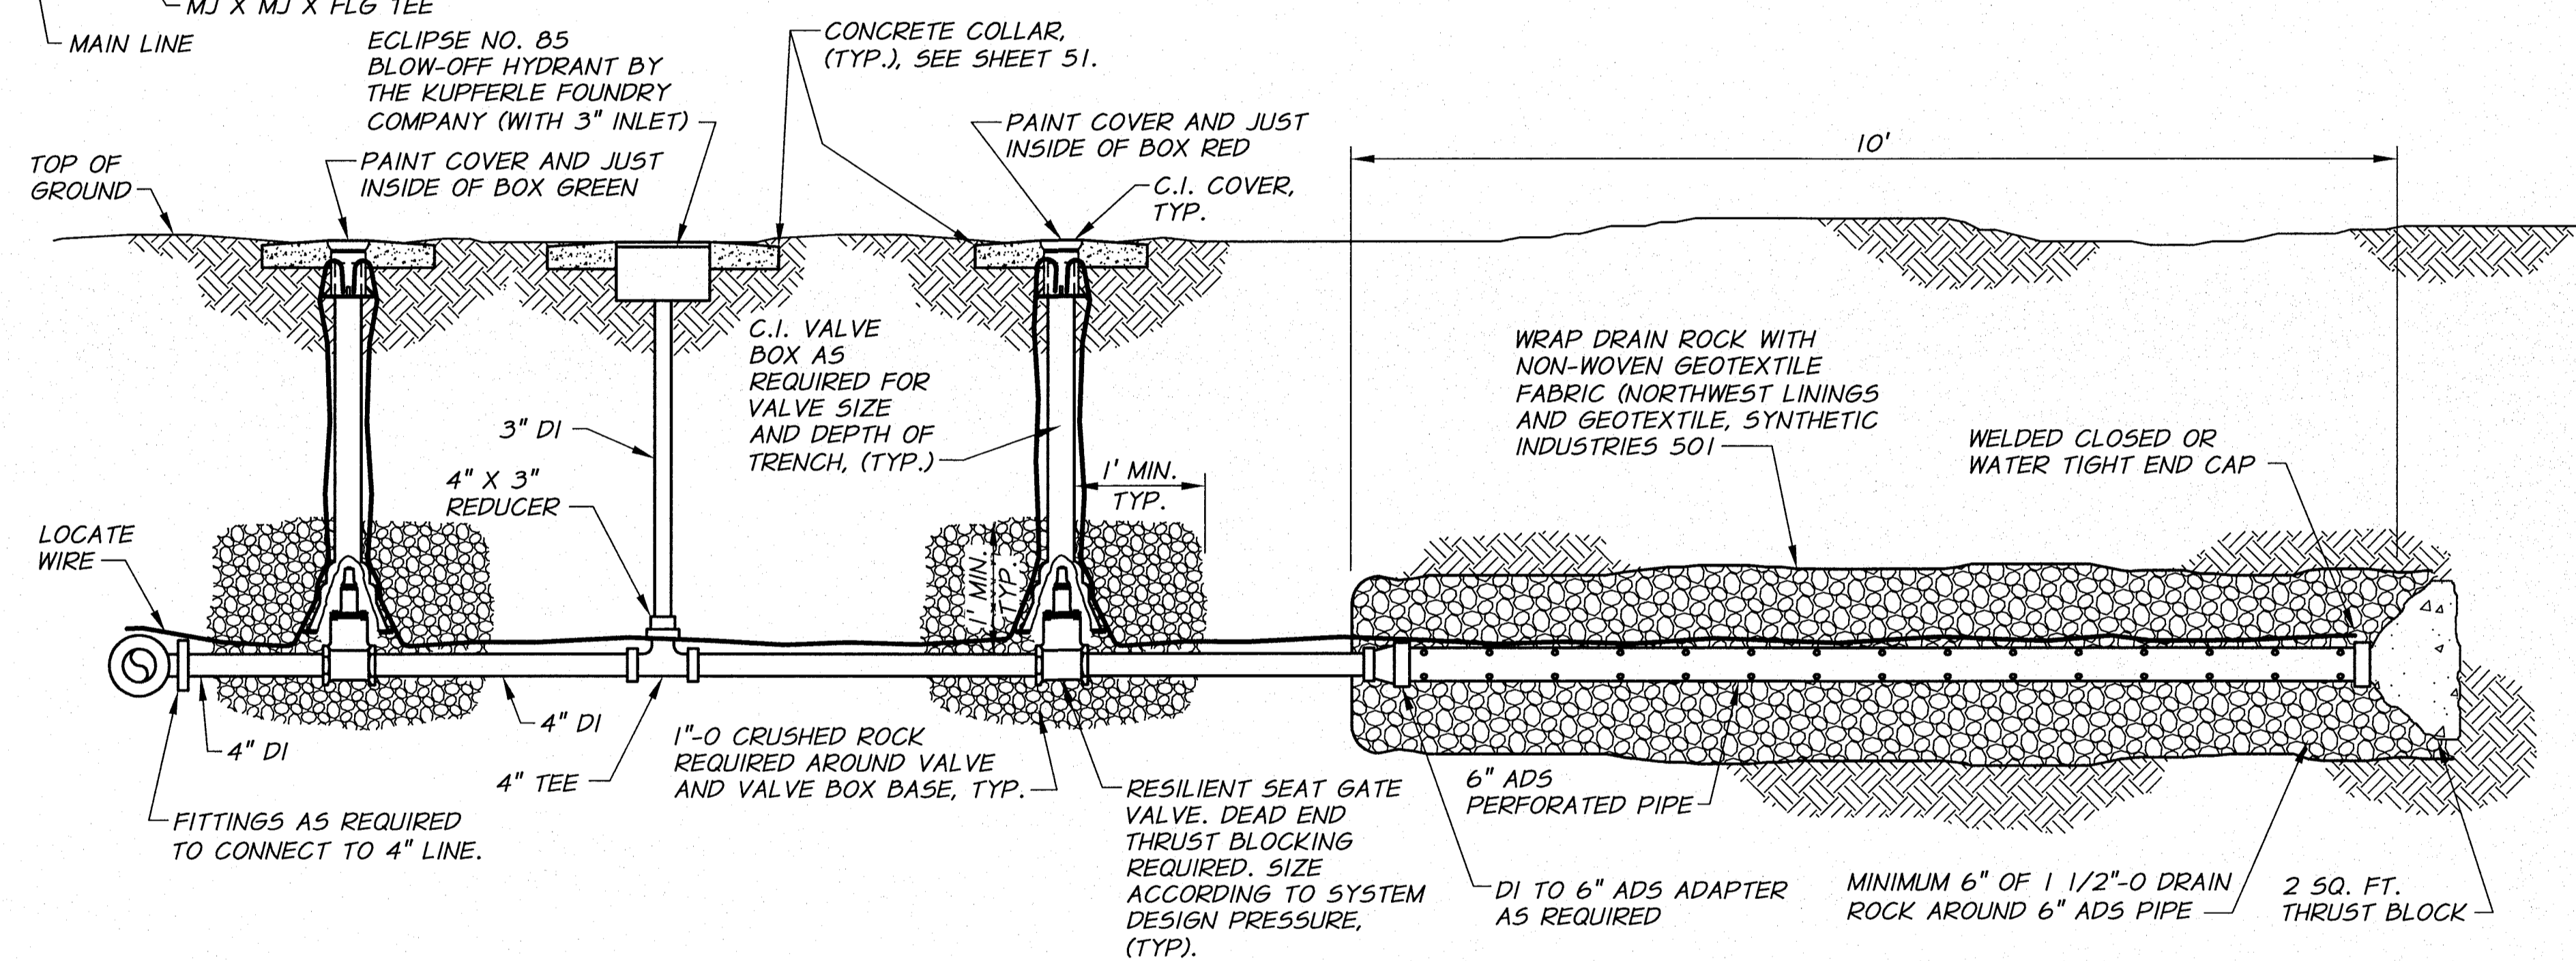


SECTION A  
TYPE 1 BLOW-OFF ASSEMBLY DETAIL  
N.T.S.


NOTE:  
BLOW-OFF TO BE FIELD  
LOCATED BY THE ENGINEER  
PRIOR TO CONSTRUCTION  
(INCLUDING ORIENTATION).

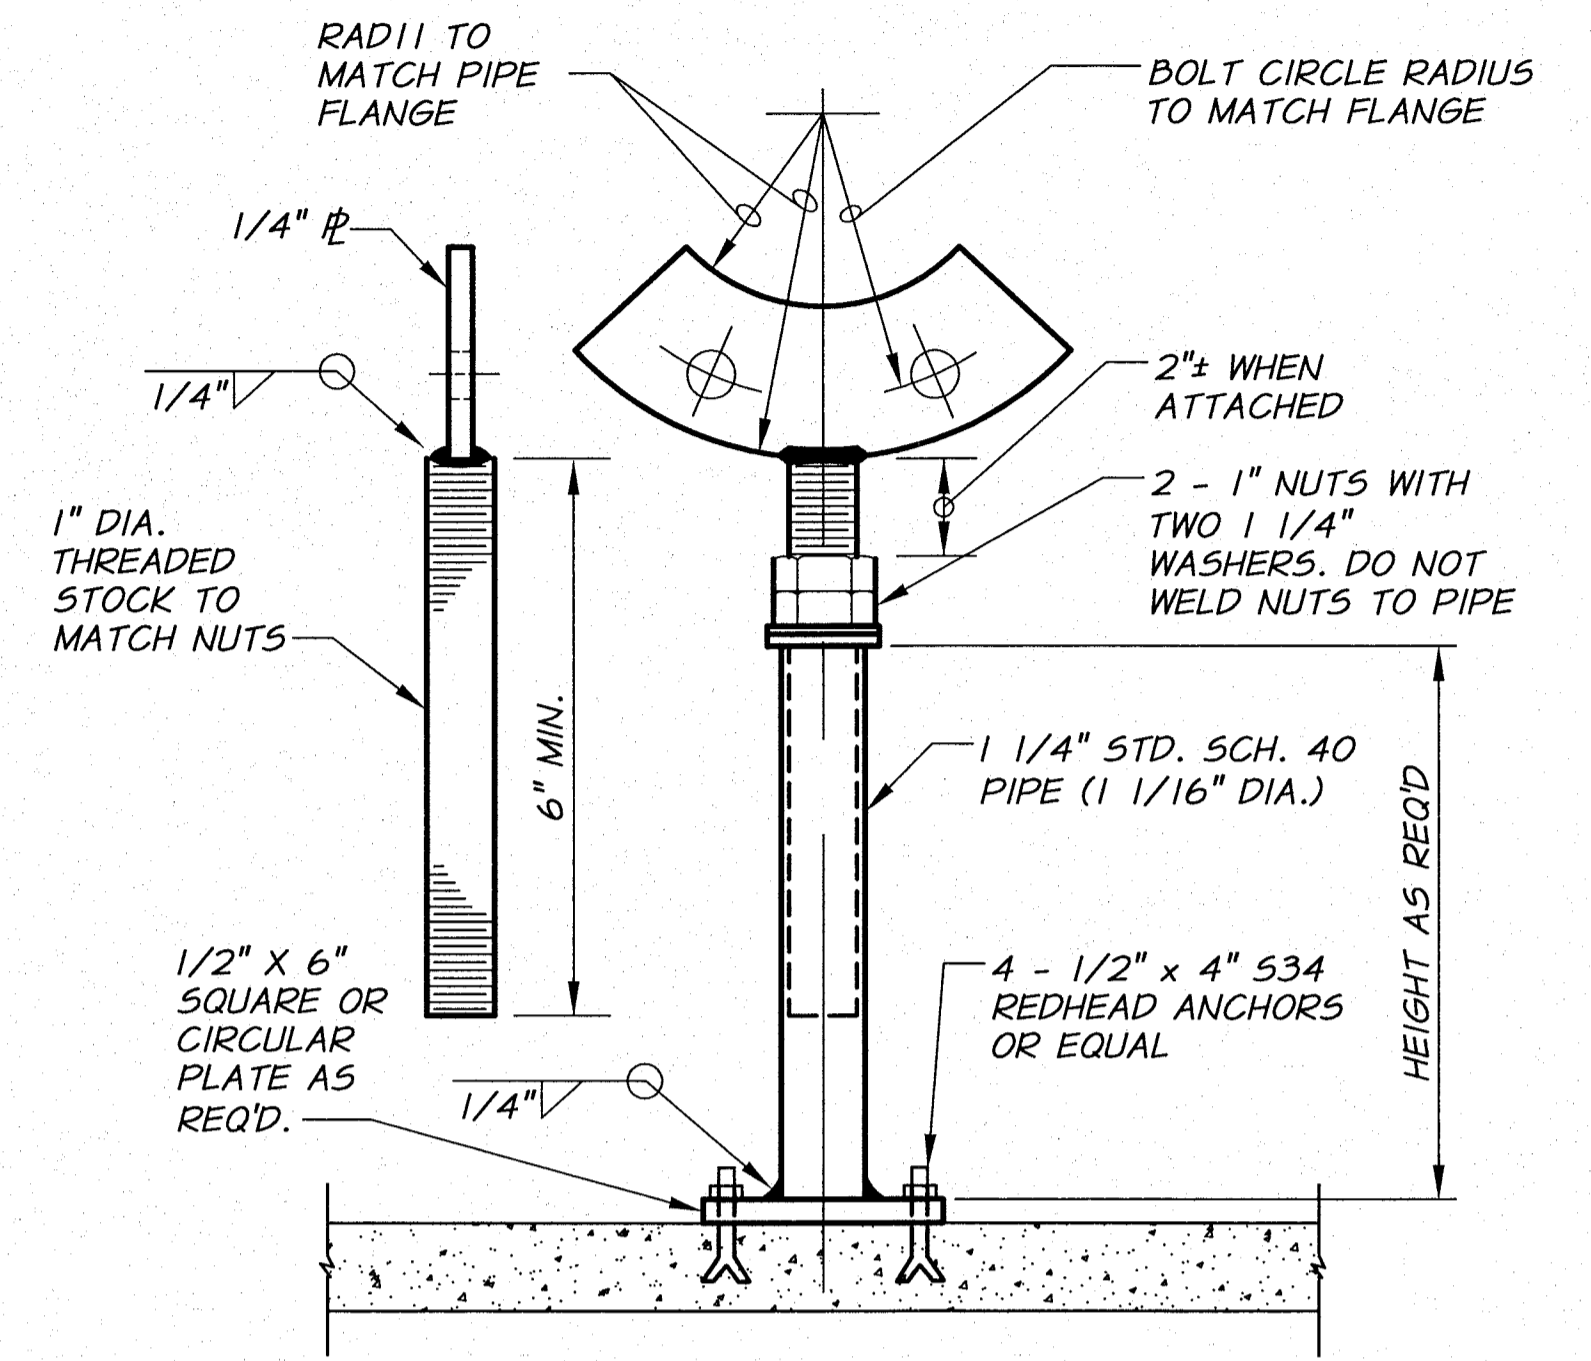

PIPE SUPPORT DETAIL  
N.T.S.

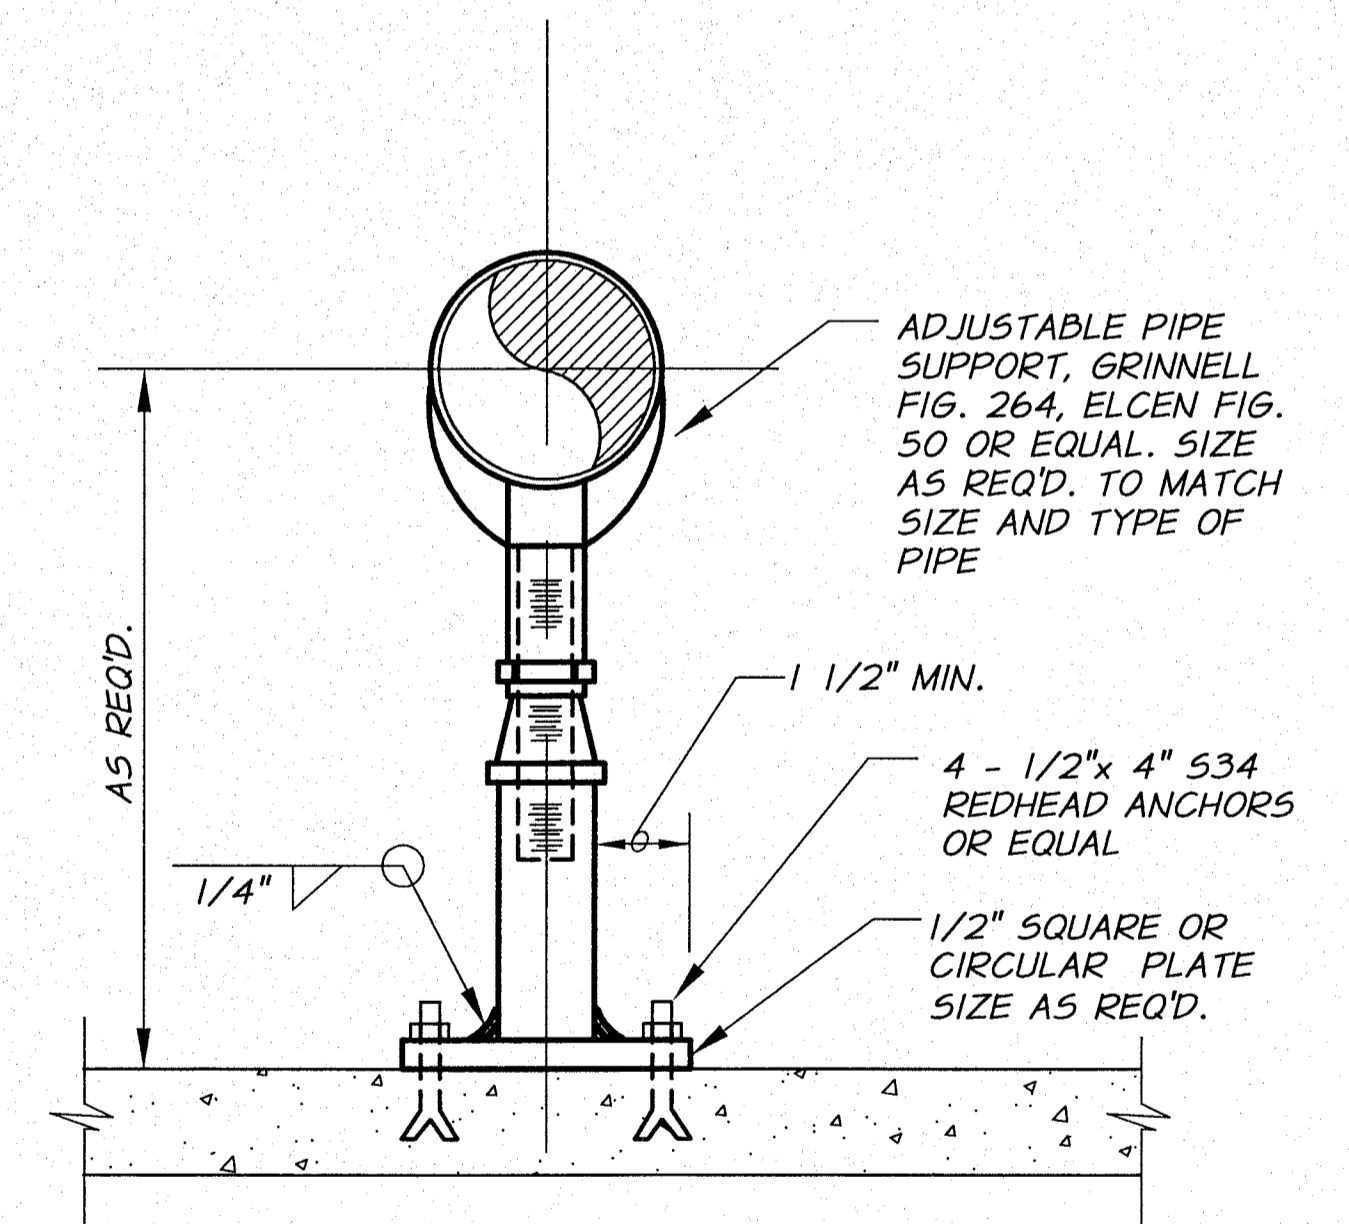


PIPE SUPPORT DETAIL  
N.T.S.

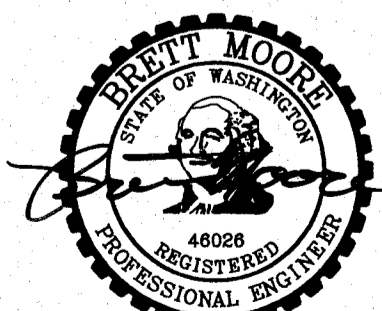





SIGNED 06-04-12  
RECORD DRAWINGS

REVISION	BY	DATE	HORIZ. SCALE	VERT. SCALE
DESIGNED BY	R. HARRIS	XREFS: TB-BID.dwg	NONE	
DRAWN BY	P. RICHARDSON			
REVIEWED BY	B. MOORE			
JOB NUMBER		1199-336	DATE	
ACAD FILE:		lrrgDets-PH2B.dwg	2011	
COPYRIGHT 2011 BY ANDERSON-PERRY & ASSOC., INC.				

**RECORD DRAWINGS**  
These record drawings have been prepared, in part, on the basis of information compiled and furnished by others. They may contain some discrepancies and omissions, and do not necessarily represent "exact" field conditions. The Owner and the Engineer accept no responsibility for their accuracy.

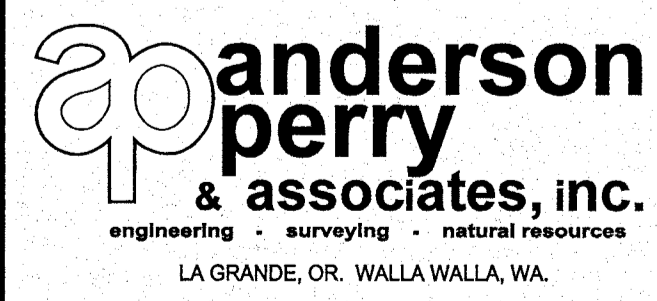


**BENTON IRRIGATION DISTRICT**  
IRRIGATION SYSTEM IMPROVEMENTS  
PHASE 2B  
MISCELLANEOUS DETAILS I

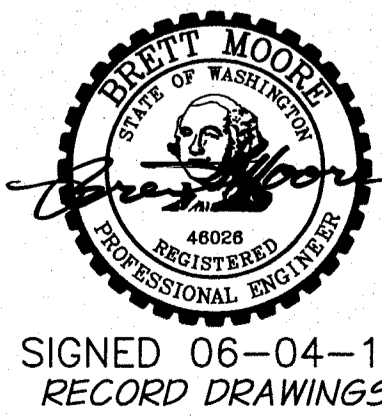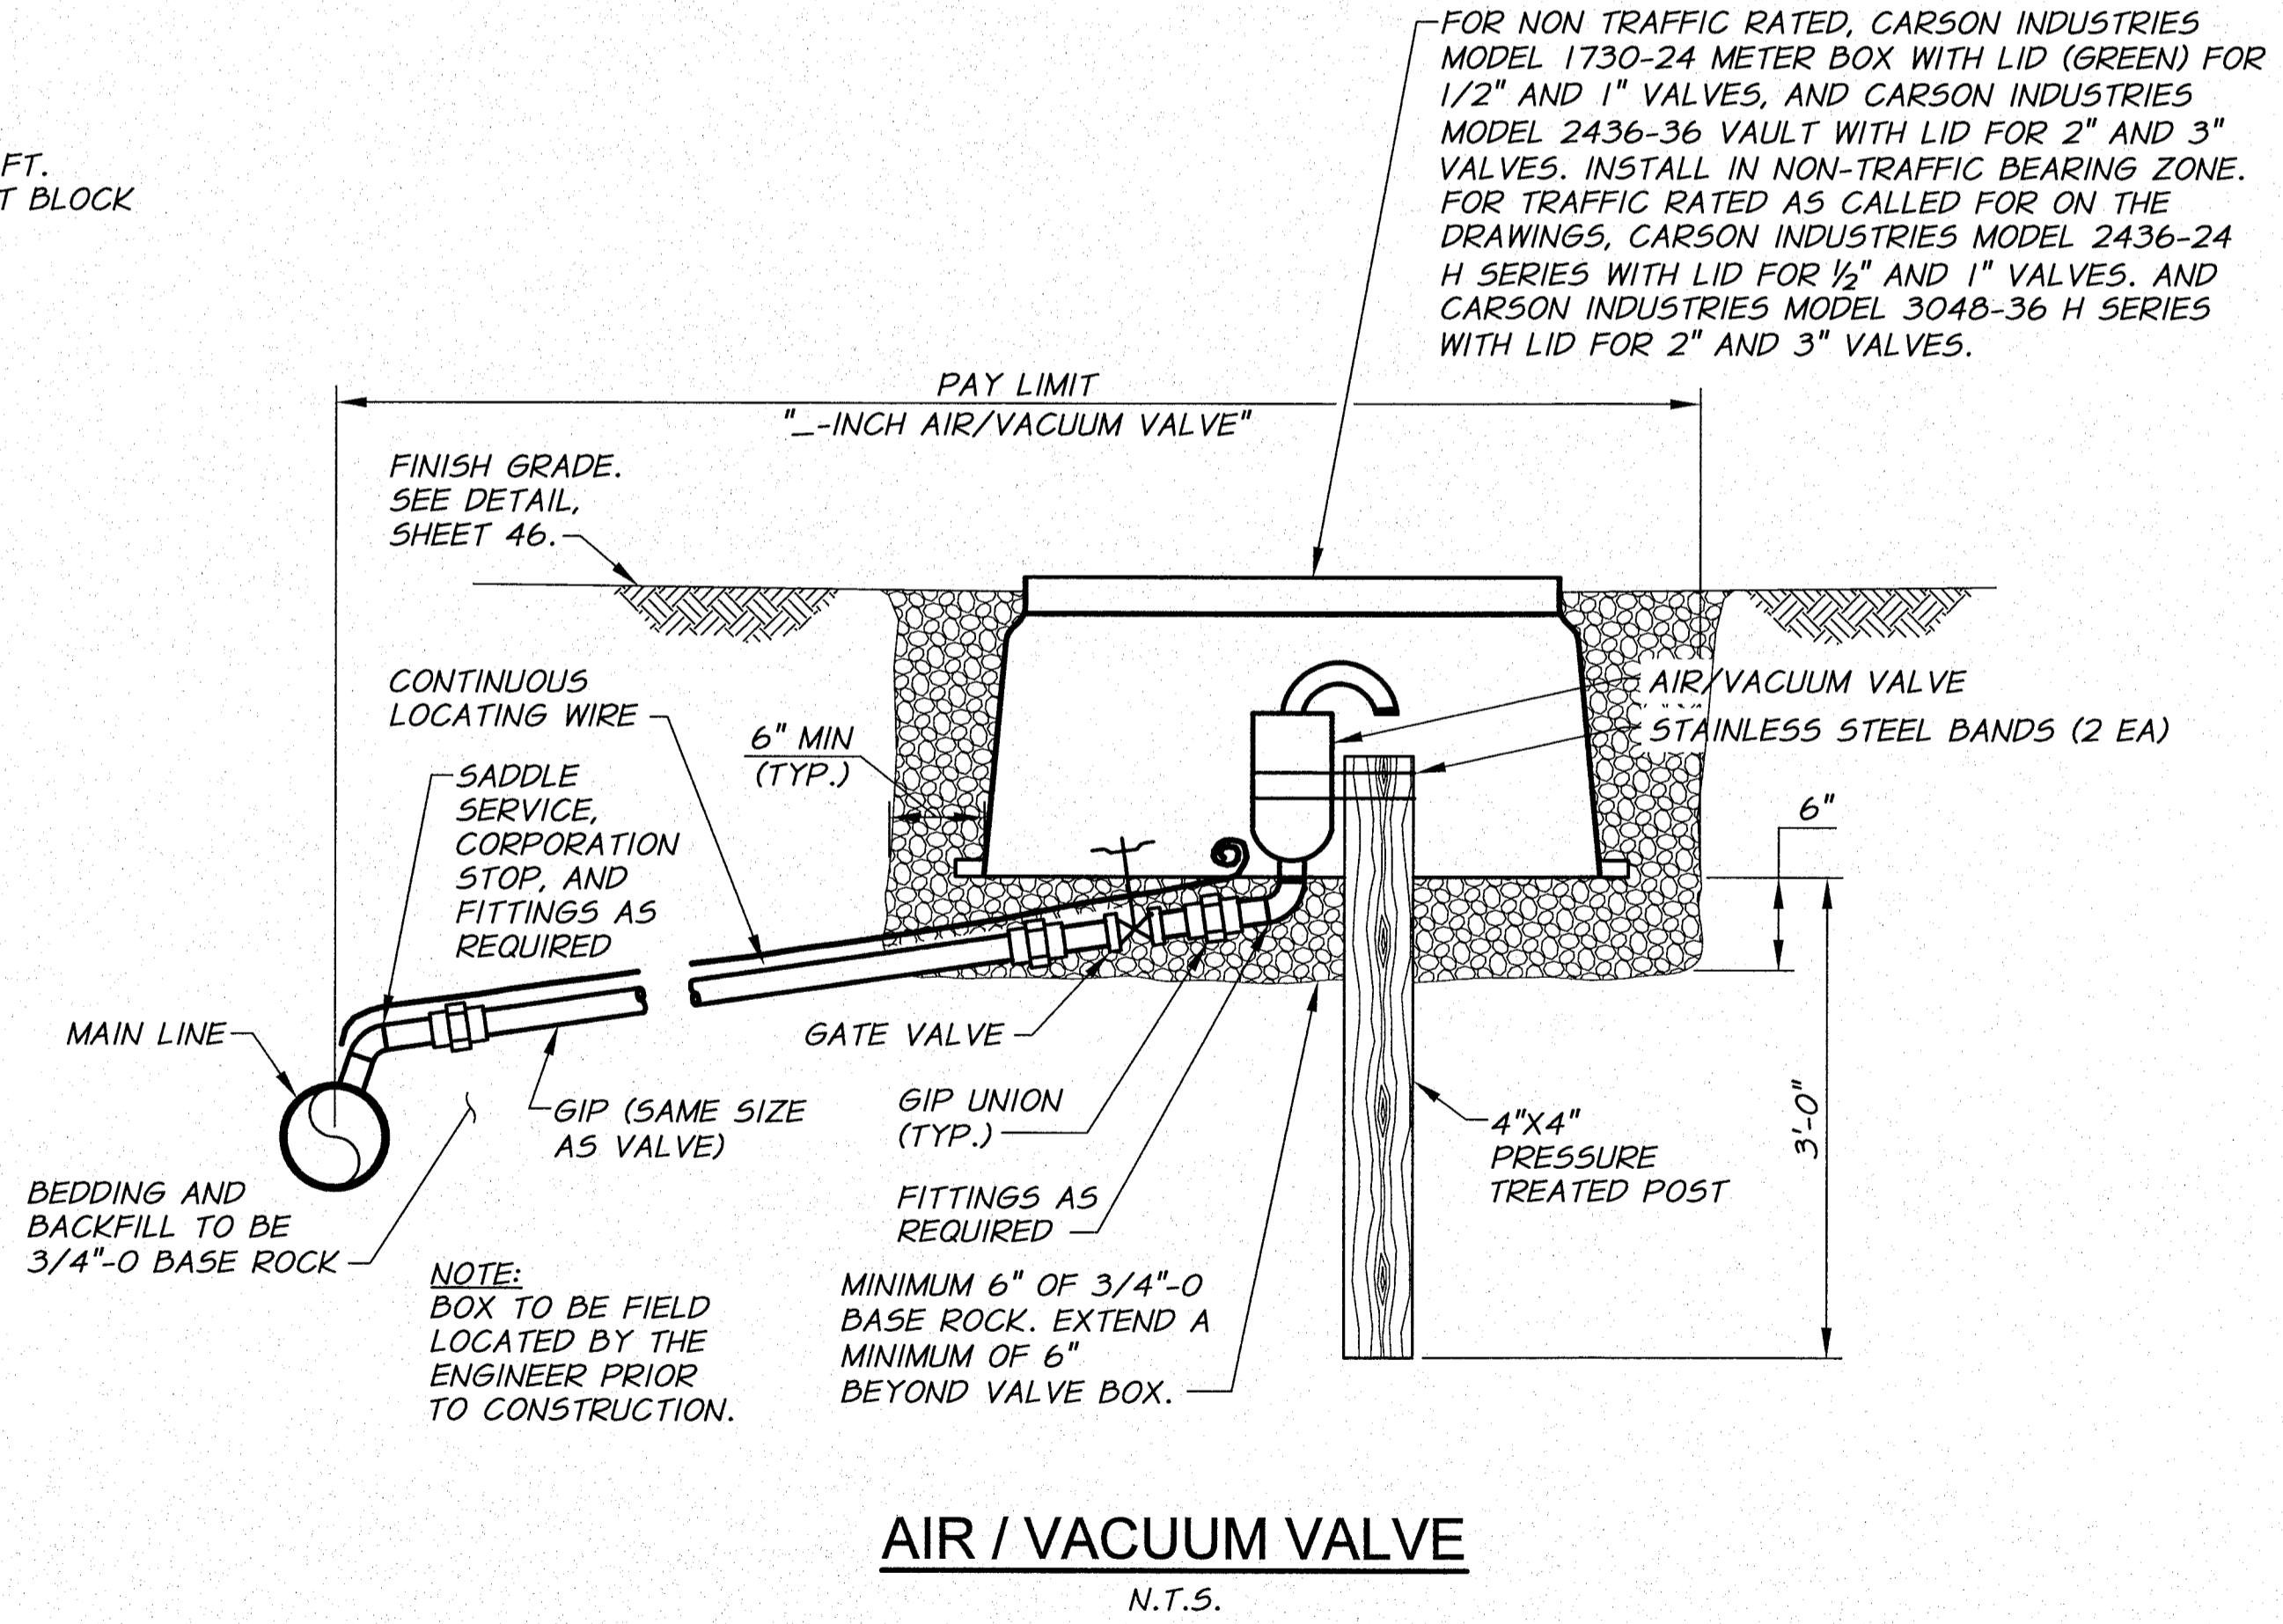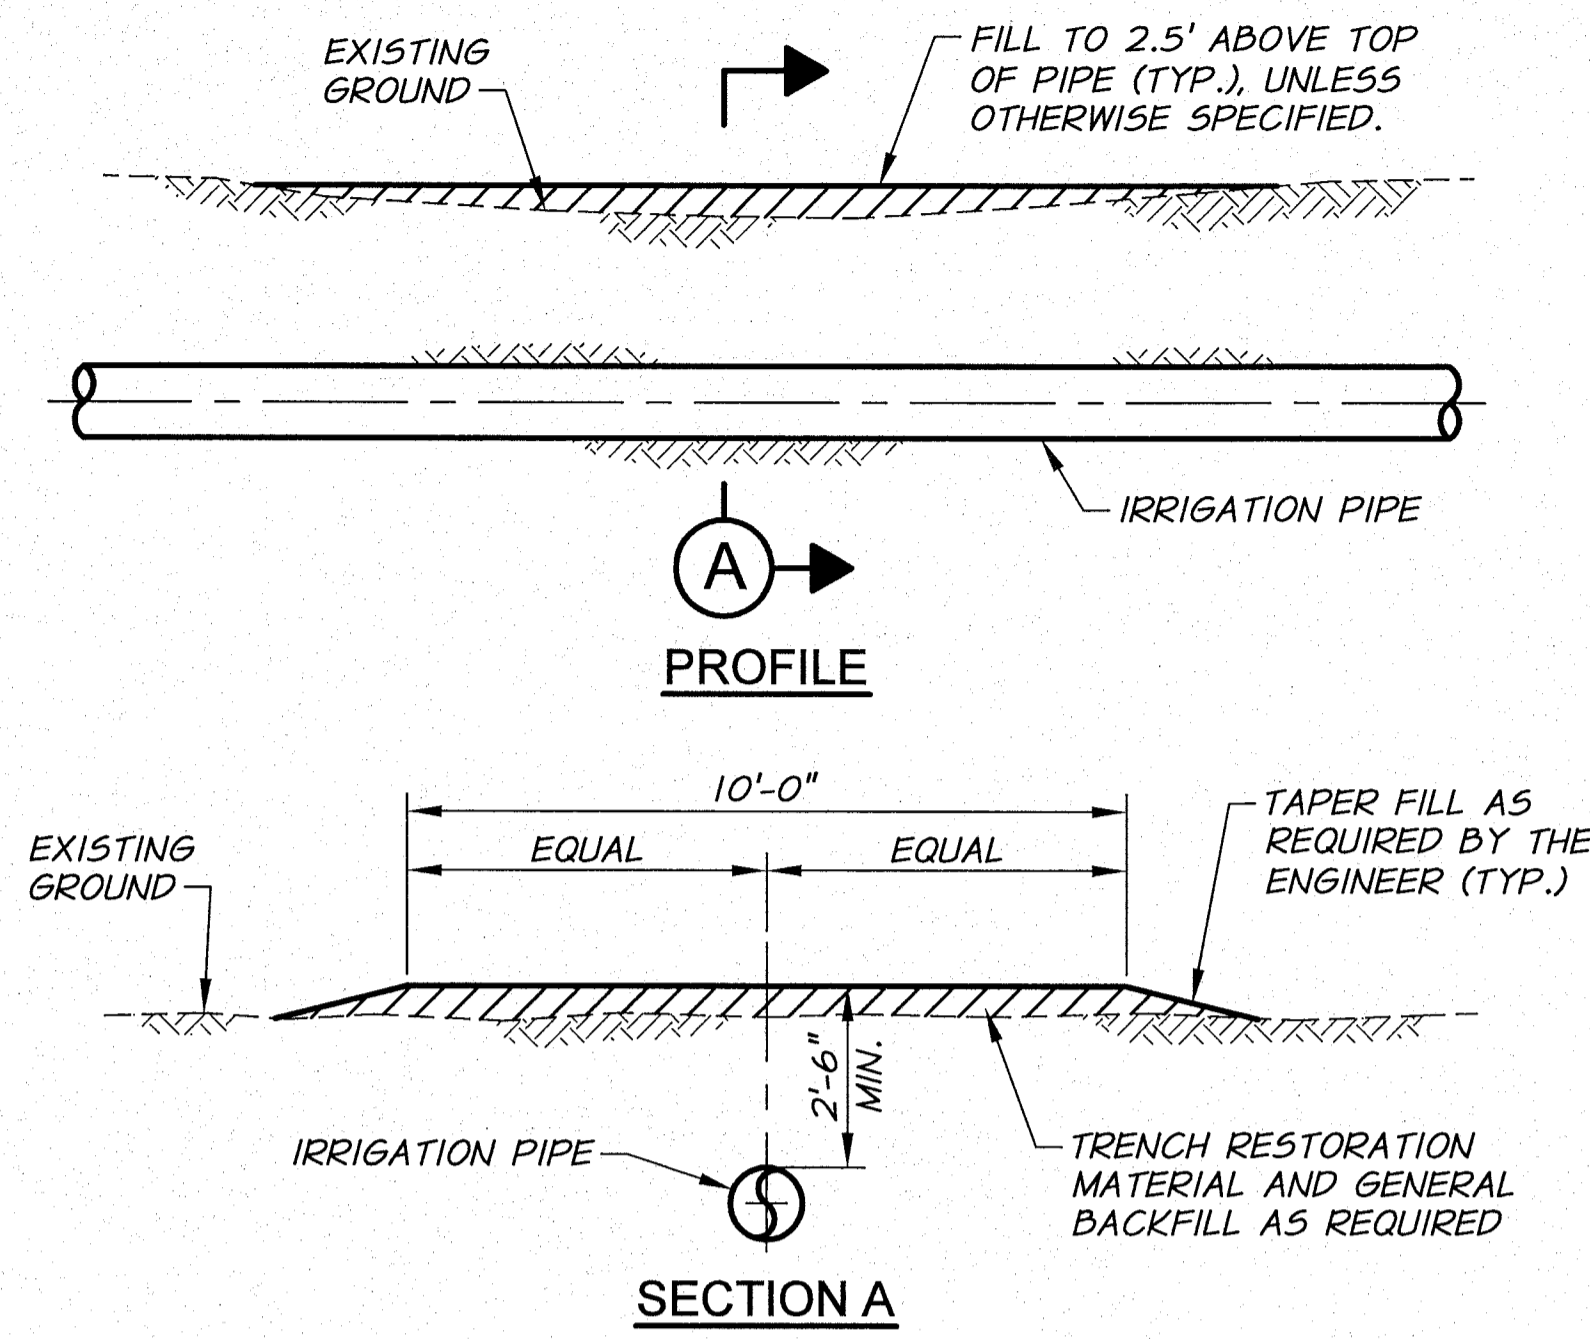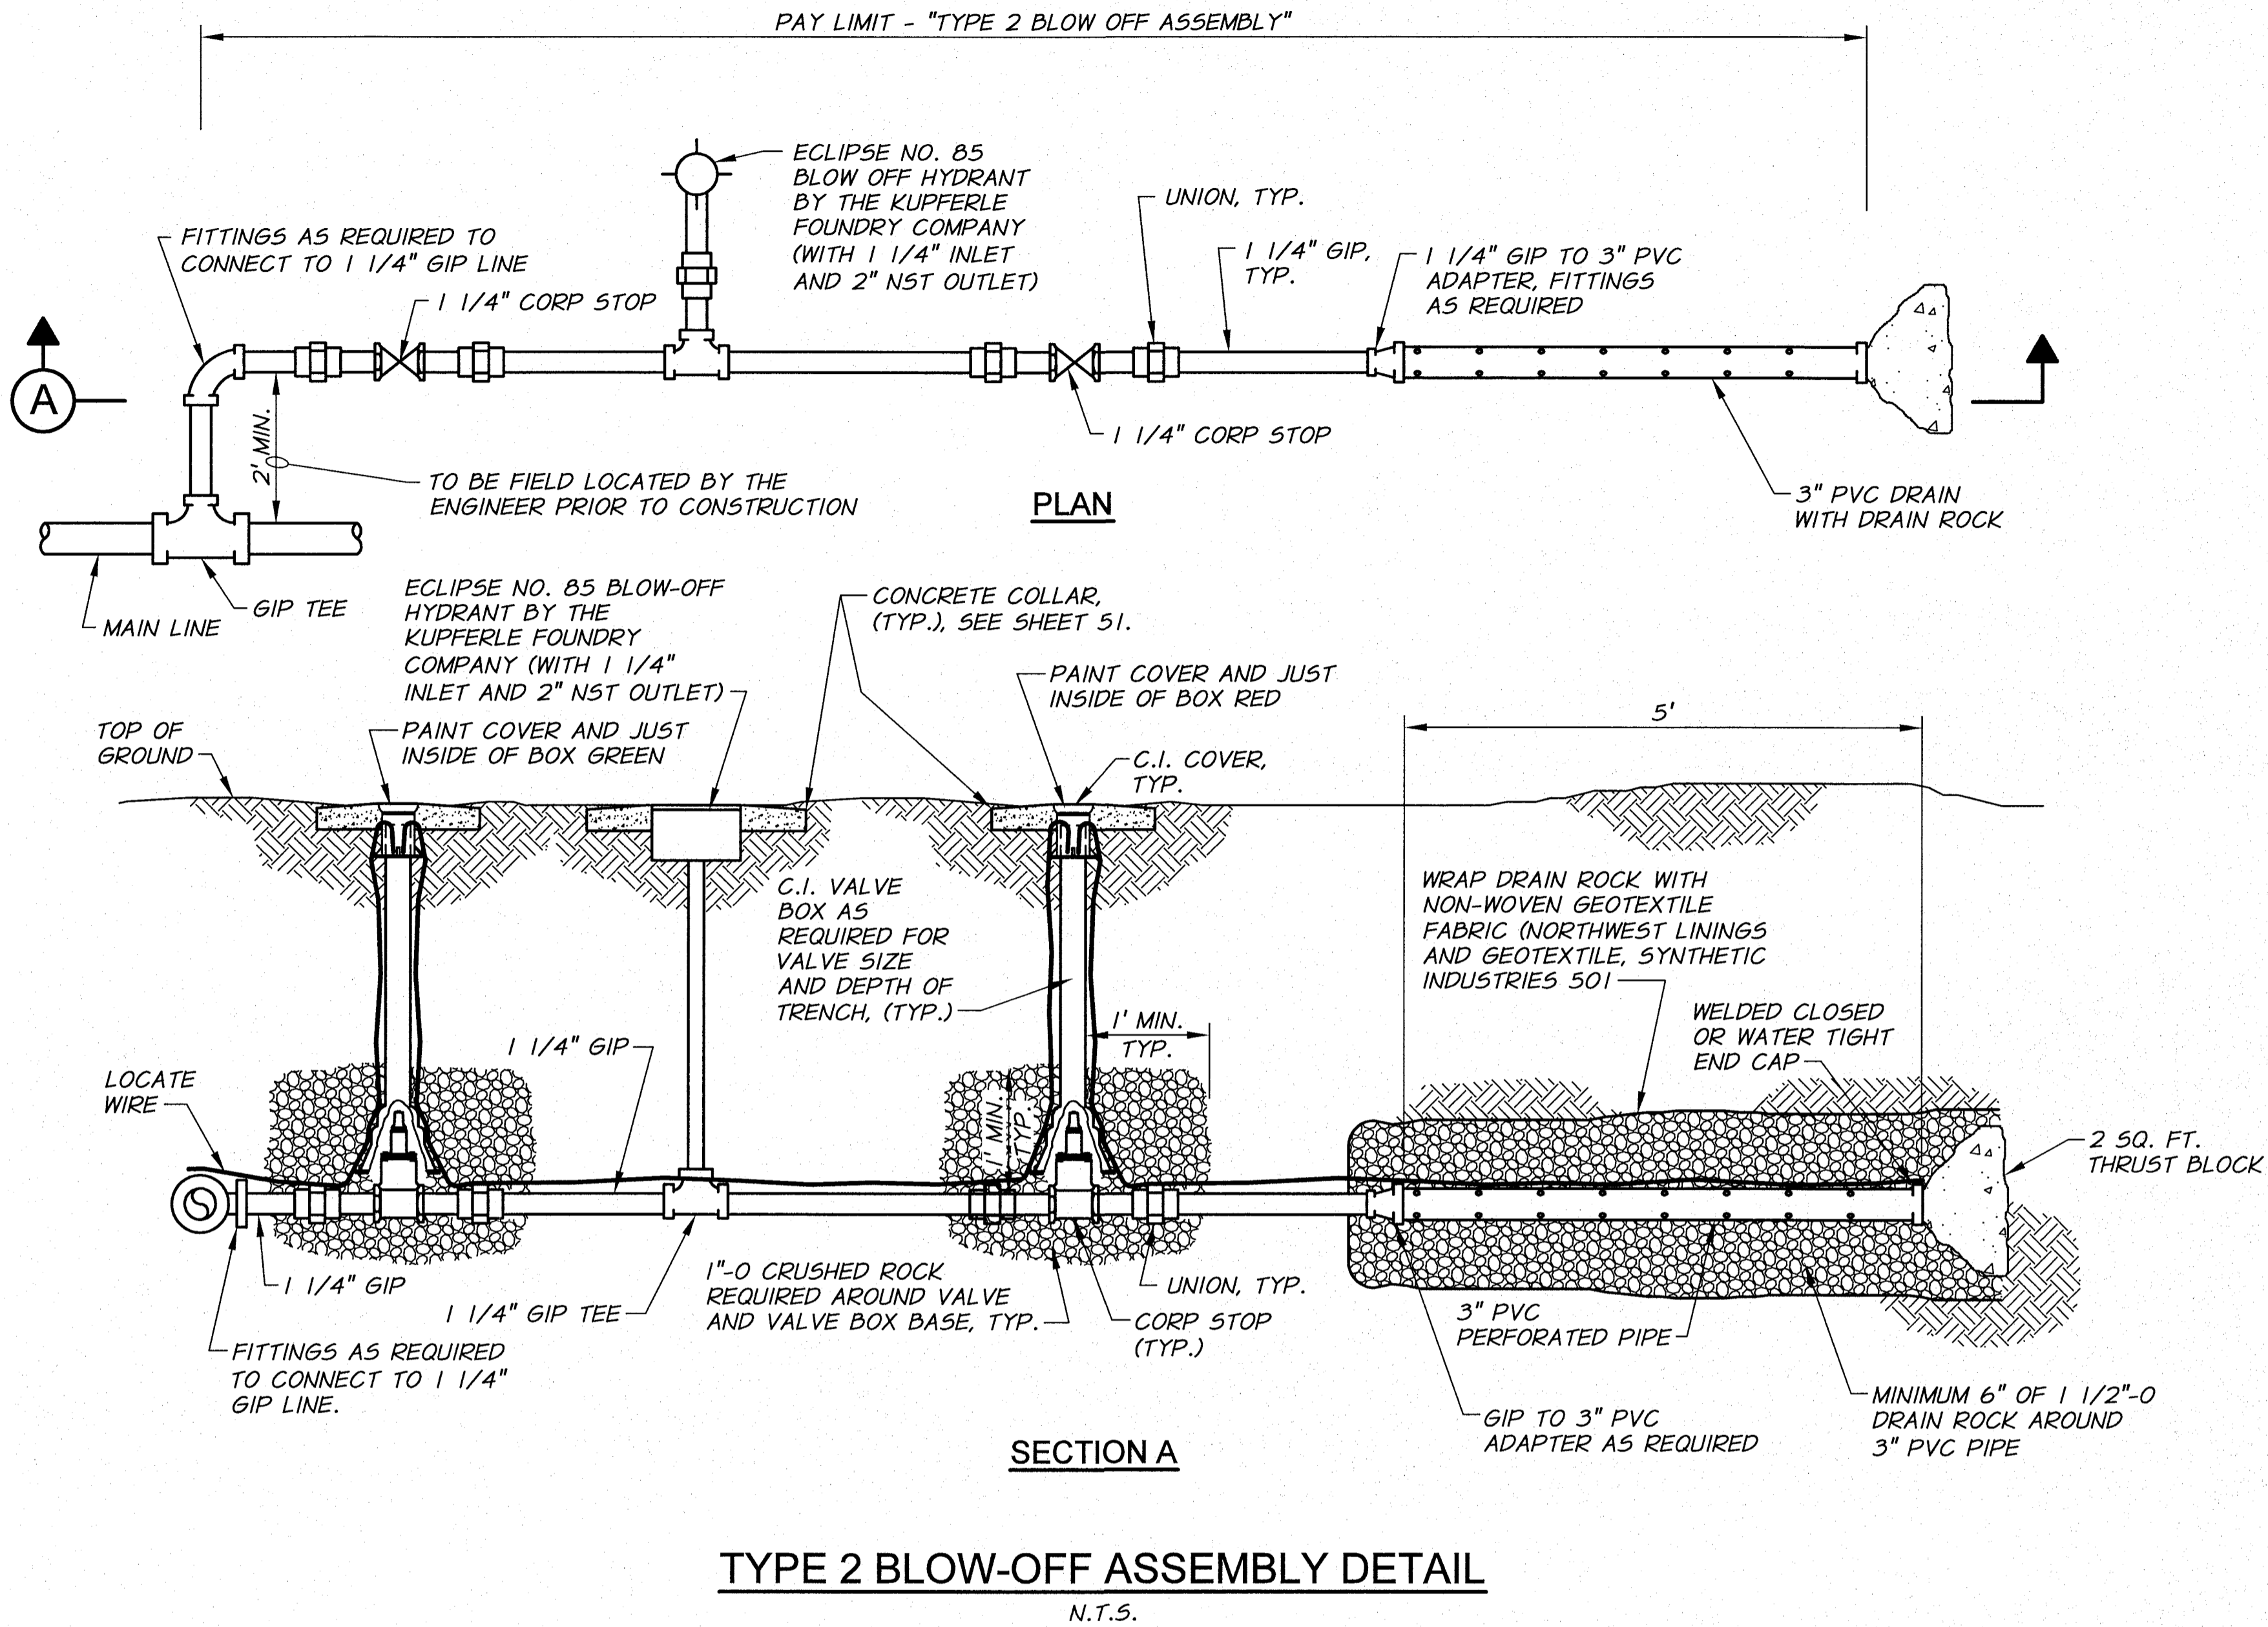

SIGNED 06-04-12  
RECORD DRAWINGS

REVISION	BY	DATE	HORZ. SCALE NONE	VERT. SCALE
DESIGNED BY R. HARRIS	XREFS: TB-BID.dwg		JOB NUMBER 1199-336	DATE 2011
DRAWN BY P. RICHARDSON			ACAD FILE: IrrgDets-PH2B.dwg	
REVIEWED BY B. MOORE			COPYRIGHT 2011 BY ANDERSON-PERRY & ASSOC., INC.	

**RECORD DRAWINGS**  
These record drawings have been prepared, in part, on the basis of information compiled and furnished by others. They may contain some discrepancies and omissions, and do not necessarily represent "exact" field conditions. The Owner and the Engineer accept no responsibility for their accuracy.

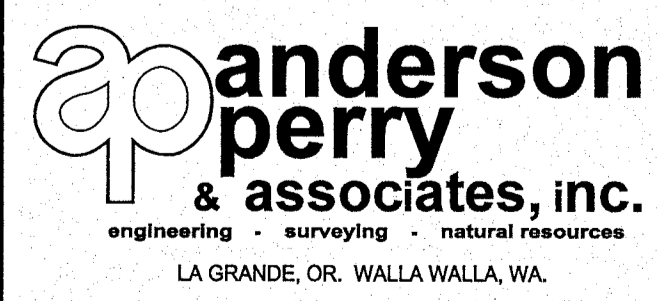


**BENTON IRRIGATION DISTRICT**  
IRRIGATION SYSTEM IMPROVEMENTS  
PHASE 2B  
MISCELLANEOUS DETAILS II

SHEET  
**50**

ARCHIVED



THE TOP 18" OF TOPSOIL IN THE EXCAVATION AREA SHALL BE REMOVED AND STOCKPILED AT A SEPARATE LOCATION FROM GENERAL TRENCH EXCAVATION. THIS TOPSOIL SHALL NOT BE MIXED OR CONTAMINATED WITH ANY OTHER MATERIAL. UPON COMPLETION OF THE TRENCH BACKFILL, AND AFTER ALL ROCKS AND UNSUITABLE MATERIAL HAVE BEEN REMOVED FROM WORK AREA, THE TOPSOIL SHALL BE REPLACED AND GRADED TO MATCH EXISTING GROUND. THE DISTURBED AREA SHALL THEN BE HYDROSEED ACCORDING TO HYDROSEED RESTORATION.

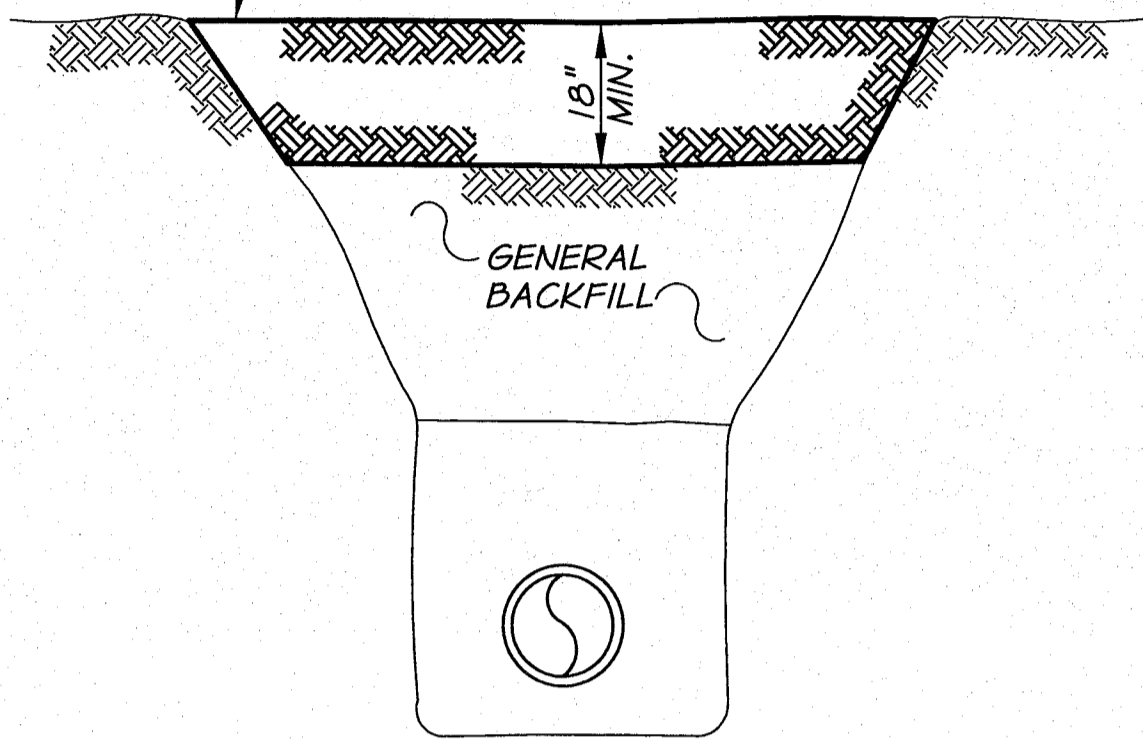


**TRENCH RESTORATION**

AGRICULTURAL AREAS

N.T.S.


REMOVE DEBRIS AND ROCK WHICH ARE NOT TYPICAL TO THE AREA. REPLACE TOPSOIL EQUAL TO EXISTING OR 6" WHICH EVER IS GREATER. RAKE AND SHAPE TO MATCH EXISTING. HYDROSEED PER HYDROSEED RESTORATION.

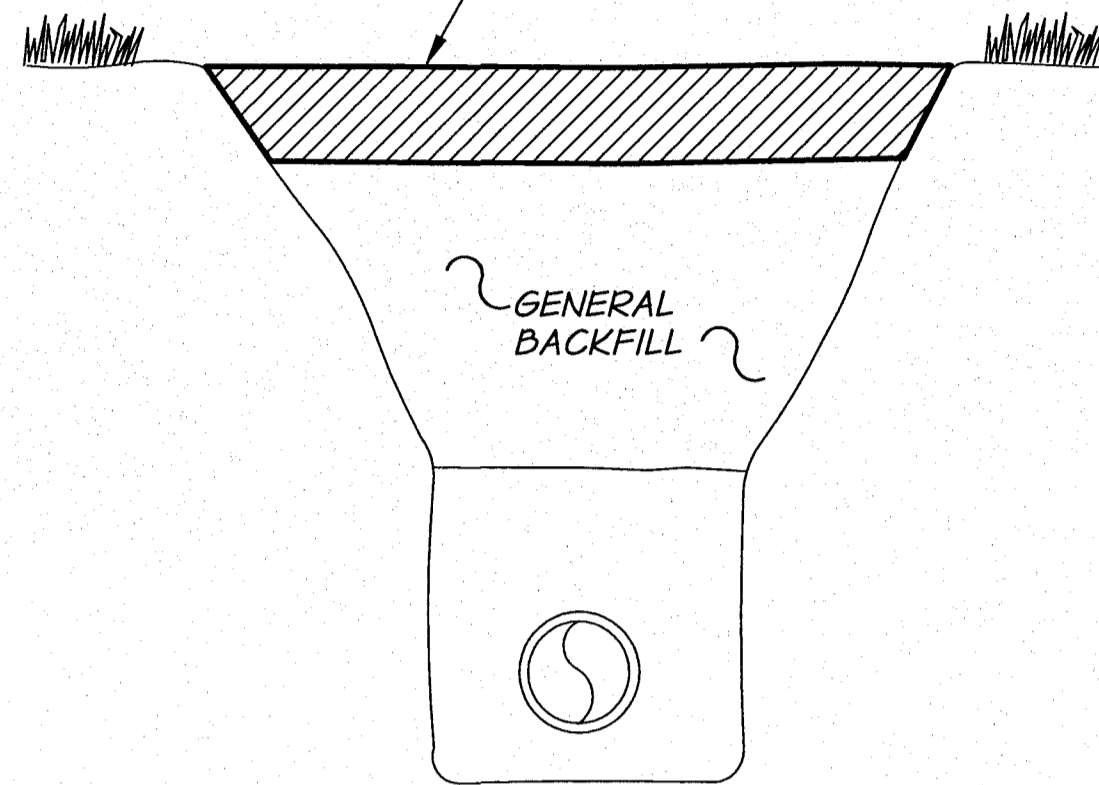

**TRENCH RESTORATION**


LAWNS & LANDSCAPED AREAS

N.T.S.

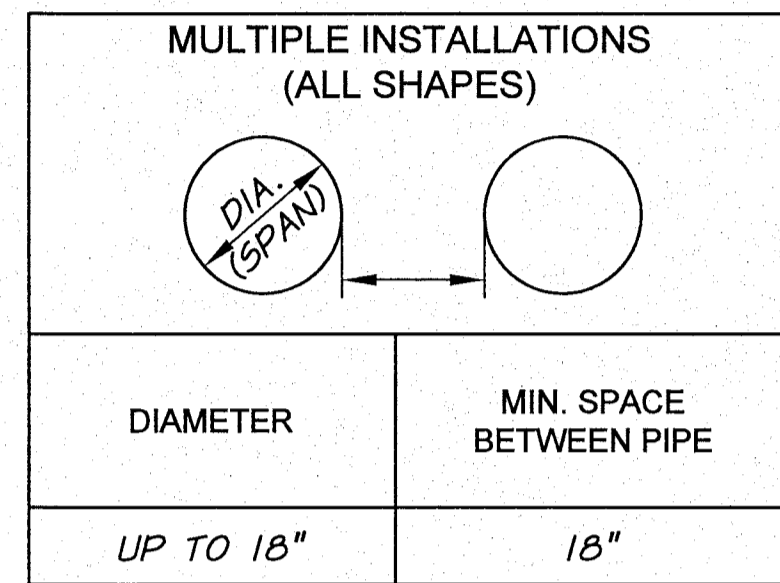


NOTES  
1. SURFACING OF PAVED AREAS SHALL COMPLY WITH STREET CUT STANDARD DRAWING.

TRENCH BACKFILL AND BEDDING TABLE			
	ASPHALT SURFACE RESTORATION	RAILROAD GRADE, GRAVEL STREETS, ROADWAYS, SHOULDERS AND PARKING AREAS	GENERAL \ HYDROSEED RESTORATION AREAS
<b>SURFACE</b>	SURFACING MATCHING EXISTING	3/4"-0 GRAVEL AGGREGATE (FOR THICKNESS SEE DETAIL THIS SHEET)	TOPSOIL OR AS DIRECTED
<b>BASE MATERIAL UNDER SURFACE</b>	3/4"-0 BASE ROCK	GENERAL BACKFILL	TOPSOIL OR AS DIRECTED
<b>GENERAL BACKFILL</b>	3/4"-0 BASE ROCK	GENERAL BACKFILL	GENERAL BACKFILL
<b>SELECT BACKFILL</b>	3/4"-0 BASE ROCK	3/4"-0 BASE ROCK	3/4"-0 BASE ROCK
<b>BEDDING</b>	3/4"-0 BASE ROCK	3/4"-0 BASE ROCK	3/4"-0 BASE ROCK

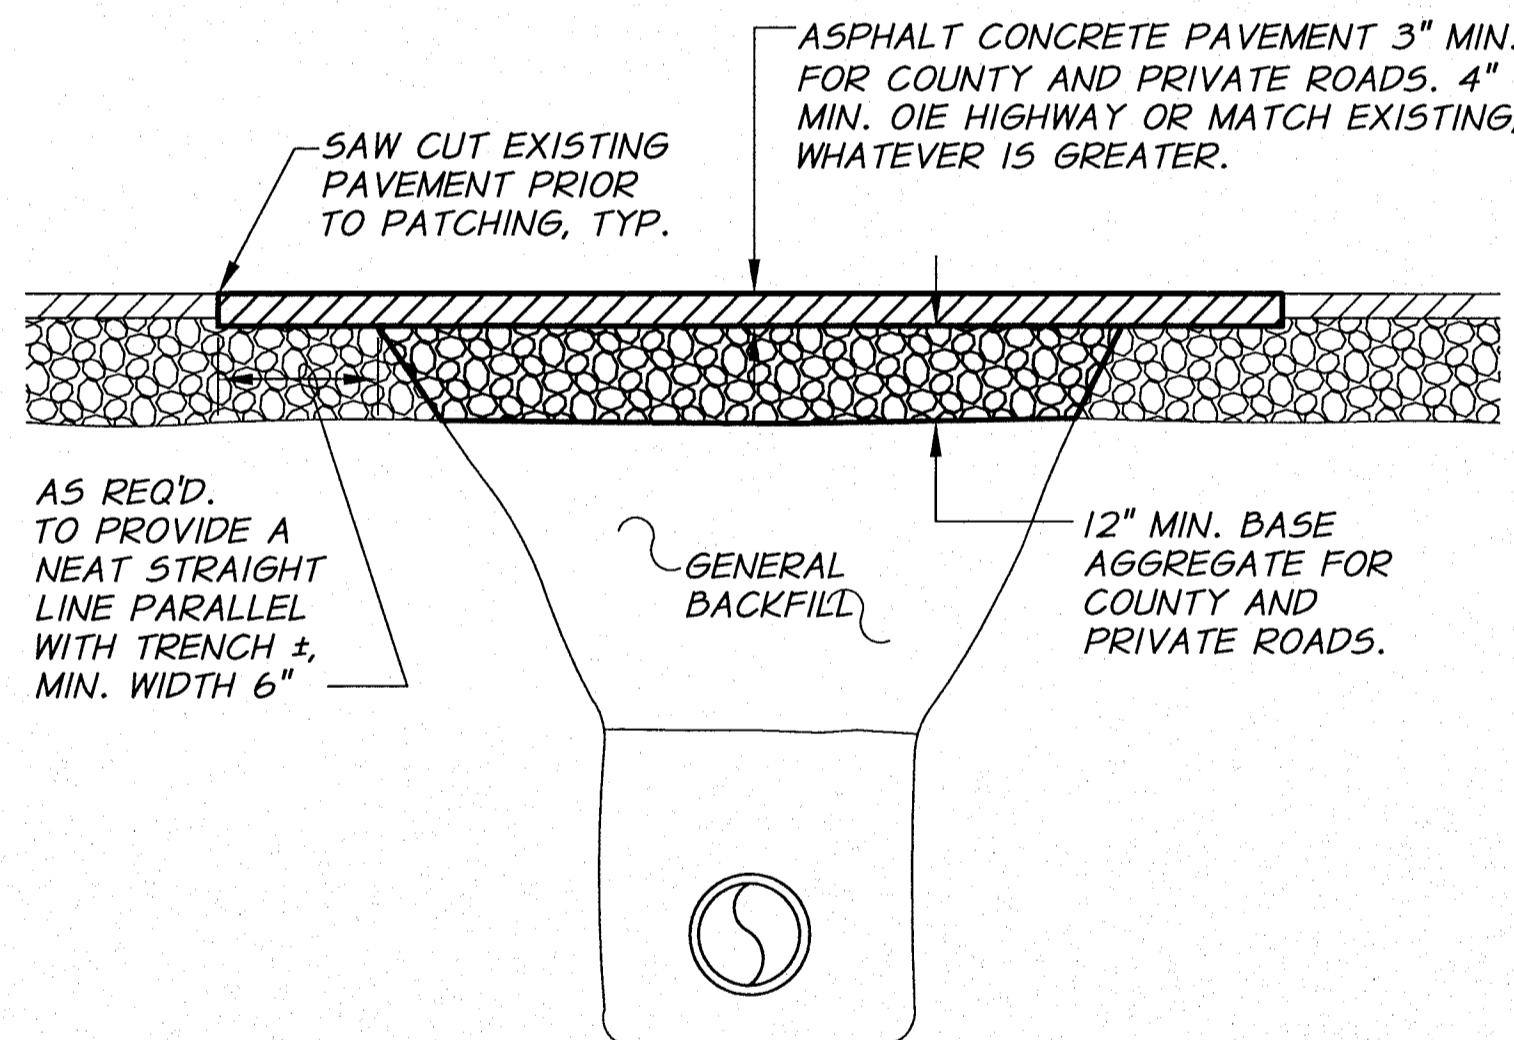

**TRENCH RESTORATION**


PAVED STREETS AND ROADWAYS  
("ASPHALT SURFACE RESTORATION" PAY ITEM)

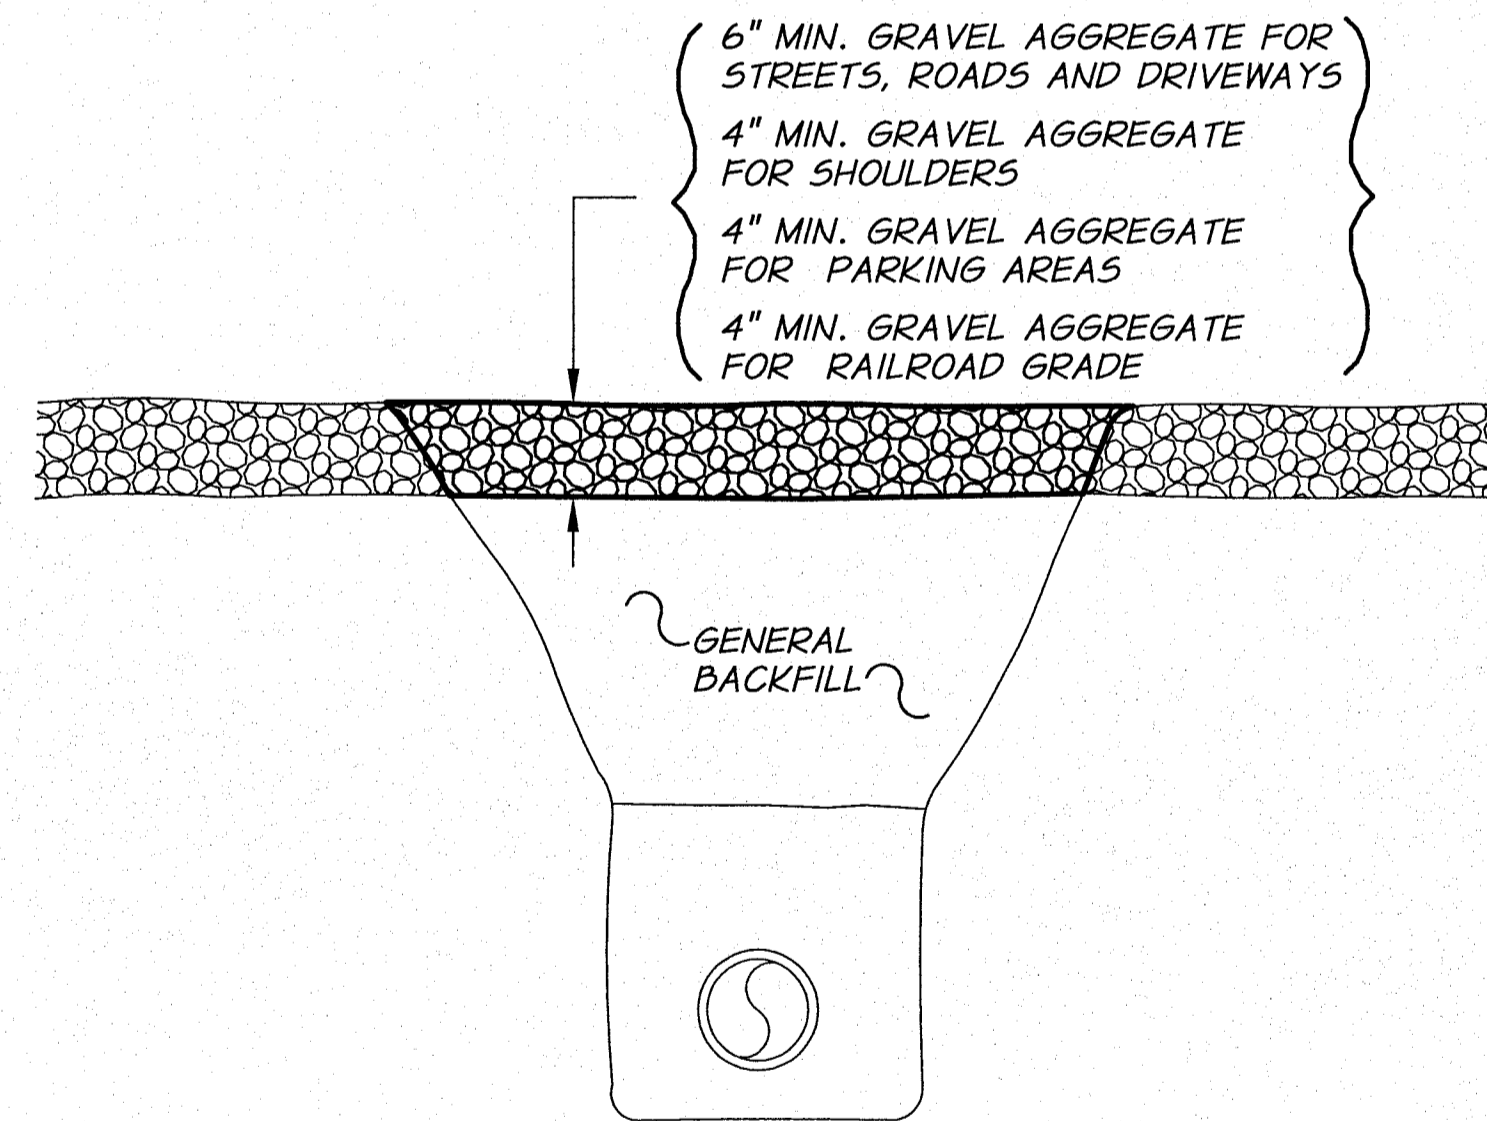

**TRENCH RESTORATION**

GRAVEL STREETS, ROADWAYS, SHOULDERS, AND PARKING AREAS  
("GRAVEL SURFACE RESTORATION" PAY ITEM)


N.T.S.

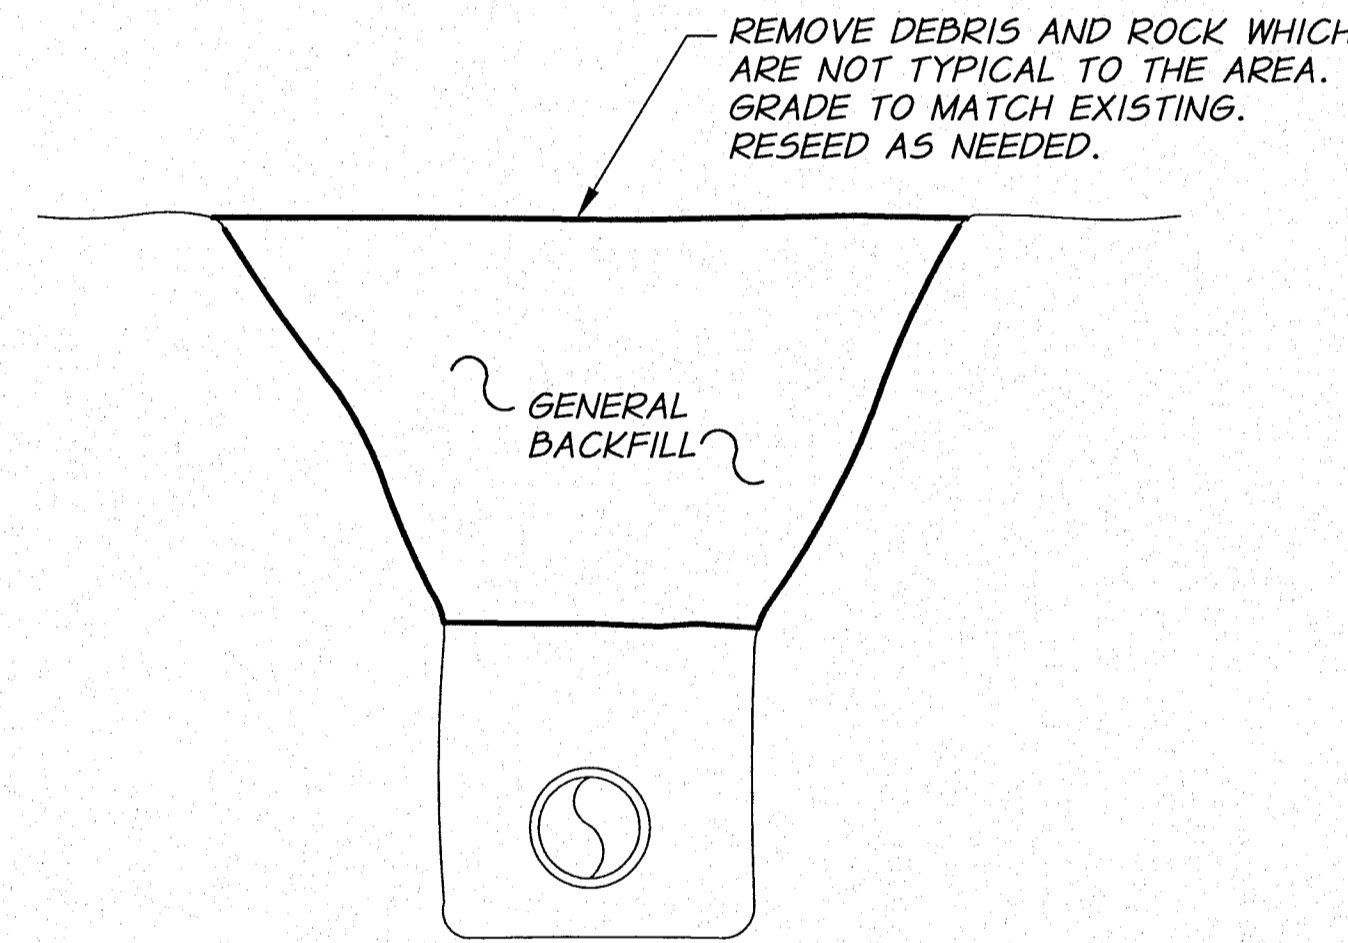

**TRENCH RESTORATION**


GENERAL AREAS

N.T.S.

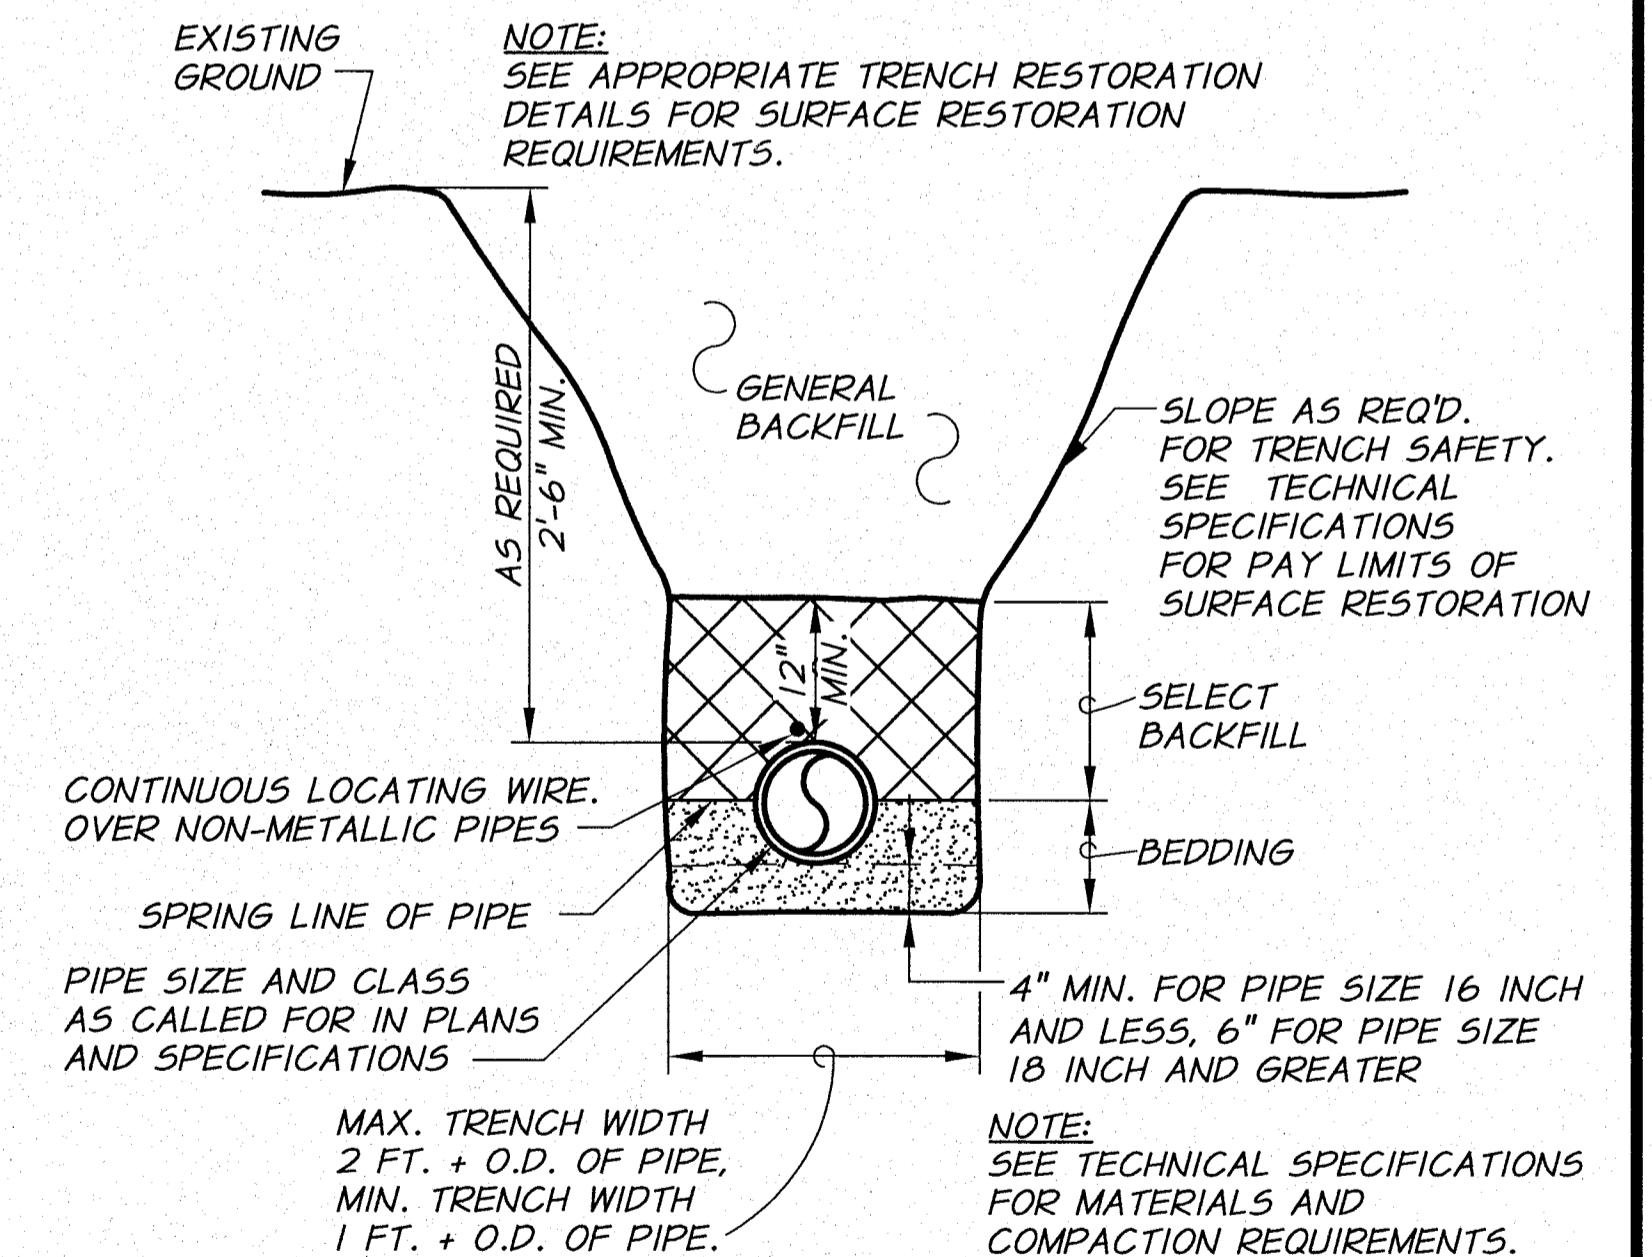

**TRENCH EXCAVATION AND BACKFILL**

N.T.S.

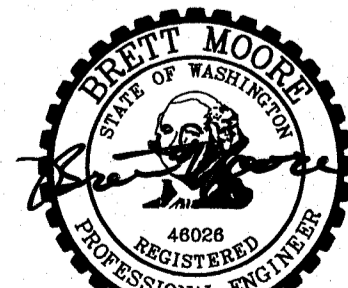


SIGNED 06-04-12  
RECORD DRAWINGS

DESIGNED BY	R. HARRIS	XREFS: TB-BID.dwg	JOB NUMBER	1199-336	DATE	2011
DRAWN BY	D. CHRISTMAN		ACAD FILE	TrenchDets-PH2B.dwg		
REVIEWED BY	B. MOORE		COPYRIGHT	2011 BY ANDERSON-PERRY & ASSOC., INC.		

**RECORD DRAWINGS**

These record drawings have been prepared, in part, on the basis of information compiled and furnished by others. They may contain some discrepancies and omissions, and do not necessarily represent "exact" field conditions. The Owner and the Engineer accept no responsibility for their accuracy.

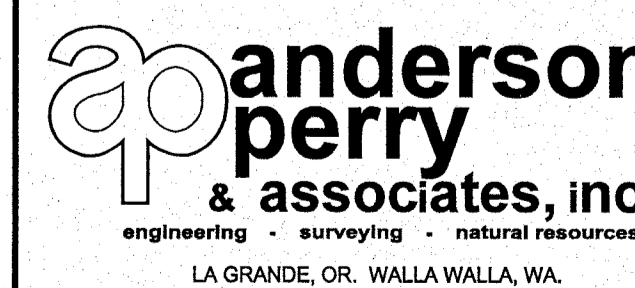

**BENTON IRRIGATION DISTRICT**  
IRRIGATION SYSTEM IMPROVEMENTS  
PHASE 2B

TRENCH DETAILS

SHEET

52

ARCHIVED

**THRUST BLOCK NOTES**

- THRUST BLOCKS SHALL BE REQUIRED AT THE FOLLOWING LOCATIONS:
  - ALL CHANGES IN DIRECTION.
  - ALL DEAD-ENDS.
  - ALL VALVES 8-INCHES AND LARGER SHALL BE SIZE FOR CLOSED CONDITION EXCEPTIONS:
    - WHEN RESTRAINED JOINT PIPE IS USED ON BOTH SIDES OF VALVE.
    - WHEN VALVE IS RESTRAINED JOINT CONNECTED TO A FITTING WHICH HAS APPROPRIATE THRUST BLOCKING.
  - AT LOCATIONS SPECIFICALLY CALLED OUT ON THE DRAWINGS.
  - AT TEMPORARY DEAD ENDS DURING PIPE INSTALLATIONS AS REQUIRED FOR TEMPORARY PRESSURE TESTING.
  - AT OTHER LOCATIONS REQUIRED BY THE ENGINEER.
- THRUST BLOCKS SHALL BE SIZED AS REQUIRED BY SOIL CONDITIONS AND DESIGN PRESSURE.
- PLACE CONCRETE AGAINST UNDISTURBED TRENCH WALL.
- CONCRETE SHALL BE 2,500 PSI MINIMUM.
- ALL CONCRETE SHALL BE PLACED SO THAT PIPE, FITTING JOINTS, BOLTS AND NUTS, ETC., WILL BE ACCESSIBLE FOR REPAIRS.
- PLACE ONE LAYER OF VISQUEEN BETWEEN FITTING AND CONCRETE TO FACILITATE FUTURE REMOVAL OF THRUST BLOCK IF REQUIRED.
- ANCHOR RODS SHALL BE 3/4" DIAMETER GALVANIZED STEEL RODS OR #6 EPOXY COATED REINFORCEMENT BAR, AASHTO M284, HAVING AN 18" MINIMUM EMBEDMENT IN CONCRETE.
- IF THE REQUIRED BEARING AREA IS LESS THAN 1 SQUARE FOOT, A THRUST BLOCK SHALL NOT BE REQUIRED.
- WHERE THRUST BLOCK IS NOT DESIGNATED, ALL THRUST BLOCKS SHALL BE SIZED PER THE PRESSURES SHOWN IN THE TECHNICAL SPECIFICATIONS, UNLESS OTHERWISE NOTED.

**DETERMINATION OF THRUST BLOCK BEARING AREA**

**NOTE:** WHEN THRUST BLOCK BEARING AREA IS NOT SPECIFIED ON THE PLANS OR DETERMINED BY THE ENGINEER, THE FOLLOWING PROCEDURE SHALL BE USED TO DETERMINE REQUIRED BEARING AREA.

- DETERMINE THRUST (T) FOR TYPE OF FITTING OR JOINT AND SIZE OF PIPE FROM TABLE NO. 1 OR TABLE NO. 3.
- DETERMINE BEARING CAPACITY (B) OF SOIL FROM TABLE NO. 2.
- DETERMINE REQUIRED BEARING AREA (A) AS FOLLOWS:

$A = T \div B$   
 EXAMPLE: DESIGN PRESSURE = 175 PSI  
 PIPE = 12"  
 FITTING = TEE  
 SOIL - SANDY GRAVEL

FROM TABLE NO. 1: T = 15,050 LB.  
 FROM TABLE NO. 2: B = 3000 LB/SQ.FT.

$A = 15,050 \div 3,000 = 5.017 \text{ SQ.FT.} \approx 5 \text{ SQ.FT. (ROUND UP TO NEAREST WHOLE SQ.FT.)}$

**TABLE NO. 1**  
 THRUST AT FITTINGS IN POUNDS AT 100 PSI OF PRESSURE

PIPE SIZE	TEES AND DEAD ENDS	90° BEND	45° BEND	22 1/2° BEND	11 1/4° BEND
4"	1,680	2,310	1,290	660	340
6"	3,770	5,320	2,890	1,480	750
8"	6,690	9,460	5,120	2,620	1,320
10"	10,440	14,780	8,010	4,090	2,050
12"	15,050	21,280	11,520	5,880	2,960
14"	20,490	28,960	15,680	8,000	4,020
16"	26,750	37,830	20,470	10,440	5,260
18"	33,850	47,870	25,910	13,210	6,640
20"	41,790	59,090	31,980	16,310	8,190
24"	60,170	85,100	46,060	23,490	11,800

**NOTE:** FOR WATER PRESSURES DIFFERENT THAN 100 PSI, MULTIPLY THRUST FOUND IN TABLE NO. 1 BY REQUIRED PROPORTION.  
 EXAMPLE: DESIGN PRESSURE = 175 PSI.  
 MULTIPLY VALUE IN TABLE BY 1.75


**TABLE NO. 2**

SOIL	SAFE BEARING LOAD LB/SQ.FT.
SOFT CLAY	500
SILT	1,000
SAND	2,000
SAND AND GRAVEL	3,000
SAND AND GRAVEL CEMENTED WITH CLAY	4,000
HARD CLAY	4,000

**TABLE NO. 3**


SIDE THRUST PER 100 LB./SQ.IN. PRESSURE PER DEGREE OF DEFLECTION			
PIPE SIZE	SIDE THRUST-LB	PIPE SIZE	SIDE THRUST-LB
4"	N/A	14"	360
6"	N/A	16"	470
8"	N/A	18"	600
10"	190	20"	730
12"	270	24"	1,050

MULTIPLY THRUST BY DEGREE OF DEFLECTION TO OBTAIN TOTAL THRUST

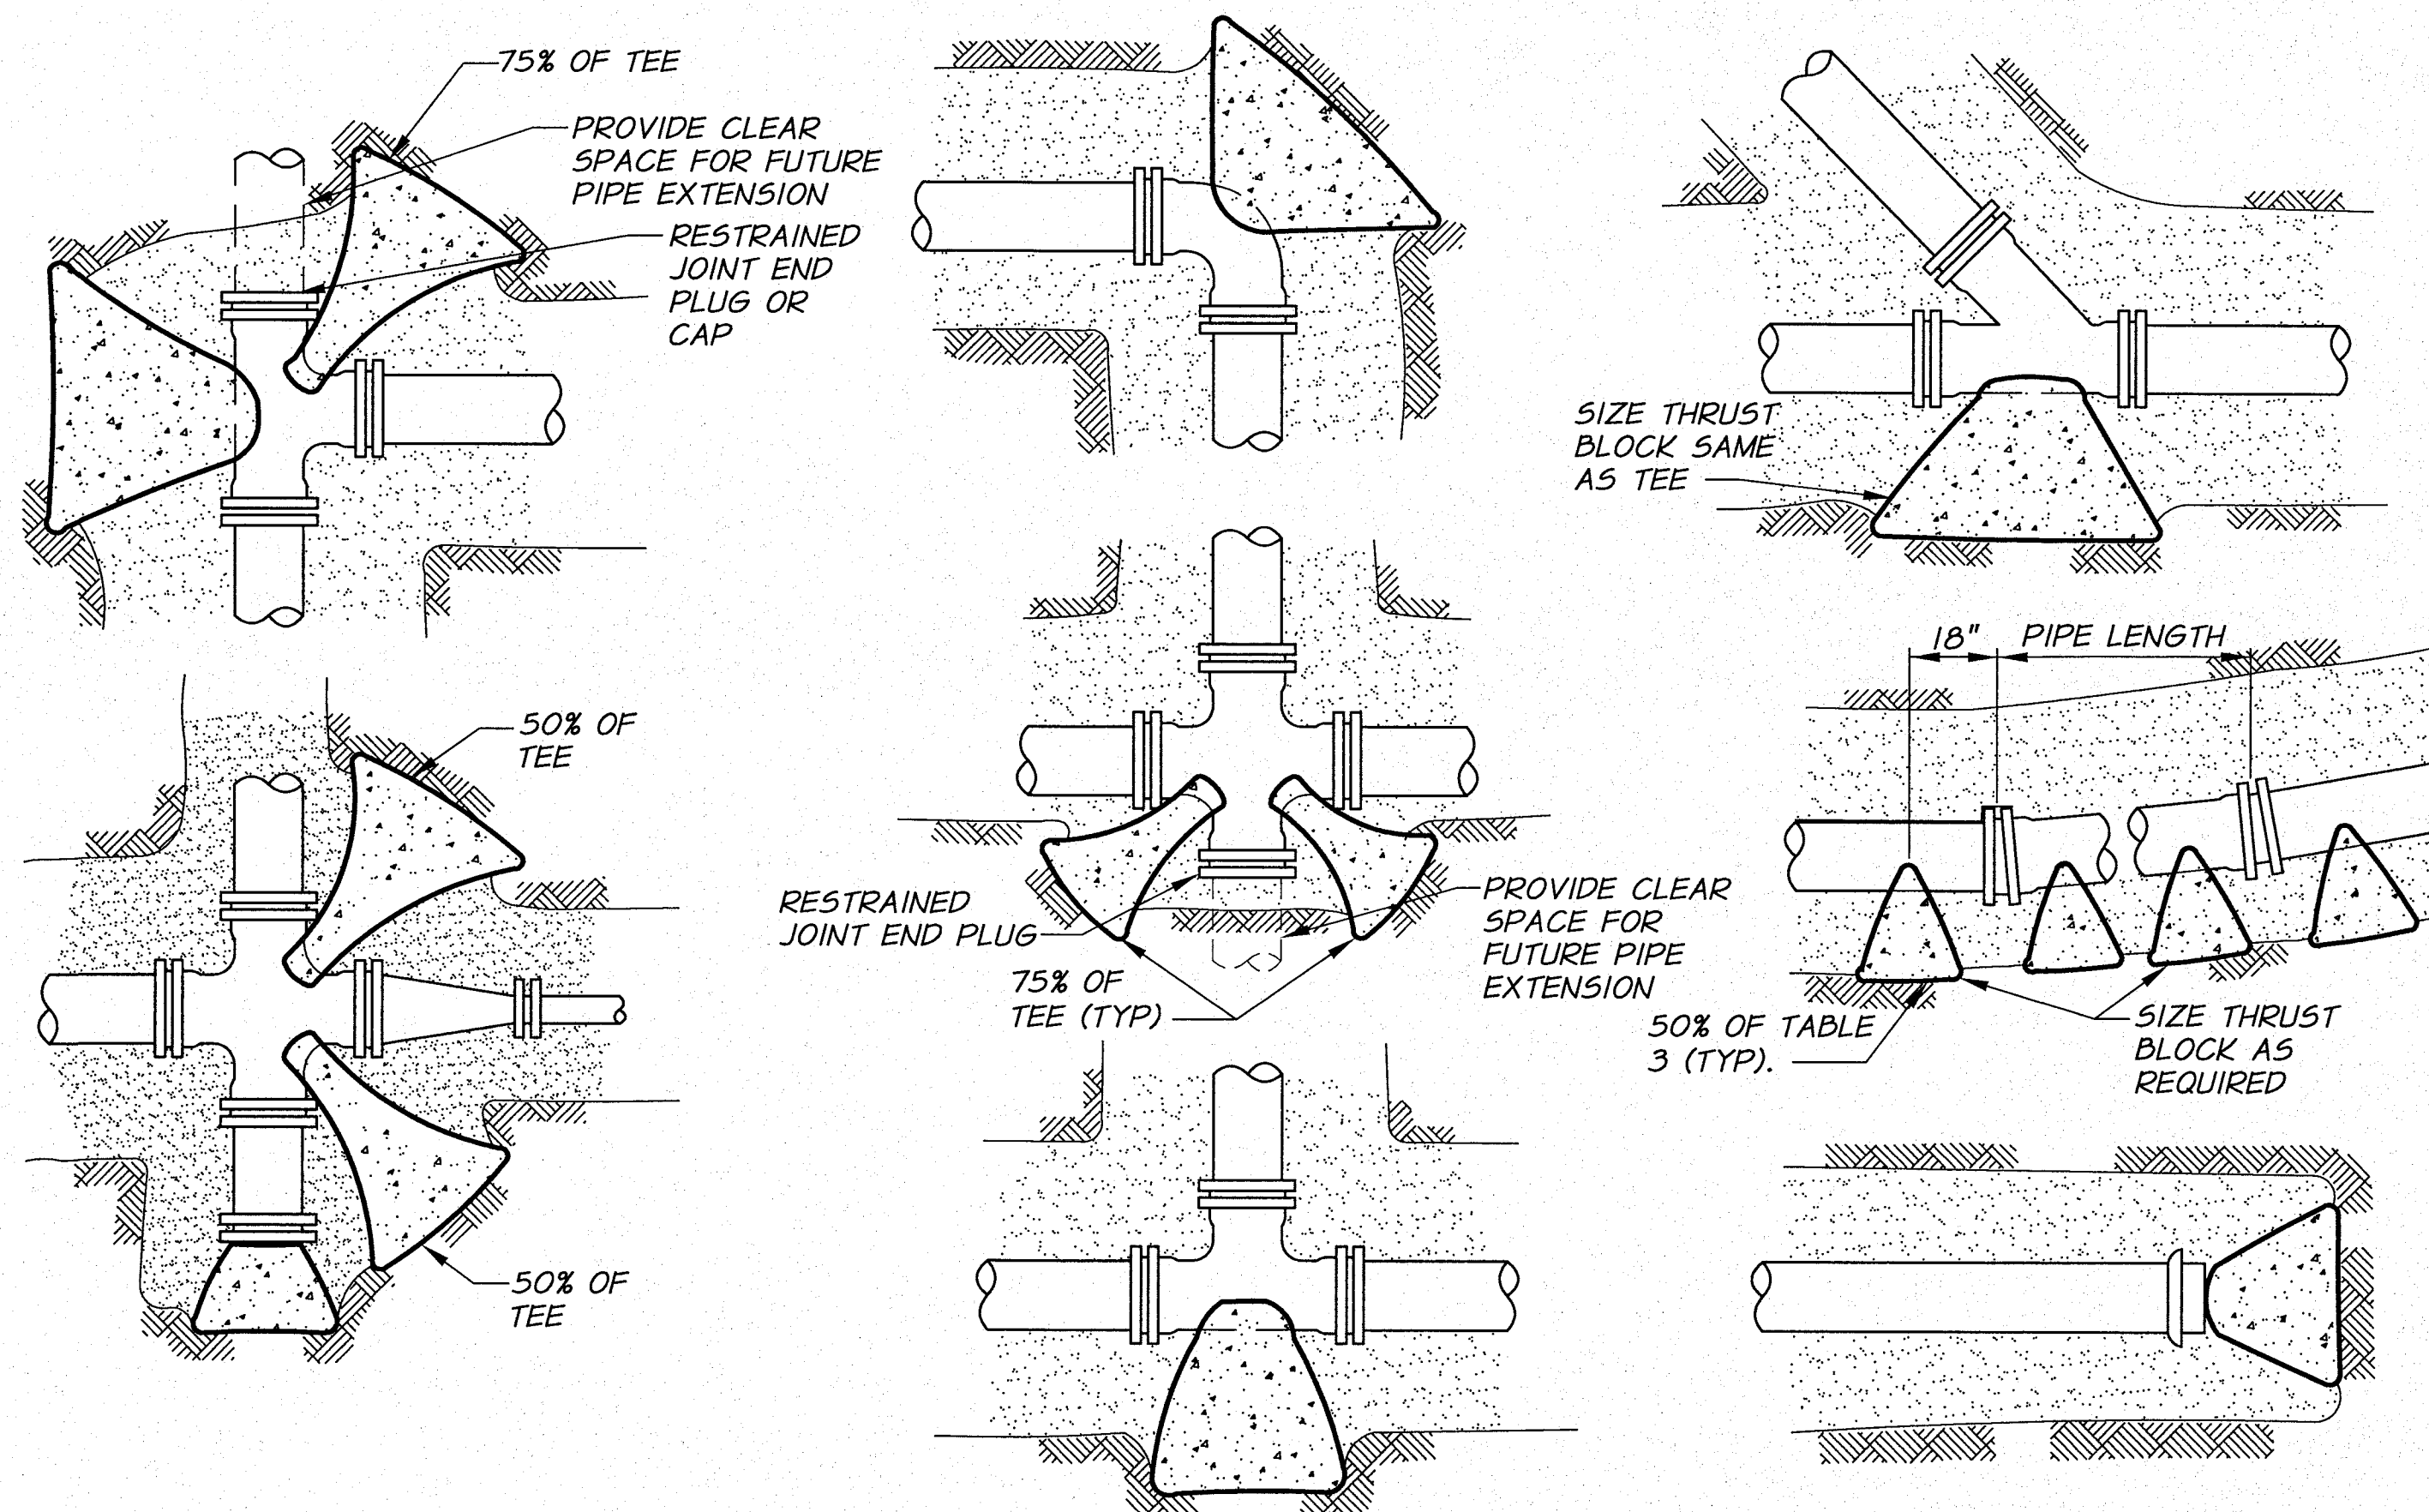


**TYPICAL THRUST BLOCK LOCATIONS**

PLAN VIEWS

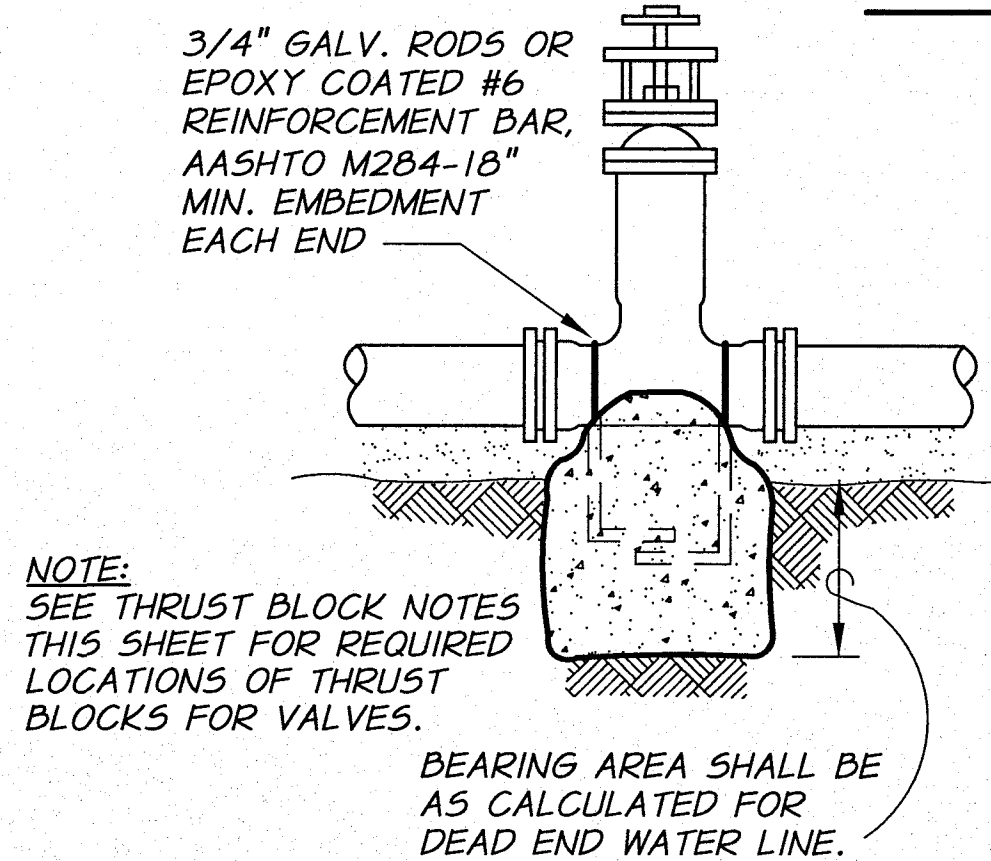


**TYPICAL VALVE THRUST BLOCK**


**NOTE:** NOT REQUIRED FOR VALVES WITH FLANGED CONNECTION TO TEE WITH THRUST BLOCK.

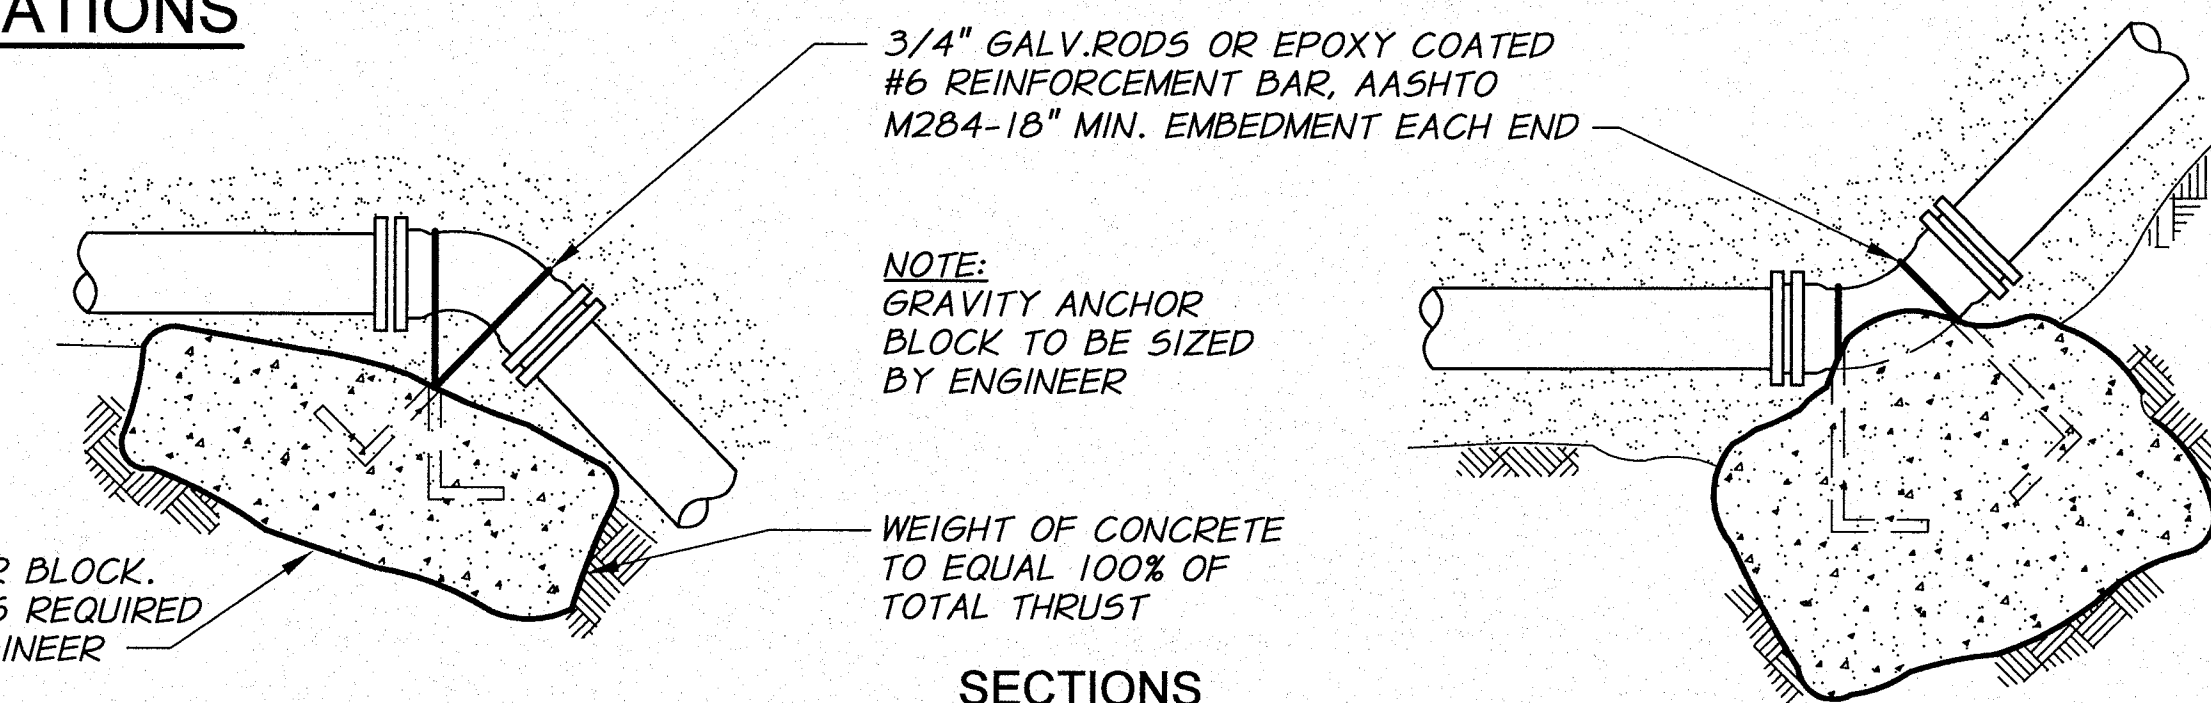

**SECTIONS**

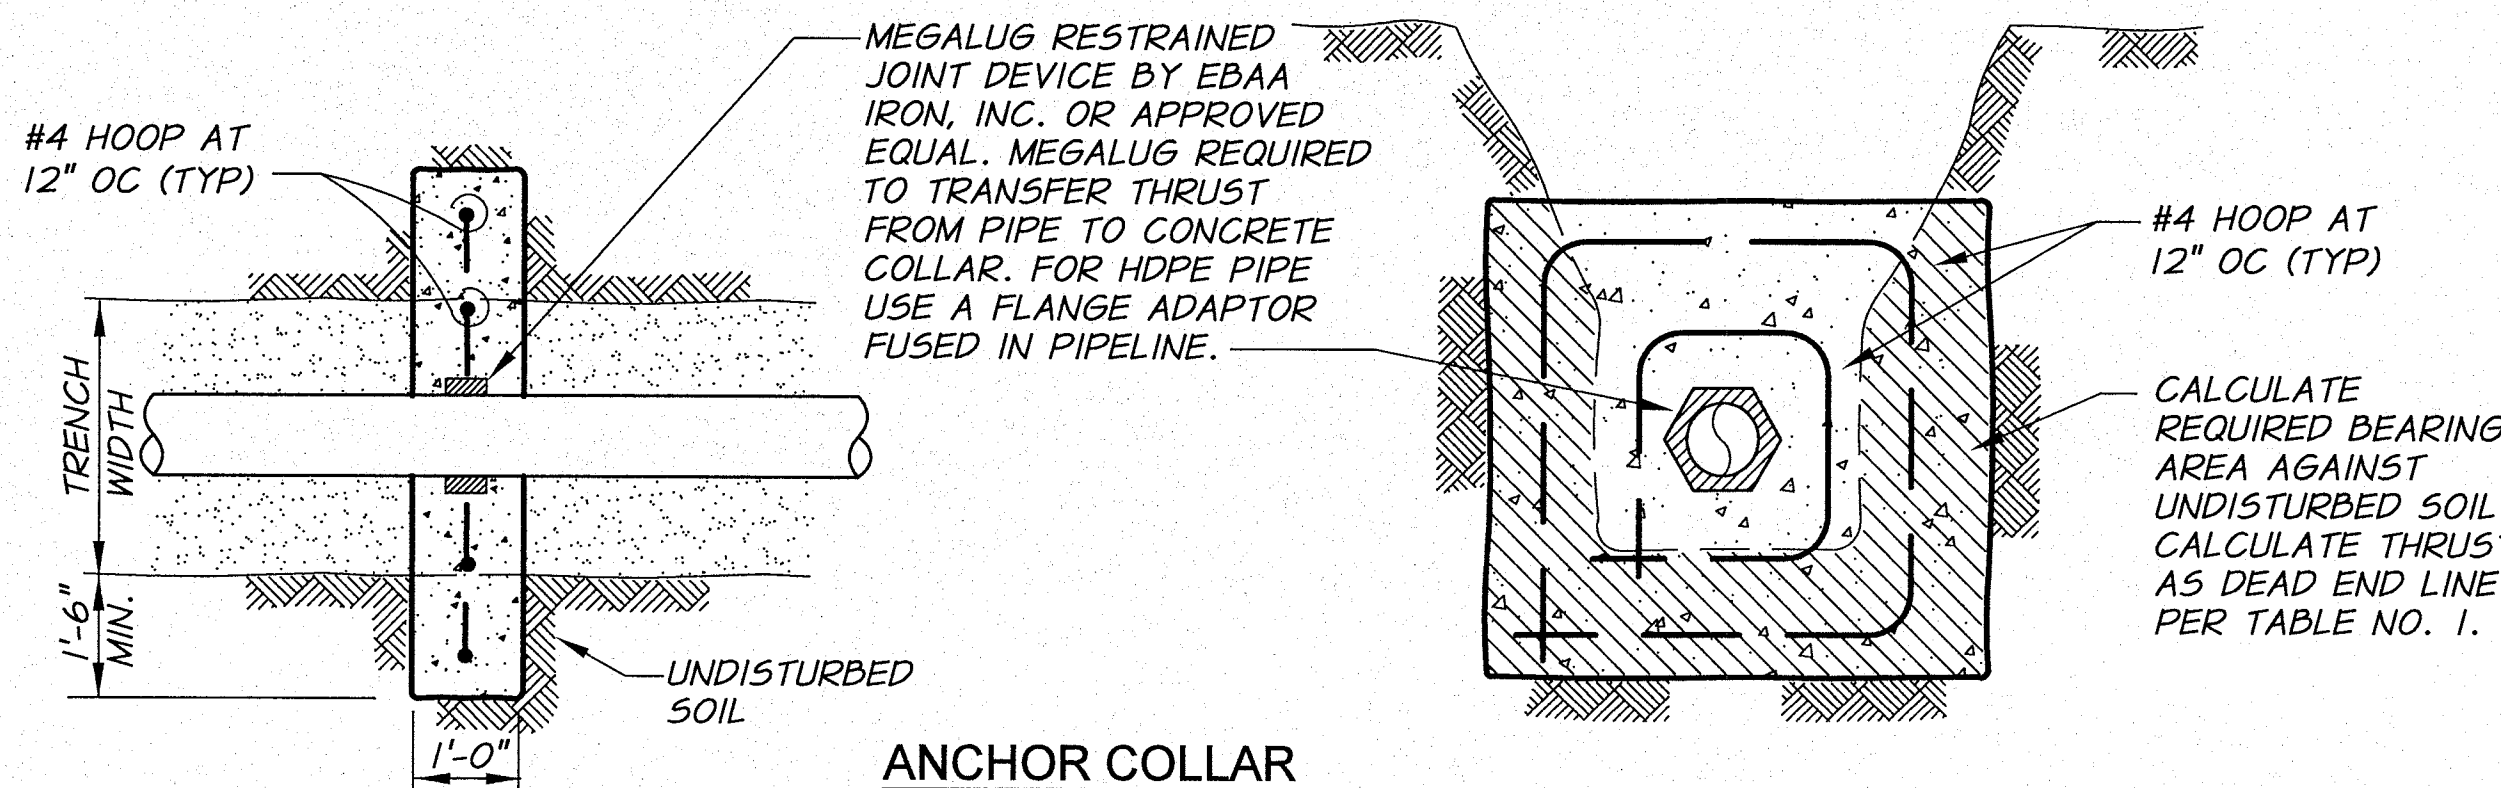

**TYPICAL ANCHOR BLOCKS**

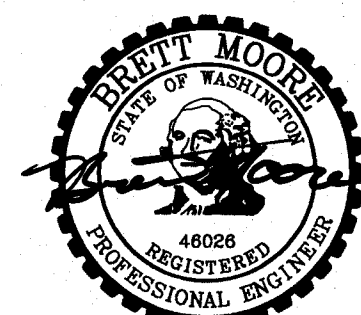


SIGNED 06-04-12  
 RECORD DRAWINGS

REVISION	BY	DATE	HORIZ. SCALE NONE	VERT. SCALE
DESIGNED BY R. HARRIS	XREFS: TB-BID.dwg		JOB NUMBER 1199-336	DATE 2011
DRAWN BY D. CHRISTMAN			ACAD FILE: Thrust-PH2B.dwg	
REVIEWED BY B. MOORE			COPYRIGHT 2011 BY ANDERSON-PERRY & ASSOC., INC.	

**RECORD DRAWINGS**

These record drawings have been prepared, in part, on the basis of information compiled and furnished by others. They may contain some discrepancies and omissions, and do not necessarily represent "exact" field conditions. The Owner and the Engineer accept no responsibility for their accuracy.

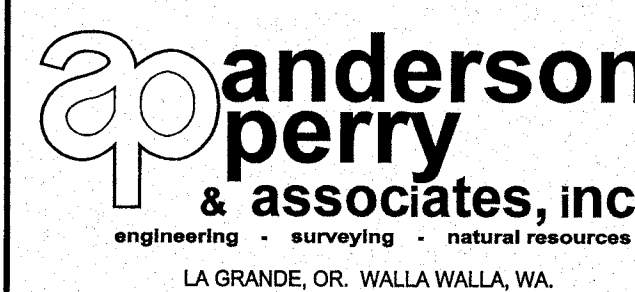

**BENTON IRRIGATION DISTRICT**  
 IRRIGATION SYSTEM IMPROVEMENTS  
 PHASE 2B

THRUST BLOCK DETAILS

SHEET

53