


SIGNED 06-04-12
RECORD DRAWINGS

RECORD DRAWINGS		DATE	5/12
DESIGNED BY	R. HARRIS	DATE	2011
DRAWN BY	E. ARNTZ	DATE	2011
REVIEWED BY	B. MOORE	DATE	2011
XREFS: TB-BID.dwg		ACAD FILE: West_Main_E.dwg	
COPYRIGHT 2011 BY ANDERSON-PERRY & ASSOC., INC.			

RECORD DRAWINGS
These record drawings have been prepared, in part, on the basis of information compiled and furnished by others. They may contain some discrepancies and omissions, and do not necessarily represent "exact" field conditions. The Owner and the Engineer accept no responsibility for their accuracy.

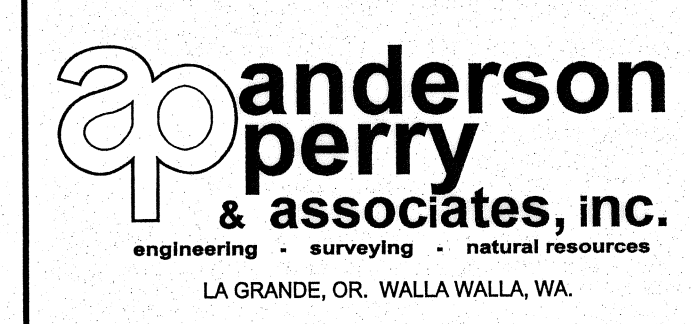

BENTON IRRIGATION DISTRICT
IRRIGATION SYSTEM IMPROVEMENTS
PHASE 2B
O.I.E. HWY. PIPING
STA. 1+00 TO STA. 14+00

SHEET
20