
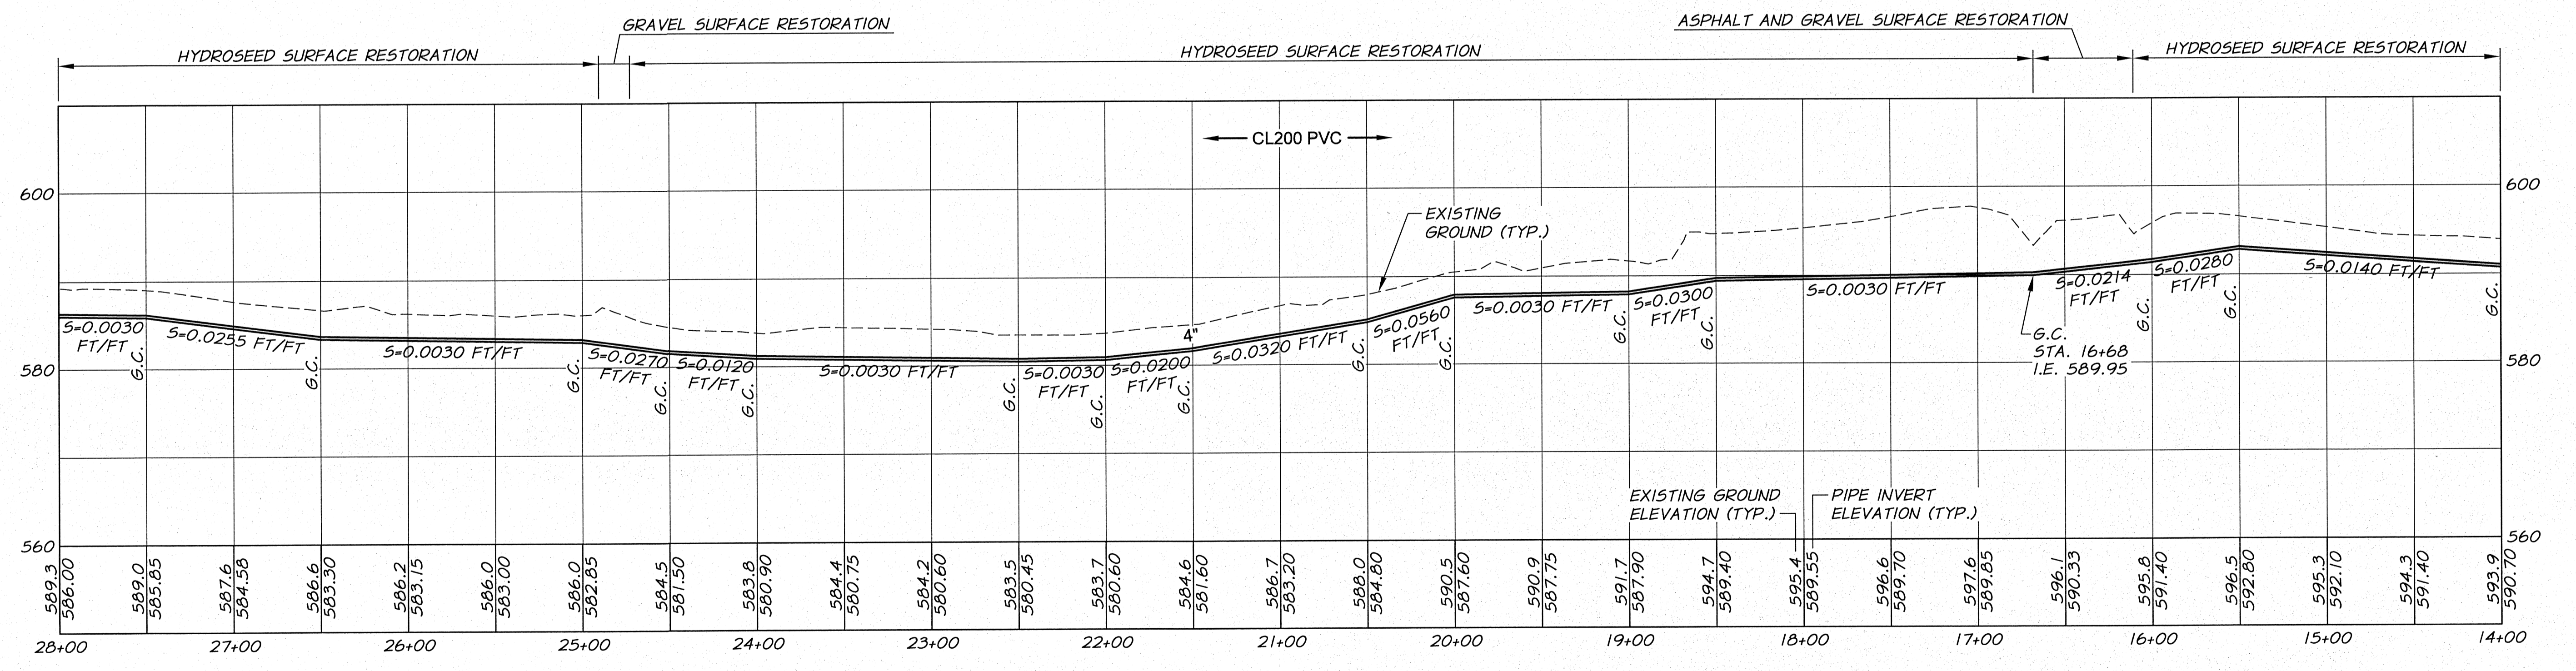


Trotter, Donald
(SEE SHEET 20)

Gardiner, Jeff
No Service

Roberts, James
(SEE SHEET 20)

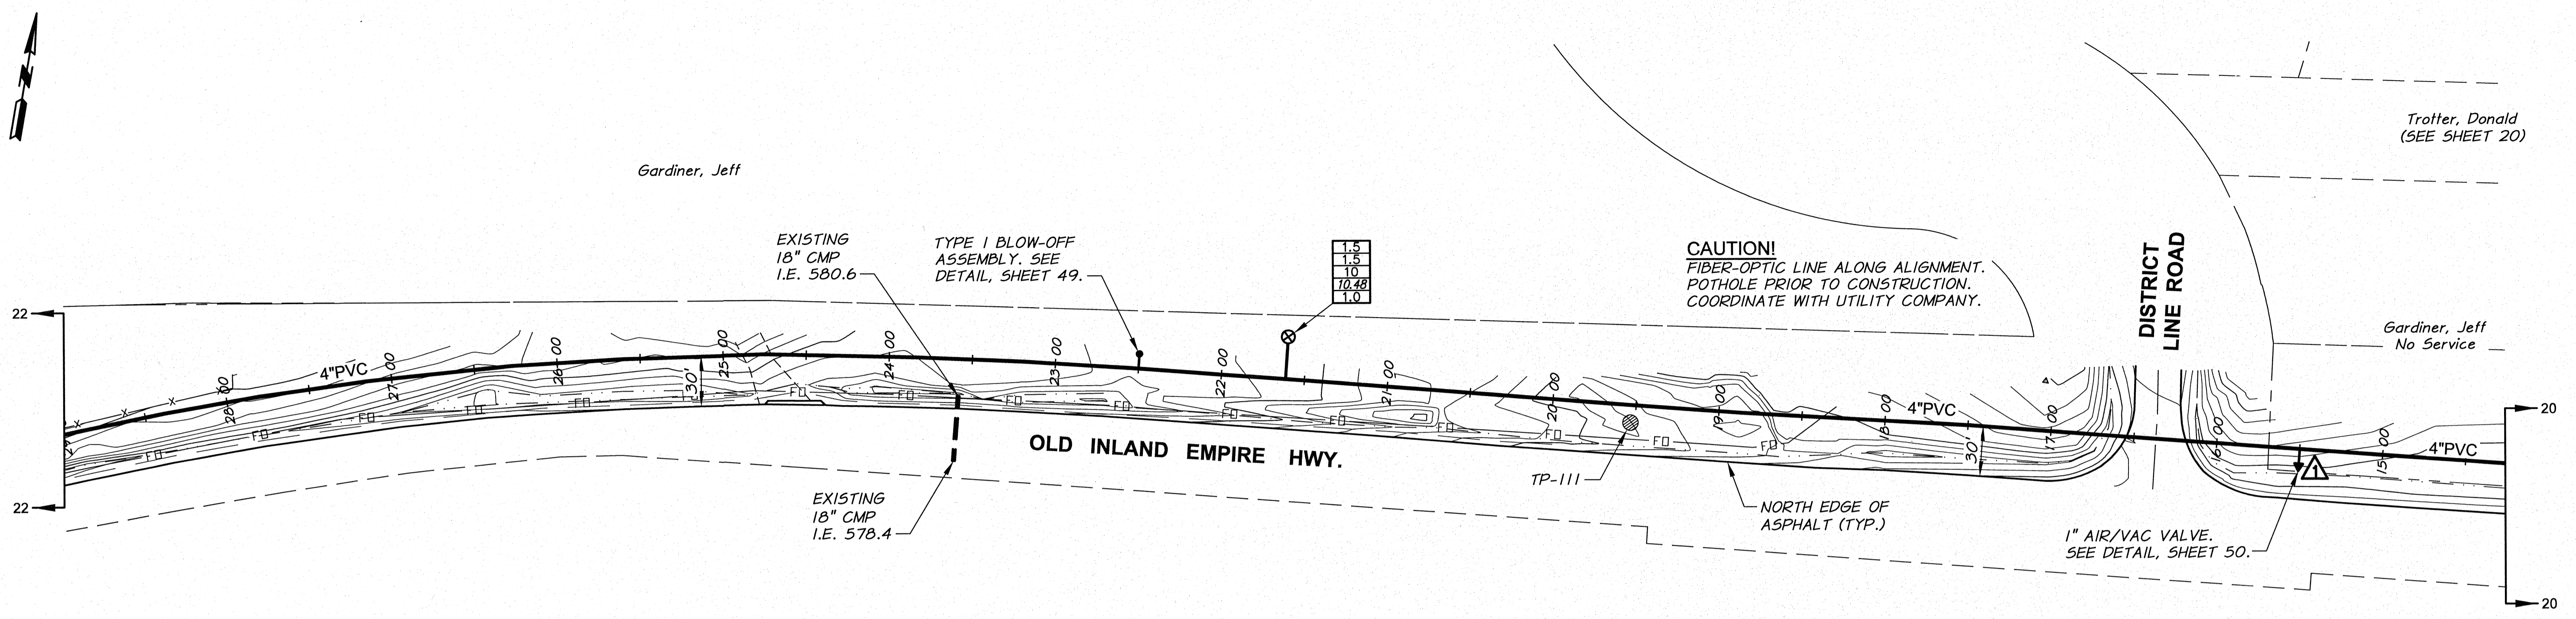


SIGNED 06-04-12
RECORD DRAWINGS

RECORD DRAWINGS		B.M.	5/12
DESIGNED BY	R. HARRIS	XREFS:	TB-BID.dwg
DRAWN BY	E. ARNTZ		
REVIEWED BY	B. MOORE		

HORIZ. SCALE	1"=50'	VERT. SCALE	1"=10'
JOB NUMBER	1199-336	DATE	2011
ACAD FILE	West_Main_E.dwg		
COPYRIGHT 2011 BY ANDERSON-PERRY & ASSOC., INC.			

RECORD DRAWINGS
These record drawings have been prepared, in part, on the basis of information compiled and furnished by others. They may contain some discrepancies and omissions, and do not necessarily represent "exact" field conditions. The Owner and the Engineer accept no responsibility for their accuracy.

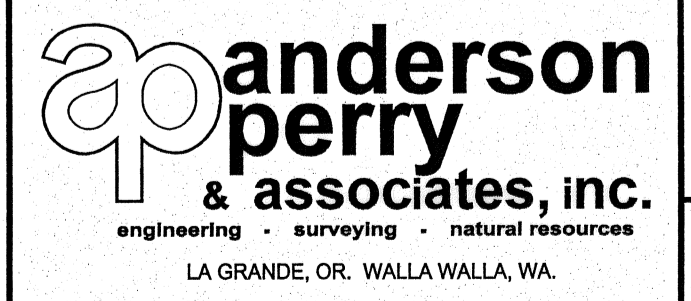

BENTON IRRIGATION DISTRICT
IRRIGATION SYSTEM IMPROVEMENTS
PHASE 2B

O.I.E. HWY. PIPING
STA. 14+00 TO STA. 28+00

SHEET
21

ARCHIVED