
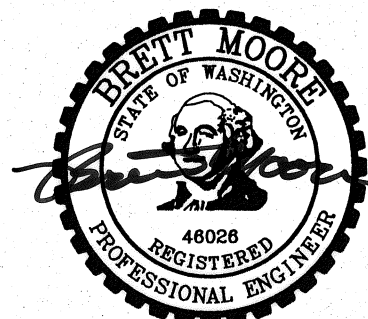


WORK ITEMS

- (A) EXISTING IRRIGATION LINE ALONG OR CROSSING ALIGNMENT. EXACT LOCATION UNKNOWN. REMOVE AND PLUG AS REQUIRED FOR NEW LINE INSTALLATION.

PAY LIMITS -
O.I.E. BOOSTER
PUMP STATION

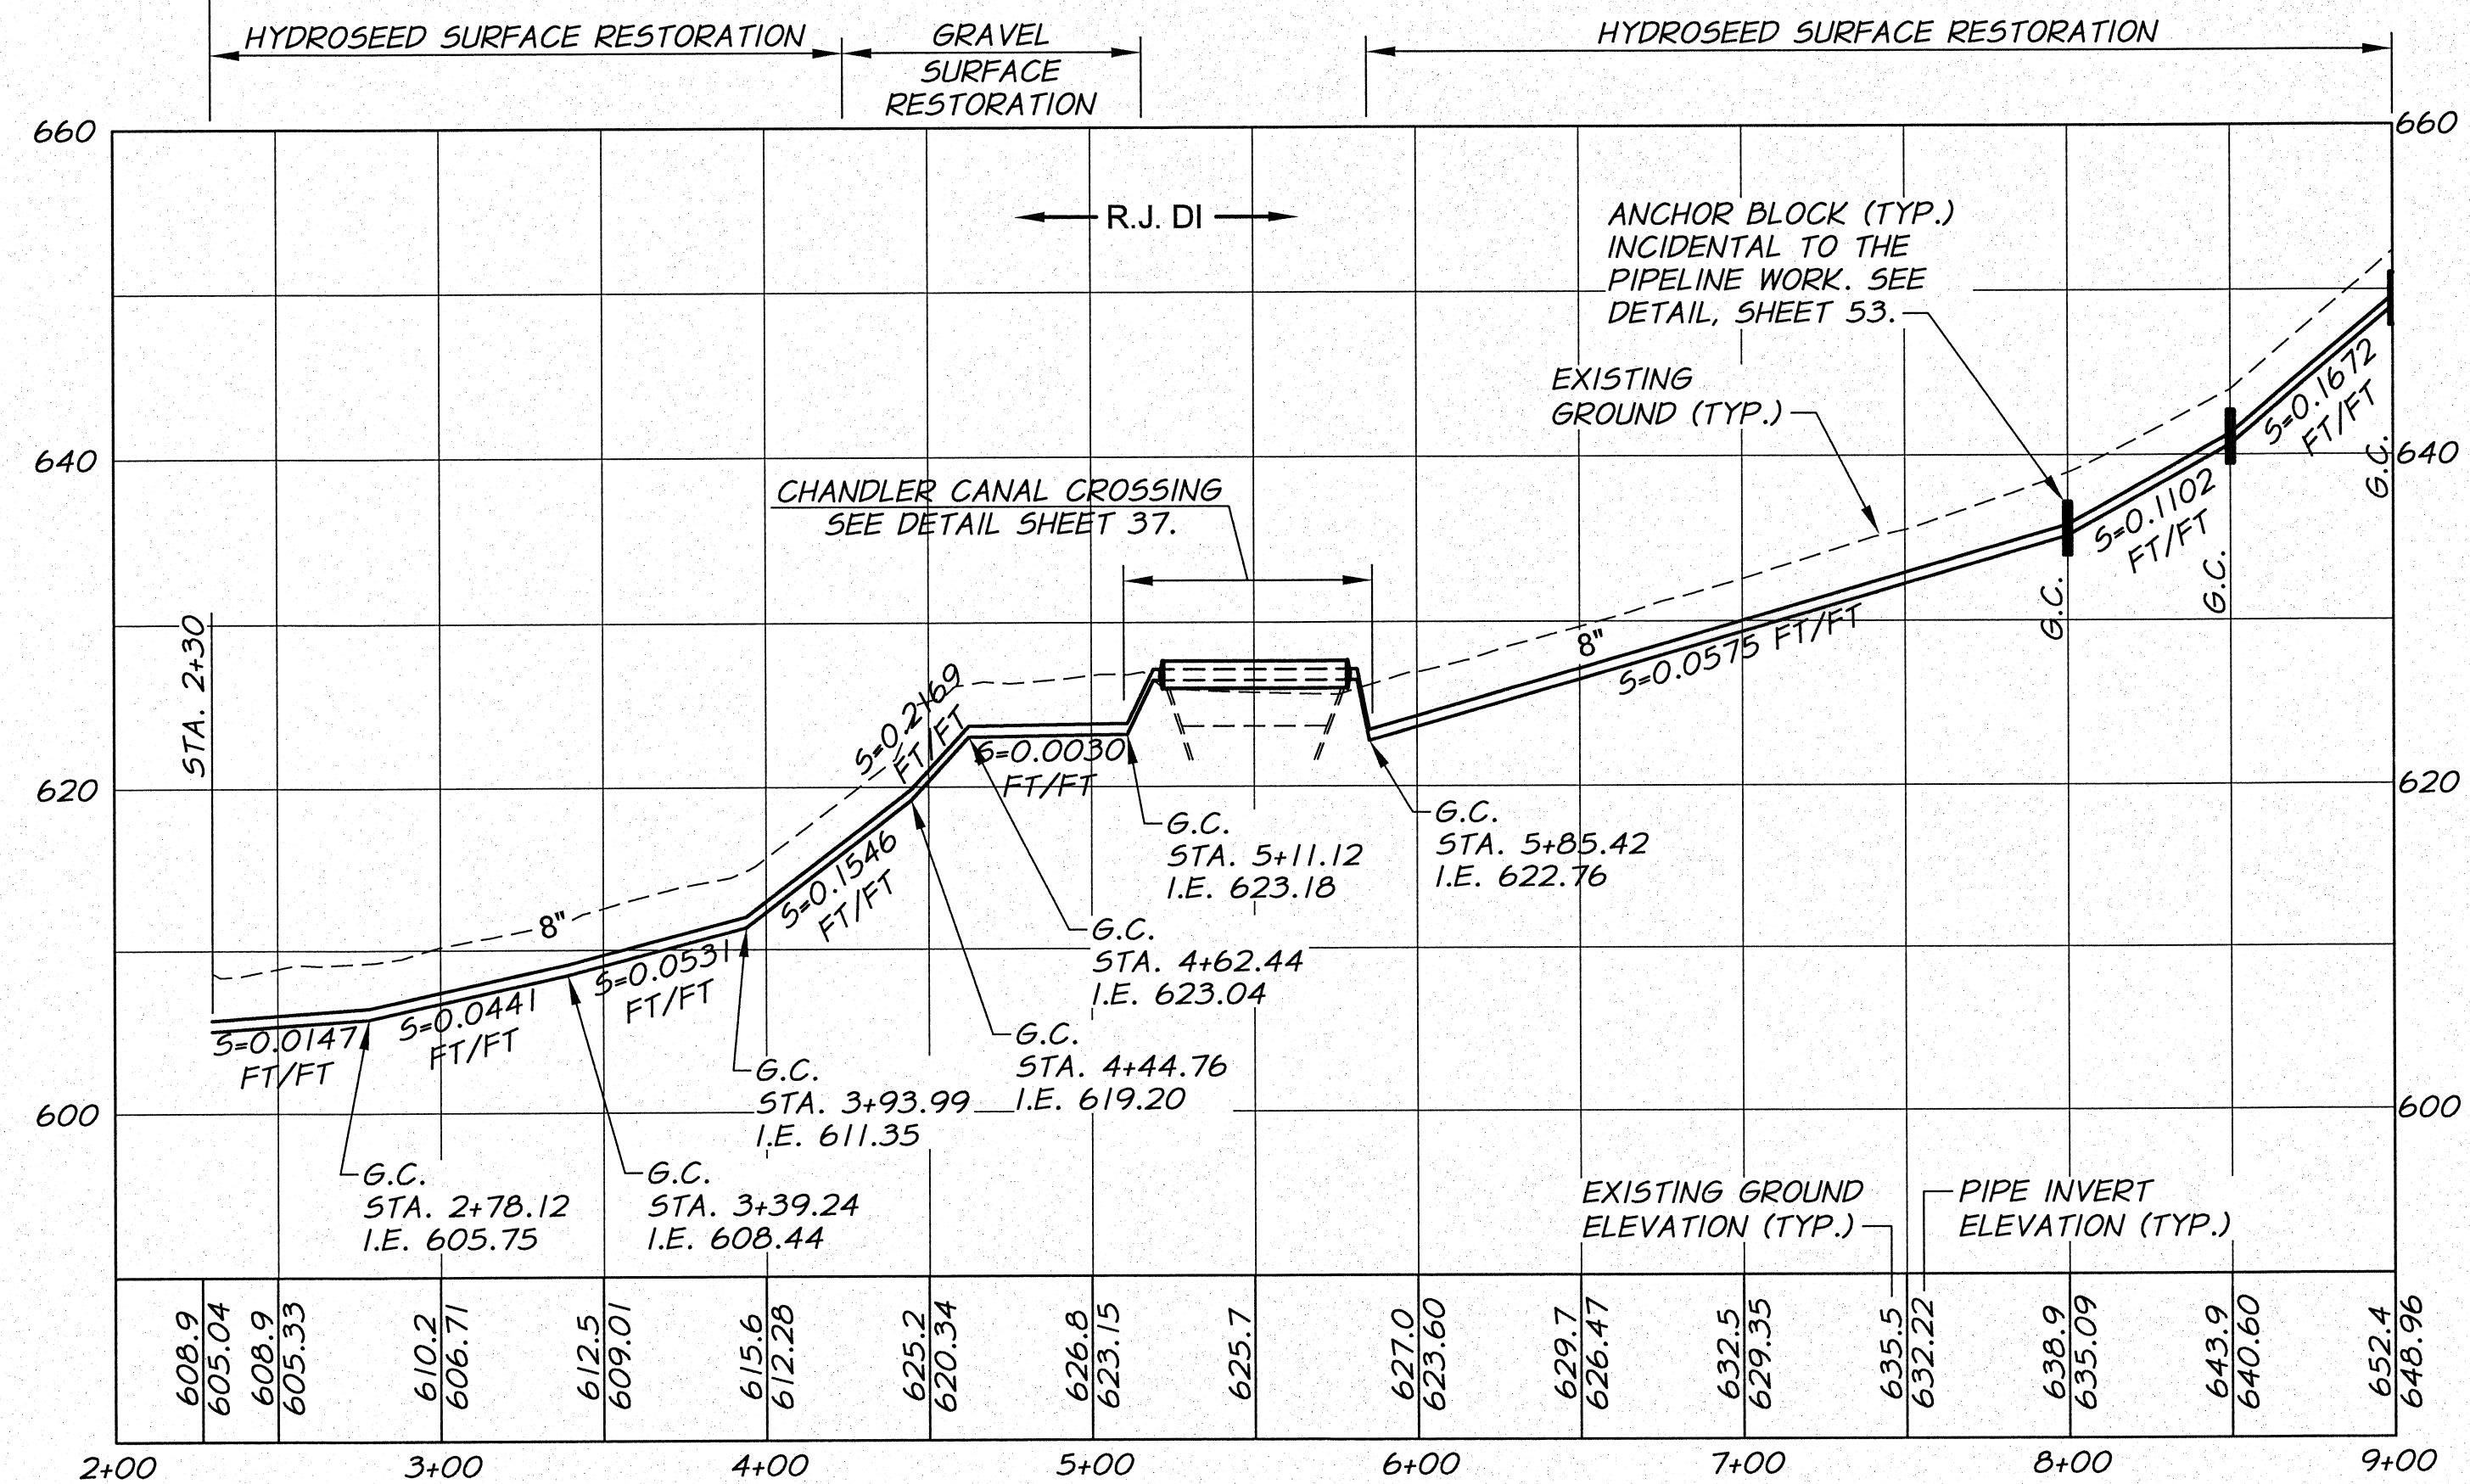


SIGNED 06-04-12
RECORD DRAWINGS

| | | | | | |
|-----------------|-----------|------------|-----------------|------|------|
| RECORD DRAWINGS | | BY | B.M. | DATE | 5/12 |
| DESIGNED BY | R. HARRIS | XREFS: | TB-BID.dwg | | |
| DRAWN BY | E. ARNTZ | JOB NUMBER | 1199-336 | | |
| REVIEWED BY | B. MOORE | DATE | 2011 | | |
| | | ACAD FILE: | West_Main_E.dwg | | |

| | |
|---|--------|
| 50 0 50 100 150 | |
| SCALE IN FEET | |
| 10 0 10 20 30 | |
| SCALE IN FEET | |
| HORIZ. SCALE | 1"=50' |
| VERT. SCALE | 1"=10" |
| COPYRIGHT 2011 BY ANDERSON-PERRY & ASSOC., INC. | |

RECORD DRAWINGS

These record drawings have been prepared, in part, on the basis of information compiled and furnished by others. They may contain some discrepancies and omissions, and do not necessarily represent "exact" field conditions. The Owner and the Engineer accept no responsibility for their accuracy.

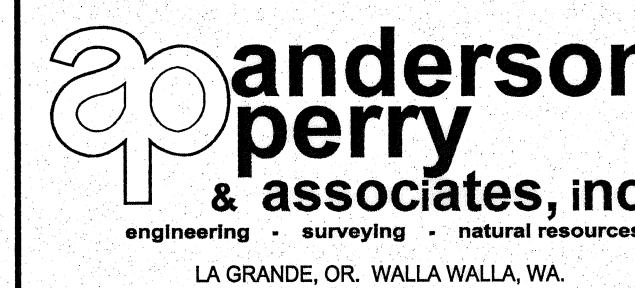

BENTON IRRIGATION DISTRICT
IRRIGATION SYSTEM IMPROVEMENTS
PHASE 2B

O.I.E. HWY. TO CANAL PIPING
STA. 1+00 TO STA. 9+00

SHEET

25