
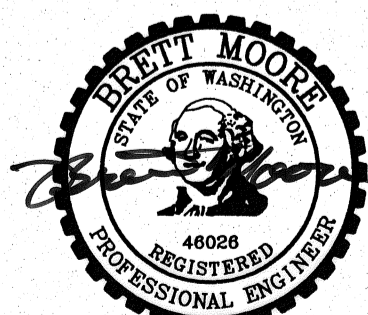


WORK ITEMS

- Ⓒ EXISTING IRRIGATION LINE ALONG ALIGNMENT TO BE ABANDONED. REMOVE AND PLUG AS REQUIRED FOR NEW LINE INSTALLATION.
- Ⓓ REMOVE CONTROL GATE, PIPING, AND CONCRETE STRUCTURE FROM CANAL OUTLET. RESTORE CANAL BANK WITH COMPACTED GENERAL BACKFILL MATERIAL. SHAPE BANK TO MATCH EXISTING.

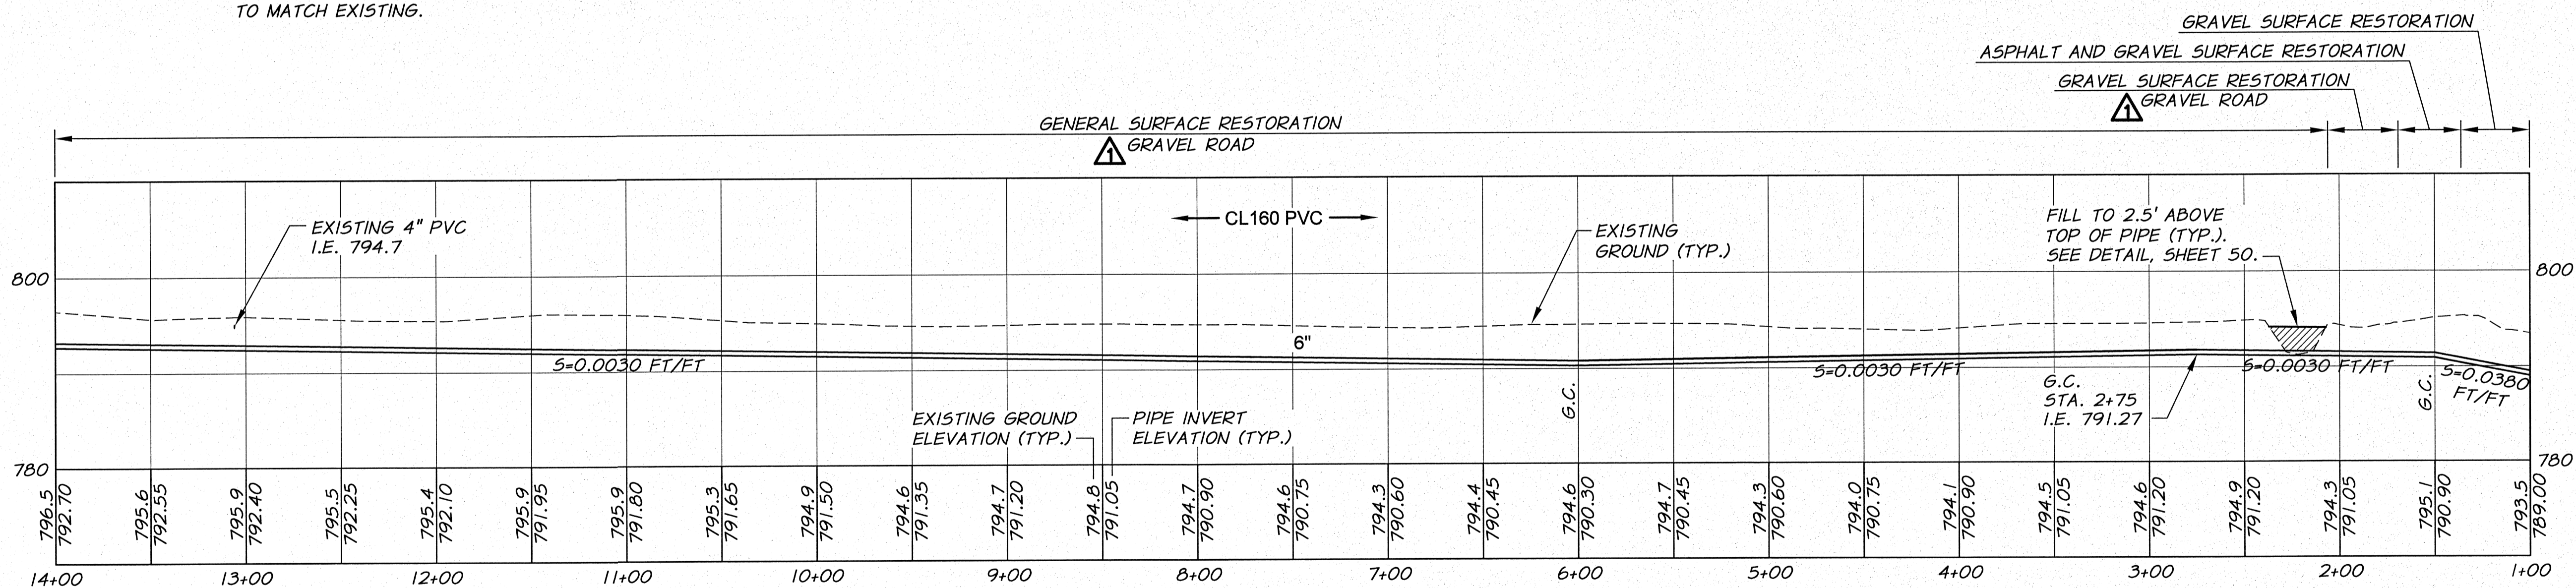


SIGNED 06-04-12
RECORD DRAWINGS

| | | | | | |
|-----------------|-----------|-------------------|------|------|------|
| RECORD DRAWINGS | | BY | B.M. | DATE | 5/12 |
| DESIGNED BY | R. HARRIS | XREFS: TB-BID.dwg | | | |
| DRAWN BY | E. ARNTZ | | | | |
| REVIEWED BY | B. MOORE | | | | |

| | | | |
|---|-----------------|--------------------|------|
| HORIZ. SCALE 1"=50' | | VERT. SCALE 1"=10' | |
| JOB NUMBER | 1199-336 | DATE | 2011 |
| ACAD FILE: | West_Main_E.dwg | | |
| COPYRIGHT 2011 BY ANDERSON-PERRY & ASSOC., INC. | | | |

RECORD DRAWINGS

These record drawings have been prepared, in part, on the basis of information compiled and furnished by others. They may contain some discrepancies and omissions, and do not necessarily represent "exact" field conditions. The Owner and the Engineer accept no responsibility for their accuracy.

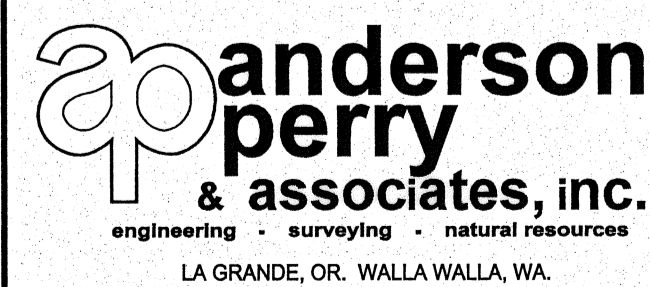

**BENTON IRRIGATION DISTRICT
IRRIGATION SYSTEM IMPROVEMENTS
PHASE 2B**

CANAL PIPING
STA. 1+00 TO STA. 14+00

SHEET

28

ARCHIVED