




RAKE AND STOCKPILE GROUND COVER.
DO NOT MIX WITH SOIL. AFTER
CONSTRUCTION, PLACE GROUND COVER
BACK TO ORIGINAL CONDITION.

1" AIR/VAC VALVE. SEE
DETAIL, SHEET 50. (TRAFFIC
RATED BOX AND LID)

Olsen Brothers Farms
No Service



1" AIR/VAC VALVE. SEE
DETAIL, SHEET 50. (TRAFFIC
RATED BOX AND LID)

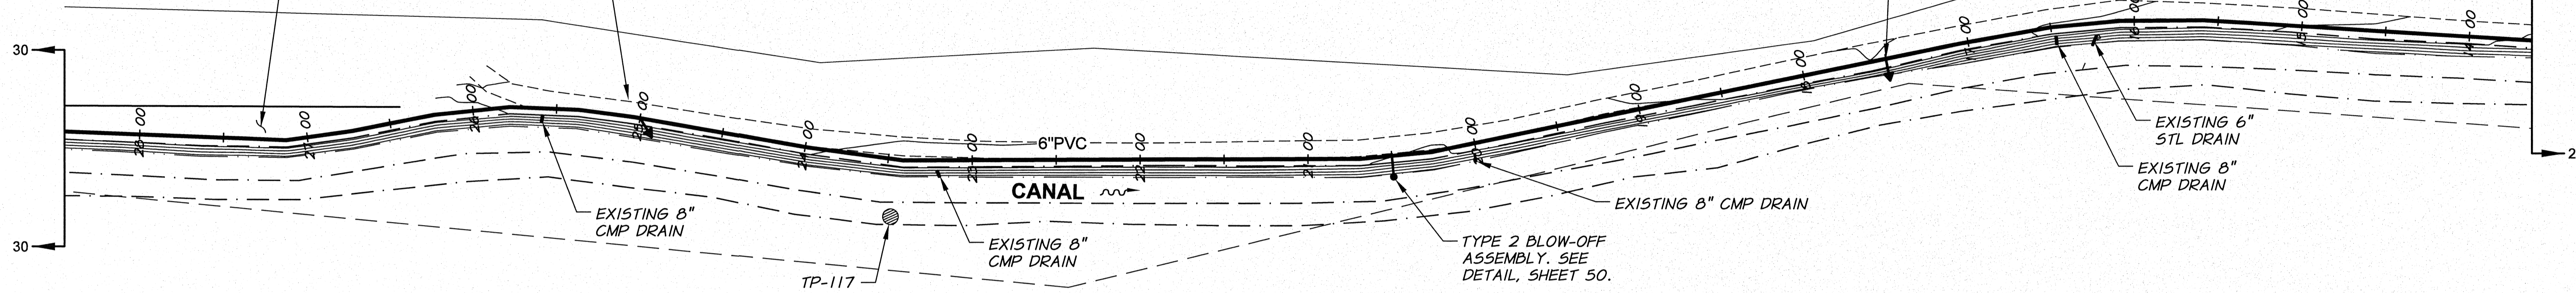

Olsen Brothers Farms
(SEE SHEET 30)



GRAVEL ROAD

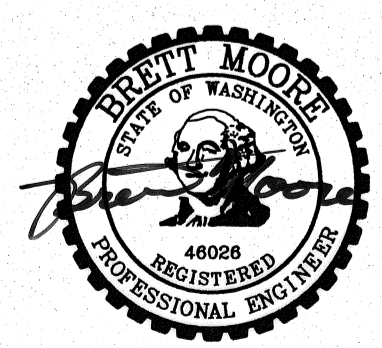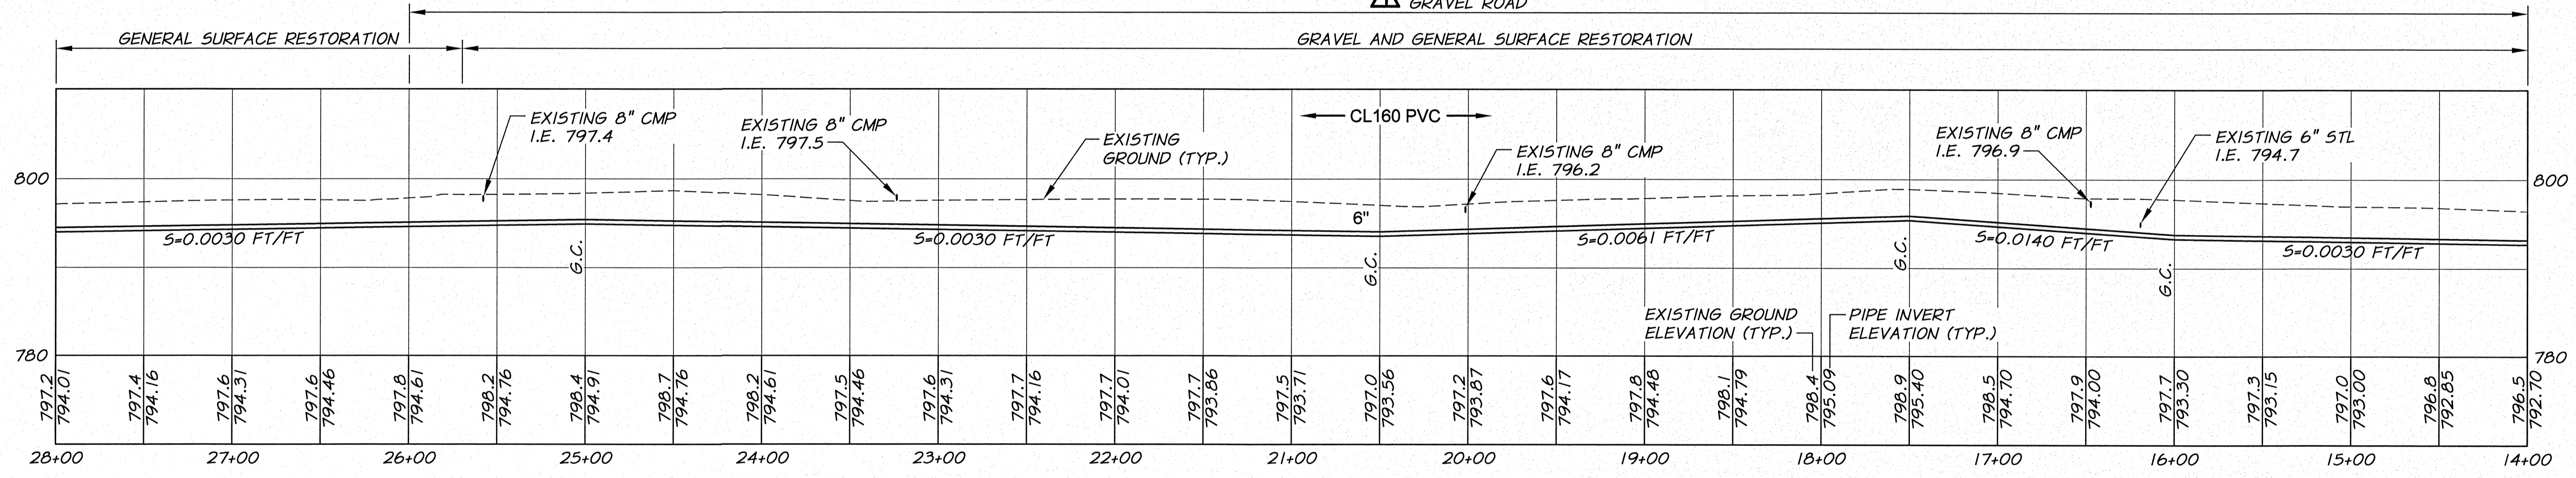


SIGNED 06-04-12
RECORD DRAWINGS

REVISION		BY	DATE
DESIGNED BY R. HARRIS		B.M.	5/12
DRAWN BY E. ARNTZ			
REVIEWED BY B. MOORE			

50	0	50	100	150
SCALE IN FEET				
10	0	10	20	30
SCALE IN FEET				
HORIZ. SCALE 1"=50'		VERT. SCALE 1"=10'		
JOB NUMBER 1199-336		DATE 2011		
ACAD FILE: West_Main_E.dwg		COPYRIGHT 2011 BY ANDERSON-PERRY & ASSOC., INC.		

RECORD DRAWINGS
These record drawings have been prepared, in part, on the basis of information compiled and furnished by others. They may contain some discrepancies and omissions, and do not necessarily represent "exact" field conditions. The Owner and the Engineer accept no responsibility for their accuracy.

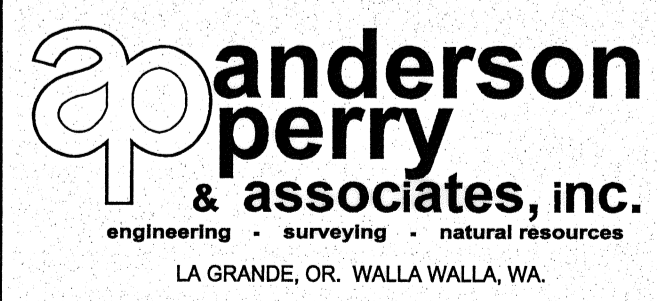

BENTON IRRIGATION DISTRICT
IRRIGATION SYSTEM IMPROVEMENTS
PHASE 2B
CANAL PIPING
STA. 14+00 TO STA. 28+00

SHEET
29