


**YAKIMA RIVER VIEW ORCHARDS 2-1/2" SERVICE**  
N.T.S.

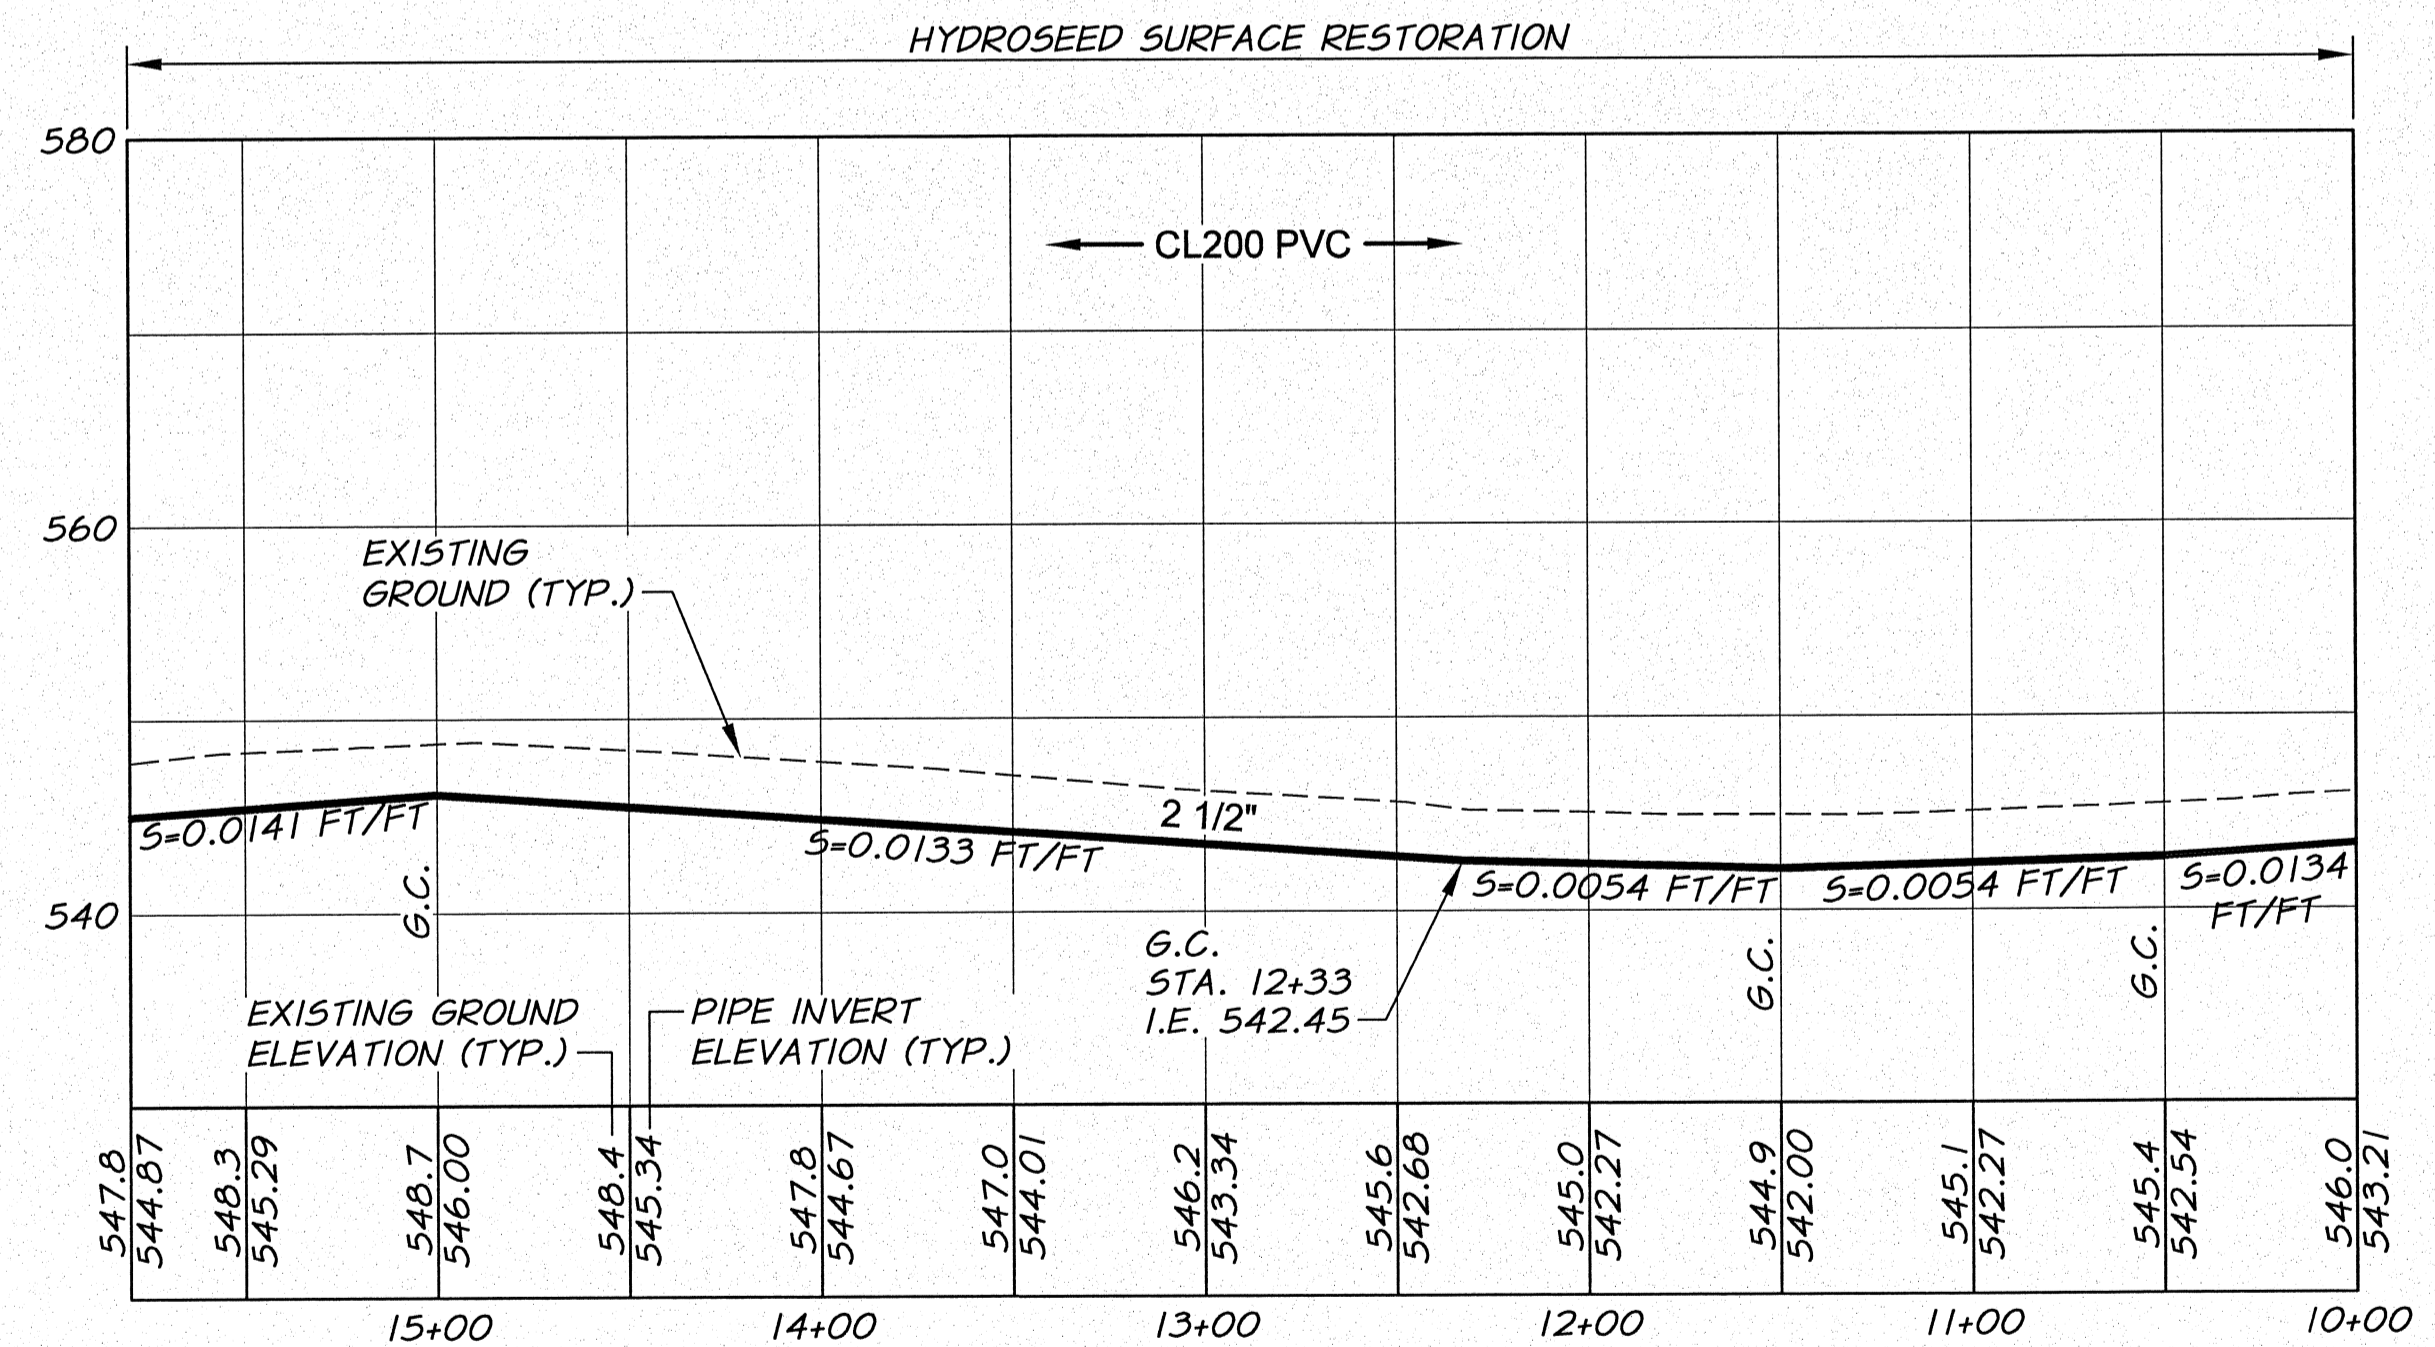


SIGNED 06-04-12  
RECORD DRAWINGS

REVISION	BY	DATE	HORIZ. SCALE 1"=50'	VERT. SCALE 1"=10'
DESIGNED BY R. HARRIS			JOB NUMBER 1199-336	DATE 2011
DRAWN BY E. ARNTZ			ACAD FILE: West_Main _F.dwg	
REVIEWED BY B. MOORE			COPYRIGHT 2011 BY ANDERSON-PERRY & ASSOC., INC.	

**RECORD DRAWINGS**

These record drawings have been prepared, in part, on the basis of information compiled and furnished by others. They may contain some discrepancies and omissions, and do not necessarily represent "exact" field conditions. The Owner and the Engineer accept no responsibility for their accuracy.

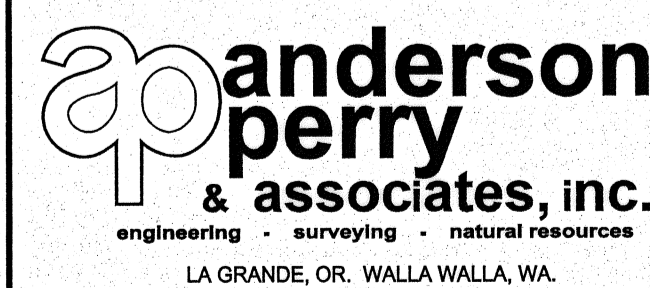

**BENTON IRRIGATION DISTRICT**  
IRRIGATION SYSTEM IMPROVEMENTS  
PHASE 2B

BRANCH LINE PIPING  
STA. 10+00 TO STA. 15+95

SHEET

34