



SIGNED 07-09-12  
RECORD DRAWINGS

RECORD DRAWINGS		BY	B.M.	DATE	5/12	
DESIGNED BY	R. HARRIS	XREFS:	TB-BID.dwg			
DRAWN BY	E. ARNTZ	JOB NUMBER	1199-336			
REVIEWED BY	B. MOORE	ACAD FILE	North_West_B.dwg			
		HORIZ. SCALE	1"=50'		VERT. SCALE	1"=10'
		JOB NUMBER	1199-336		DATE	2011
		ACAD FILE	North_West_B.dwg			
COPYRIGHT 2011 BY ANDERSON-PERRY & ASSOC., INC.						

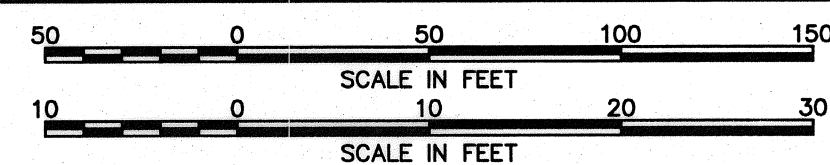

### RECORD DRAWINGS

These record drawings have been prepared, in part, on the basis of information compiled and furnished by others. They may contain some discrepancies and omissions, and do not necessarily represent "exact" field conditions. The Owner and the Engineer accept no responsibility for their accuracy.

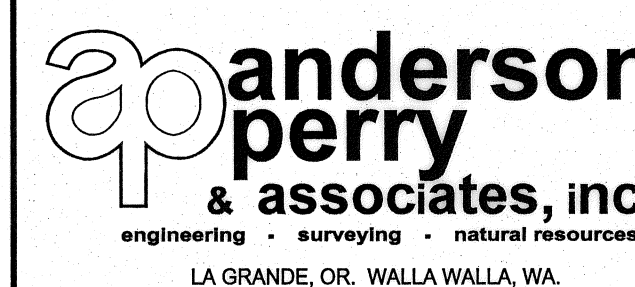

### BENTON IRRIGATION DISTRICT IRRIGATION SYSTEM IMPROVEMENTS PHASE 2C

EAST ROZA TO KNOX ROAD PIPING  
STA. 13+00 TO STA. 20+00

SHEET

4

ARCHIVED