


NOTES

1. GRADE TO DRAIN TO MAIN LINE.
2. MAINTAIN 2.5 FT. MINIMUM COVER.

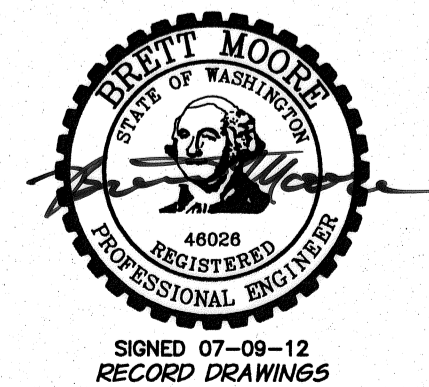


REVISION	BY	DATE	XREFS: TB-BID.dwg
DESIGNED BY	R. HARRIS		
DRAWN BY	E. ARNTZ		
REVIEWED BY	B. MOORE		

HORIZ. SCALE 1"=50'	VERT. SCALE 1"=10'
JOB NUMBER 1199-336	DATE 2011
ACAD FILE: North_West _C.dwg	
COPYRIGHT 2011 BY ANDERSON-PERRY & ASSOC., INC.	

RECORD DRAWINGS

These record drawings have been prepared, in part, on the basis of information compiled and furnished by others. They may contain some discrepancies and omissions, and do not necessarily represent "exact" field conditions. The Owner and the Engineer accept no responsibility for their accuracy.

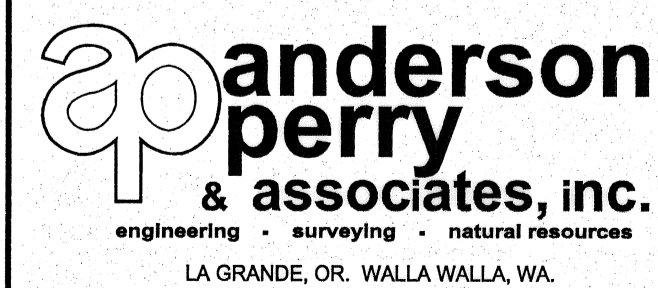

**BENTON IRRIGATION DISTRICT
IRRIGATION SYSTEM IMPROVEMENTS
PHASE 2C**

EAST ROZA TO KNOX ROAD PIPING
STA. 1+00 TO STA. 8+00

SHEET

15