


WORK ITEMS

- (A) EXISTING IRRIGATION LINE ALONG OR CROSSING ALIGNMENT. EXACT LOCATION UNKNOWN. REMOVE AND PLUG AS REQUIRED FOR NEW LINE INSTALLATION.
- (B) EXISTING IRRIGATION CONTROL STRUCTURE TO BE REMOVED.


NOTES

1. MAINTAIN 2.5' MIN. COVER AND GRADE TO DRAIN AWAY FROM MAIN LINE.
2. HYDROSEED AND GRAVEL SURFACE RESTORATION.

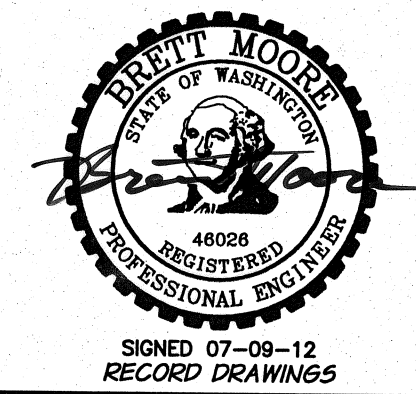

REVISION		BY DATE		HORIZ. SCALE 1"=50'		VERT. SCALE 1"=10'	
△ RECORD DRAWINGS		B.M. 5/12		50 0 50 100 150		SCALE IN FEET	
DESIGNED BY R. HARRIS		XREFS: TB-BID.dwg		10 0 10 20 30		SCALE IN FEET	
DRAWN BY E. ARNTZ				JOB NUMBER 1199-336		DATE 2011	
REVIEWED BY B. MOORE				ACAD FILE: North_West_C.dwg			
COPYRIGHT 2011 BY ANDERSON-PERRY & ASSOC., INC.							

RECORD DRAWINGS
 These record drawings have been prepared, in part, on the basis of information compiled and furnished by others. They may contain some discrepancies and omissions, and do not necessarily represent "exact" field conditions. The Owner and the Engineer accept no responsibility for their accuracy.

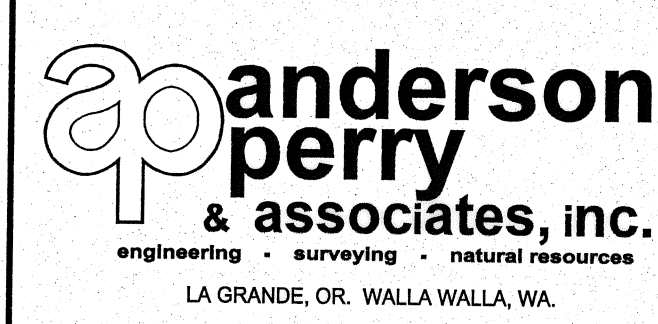

BENTON IRRIGATION DISTRICT
 IRRIGATION SYSTEM IMPROVEMENTS
 PHASE 2C
 HIGHLAND EXT. ROAD PIPING
 STA. 1+00 TO STA. 4+40

SHEET
16