


RECORD DRAWINGS		BY	B.M.	DATE	5/12
DESIGNED BY	R. HARRIS	XREFS:	TB-BID.dwg		
DRAWN BY	E. ARNTZ	JOB NUMBER	1199-336	DATE	2011
REVIEWED BY	B. MOORE	ACAD FILE:	North_West _B.dwg		
COPYRIGHT 2011 BY ANDERSON-PERRY & ASSOC., INC.					

**RECORD DRAWINGS**  
 These record drawings have been prepared, in part, on the basis of information compiled and furnished by others. They may contain some discrepancies and omissions, and do not necessarily represent "exact" field conditions. The Owner and the Engineer accept no responsibility for their accuracy.

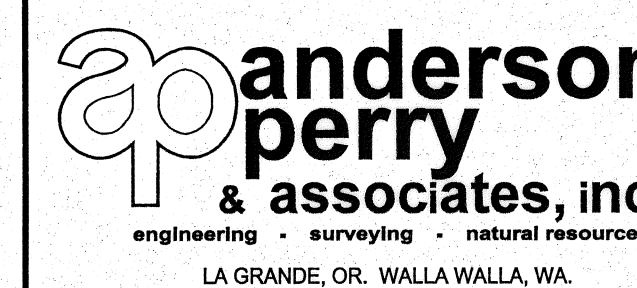

**BENTON IRRIGATION DISTRICT**  
 IRRIGATION SYSTEM IMPROVEMENTS  
 PHASE 2C

EAST ROZA TO KNOX ROAD PIPING  
 STA. 1+00 TO STA. 4+70

SHEET

19

ARCHIVED

C:\BENTON.LD\1199\_336\_PRESSURE\_IRRIGATION\PHASE\_2\North\_West\_B.dwg North West 25 7/20/2012 10:56:24 AM