
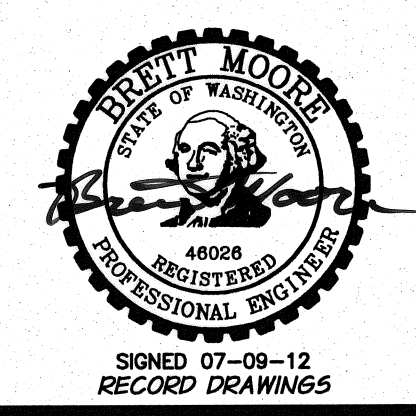
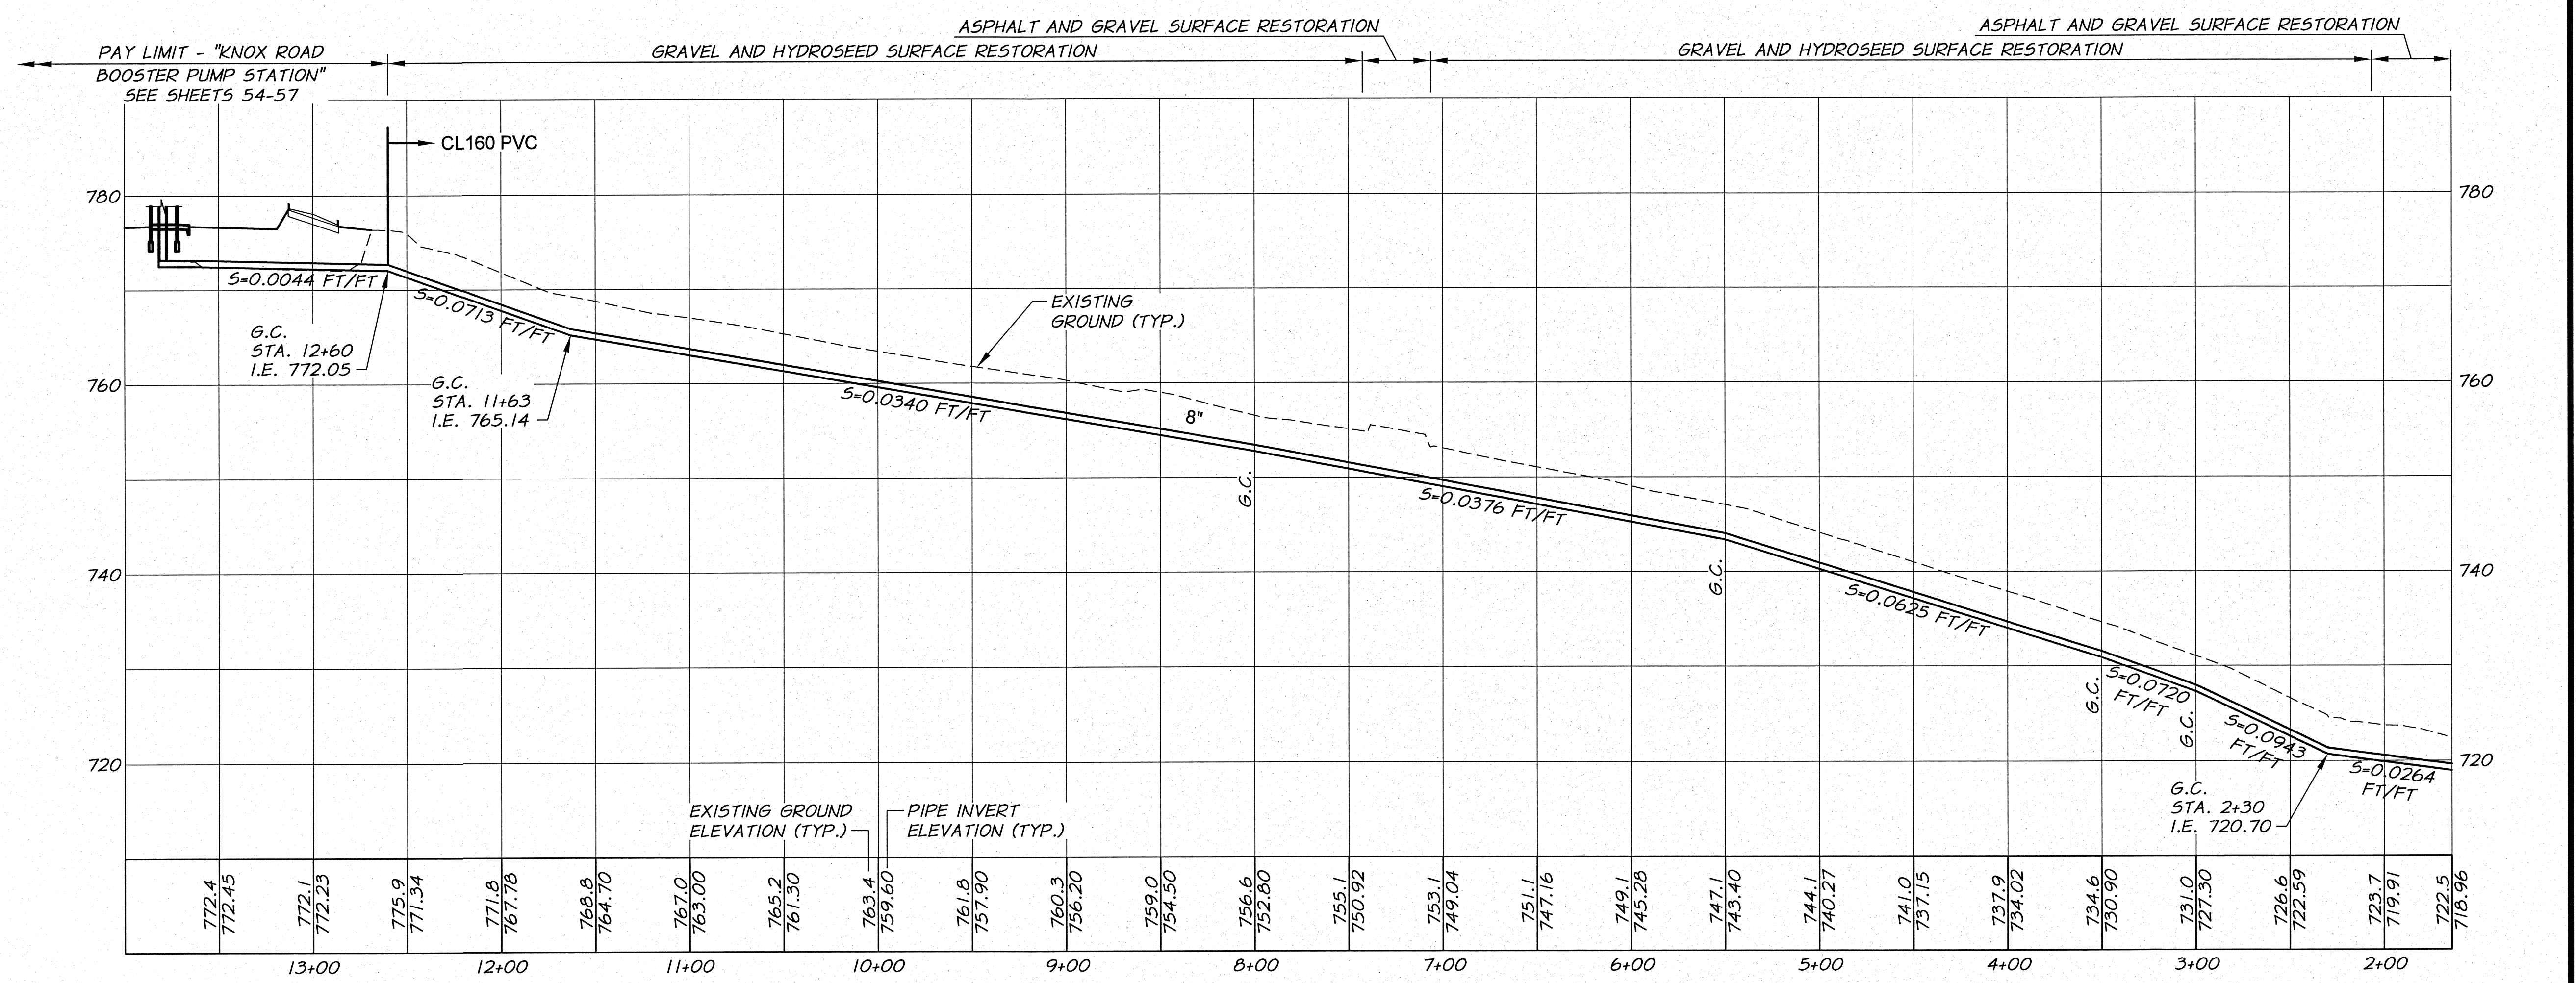



WORK ITEMS

- (A) EXISTING IRRIGATION LINE ALONG OR CROSSING ALIGNMENT. EXACT LOCATION UNKNOWN. REMOVE AND PLUG AS REQUIRED FOR NEW LINE INSTALLATION.
- (C) EXISTING IRRIGATION LINE ALONG ALIGNMENT TO BE ABANDONED. REMOVE AND PLUG AS REQUIRED FOR NEW LINE INSTALLATION.

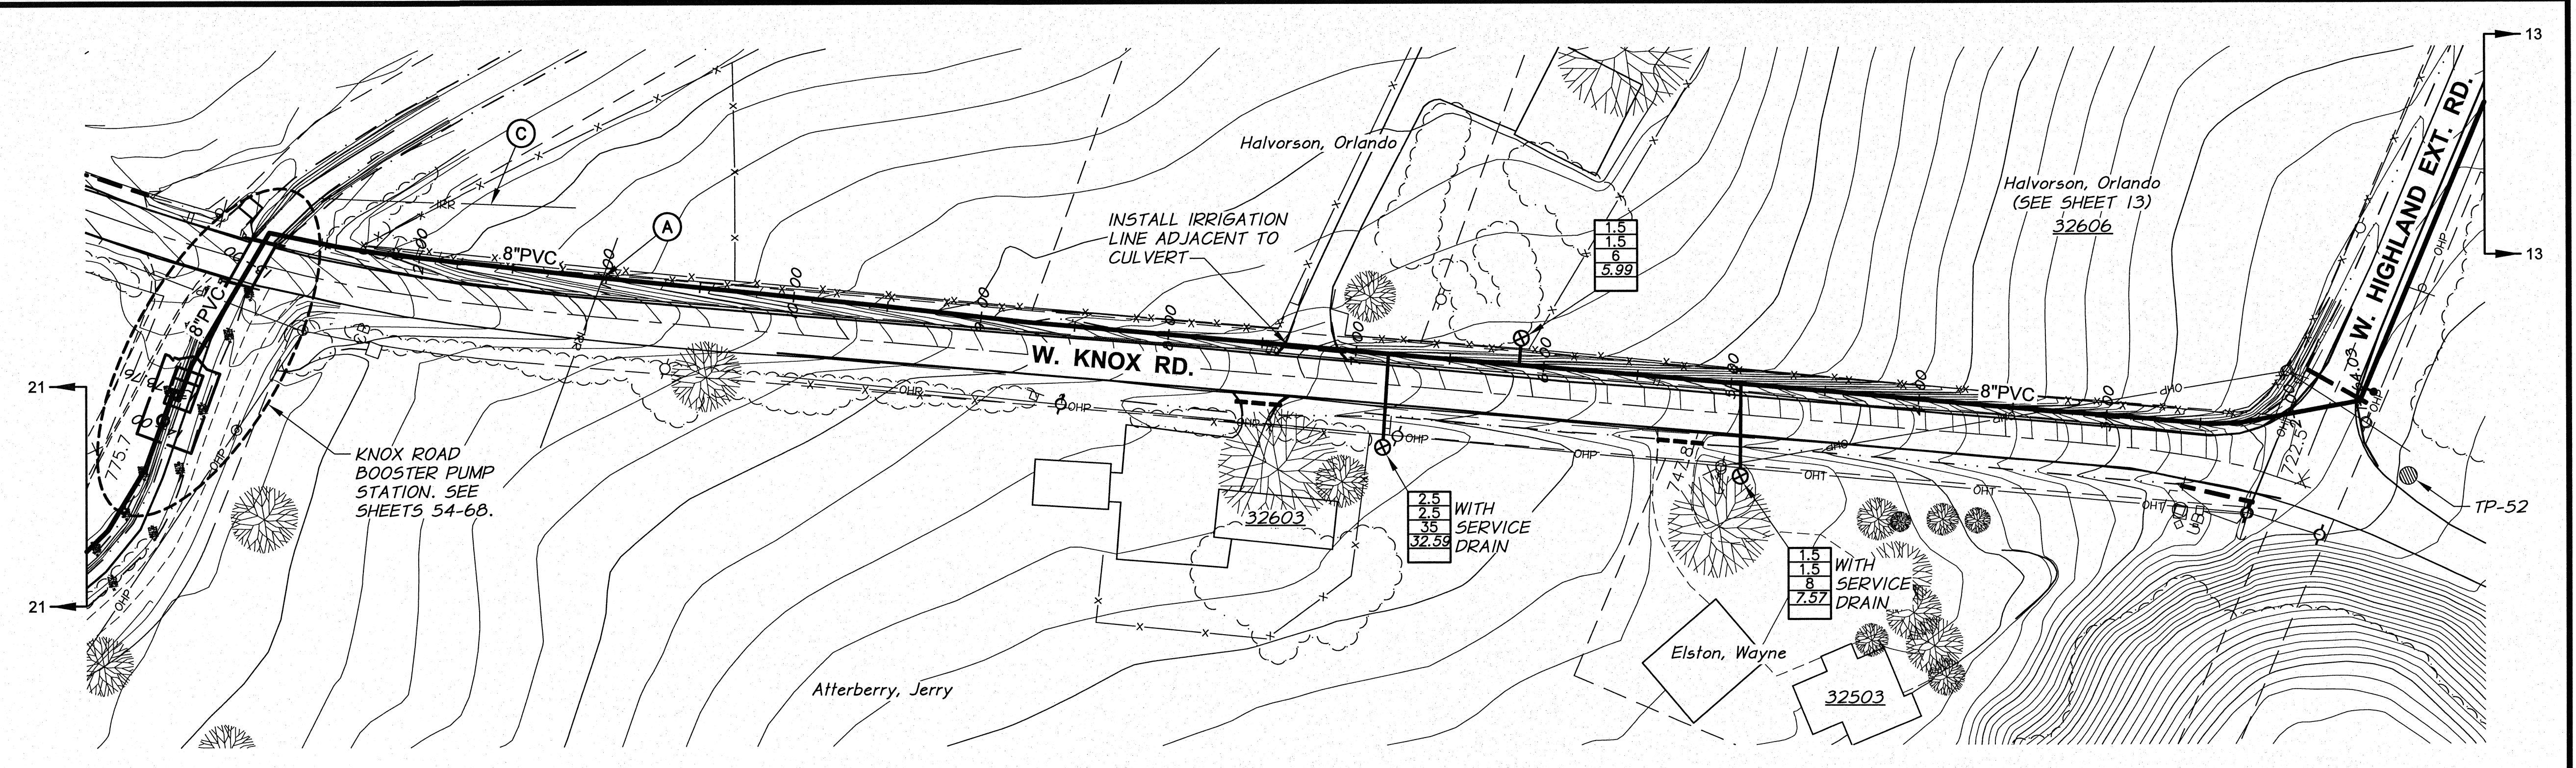

DESIGNED BY R. HARRIS	DATE	HORIZ. SCALE 1" = 50'	VERT. SCALE 1" = 10'
DRAWN BY E. ARNTZ	DATE	JOB NUMBER 1199-336	DATE
REVIEWED BY B. MOORE	DATE	ACAD FILE North_West_C.dwg	DATE
COPYRIGHT 2011 BY ANDERSON-PERRY & ASSOC., INC.			

RECORD DRAWINGS
These record drawings have been prepared, in part, on the basis of information compiled and furnished by others. They may contain some discrepancies and omissions, and do not necessarily represent "exact" field conditions. The Owner and the Engineer accept no responsibility for their accuracy.

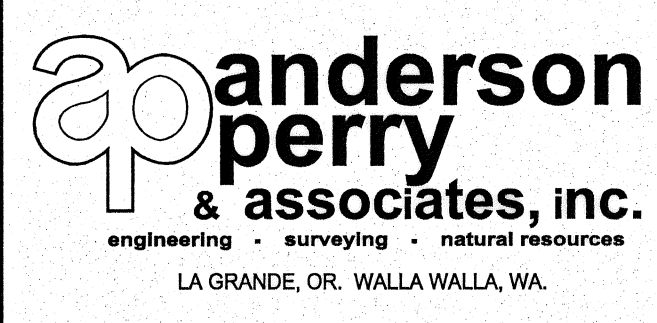

BENTON IRRIGATION DISTRICT
IRRIGATION SYSTEM IMPROVEMENTS
PHASE 2C
KNOX ROAD TO RAYHILL ROAD PIPING
STA. 1+64 TO KNOX ROAD PUMP STATION