


DESIGNED BY	R. HARRIS	DATE	2011
DRAWN BY	E. ARNTZ	JOB NUMBER	1199-336
REVIEWED BY	B. MOORE	ACAD FILE	North_West _C.dwg
XREFs: TB-BID.dwg			
COPYRIGHT 2011 BY ANDERSON-PERRY & ASSOC., INC.			

**RECORD DRAWINGS**  
 These record drawings have been prepared, in part, on the basis of information compiled and furnished by others. They may contain some discrepancies and omissions, and do not necessarily represent "exact" field conditions. The Owner and the Engineer accept no responsibility for their accuracy.

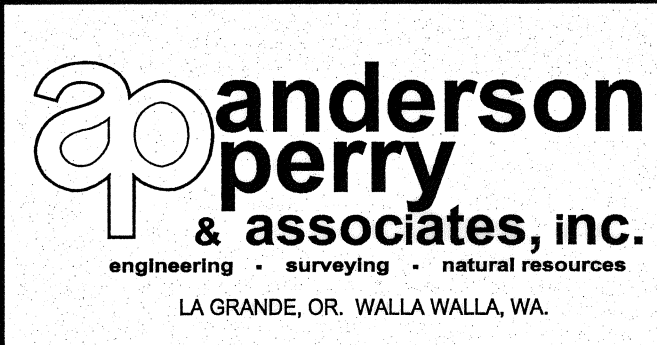

**BENTON IRRIGATION DISTRICT**  
 IRRIGATION SYSTEM IMPROVEMENTS  
 PHASE 2C  
 KNOX ROAD TO RAYHILL ROAD PIPING  
 STA. 24+00 TO STA. 33+00