


DESIGNED BY	R. HARRIS	XREFs: TB-BID.dwg
DRAWN BY	E. ARNTZ	
REVIEWED BY	B. MOORE	

REVISION	BY	DATE	HORIZ. SCALE 1"=50'	VERT. SCALE 1"=10'
			JOB NUMBER 1199-336	DATE 2011
			ACAD FILE: North_West _C.dwg	
COPYRIGHT 2011 BY ANDERSON-PERRY & ASSOC., INC.				

RECORD DRAWINGS
 These record drawings have been prepared, in part, on the basis of information compiled and furnished by others. They may contain some discrepancies and omissions, and do not necessarily represent "exact" field conditions. The Owner and the Engineer accept no responsibility for their accuracy.

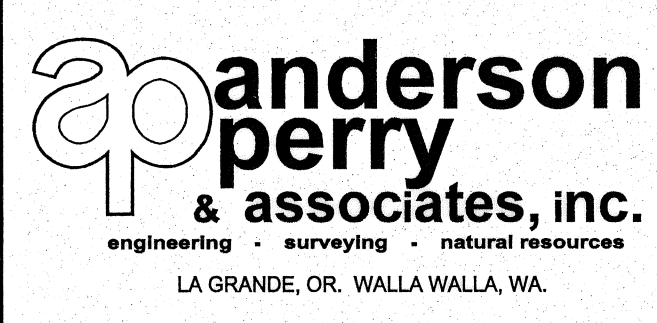

BENTON IRRIGATION DISTRICT
 IRRIGATION SYSTEM IMPROVEMENTS
 PHASE 2C
 KNOX ROAD TO RAYHILL ROAD PIPING
 STA. 33+00 TO STA. 44+00