
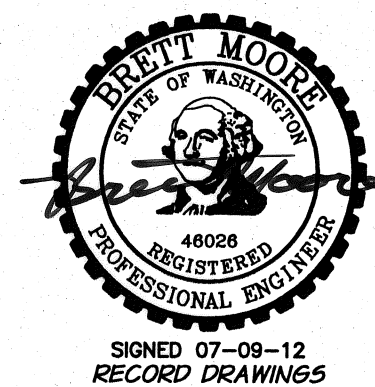
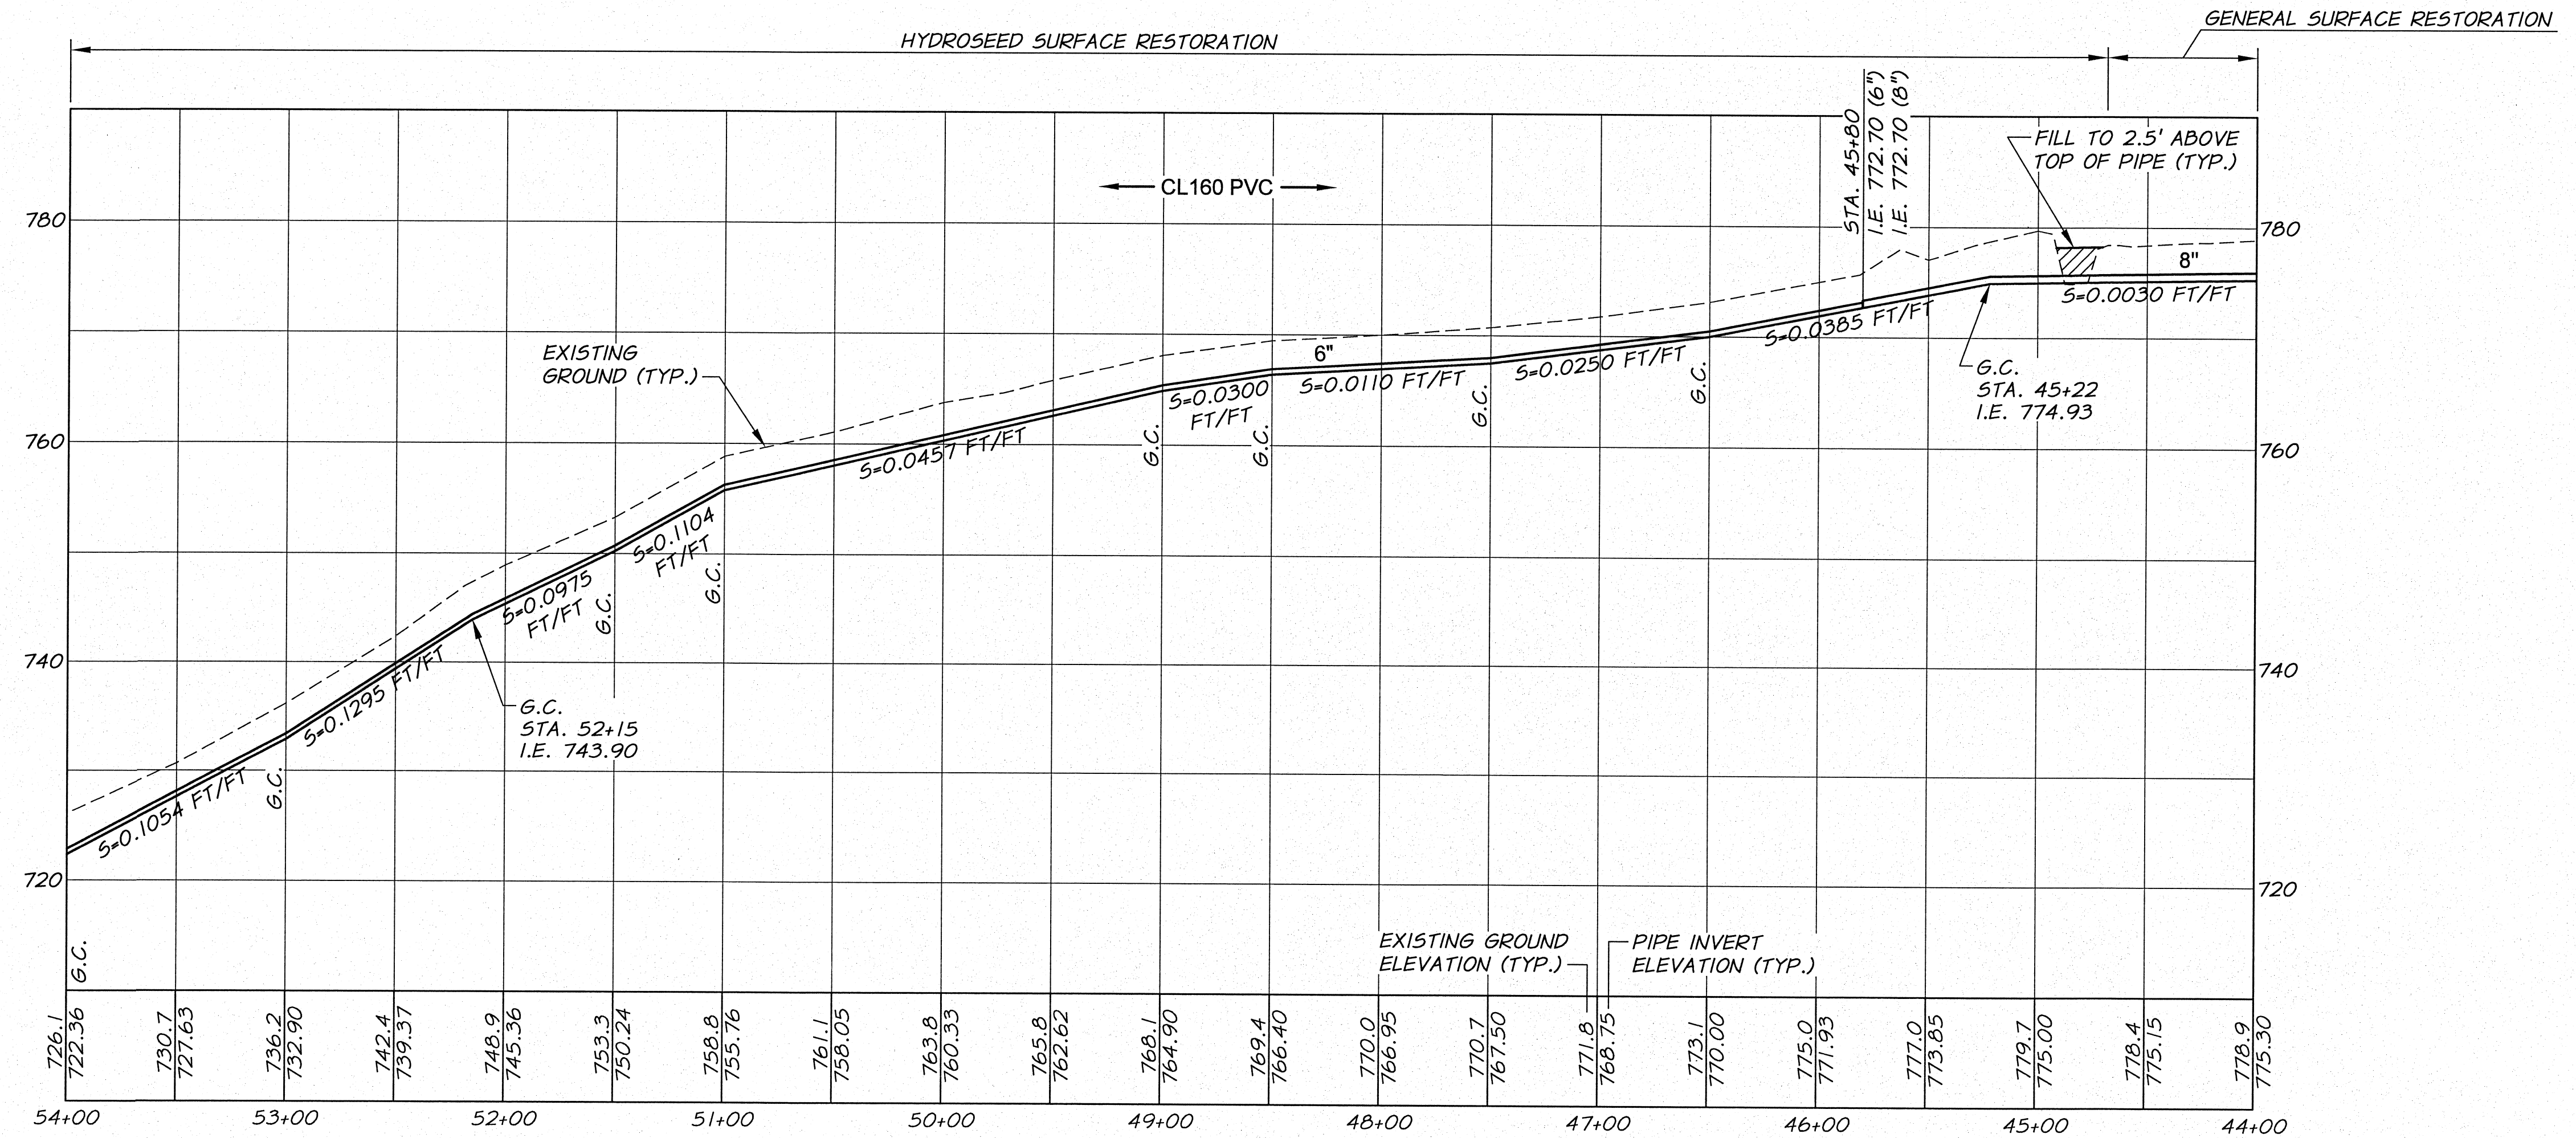


**WORK ITEMS**

- ① REMOVE CONTROL GATE, PIPING, AND CONCRETE STRUCTURE FROM CANAL OUTLET. RESTORE CANAL BANK WITH COMPACTED GENERAL BACKFILL MATERIAL. SHAPE BANK TO MATCH EXISTING.

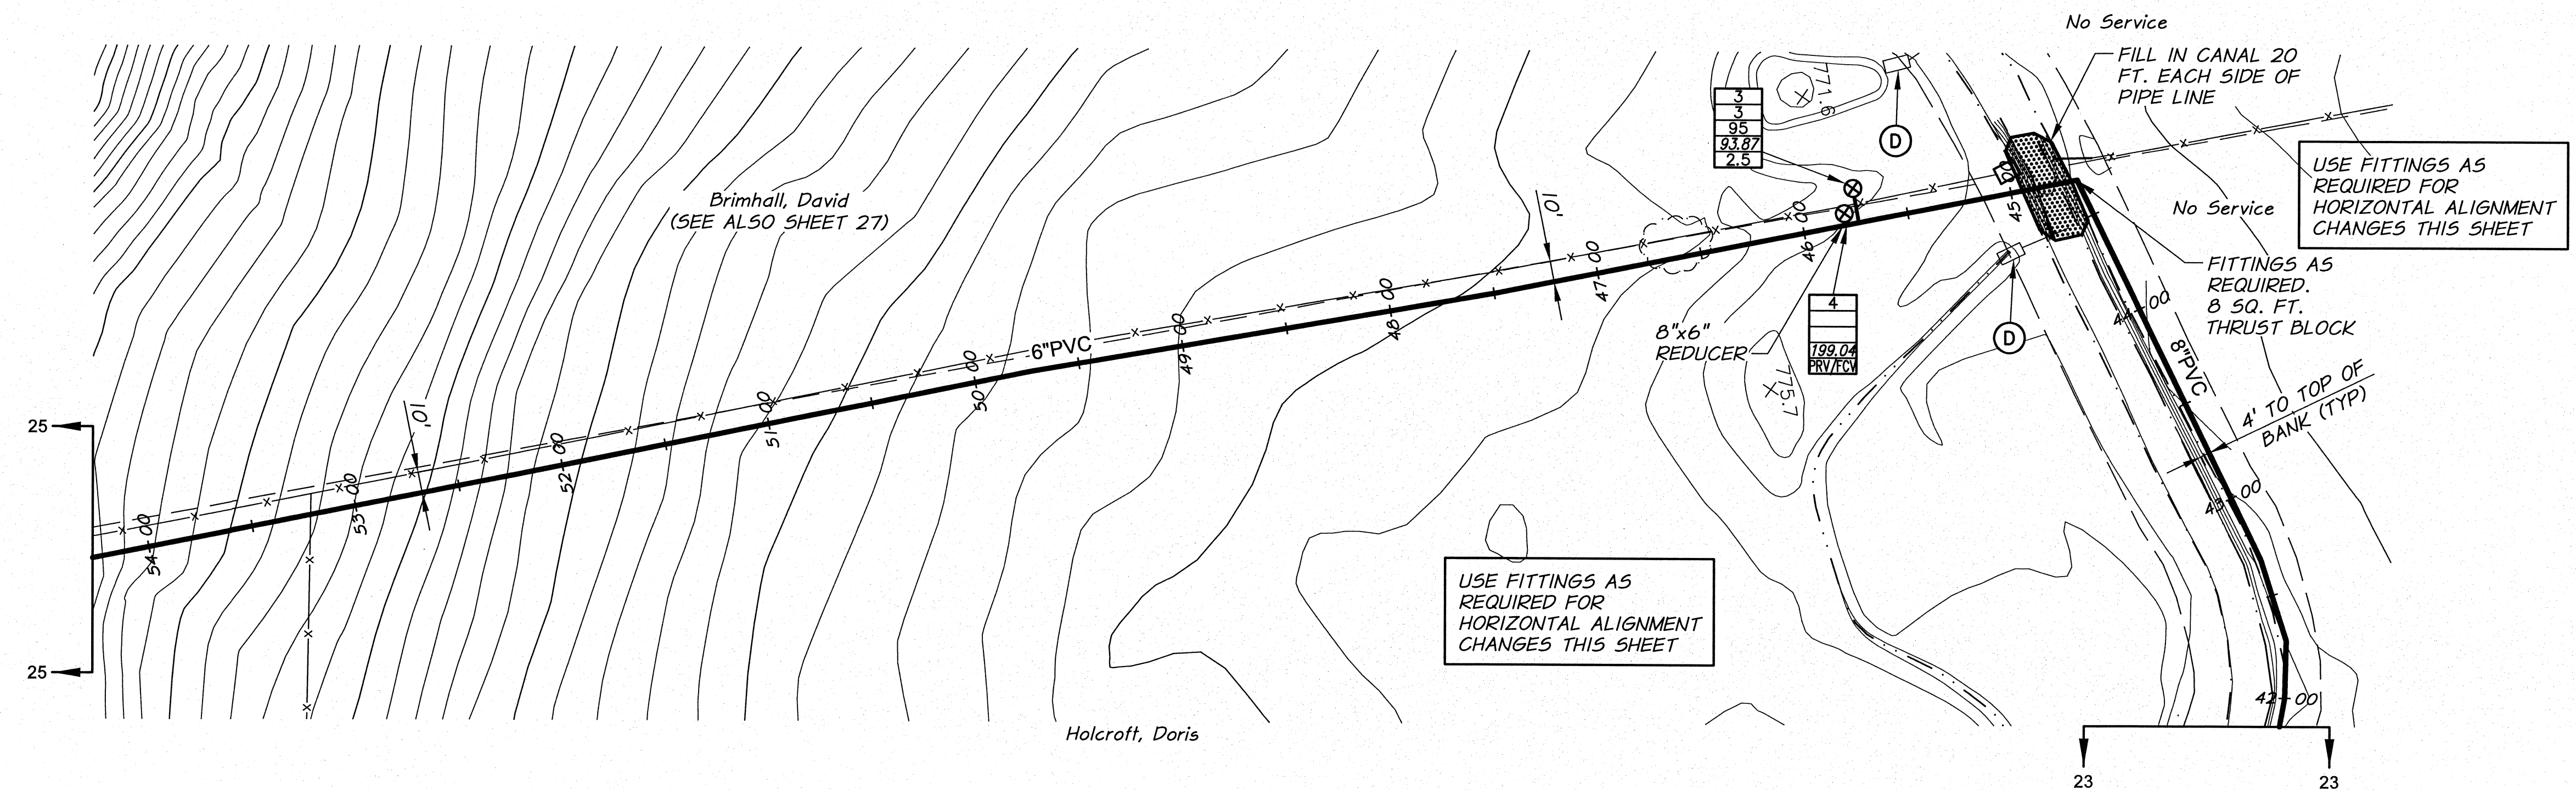


SIGNED 07-09-12  
RECORD DRAWINGS

|             |           |      |      |
|-------------|-----------|------|------|
| DESIGNED BY | R. HARRIS | DATE |      |
| DRAWN BY    | E. ARNTZ  | DATE | 2011 |
| REVIEWED BY | B. MOORE  | DATE |      |

|   |                  |
|---|------------------|
| JOB NUMBER                                      | 1199-336         |
| ACAD FILE                                       | North_West_E.dwg |
| COPYRIGHT 2011 BY ANDERSON-PERRY & ASSOC., INC. |                  |

**RECORD DRAWINGS**

These record drawings have been prepared, in part, on the basis of information compiled and furnished by others. They may contain some discrepancies and omissions, and do not necessarily represent "exact" field conditions. The Owner and the Engineer accept no responsibility for their accuracy.

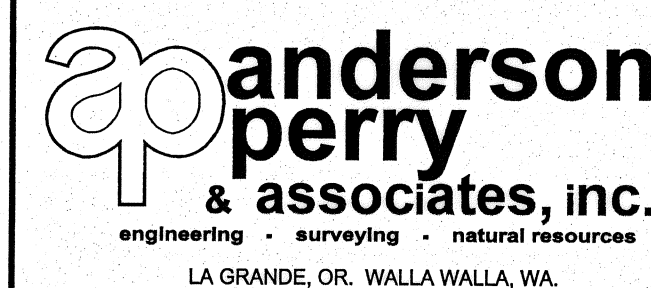

**BENTON IRRIGATION DISTRICT  
IRRIGATION SYSTEM IMPROVEMENTS  
PHASE 2C**

KNOX ROAD TO RAYHILL ROAD PIPING  
STA. 44+00 TO STA. 54+00

SHEET

**24**

ARCHIVED