


DESIGNED BY	R. HARRIS	DATE	2011
DRAWN BY	E. ARNTZ	DATE	2011
REVIEWED BY	B. MOORE	DATE	2011

XREFs: TB-BID.dwg  
 JOB NUMBER: 1199-336  
 ACAD FILE: North\_West\_E.dwg  
 COPYRIGHT 2011 BY ANDERSON-PERRY & ASSOC., INC.

**RECORD DRAWINGS**

These record drawings have been prepared, in part, on the basis of information compiled and furnished by others. They may contain some discrepancies and omissions, and do not necessarily represent "exact" field conditions. The Owner and the Engineer accept no responsibility for their accuracy.

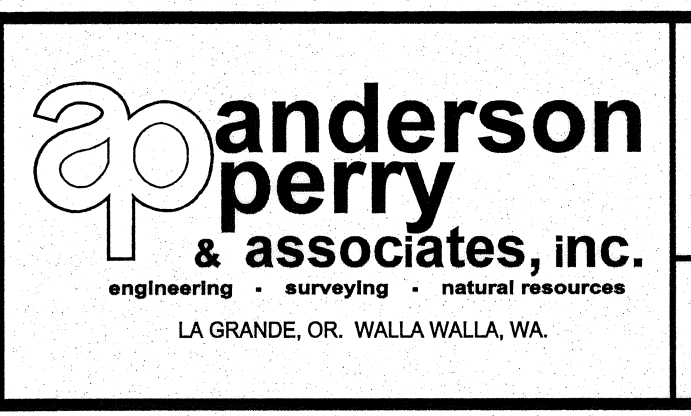

**BENTON IRRIGATION DISTRICT**  
 IRRIGATION SYSTEM IMPROVEMENTS  
 PHASE 2C

KNOX ROAD TO RAYHILL ROAD PIPING  
 STA. 54+00 TO STA. 65+00