


DESIGNED BY	R. HARRIS	DATE	
DRAWN BY	E. ARNTZ	DATE	2011
REVIEWED BY	B. MOORE	DATE	

HORIZ. SCALE	1" = 50'	VERT. SCALE	1" = 10'
JOB NUMBER	1199-336	DATE	2011
ACAD FILE	North_West_E.dwg		
COPYRIGHT 2011 BY ANDERSON-PERRY & ASSOC., INC.			

RECORD DRAWINGS
 These record drawings have been prepared, in part, on the basis of information compiled and furnished by others. They may contain some discrepancies and omissions, and do not necessarily represent "exact" field conditions. The Owner and the Engineer accept no responsibility for their accuracy.

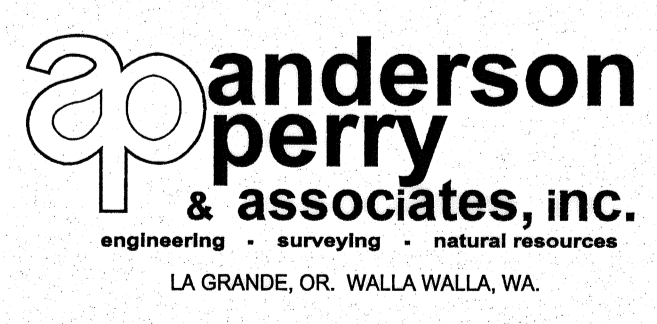

BENTON IRRIGATION DISTRICT
 IRRIGATION SYSTEM IMPROVEMENTS
 PHASE 2C
 KNOX ROAD TO RAYHILL ROAD PIPING
 STA. 65+00 TO STA. 75+00