

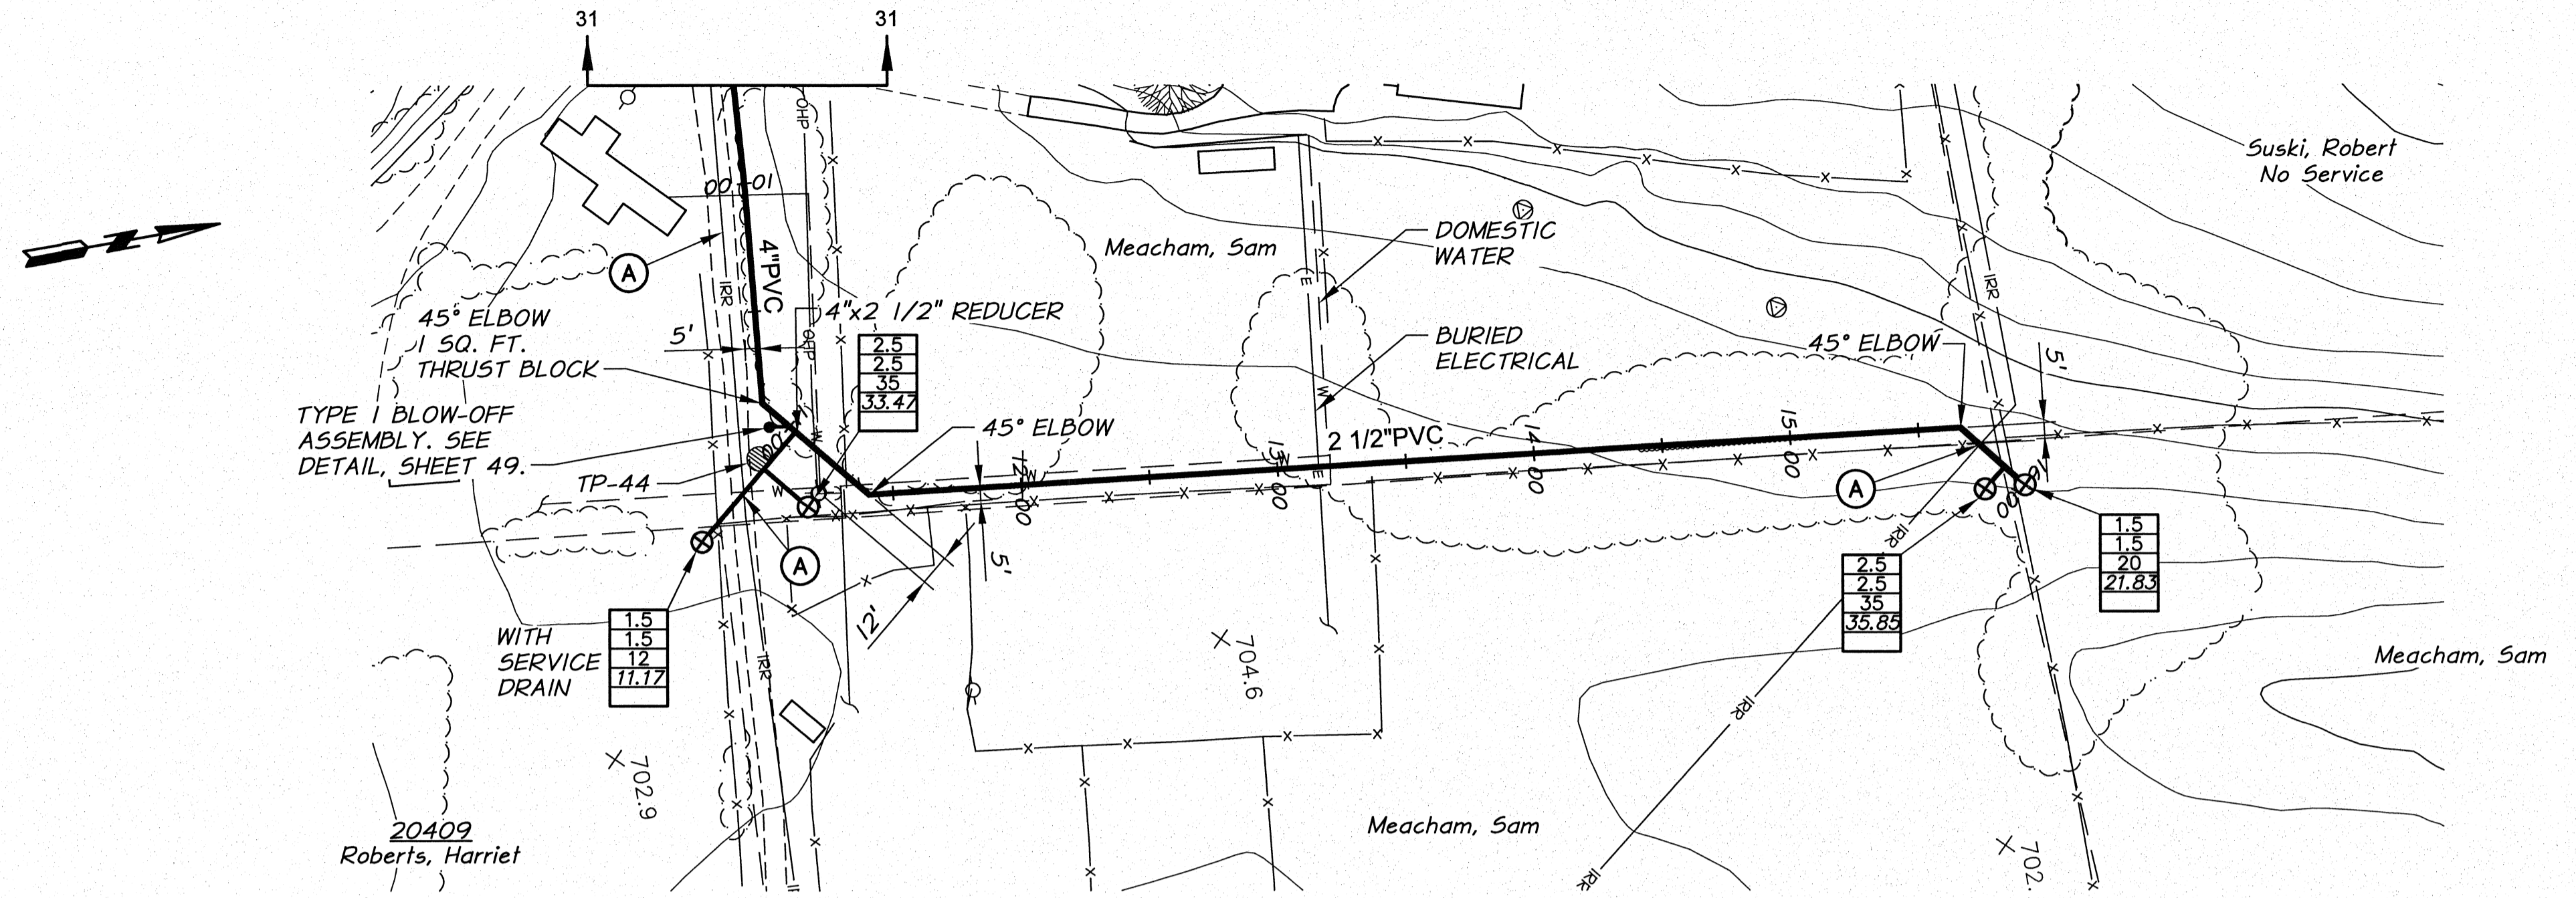


WORK ITEMS

- (A) EXISTING IRRIGATION LINE ALONG OR CROSSING ALIGNMENT. EXACT LOCATION UNKNOWN. REMOVE AND PLUG AS REQUIRED FOR NEW LINE INSTALLATION.

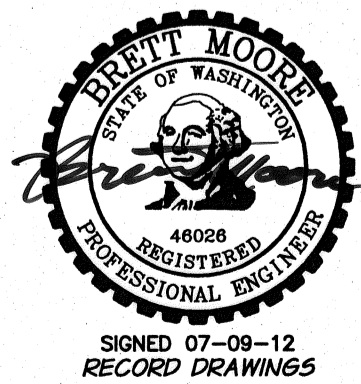

GRAVEL AND HYDROSEED SURFACE RESTORATION

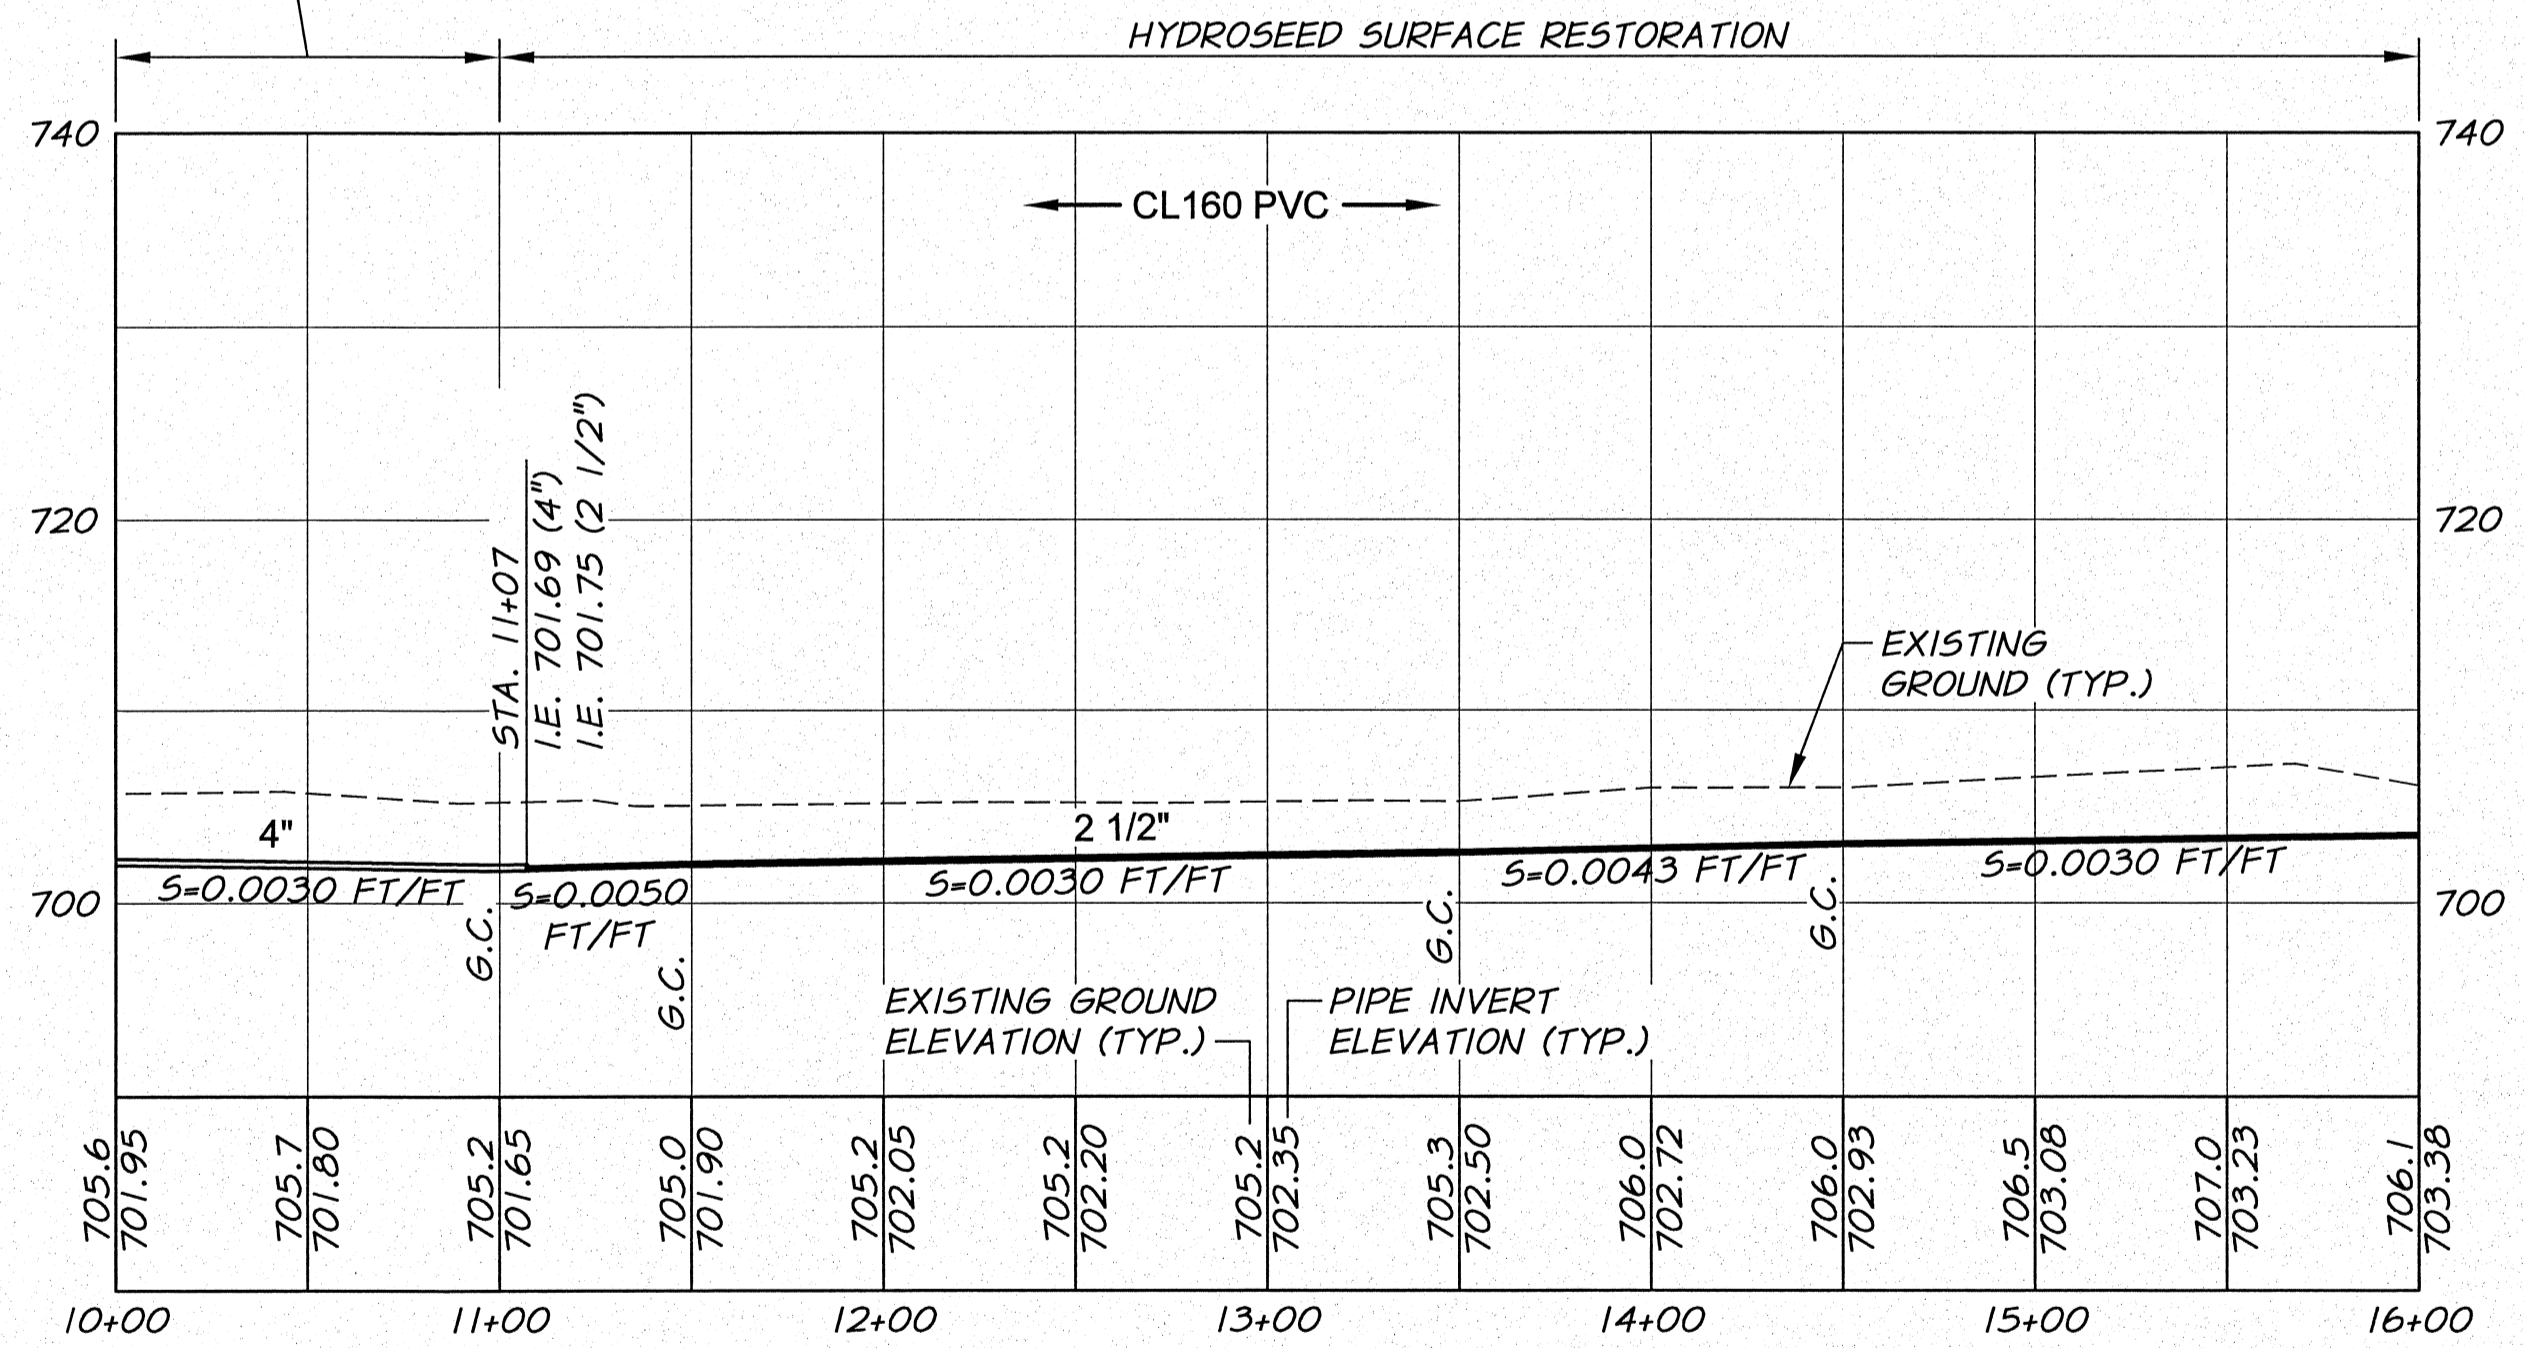


DESIGNED BY	R. HARRIS	XREFS: TB-BID.dwg
DRAWN BY	E. ARNTZ	
REVIEWED BY	B. MOORE	

HORIZ. SCALE	1"=50'	VERT. SCALE	1"=10'
JOB NUMBER	1199-336	DATE	2011
ACAD FILE:	North_West_B.dwg		
COPYRIGHT 2011 BY ANDERSON-PERRY & ASSOC., INC.			

RECORD DRAWINGS

These record drawings have been prepared, in part, on the basis of information compiled and furnished by others. They may contain some discrepancies and omissions, and do not necessarily represent "exact" field conditions. The Owner and the Engineer accept no responsibility for their accuracy.

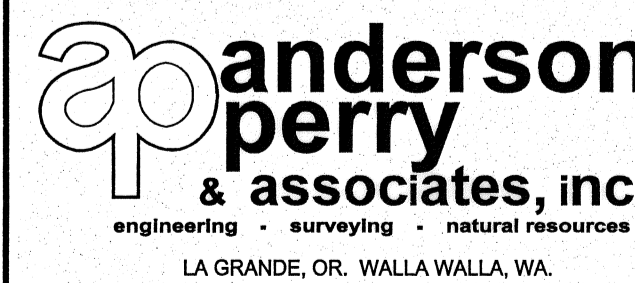

**BENTON IRRIGATION DISTRICT
IRRIGATION SYSTEM IMPROVEMENTS
PHASE 2C**

**WEST MEACHAM PIPING
STA. 10+00 TO STA. 15+68**

SHEET

32