


BENTON IRRIGATION DISTRICT

IRRIGATION SYSTEM IMPROVEMENTS


PHASE 3A

2011

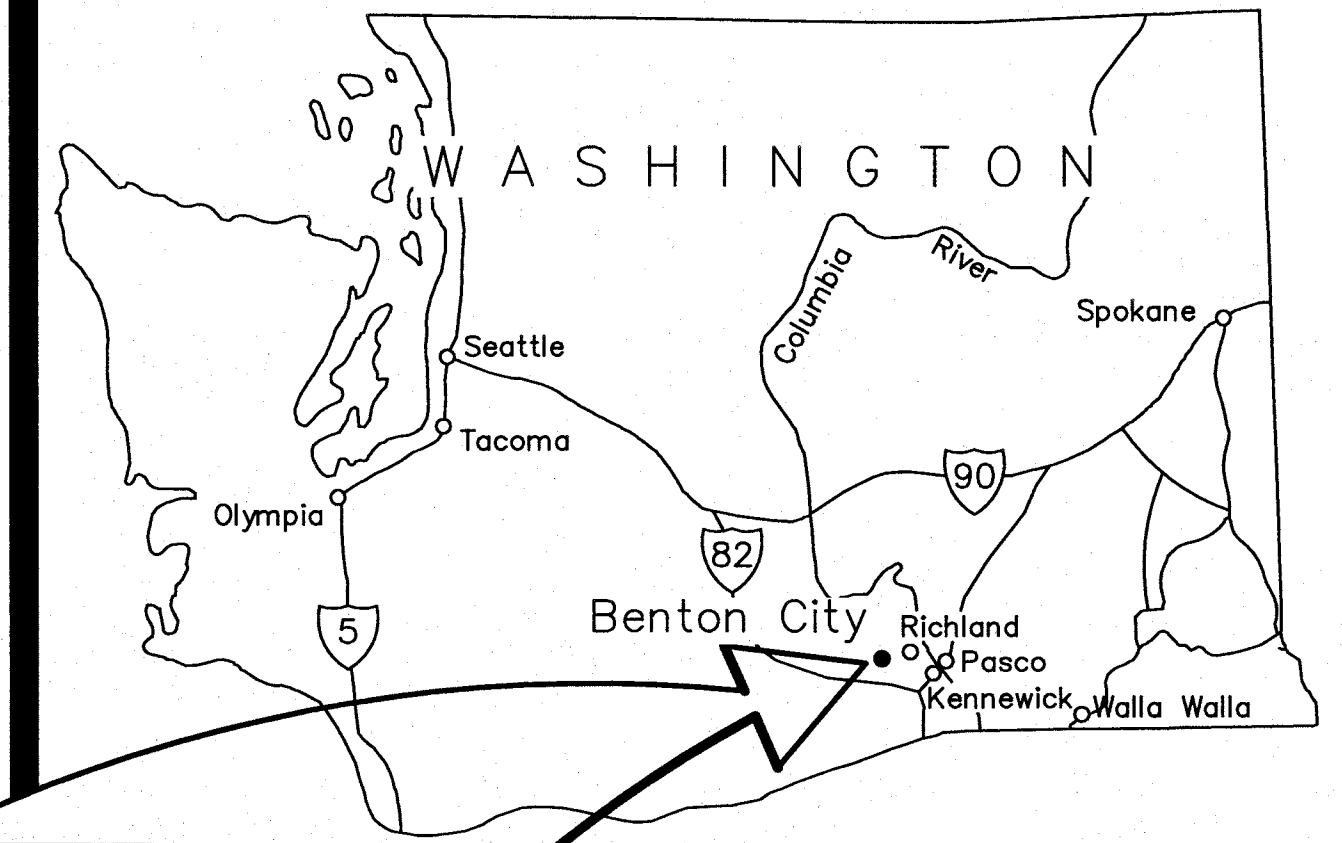


INDEX

- COVER
- 1 LEGEND, NOTES, AND QUANTITIES
- 2 SHEET INDEX
- HIGHLAND RD. TO KENDALL RD. PIPING**
- 3 EXISTING MAIN LINE SERVICES
- 4 LINE A STA. 1+00 TO STA. 23+00 AND LINE B
- 5 LINE A STA. 23+00 TO STA. 40+00
- 6 LINE A STA. 40+00 TO STA. 55+30 AND LINE C
- 7 LINE D STA. 1+00 TO STA. 7+43
- KENDALL RD. SOUTH PIPING**
- 8 LINE E STA. 1+00 TO 7+00 AND LINE F STA. 1+00 TO 11+00
- 9 LINE E STA. 7+00 TO STA. 23+21
- 10 LINE F STA. 11+00 TO STA. 20+56
- O.I.E. HIGHWAY PIPING**
- 11 LINE G STA. 1+00 TO 12+00 AND LINE H
- 12 LINE G STA. 12+00 TO 19+13 AND LINES J, K, L, M, AND R
- KENDALL RD. NORTH PIPING**
- 13 LINE N, LINE S, AND LINE Q
- DETAILS**
- 14 PIPE CONNECTION DETAILS I
- 15 PIPE CONNECTION DETAILS II
- 16 SERVICE DETAILS I
- 17 SERVICE DETAILS II
- 18 SERVICE DETAILS III
- 19 SERVICE DETAILS IV
- 20 SERVICE DETAILS V
- 21 VALVE VAULT DETAILS I
- 22 VALVE VAULT DETAILS II
- 23 VALVE VAULT DETAILS III
- 24 VALVE STATION DETAILS I
- 25 VALVE STATION DETAILS II
- 26 MISCELLANEOUS DETAILS I
- 27 MISCELLANEOUS DETAILS II
- 28 MISCELLANEOUS DETAILS III
- △ 28A MISCELLANEOUS DETAILS IV
- 29 TRENCH DETAILS
- 30 THRUST BLOCK DETAILS

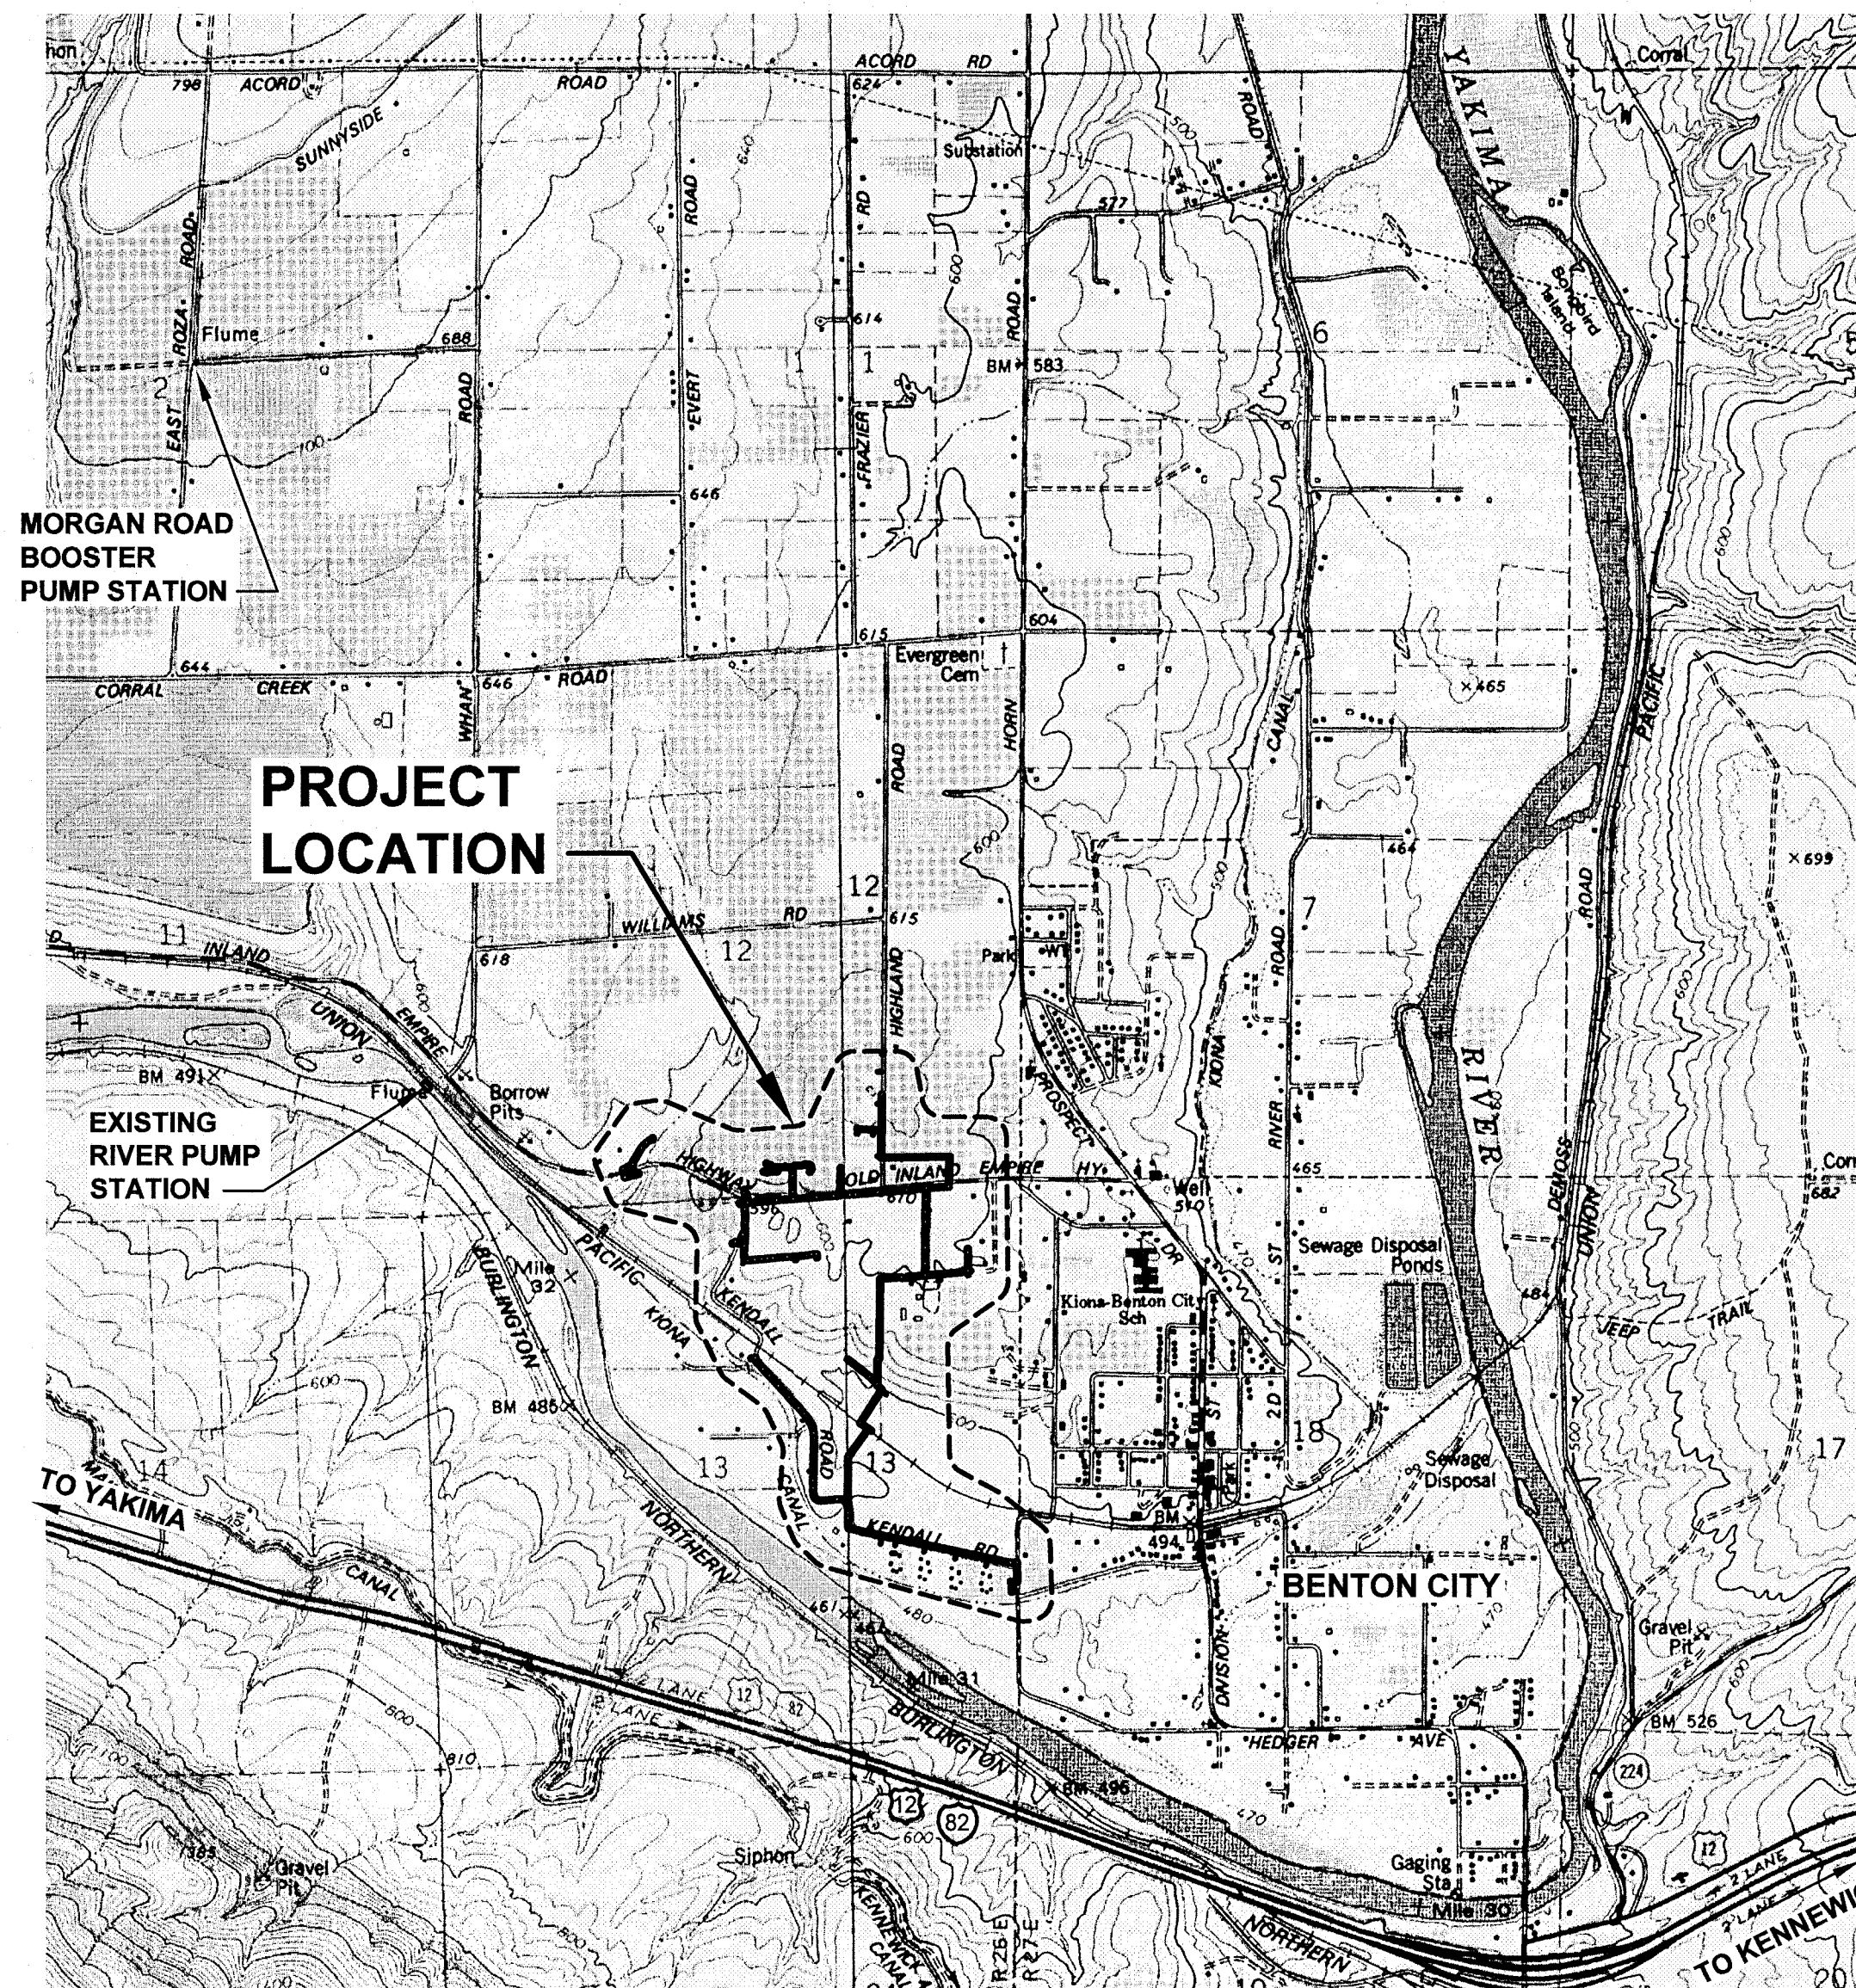

VICINITY MAP
NTS

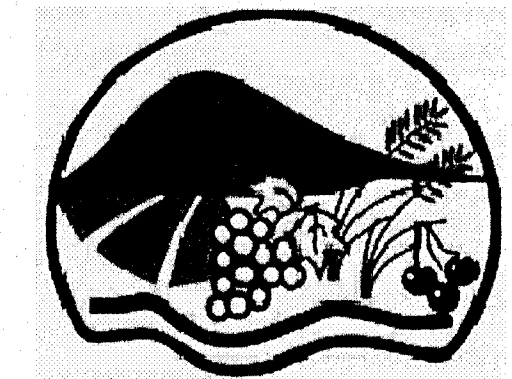


DISTRICT BOARD OF DIRECTORS

MELISSA GLODO
ROBERT BUOY
DIRK MARTIN

RECORD DRAWINGS

These record drawings have been prepared, in part, on the basis of information compiled and furnished by others. They may contain some discrepancies and omissions, and do not necessarily represent "exact" field conditions. The Owner and the Engineer accept no responsibility for their accuracy.

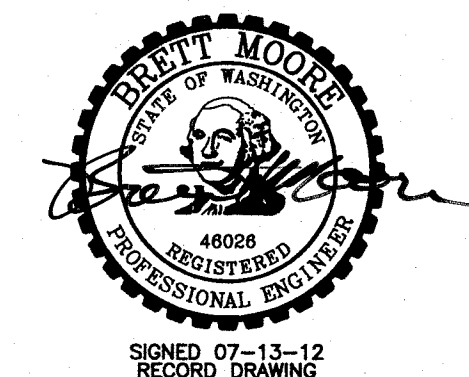


anderson perry
& associates, inc.

engineering • surveying • natural resources
1901 N. Fir Street - La Grande, OR 97850 Ph: (541)963-8309 Fax: (541)963-5456
LA GRANDE, OR WALLA WALLA, WA

PLAN LEGEND

IRRIGATION	
EXISTING	PROPOSED
IRRIGATION LINE — IRR —	6" PVC —
VALVE \bowtie	\bowtie
CAP [[
COUPLING $\#$	$\#$
REDUCER \triangleright	\blacktriangleright
AIR/VAC VALVE \uparrow	\uparrow
BLOW OFF ASSEMBLY \odot	\odot
SERVICE —	\odot
IRRIGATION CONTROL STRUCTURE — IRR — IRR —	
SPRINKLER HEAD \odot	

SITE SURVEY	
EXISTING	
INDEX CONTOUR — 750 —	
INTERMEDIATE CONTOUR — 749 —	
CENTERLINE — — —	
PROPERTY LINE/EASEMENT - - - - -	
SECTION LINE - - - - -	
CULVERT [- - - - -]	
BENCH MARK \oplus	
MONUMENT \triangle	
CONTROL POINT \odot	
TEST PIT (SEE CONTRACT DOCUMENT APPENDIX FOR LOGS) \odot TP-14	
SPOT ELEVATION 592.3 X	

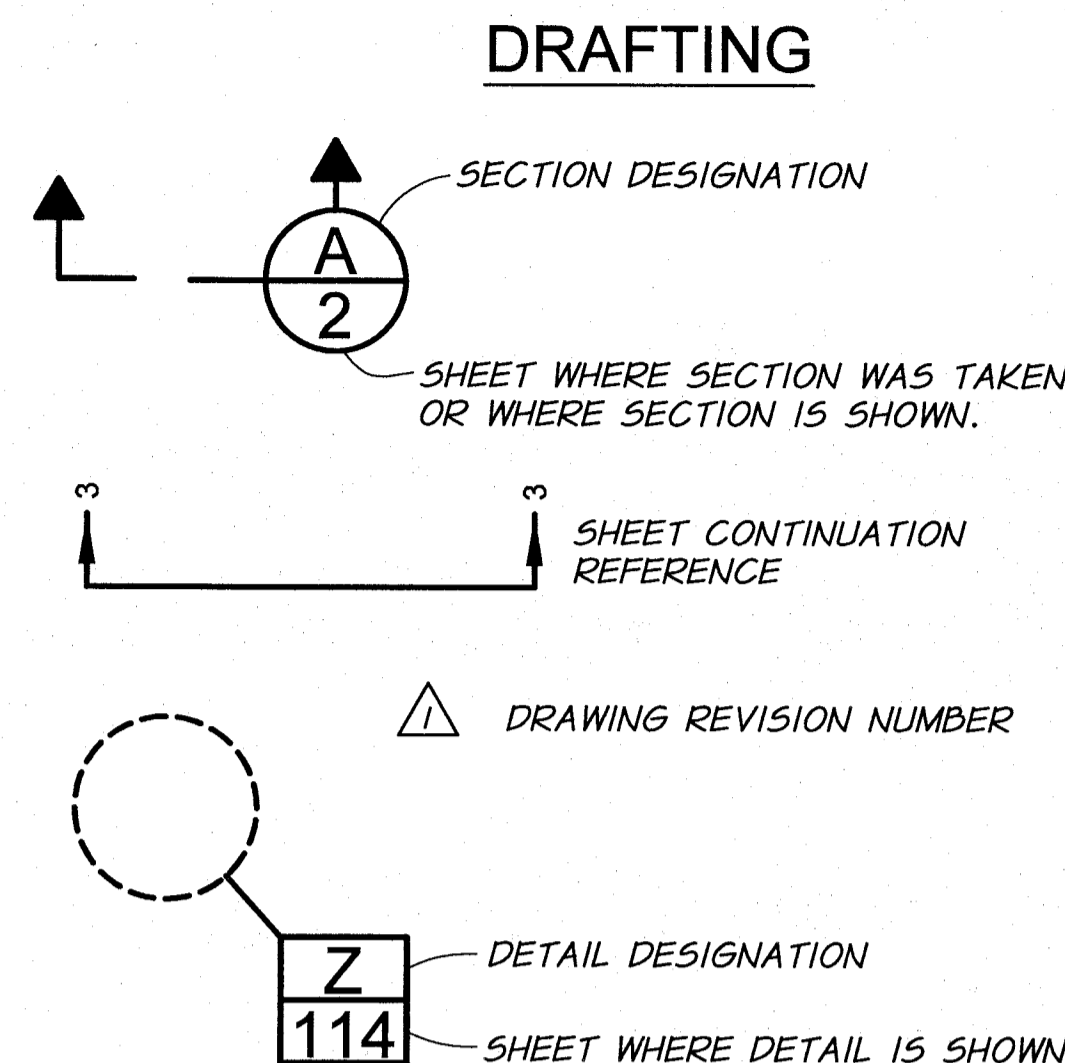


MISCELLANEOUS UTILITIES

EXISTING	
WATER LINE — W — W —	
BURIED POWER — P — P — P —	
OVERHEAD POWER — OHP — OHP —	
BURIED TELEPHONE — UT —	
FIBER OPTIC — FO —	
GAS SERVICE — G — G —	
SIGNAL CABLE IN CONDUIT — SC —	
UTILITY POLE \odot	
GUY WIRE \curvearrowright	
TELEPHONE RISER \diamond	
STREET LIGHT \odot	

GENERAL	
EXISTING	
FENCE LINE/GATE — X — X — X —	
CHAINLINK FENCE — — — — —	
CREEK/DITCH CENTERLINE — — — — —	
RIVERBANK/ShORELINE \blacktriangleright	
SIGN \square	
CONIFER TREE \star	
DECIDUOUS TREE \odot	
SHRUB \odot	
BUILDING \square	

STREET AND CURB

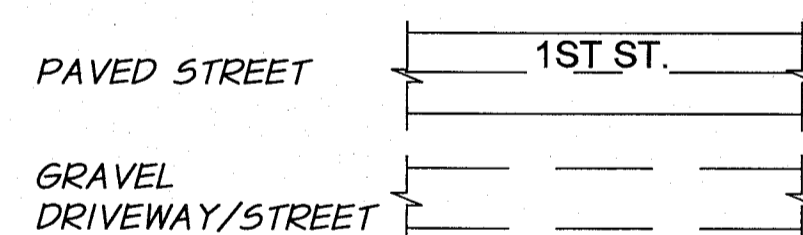

1.5	SERVICE LINE SIZE (INCHES)
1	DOLE CONTROL VALVE SIZE (INCHES)
3.03	DOLE CONTROL VALVE FLOW RATE (GPM)
1.5	CALCULATED REQUIRED FLOW (GPM)
	PRV SIZE (INCHES) OR CONTROL TYPE FOR LARGER SERVICES:
	FCV = FLOW CONTROL VALVE
	PRV/FCV = PRESSURE REDUCING AND FLOW CONTROL VALVE

NOTE: A BLANK DOLE CONTROL VALVE SIZE AND FLOW FIELD INDICATES A FLOWMETER USED. A BLANK PRV SIZE FIELD INDICATES NO PRV VALVE REQUIRED.

STANDARD RESIDENTIAL SERVICE. LINE SIZE IS 1.0 INCH, DOLE CONTROL VALVE SIZE IS 1.0 INCH WITH 6 GPM FLOW RATE. CALCULATED REQUIRED FLOW IS 5.82 GPM.



ESTIMATED QUANTITIES FOR ROCK EXCAVATION

PHASE 3A: ±300 CUBIC YARDS

NOTE: REFER TO THE SPECIFICATIONS FOR DESCRIPTION OF ROCK EXCAVATION. THE QUANTITIES SHOWN ARE ESTIMATES PREPARED BY THE ENGINEER AND ARE BASED UPON FIELD SURVEY DATA PERFORMED BY THE ENGINEER, AND THE IMPROVEMENTS SHOWN ON THE DRAWINGS. THE CONTRACTOR SHALL MAKE HIS OWN DETERMINATION OF THE ACTUAL QUANTITIES TO COMPLETE THE WORK AS SHOWN ON THE DRAWINGS AND AS SPECIFIED FOR PREPARING HIS BID FOR THE PROJECT.

CONSTRUCTION NOTES


- ALL ASPHALT RESTORATION REQUIRED WITHIN AREAS NOT SPECIFIED FOR ASPHALT RESTORATION SHALL BE COMPLETED AT THE CONTRACTOR'S EXPENSE AND AT NO COST TO THE OWNER.
- REMOVE EXISTING DRAINAGE CULVERTS TO CONSTRUCT IRRIGATION LINE. EXISTING CULVERTS TO BE REINSTALLED AFTER PIPELINE INSTALLATION IS COMPLETED. CULVERTS DAMAGED BY CONSTRUCTION TO BE REPLACED WITH NEW SAME TYPE AND SIZE AT CONTRACTOR'S EXPENSE AND AT NO COST TO THE OWNER UNLESS THE CULVERT AGE AND CONDITION ENSUED THE DAMAGE AS DETERMINED BY THE ENGINEER. THE ENGINEER MAY REQUIRE REPLACEMENT OF CULVERTS DUE TO AGE OF CULVERT AND EXISTING CONDITION. REPLACEMENT REQUIRED BY THE ENGINEER SHALL BE PAID UNDER THE "CULVERT REPLACEMENT" BID ITEM AND MUST HAVE PRIOR APPROVAL BEFORE REPLACEMENT.
- MAILBOXES, SIGNS, ETC., IN CONFLICT WITH WORK SHALL BE TEMPORARILY RELOCATED, AS REQUIRED BY THE ENGINEER, AND REINSTALLED TO THE ORIGINAL LOCATION AFTER THE IRRIGATION LINE IS CONSTRUCTED, UNLESS OTHERWISE DIRECTED BY THE ENGINEER. DAMAGED MAILBOXES, SIGNS, POSTS, ETC., CAUSED BY THE CONSTRUCTION SHALL BE REPLACED WITH NEW LIKE KIND AS REQUIRED BY THE ENGINEER AT THE CONTRACTOR'S EXPENSE AND AT NO COST TO THE OWNER UNLESS THE AGE AND CONDITION ENSUED THE DAMAGE AS DETERMINED BY THE ENGINEER. THE ENGINEER MAY REQUIRE REPLACEMENT OF POST DUE TO AGE OF POST AND EXISTING CONDITION. REPLACEMENT REQUIRED BY THE ENGINEER SHALL BE PAID UNDER THE "POST REPLACEMENT" BID ITEM.
- REMOVE EXISTING FENCING TO CONSTRUCT IRRIGATION LINES AS REQUIRED. EXISTING FENCING TO BE REINSTALLED TO THE SATISFACTION OF THE PROPERTY OWNERS AFTER PIPELINE INSTALLATION IS COMPLETED. FENCING DAMAGED BY CONSTRUCTION TO BE REPLACED WITH NEW SAME TYPE AND SIZE TO THE SATISFACTION OF THE PROPERTY OWNERS AT CONTRACTOR'S EXPENSE AND AT NO COST TO THE OWNER.
- LOCATION FOR ALL SERVICES, AIR/VAC VALVES AND BLOW OFF ASSEMBLIES TO BE FIELD VERIFIED WITH THE ENGINEER PRIOR TO CONSTRUCTION. LOW POINTS ON MAIN LINES AND HIGH POINTS ON MAIN LINES SHOWN ON THE DRAWINGS ARE APPROXIMATE. CONSTRUCT BLOW OFFS AND AIR/VAC VALVES AT CONSTRUCTED LOW POINTS AND HIGH POINTS, RESPECTIVELY.
- FOR IRRIGATION LINE CONSTRUCTION DIRECTLY ADJACENT TO ORCHARDS, THE CONTRACTOR SHALL PROTECT ORCHARD LIMBS FROM DAMAGE AS REQUIRED DURING CONSTRUCTION. COMPENSATION FOR DAMAGED TREES AND/OR LIMBS CAUSED BY THE CONTRACTOR SHALL BE AT THE CONTRACTOR'S EXPENSE AND AT NO COST TO THE OWNER. SEE TECHNICAL SPECIFICATION FOR DETAIL.
- FRONTIER UNDERGROUND FIBER OPTIC LINES ARE LOCATED WITHIN THE PROJECT. THE CONTRACTOR SHALL COORDINATE HIS WORK WITH FRONTIER PRIOR TO CONSTRUCTION. FOR NEW IRRIGATION LINES THAT WILL CROSS FIBER OPTIC LINES, THE NEW IRRIGATION LINES SHALL BE INSTALLED UNDERNEATH THE FIBER OPTIC LINES, MAINTAINING A MINIMUM OF 12 INCHES CLEARANCE. ADJUSTMENTS TO THE IRRIGATION LINE VERTICAL GRADE MAY BE REQUIRED, INCLUDING FITTINGS AS REQUIRED. THIS ADJUSTMENT SHALL BE INCIDENTAL TO THE WORK.
- EXISTING GROUND ELEVATIONS SHOWN ON THE PROFILES ARE APPROXIMATE AND MAY VARY FROM ACTUAL EXISTING GROUND ELEVATIONS ENCOUNTERED DURING CONSTRUCTION. THERE SHALL BE NO ADDITIONAL PAYMENT MADE TO THE CONTRACTOR FOR EXCAVATION AND BACKFILL VARIATIONS CAUSED BY ELEVATION OF EXISTING GROUND DIFFERENCES FROM WHAT IS SHOWN ON THE DRAWINGS.
- BOTH HORIZONTAL DEFLECTIONS AND CHANGES OF VERTICAL GRADE ARE SHOWN ON THE DRAWINGS. IN SOME LOCATIONS FITTINGS ARE CALLED FOR ON THE DRAWINGS AT HORIZONTAL DEFLECTIONS AND CHANGES IN VERTICAL GRADE, BUT NOT AT ALL LOCATIONS THAT MAY REQUIRE FITTINGS. IF PIPE JOINT DEFLECTION OR BENDING THE PIPE AS DESCRIBED AND ALLOWED IN THE TECHNICAL SPECIFICATIONS DOES NOT MAINTAIN ALIGNMENT OR GRADE, FITTINGS SHALL BE USED WITH APPROPRIATE THRUST BLOCKING AND SHALL BE INCIDENTAL TO THE PIPELINE WORK. ADDITIONALLY, THE CONTRACTOR SHALL MAINTAIN THE 2.5-FOOT MINIMUM COVER OVER THE TOP OF PIPE DURING CONSTRUCTION FOR ALL AREAS EXCEPT DITCH LINES AND ROAD CROSSINGS. MINIMUM COVER FOR DITCH LINES AND ROAD CROSSINGS SHALL BE 3 FEET, UNLESS NOTED OTHERWISE.
- THE CONTRACTOR SHALL PERFORM EXPLORATORY WORK PRIOR TO CONSTRUCTION INCLUDING POTHOLING OF UTILITIES SUCH AS TELEPHONE, FIBER OPTIC, ELECTRICAL, WATER, ETC., AND IRRIGATION MAINS AND SERVICE LINES THAT LAY ADJACENT TO OR CROSS THE IMPROVEMENTS TO BE CONSTRUCTED. THIS WORK SHALL BE PERFORMED IN ORDER TO ACCURATELY LOCATE AND DETERMINE SIZES OF THE LINES AND TO DETERMINE ANY CONFLICTS THAT MAY EXIST THAT WILL REQUIRE ADJUSTMENT OF UTILITIES, COORDINATION WITH UTILITIES, OR ADJUSTMENT OF IMPROVEMENTS. SEE THE TECHNICAL SPECIFICATIONS FOR ADDITIONAL DETAILS. PAYMENT FOR EXPLORATORY WORK SHALL BE PAID UNDER THE BID ITEM "POTHOLING."
- THRUST BLOCKING REQUIRED FOR ALL TEES AND ELBOWS 11-1/4 DEGREES OR GREATER FOR PIPE SIZES 3-INCH OR GREATER.
- THE CONTRACTOR'S WORK SHALL BE LIMITED TO THE WIDTH OF THE IRRIGATION EASEMENT PLUS ANY ADDITIONAL TEMPORARY EASEMENT PROVIDED AND COUNTY ROAD RIGHT-OF-WAY AS SPECIFIED IN THE TECHNICAL SPECIFICATIONS. SEE THE TECHNICAL SPECIFICATIONS FOR DETAILS.
- SMUDGE POTS AND ACCESSORIES ADJACENT TO ORCHARDS SHALL BE MOVED BY PROPERTY OWNER PRIOR TO CONSTRUCTION.



REVISION	BY	DATE	HORIZ. SCALE	VERT. SCALE
DESIGNED BY	R. HARRIS		NONE	
DRAWN BY	D. CHRISTMAN		JOB NUMBER 1199-336	DATE 2011
REVIEWED BY	B. MOORE		ACAD FILE: LEGEND-Ph3A.dwg	
COPYRIGHT 2011 BY ANDERSON-PERRY & ASSOC., INC.				

RECORD DRAWINGS

These record drawings have been prepared, in part, on the basis of information compiled and furnished by others. They may contain some discrepancies and omissions, and do not necessarily represent "exact" field conditions. The Owner and the Engineer accept no responsibility for their accuracy.

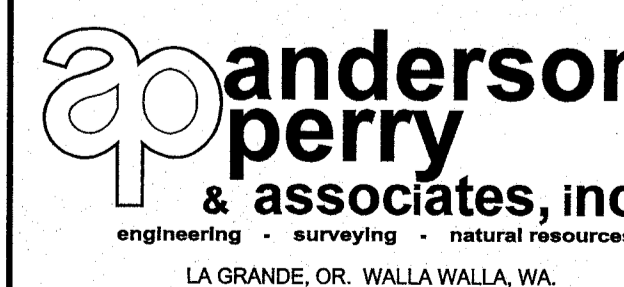

BENTON IRRIGATION DISTRICT
IRRIGATION SYSTEM IMPROVEMENTS
PHASE 3A


LEGEND, NOTES, AND QUANTITIES

SHEET


1




EXISTING RIVER PUMP STATION

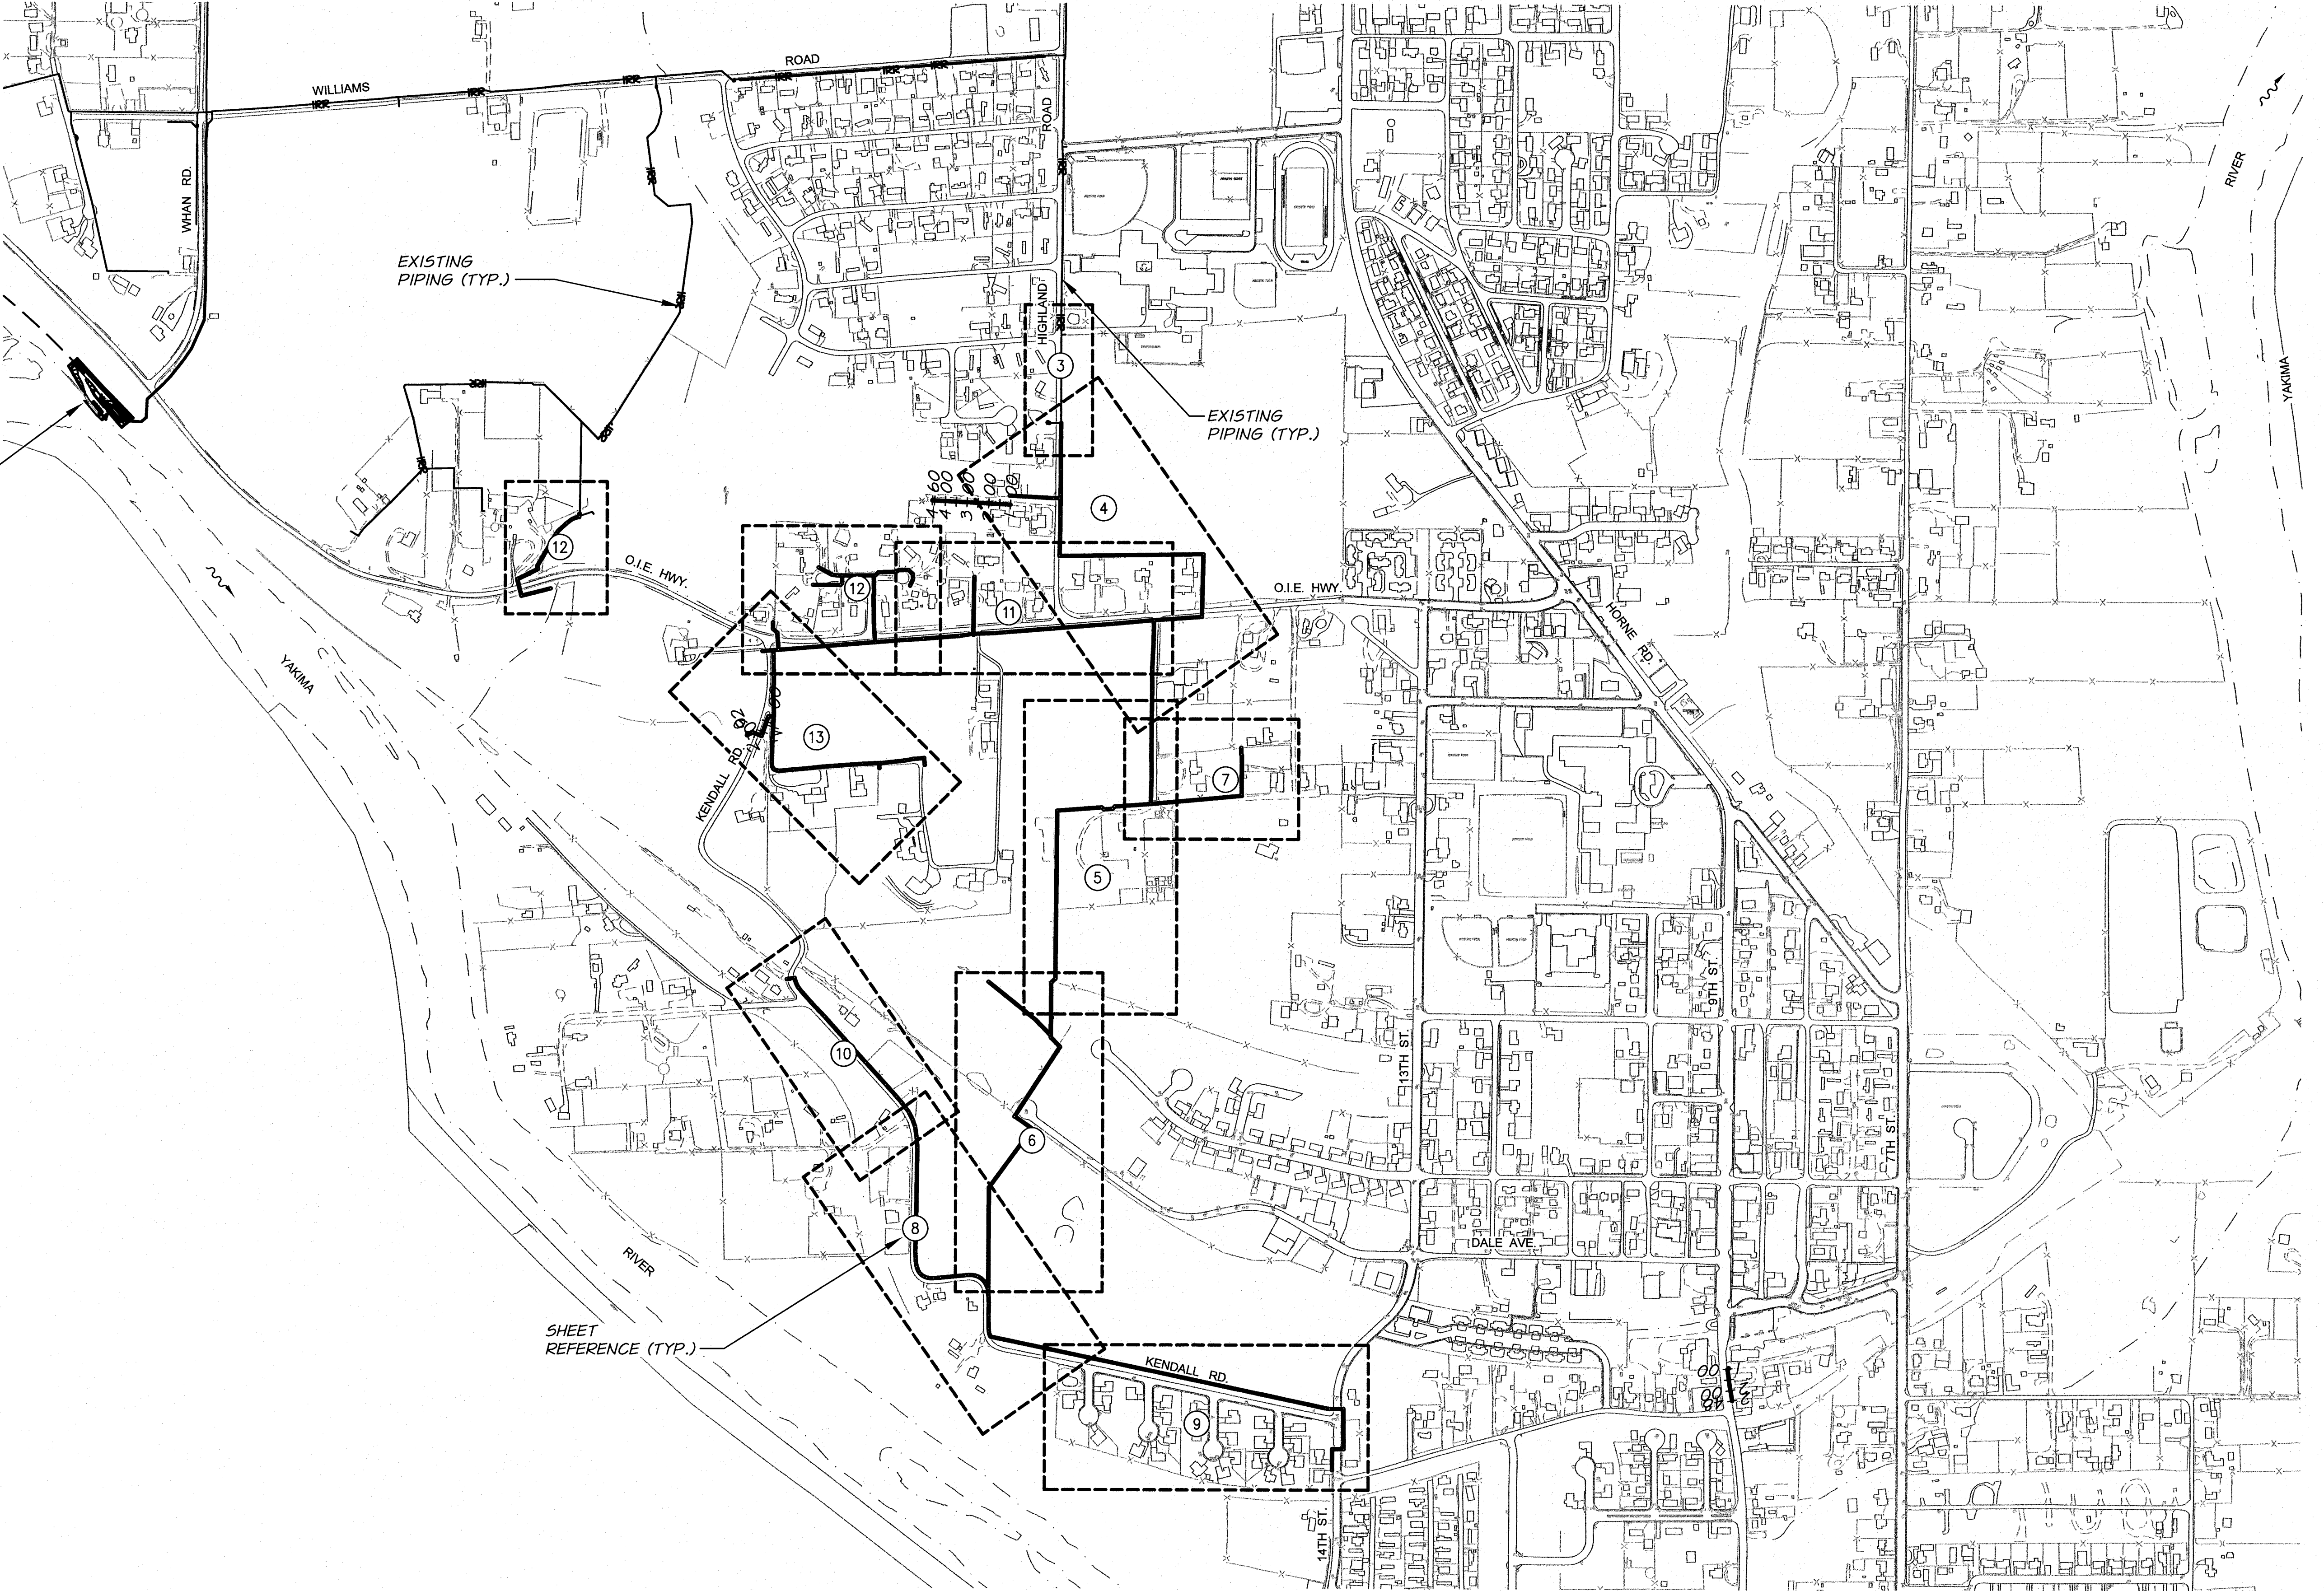

REVISION	BY	DATE	HORIZ. SCALE 1" = 400'	VERT. SCALE
DESIGNED BY R. HARRIS			JOB NUMBER 1199-336	DATE 2011
DRAWN BY D. CHRISTMAN			ACAD FILE: SheetIndexPH3A.dwg	
REVIEWED BY B. MOORE			COPYRIGHT 2011 BY ANDERSON-PERRY & ASSOC., INC.	


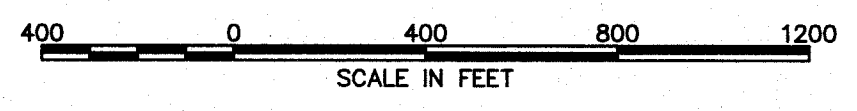


RECORD DRAWINGS
 These record drawings have been prepared, in part, on the basis of information compiled and furnished by others. They may contain some discrepancies and omissions, and do not necessarily represent "exact" field conditions. The Owner and the Engineer accept no responsibility for their accuracy.

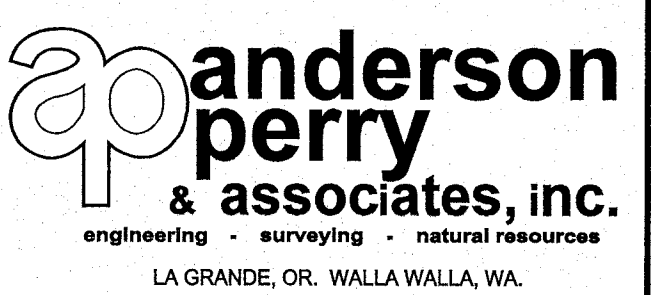


BENTON IRRIGATION DISTRICT
IRRIGATION SYSTEM IMPROVEMENTS
PHASE 3A
 SHEET INDEX

SHEET **2**

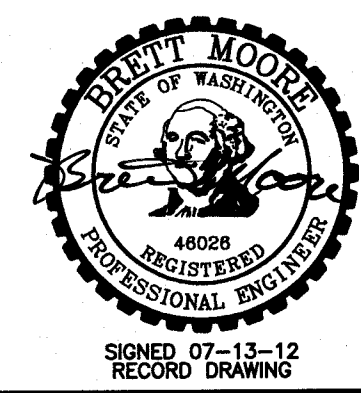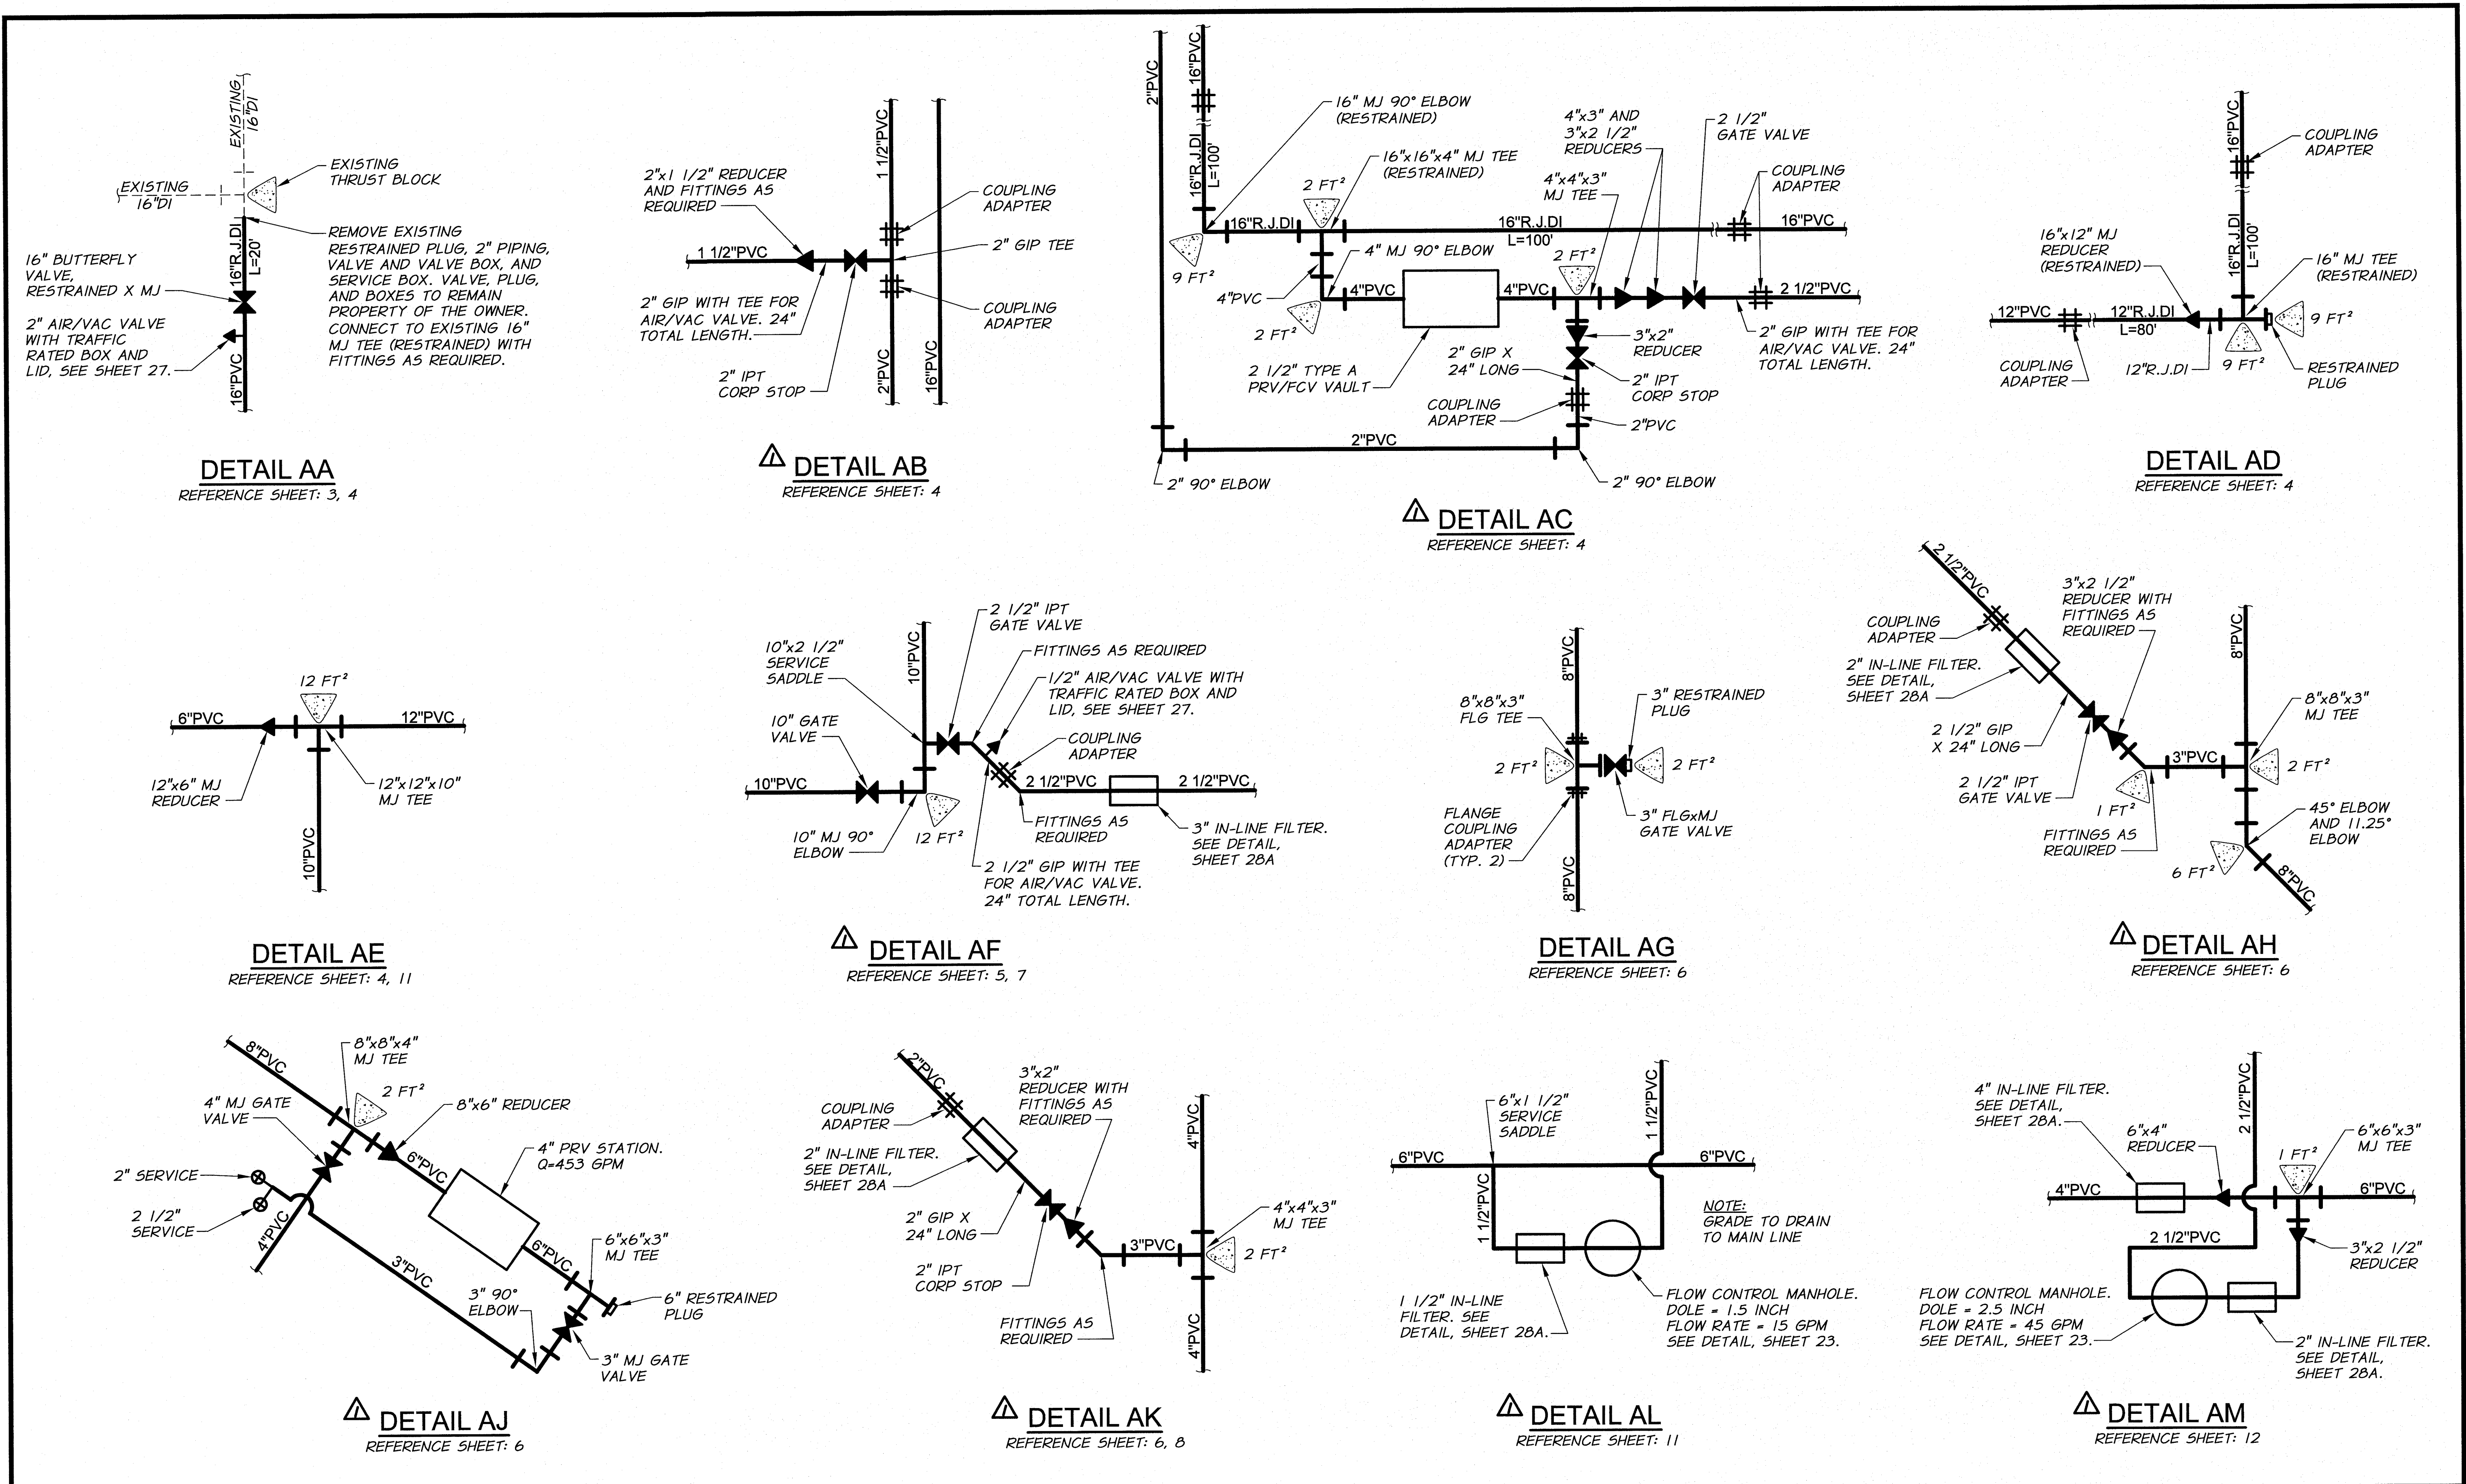


RECORD DRAWING		BY	B.M.	DATE	7/12
DESIGNED BY	R. HARRIS	JOB NUMBER	1199-336	DATE	2011
DRAWN BY	D. CHRISTMAN	ACAD FILE	PipeConnDets-Ph3A.dwg		
REVIEWED BY	B. MOORE	COPYRIGHT 2011 BY ANDERSON-PERRY & ASSOC., INC.			


RECORD DRAWINGS
 These record drawings have been prepared, in part, on the basis of information compiled and furnished by others. They may contain some discrepancies and omissions, and do not necessarily represent "exact" field conditions. The Owner and the Engineer accept no responsibility for their accuracy.

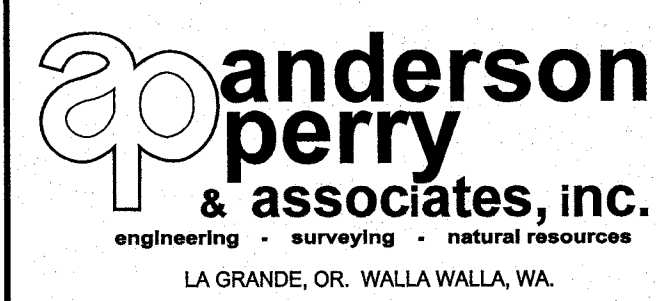


BENTON IRRIGATION DISTRICT IRRIGATION SYSTEM IMPROVEMENTS PHASE 3A PIPE CONNECTION DETAILS I	SHEET
	14

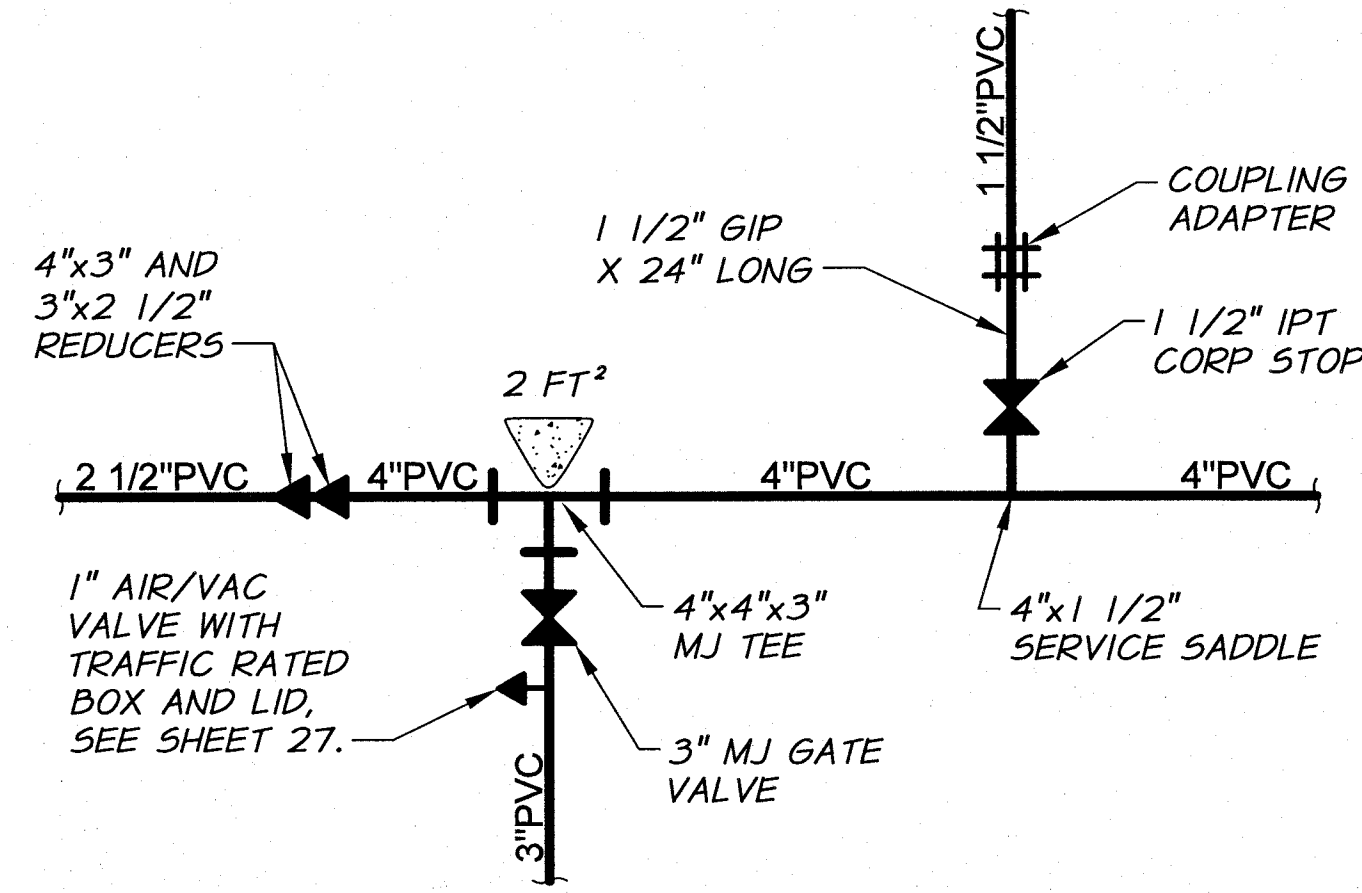


DETAIL AN
REFERENCE SHEET: 12, 13

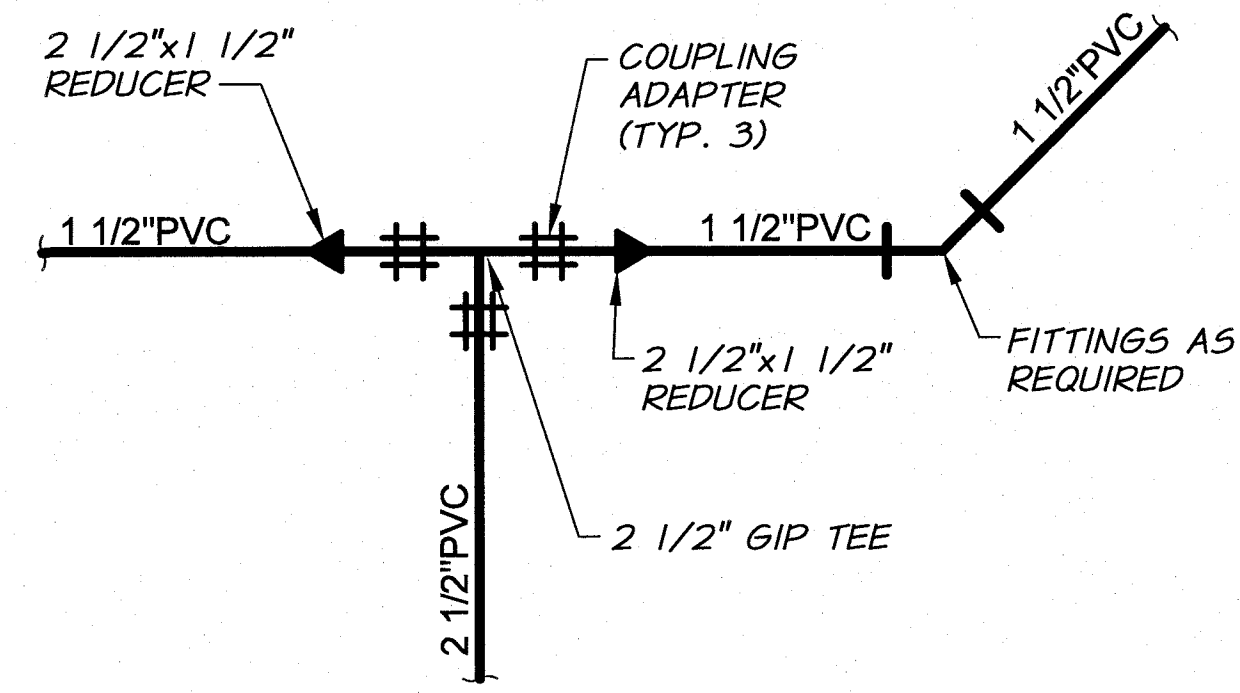


DETAIL AP
REFERENCE SHEET: 12

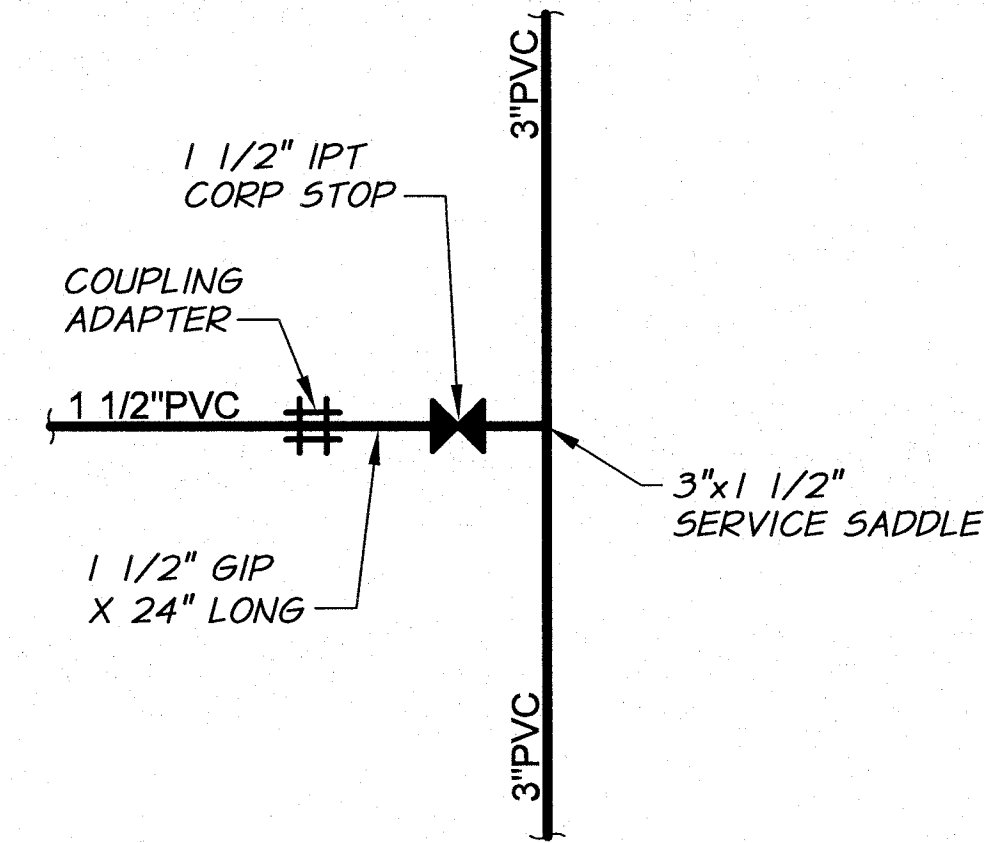


DETAIL AQ
REFERENCE SHEET: 13

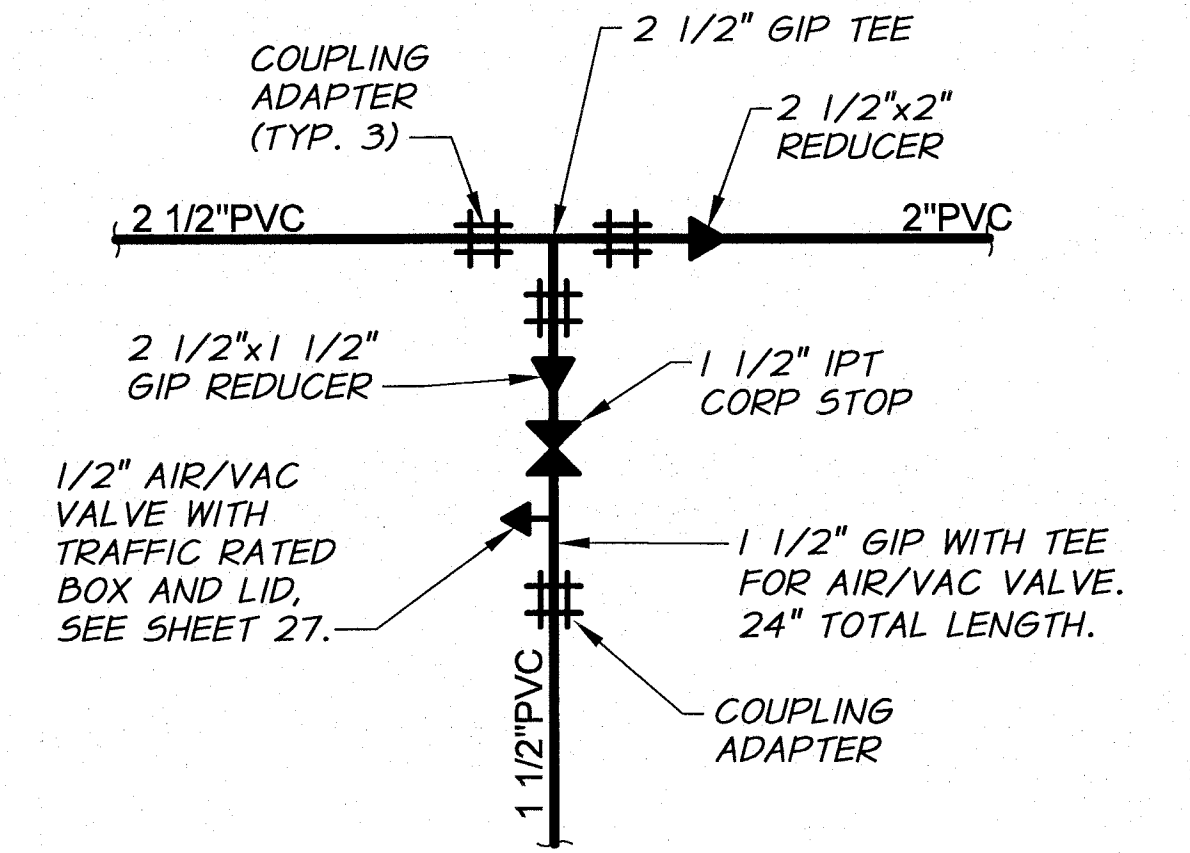

DETAIL AS
REFERENCE SHEET: 13

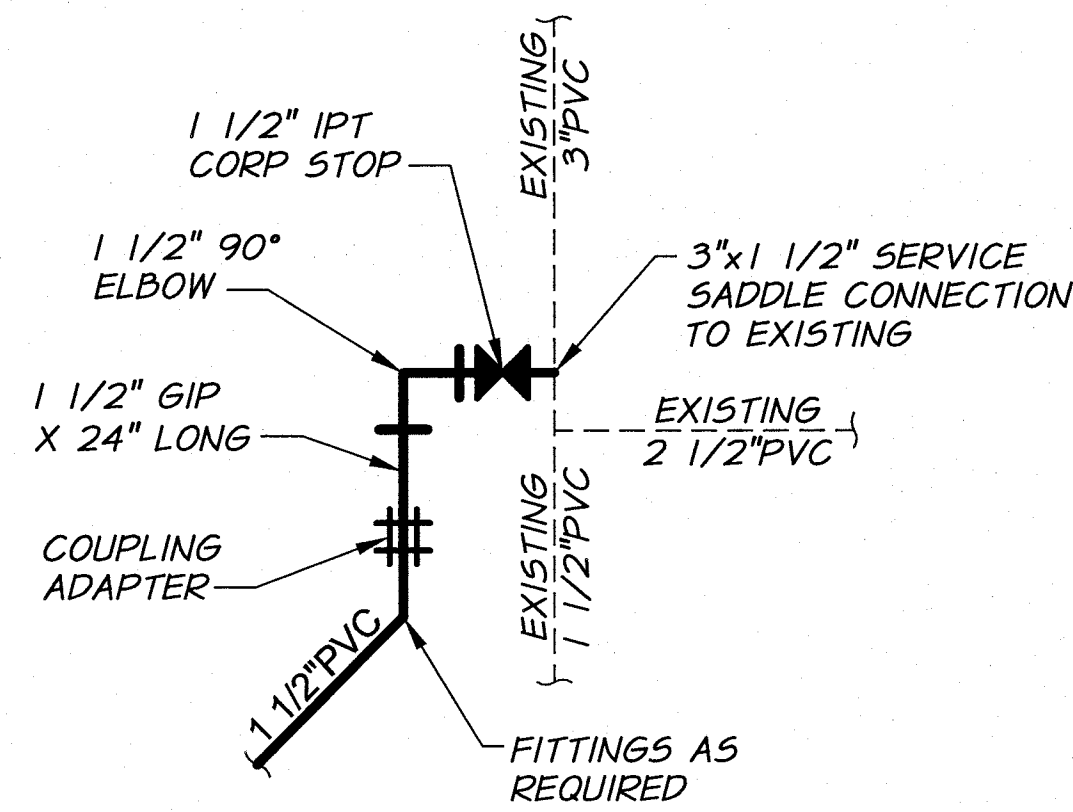

DETAIL AT
REFERENCE SHEET: 12

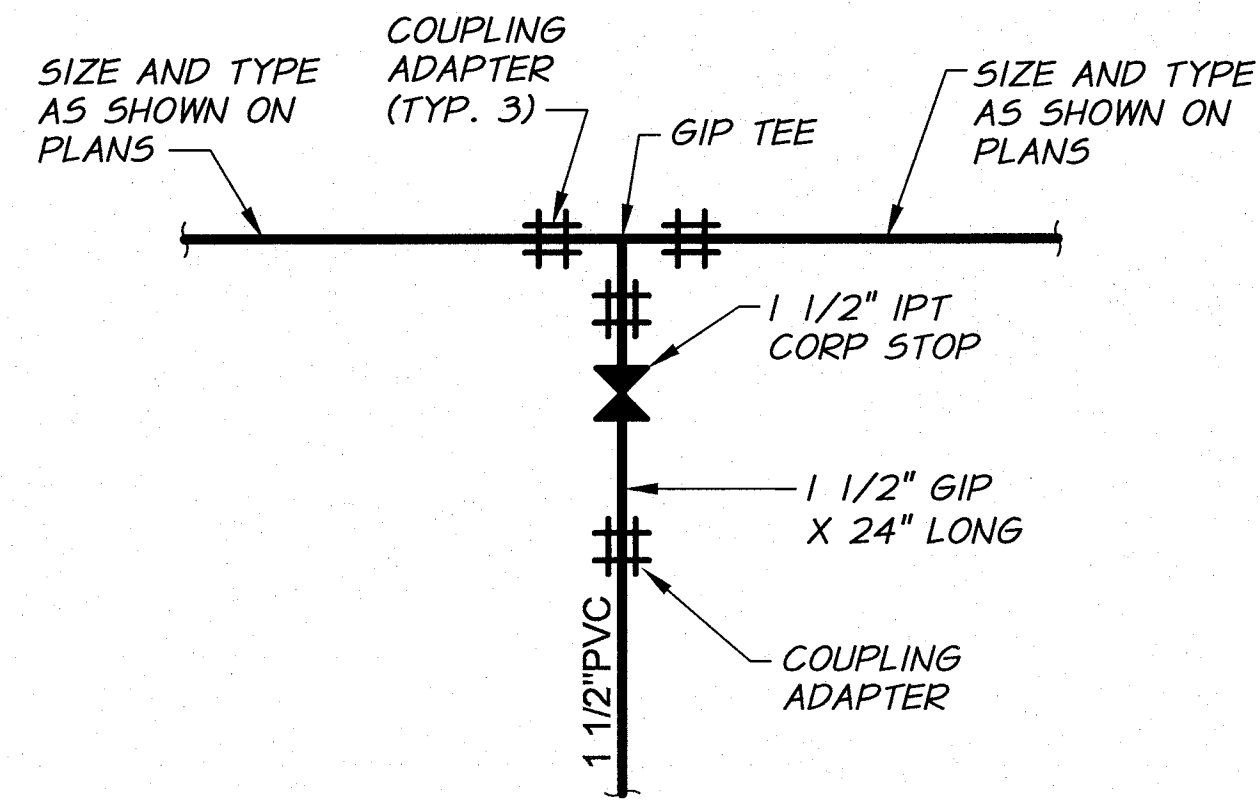


DETAIL AV
REFERENCE SHEET: 9



REVISION	BY	DATE	HORIZ. SCALE	VERT. SCALE
DESIGNED BY	R. HARRIS		NONE	
DRAWN BY	D. CHRISTMAN		1199-336	2011
REVIEWED BY	B. MOORE		ACAD FILE: PipeConnDets-Ph3A.dwg	
COPYRIGHT 2011 BY ANDERSON-PERRY & ASSOC., INC.				

RECORD DRAWINGS

These record drawings have been prepared, in part, on the basis of information compiled and furnished by others. They may contain some discrepancies and omissions, and do not necessarily represent "exact" field conditions. The Owner and the Engineer accept no responsibility for their accuracy.

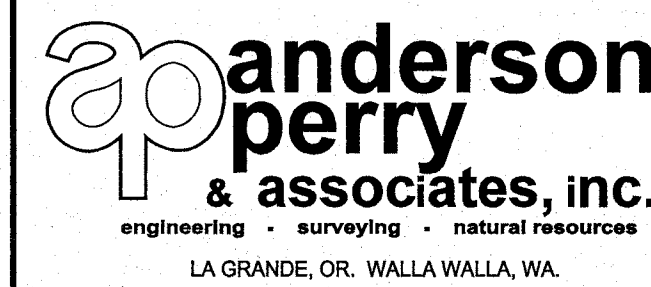


BENTON IRRIGATION DISTRICT
IRRIGATION SYSTEM IMPROVEMENTS
PHASE 3A

PIPE CONNECTION DETAILS II

SHEET


15

ARCHIVED

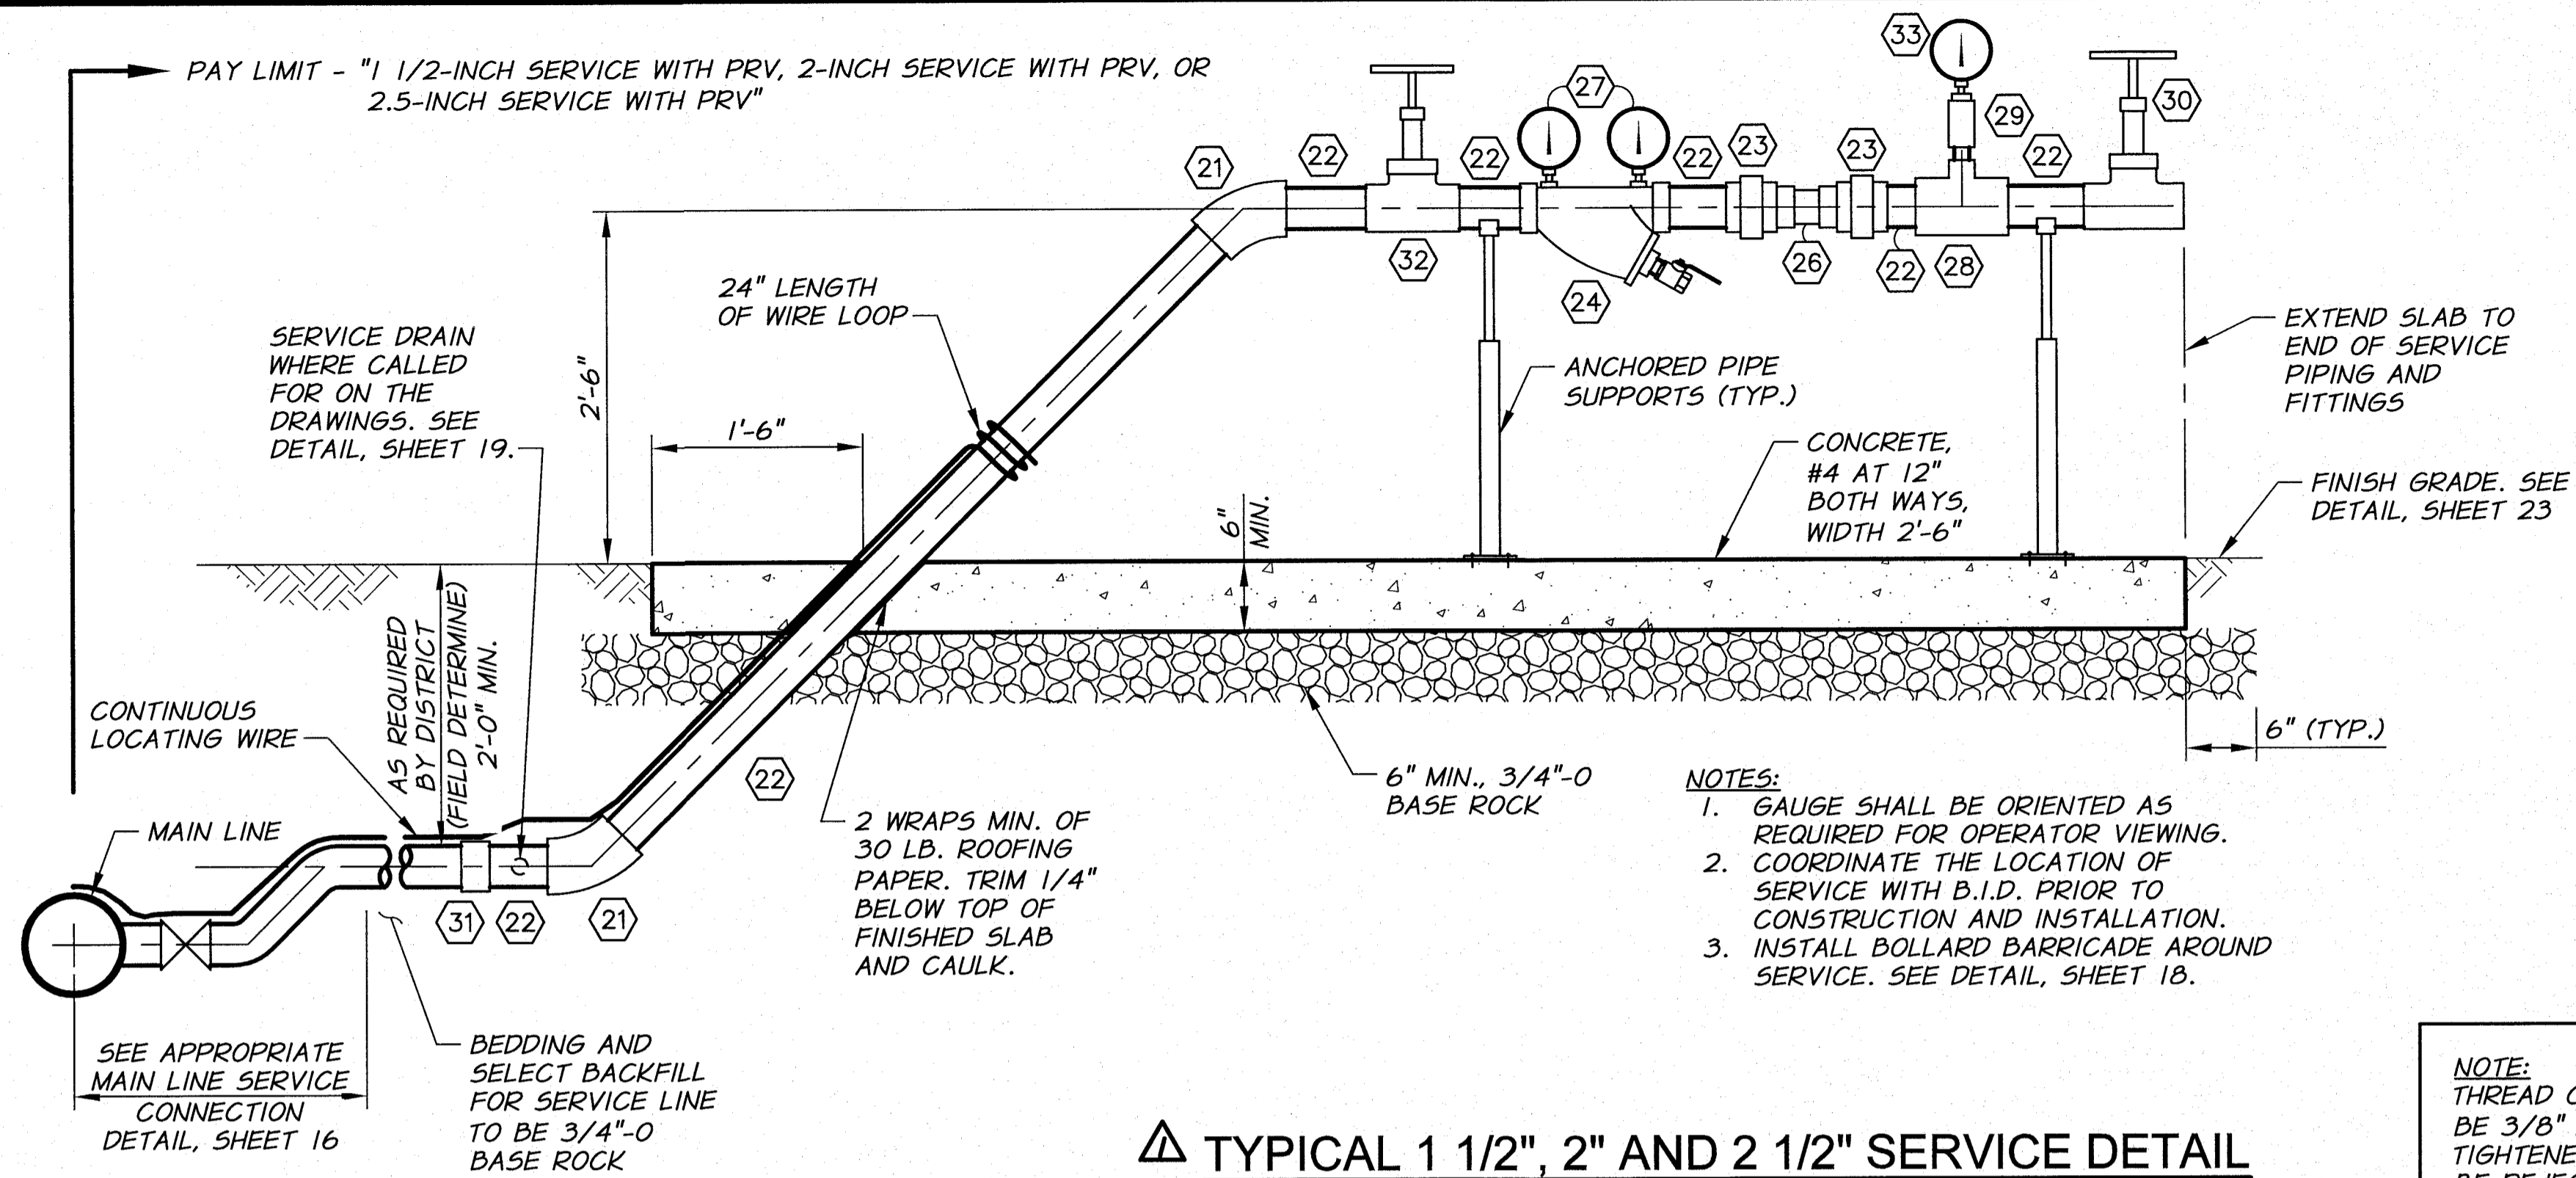

TYPICAL 1 1/2", 2" AND 2 1/2" SERVICE DETAIL
WITHOUT PRESSURE REDUCING VALVE
N.T.S.


NOTE:
THREAD CLEARANCE SHALL BE 3/8" MINIMUM. OVER TIGHTENED FITTINGS WILL BE REJECTED AND PIPING ASSEMBLY REASSEMBLED TO MEET REQUIREMENTS. SEE SPECIFICATIONS FOR MORE DETAILS.

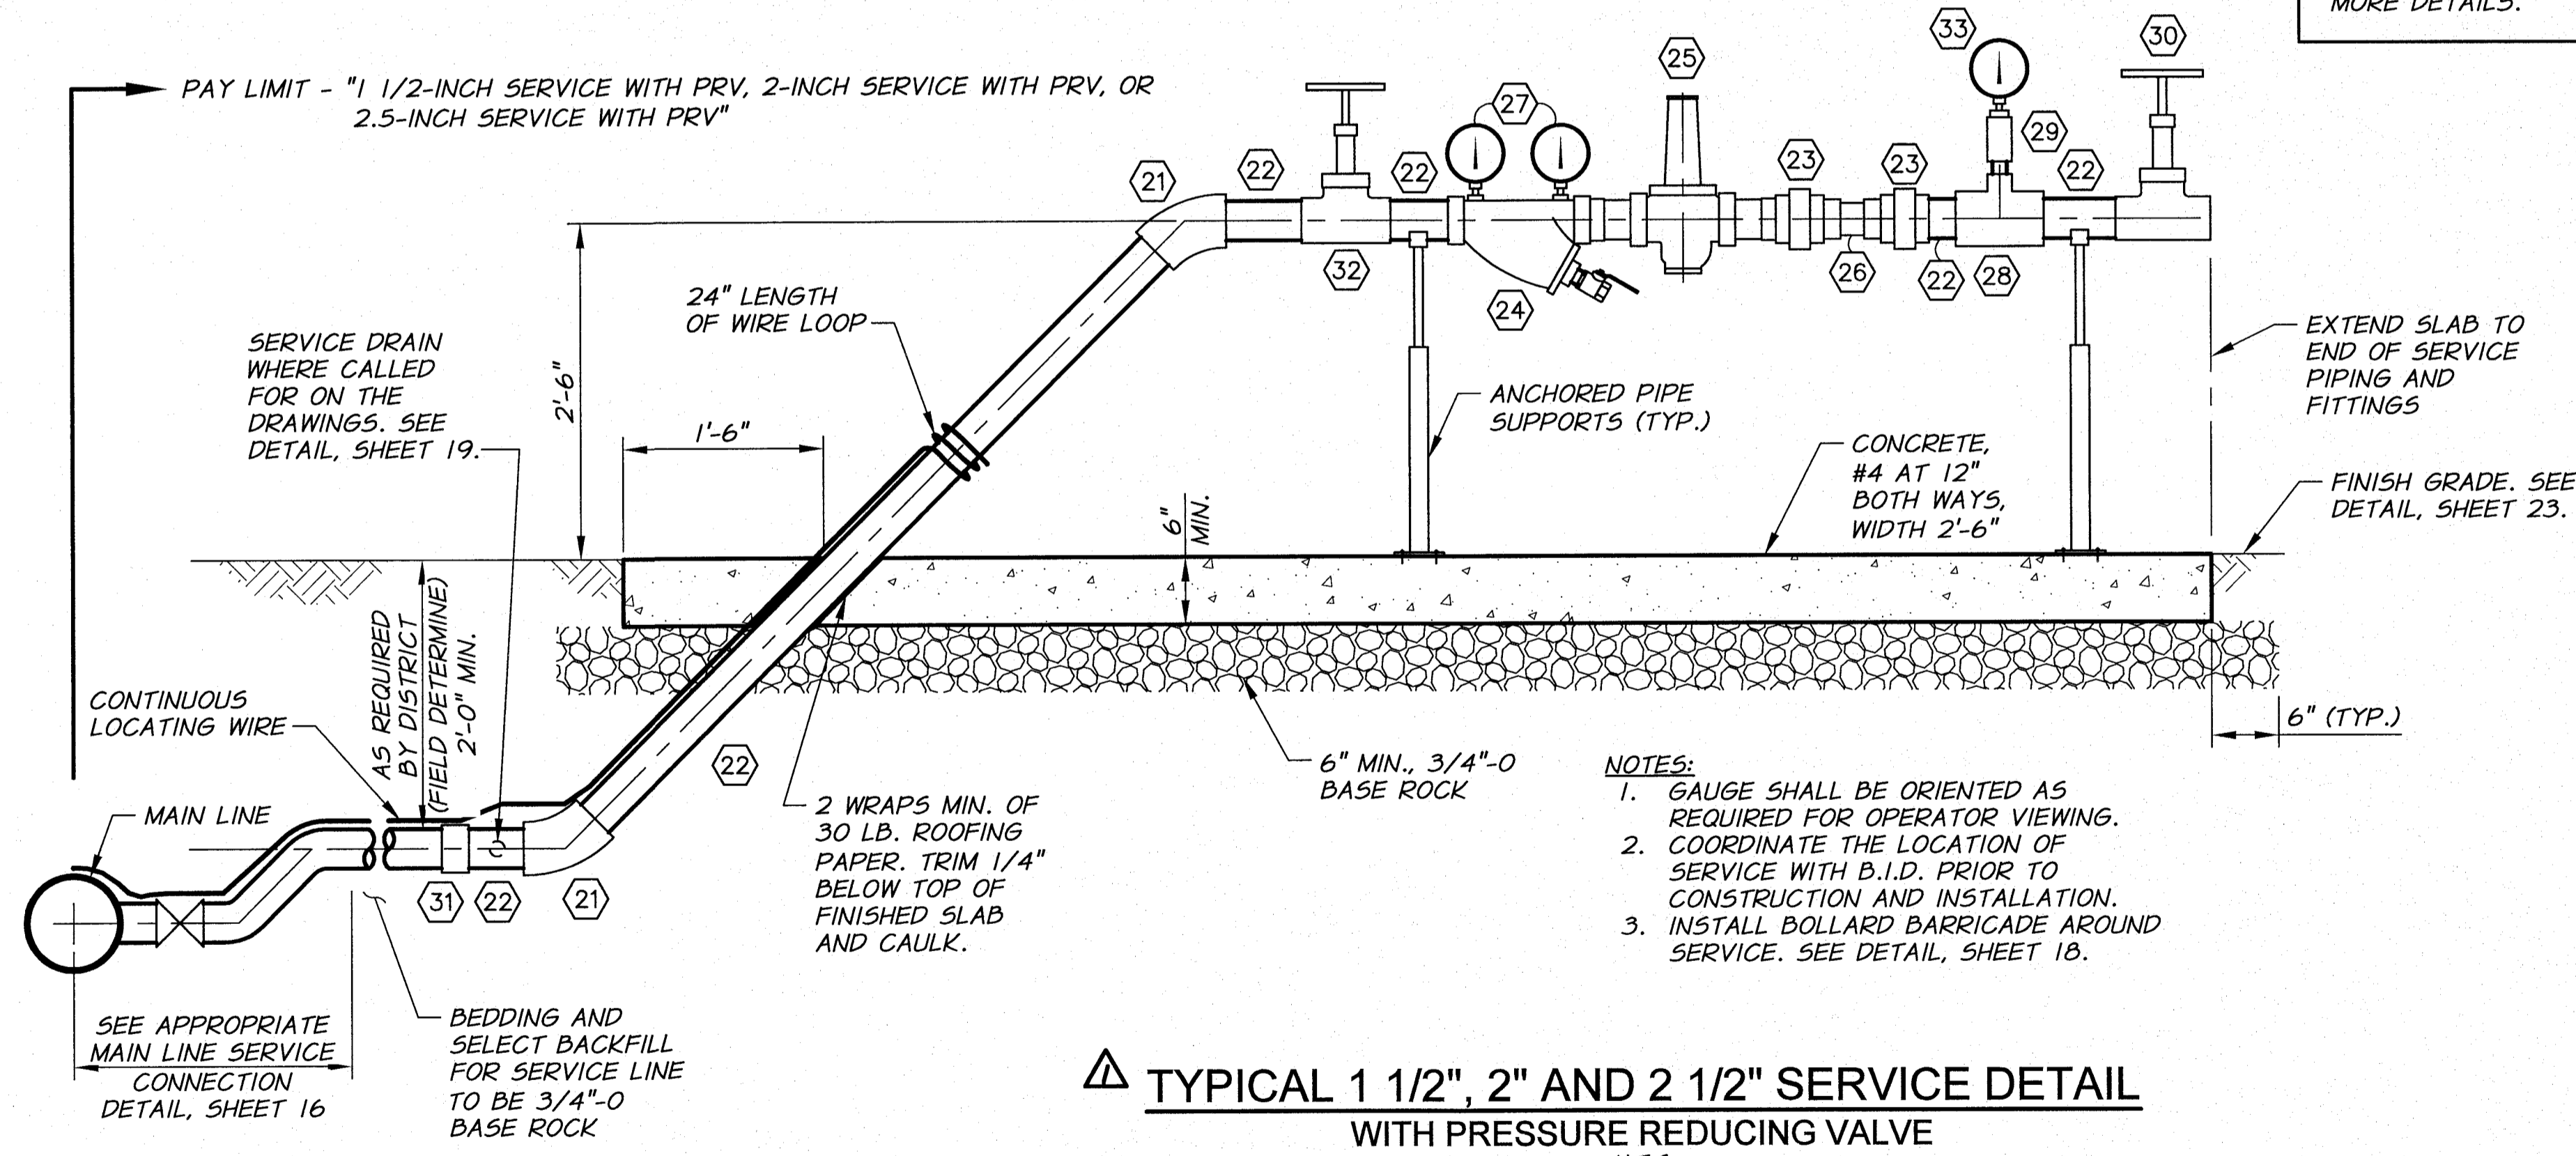

TYPICAL 1 1/2", 2" AND 2 1/2" SERVICE DETAIL
WITH PRESSURE REDUCING VALVE
N.T.S.


SERVICE FITTING SCHEDULE

- (21) G.I.P. 45° ELBOW
- (22) SCH. 40 G.I.P. PIPE
- (23) G.I.P. UNION OR G.I.P. REDUCING UNION AS REQUIRED
- (24) SONNTAG ALUMINUM Y-FILTER WITH 40 MESH FILTER SCREEN. 1 1/4" FOR 1 1/2" SERVICE, 2" FOR 2" SERVICE, 3" FOR 2.5" SERVICE (UNLESS OTHERWISE SPECIFIED), WITH FITTINGS AS REQUIRED
- (25) CLA-VAL 990 PRESSURE REDUCING VALVE WITH BUSHINGS AS REQUIRED. SIZE AS SHOWN ON PLANS. SEE TECHNICAL SPECIFICATIONS FOR DETAILS.
- (26) DOLE FLOW CONTROL VALVE. SIZE AS SHOWN ON PLANS. INSTALL WITH FLOW RATE LABEL FACING UPWARDS AND NO WRENCH MARKS ON VALVE.
- (27) 4" 55 GLYCERIN FILLED PRESSURE GAUGE, FITTINGS AS REQUIRED
- (28) SIZE x 3/4" G.I.P. TEE
- (29) 3/4" THREADED BRASS BALL VALVE WITH 3/4"x1/4" BUSHING AND BRASS QUICK COUPLING PLUG (UNVALVED)
- (30) BRASS THREADED GATE VALVE
- (31) SCH 80 PVC TRANSITION COUPLING AND FITTINGS AS REQ'D. FEMALE CONNECTION TO GIP.
- (32) LOCKING THREADED BRASS GATE VALVE WITH BUSHINGS AS REQ'D. USE 1 1/2" VALVE FOR 1 1/2" SERVICE, USE 2" VALVE FOR 2" OR 2 1/2" SERVICE
- (33) BRASS QUICK COUPLING SOCKET (UNVALVED) GAUGE BY OWNER.

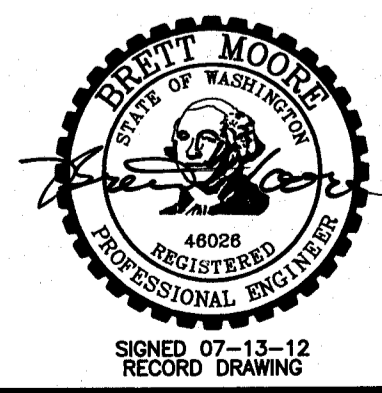


RECORD DRAWING		BY	B.M.	DATE	7/12
DESIGNED BY	R. HARRIS	JOB NUMBER	1199-336	DATE	2011
DRAWN BY	D. CHRISTMAN	ACAD FILE	ServiceDets-Ph3A.dwg		
REVIEWED BY	B. MOORE	COPYRIGHT 2011 BY ANDERSON-PERRY & ASSOC., INC.			

RECORD DRAWINGS
These record drawings have been prepared, in part, on the basis of information compiled and furnished by others. They may contain some discrepancies and omissions, and do not necessarily represent "exact" field conditions. The Owner and the Engineer accept no responsibility for their accuracy.

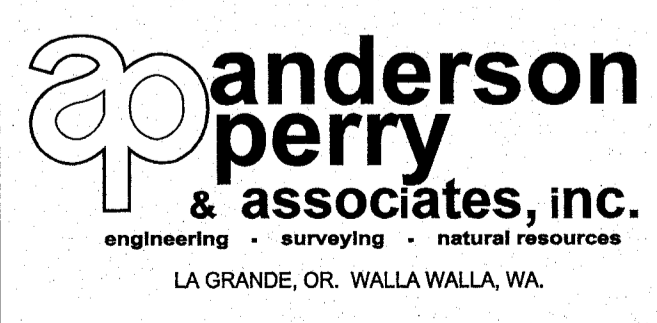

BENTON IRRIGATION DISTRICT
IRRIGATION SYSTEM IMPROVEMENTS
PHASE 3A
SERVICE DETAILS II

NOTE:
THREAD CLEARANCE SHALL BE 3/8" MINIMUM. OVER TIGHTENED FITTINGS WILL BE REJECTED AND PIPING ASSEMBLY REASSEMBLED TO MEET REQUIREMENTS. SEE SPECIFICATIONS FOR MORE DETAILS.

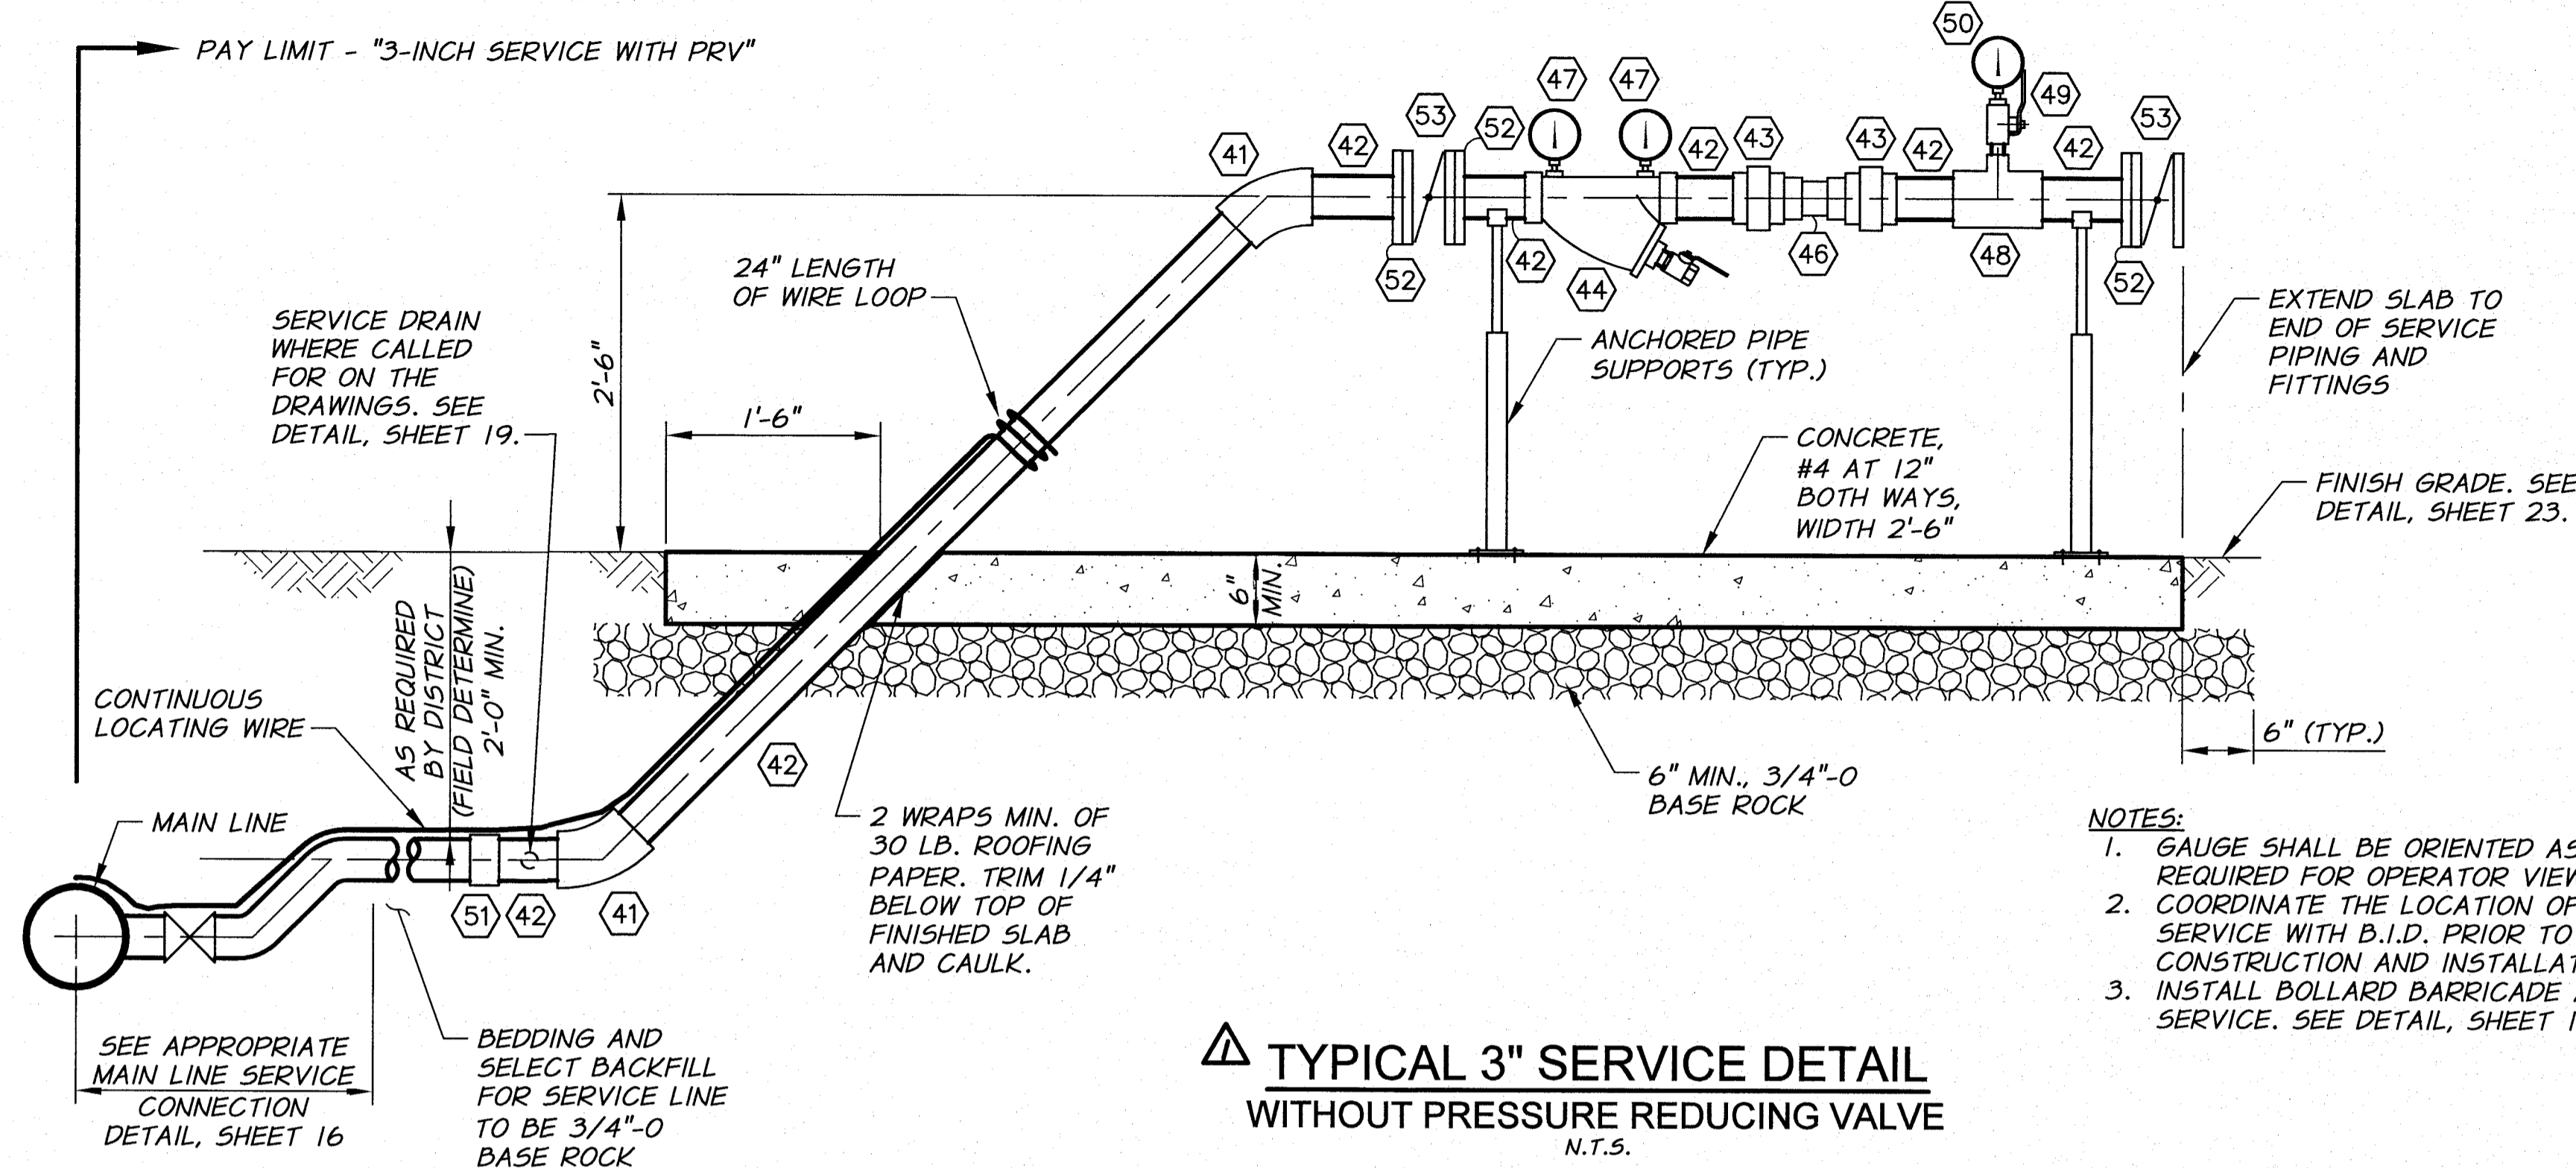


TYPICAL 3" SERVICE DETAIL
WITHOUT PRESSURE REDUCING VALVE
N.T.S.

△ SERVICE FITTING SCHEDULE


- 41 G.I.P. 45° ELBOW
- 42 SCH. 40 G.I.P. PIPE
- 43 G.I.P. UNION OR G.I.P. REDUCING UNION AS REQUIRED
- 44 3" SONNAG ALUMINUM Y-FILTER WITH 40 MESH FILTER SCREEN, UNLESS OTHERWISE SPECIFIED
- 46 DOLE FLOW CONTROL VALVE. SIZE AS SHOWN ON PLANS. INSTALL WITH FLOW RATE LABEL FACING UPWARDS AND NO WRENCH MARKS ON VALVE.
- 47 4" 55 GLYCERIN FILLED PRESSURE GAUGE. FITTINGS AS REQUIRED.
- 48 3"x3/4" G.I.P. TEE
- 49 3/4" THREADED BRASS BALL VALVE WITH 3/4"x1/4" BUSHING AND BRASS QUICK COUPLING PLUG (UNVALVED)
- 50 BRASS QUICK COUPLING SOCKET (UNVALVED) GAUGE BY OWNER
- 51 SCH 80 PVC TRANSITION COUPLING AND FITTINGS AS REQ'D. FEMALE CONNECTION TO GIP.
- 52 FLANGE ADAPTER
- 53 3" FLG BUTTERFLY VALVE WITH WHEEL OPERATOR AND POSITION INDICATOR

- NOTES:
1. GAUGE SHALL BE ORIENTED AS REQUIRED FOR OPERATOR VIEWING.
 2. COORDINATE THE LOCATION OF SERVICE WITH B.I.D. PRIOR TO CONSTRUCTION AND INSTALLATION.
 3. INSTALL BOLLARD BARRICADE AROUND SERVICE. SEE DETAIL, SHEET 18.

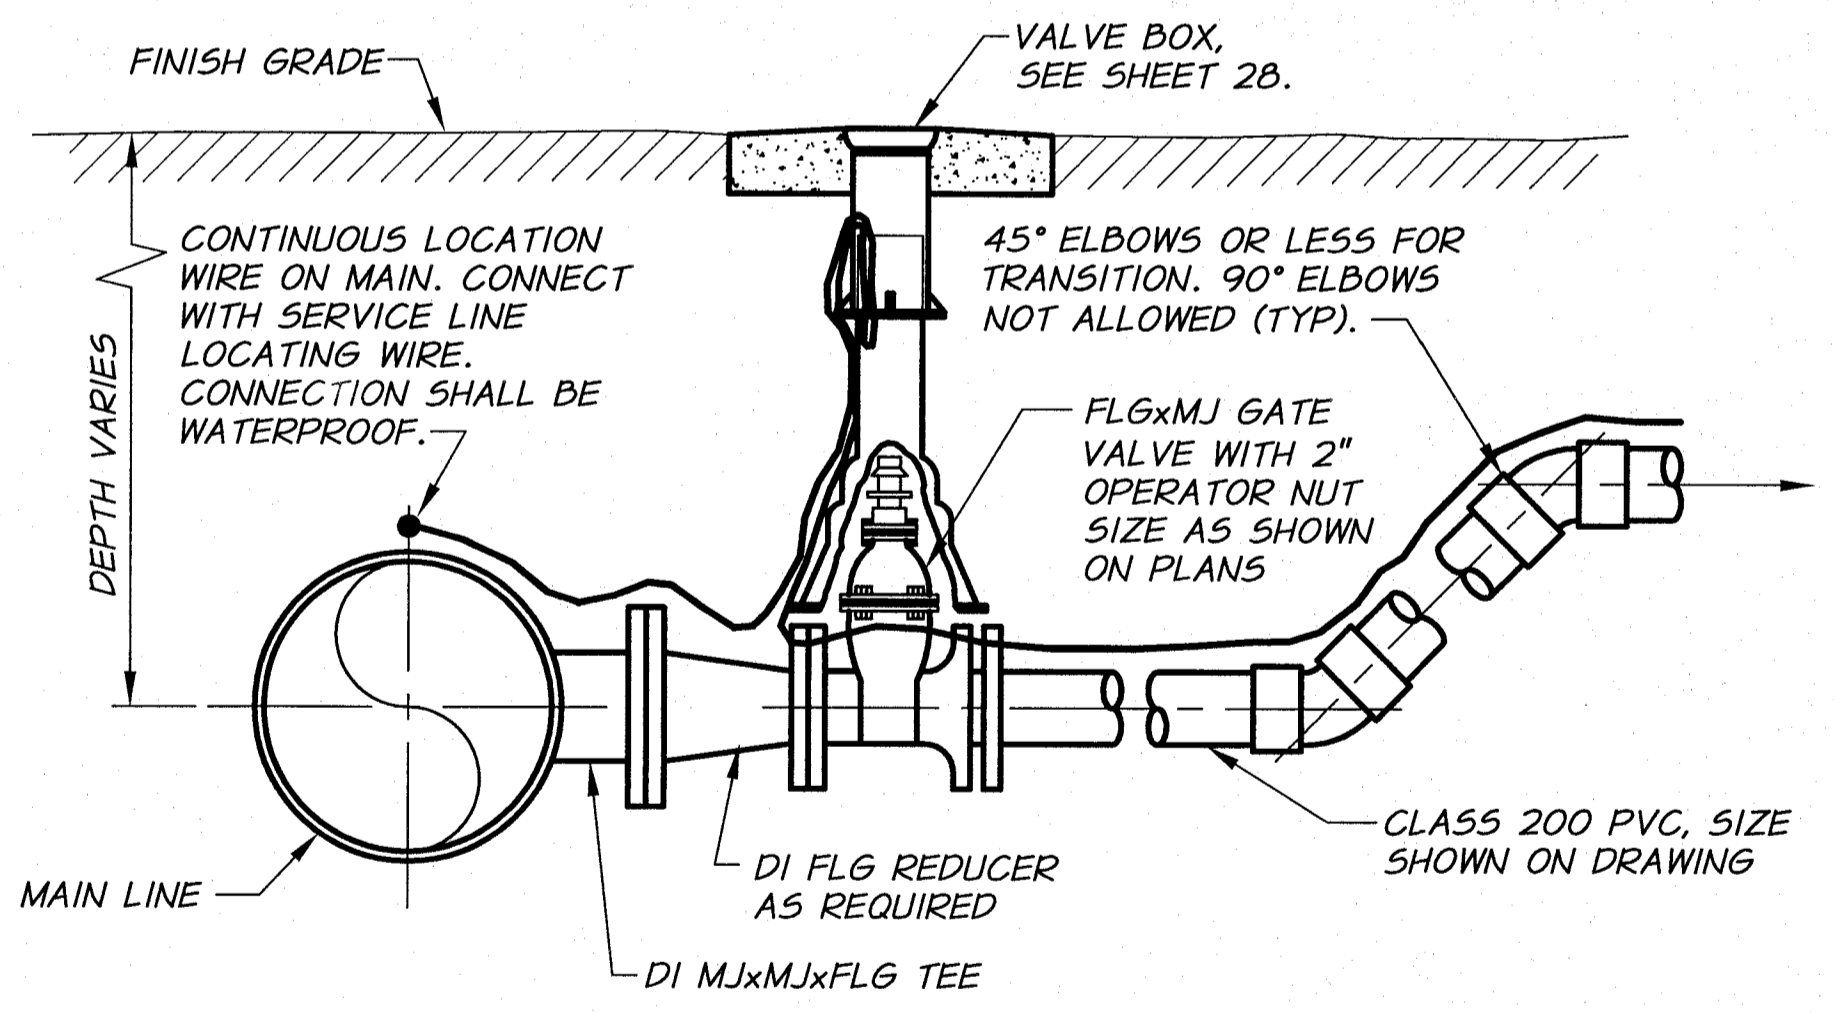


NOTE:
COORDINATE THE LOCATION OF SERVICE LINE CONNECTION WITH B.I.D. PRIOR TO CONSTRUCTION AND INSTALLATION.

MAIN LINE SERVICE CONNECTION
FOR 4" SERVICE AND LARGER
N.T.S.

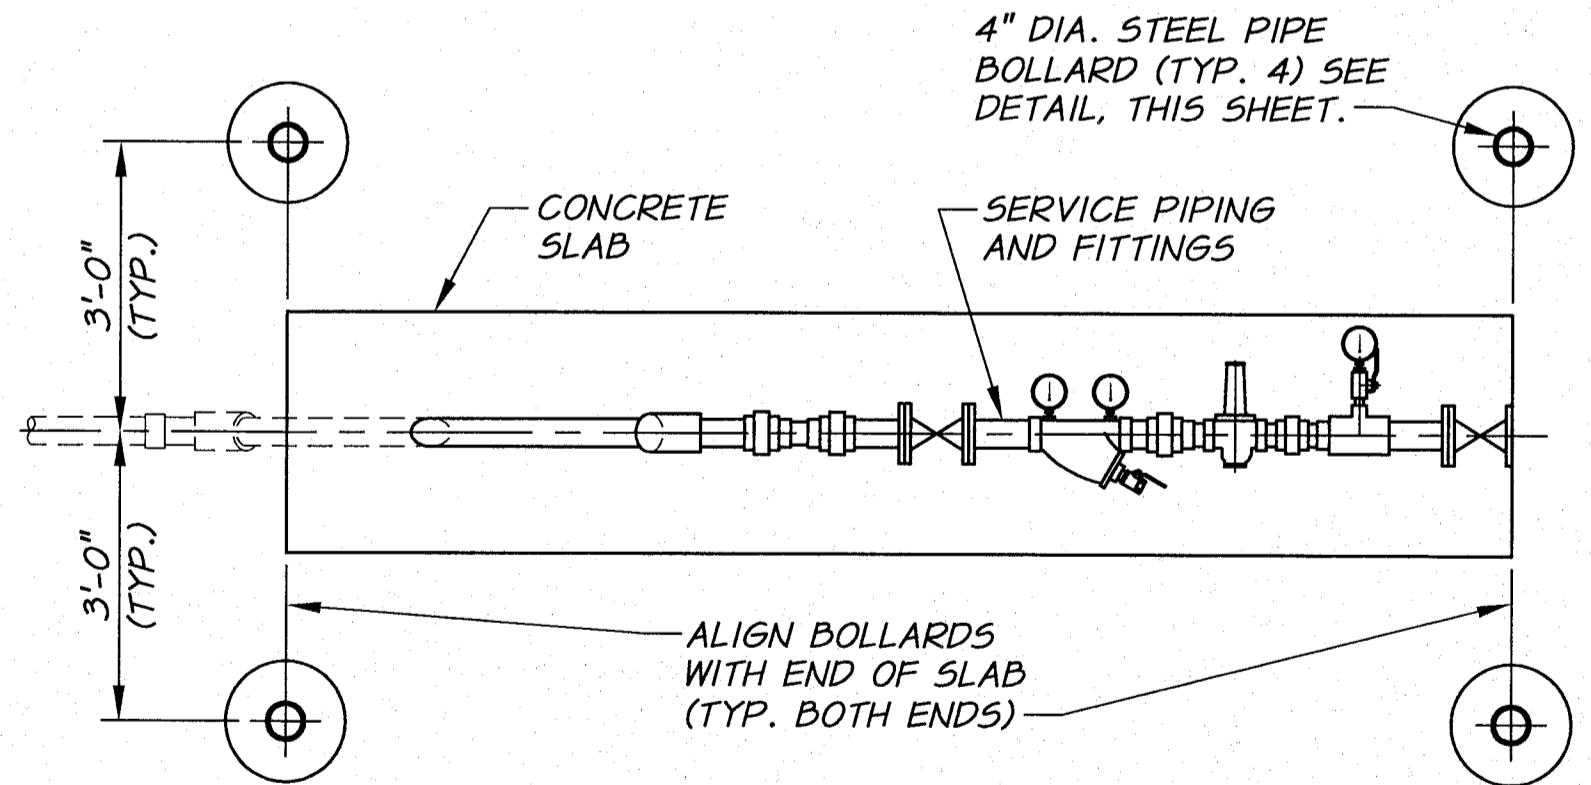


ABOVE GROUND SERVICE BARRICADE DETAIL
PLAN
N.T.S.

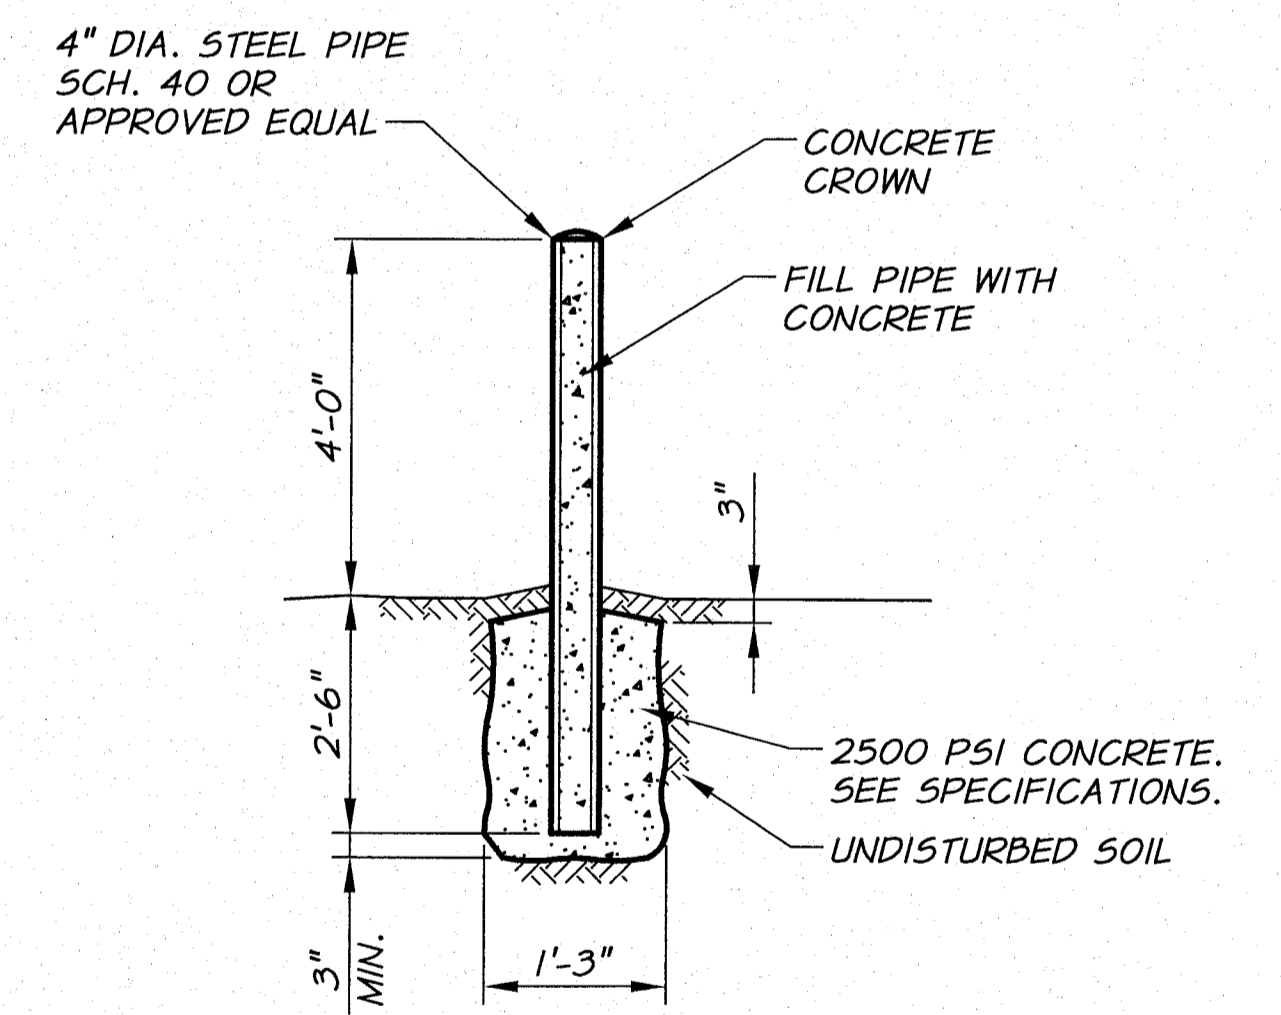


- NOTES:
1. 4" DIA. STEEL PIPE SHALL BE PLUMB.
 2. PAINTING SHALL BE DONE ONLY AFTER SURFACE IS FREE OF RUST, OIL, AND GREASE. THE METAL SHALL BE PRIMED AND TWO FINISH COATS APPLIED, YELLOW IN COLOR.

BOLLARD DETAIL
N.T.S.

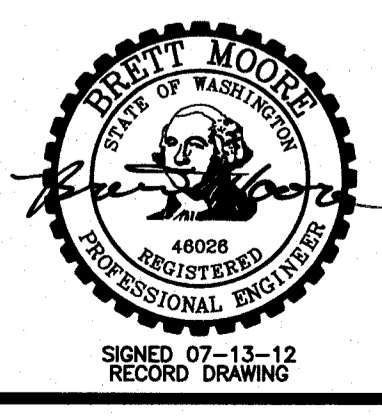

REVISION		BY	DATE	HORZ. SCALE	VERT. SCALE
RECORD DRAWING		B.M.	7/12	NONE	
DESIGNED BY	R. HARRIS		JOB NUMBER	1199-336	
DRAWN BY	D. CHRISTMAN		DATE	2011	
REVIEWED BY	B. MOORE		ACAD FILE:	ServiceDets-Ph3A.dwg	
COPYRIGHT 2011 BY ANDERSON-PERRY & ASSOC., INC.					


RECORD DRAWINGS
These record drawings have been prepared, in part, on the basis of information compiled and furnished by others. They may contain some discrepancies and omissions, and do not necessarily represent "exact" field conditions. The Owner and the Engineer accept no responsibility for their accuracy.

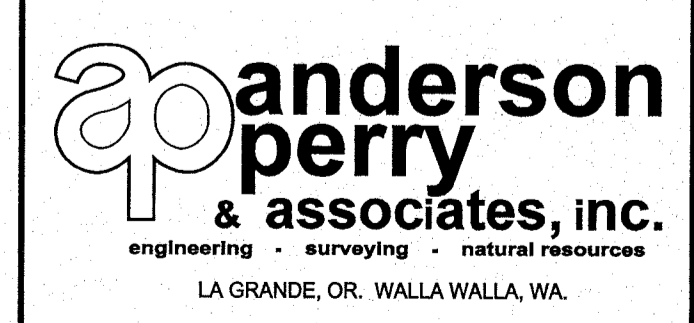

BENTON IRRIGATION DISTRICT
IRRIGATION SYSTEM IMPROVEMENTS
PHASE 3A
SERVICE DETAILS III

SHEET
18

NOTE:
 THREAD CLEARANCE SHALL BE 3/8" MINIMUM. OVER TIGHTENED FITTINGS WILL BE REJECTED AND PIPING ASSEMBLY REASSEMBLED TO MEET REQUIREMENTS. SEE SPECIFICATIONS FOR MORE DETAILS.

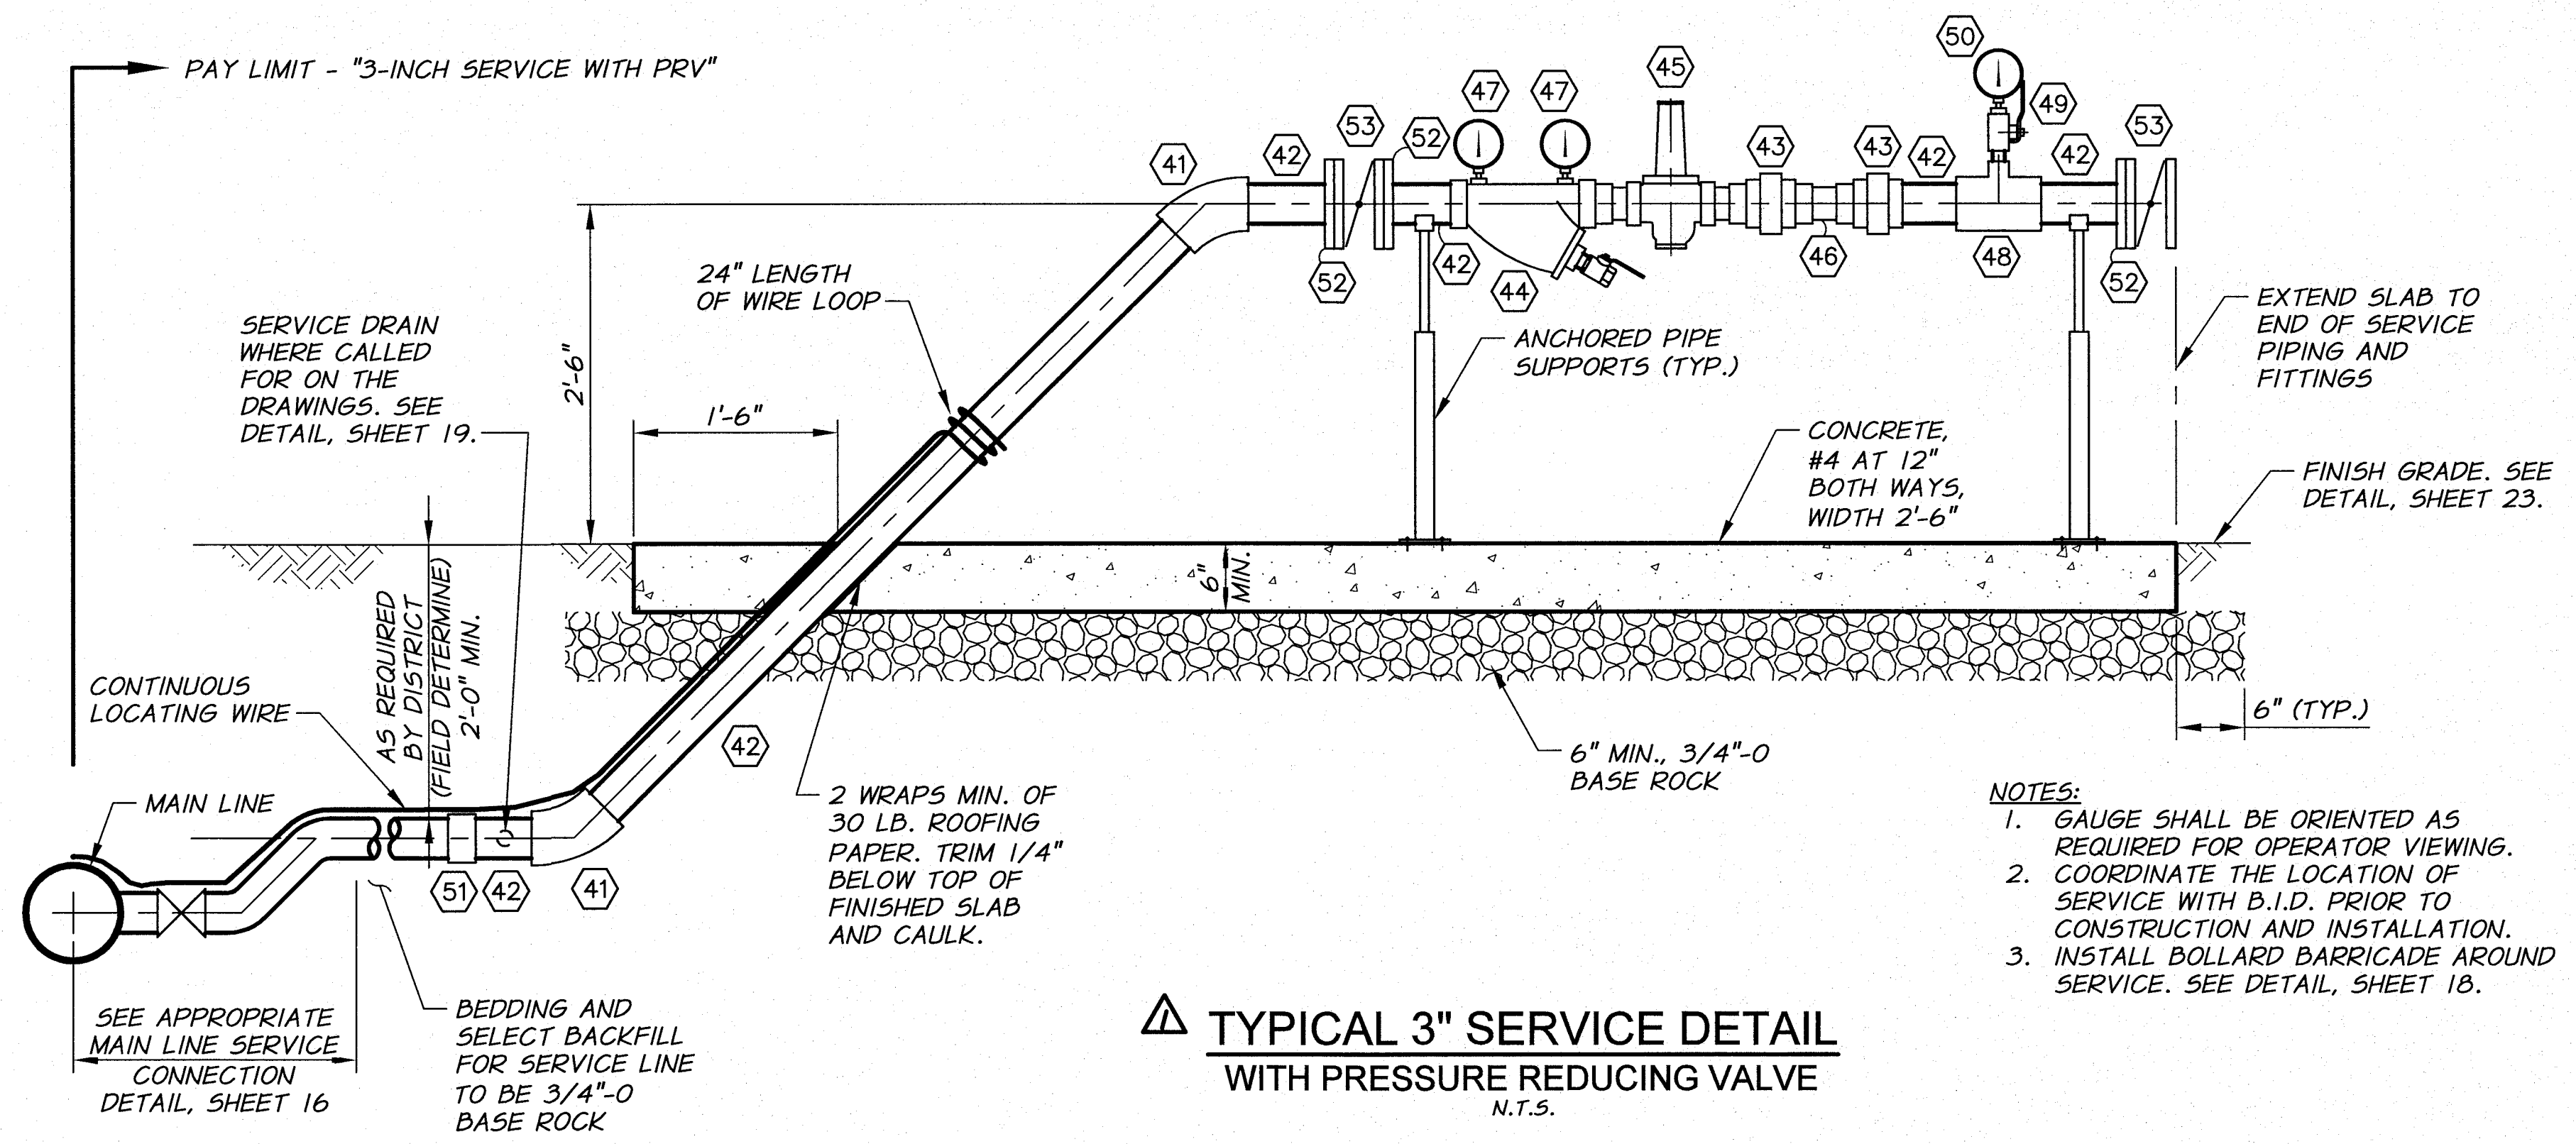


TYPICAL 3" SERVICE DETAIL WITH PRESSURE REDUCING VALVE
 N.T.S.

△ SERVICE FITTING SCHEDULE

- 41 G.I.P. 45° ELBOW
- 42 SCH. 40 G.I.P. PIPE
- 43 G.I.P. UNION OR G.I.P. REDUCING UNION AS REQUIRED
- 44 3" SONNITAG ALUMINUM Y-FILTER WITH 40 MESH FILTER SCREEN, UNLESS OTHERWISE SPECIFIED
- 45 CLA-VAL 990 PRESSURE REDUCING VALVE WITH BUSHINGS AS REQUIRED. SIZE AS SHOWN ON PLANS. SEE TECHNICAL SPECIFICATIONS FOR DETAILS.
- 46 DOLE FLOW CONTROL VALVE. SIZE AS SHOWN ON PLANS. INSTALL WITH FLOW RATE LABEL FACING UPWARDS AND NO WRENCH MARKS ON VALVE.
- 47 4" SS GLYCERIN FILLED PRESSURE GAUGE. FITTINGS AS REQUIRED.
- 48 3"x3/4" G.I.P. TEE
- 49 3/4" THREADED BRASS BALL VALVE WITH 3/4"x1/4" BUSHING AND BRASS QUICK COUPLING PLUG (UNVALVED)
- 50 BRASS QUICK COUPLING SOCKET (UNVALVED) GAUGE BY OWNER
- 51 SCH 80 PVC TRANSITION COUPLING AND FITTINGS AS REQ'D. FEMALE CONNECTION TO GIP.
- 52 FLANGE ADAPTER
- 53 3" FLG BUTTERFLY VALVE WITH WHEEL OPERATOR AND POSITION INDICATOR

- NOTES:**
1. GAUGE SHALL BE ORIENTED AS REQUIRED FOR OPERATOR VIEWING.
 2. COORDINATE THE LOCATION OF SERVICE WITH B.I.D. PRIOR TO CONSTRUCTION AND INSTALLATION.
 3. INSTALL BOLLARD BARRICADE AROUND SERVICE. SEE DETAIL, SHEET 18.

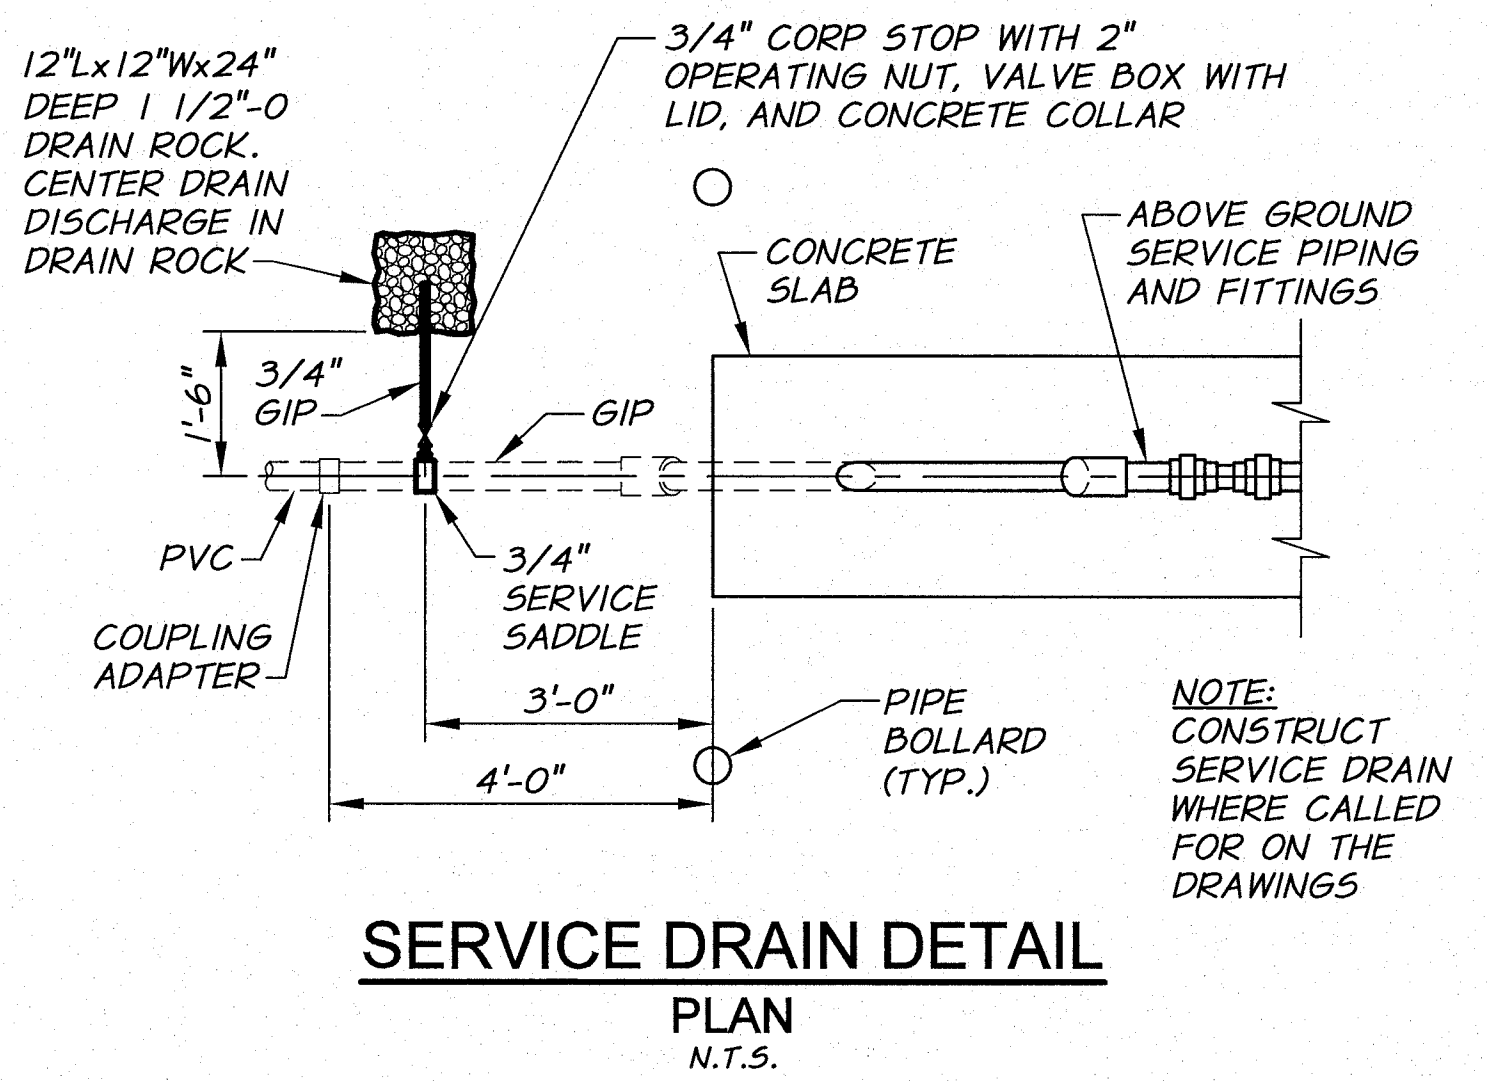


SERVICE DRAIN DETAIL PLAN
 N.T.S.



RECORD DRAWING		BY	B.M.	DATE	7/12
DESIGNED BY	R. HARRIS	JOB NUMBER	1199-336	DATE	2011
DRAWN BY	D. CHRISTMAN	ACAD FILE	ServiceDets-Ph3A.dwg		
REVIEWED BY	B. MOORE	COPYRIGHT 2011 BY ANDERSON-PERRY & ASSOC., INC.			

RECORD DRAWINGS
 These record drawings have been prepared, in part, on the basis of information compiled and furnished by others. They may contain some discrepancies and omissions, and do not necessarily represent "exact" field conditions. The Owner and the Engineer accept no responsibility for their accuracy.

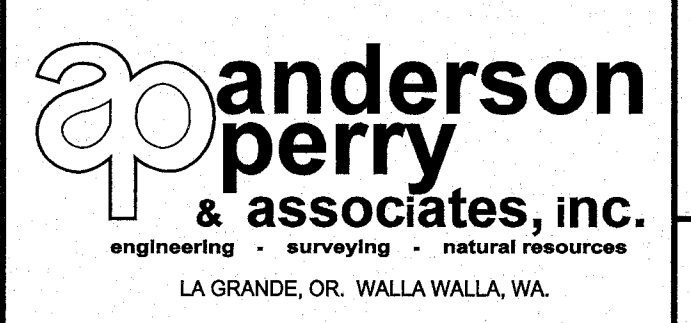

BENTON IRRIGATION DISTRICT
 IRRIGATION SYSTEM IMPROVEMENTS
 PHASE 3A
 SERVICE DETAILS IV



4'-0" X 8'-6" X 4'-6" MIN. (INSIDE DIMENSIONS) OR LARGER H-20 TRAFFIC RATED PRE-CAST CONCRETE VAULT. UTILITY VAULT COMPANY OR APPROVED EQUAL. SUBMIT DRAWINGS FOR APPROVAL.

H-20 RATED GALVANIZED SPRING-ASSISTED HATCH COVER WITH DRAIN, UTILITY VAULT NO. 2-332P OR APPROVED EQUAL. ONE LOCKING BOLT FOR EACH LID. PROVIDE RISERS AS REQUIRED.

FINISH GRADE. SEE DETAIL, SHEET 23.

FITTING SCHEDULE


- 1 TRANSITION COUPLING
- 2 GIP, SIZE AS SHOWN ON PLANS
- 3 THREADED GIP REDUCER WHERE REQUIRED
- 4 1 1/4", 2", OR 2 1/2" THREADED GIP
- 5 BRASS THREADED GATE VALVE
- 6 GIP UNION
- 7 SONNTAG ALUMINUM Y FILTER WITH 3/32 SCREEN
- 8 1 1/4", 2", OR 2 1/2" THREADED PRESSURE REDUCING VALVE, CLA-VAL 90-01 FOR TYPE A. 1 1/4", 2", OR 2 1/2" THREADED PRESSURE REDUCING VALVE, CLA-VAL 990 FOR TYPE B.
- 9 SIZE x 3/4" THREADED GIP TEE
- 10 3/4" THREADED BRASS BALL VALVE WITH 3/4"x1/4" NPT BUSHING AND QUICK COUPLING
- 11 4" 55 GLYCERIN FILLED PRESSURE GAUGE WITH FITTINGS AS REQUIRED. ORIENT GAUGE SO THAT FACE IS CLEARLY VISIBLE FROM VAULT ACCESS OPENING.
- 12 PIPE SUPPORT. SEE DETAIL, SHEET 26.
- 13 SEAL PIPE PENETRATIONS WATERTIGHT WITH NON-SHRINK GROUT
- 14 BRASS GRATED DRAIN WITH KNOCKOUT HOLE FOR DRAIN PIPE. DO NOT PROVIDE DRAIN IN HIGH GROUND WATER AREA.

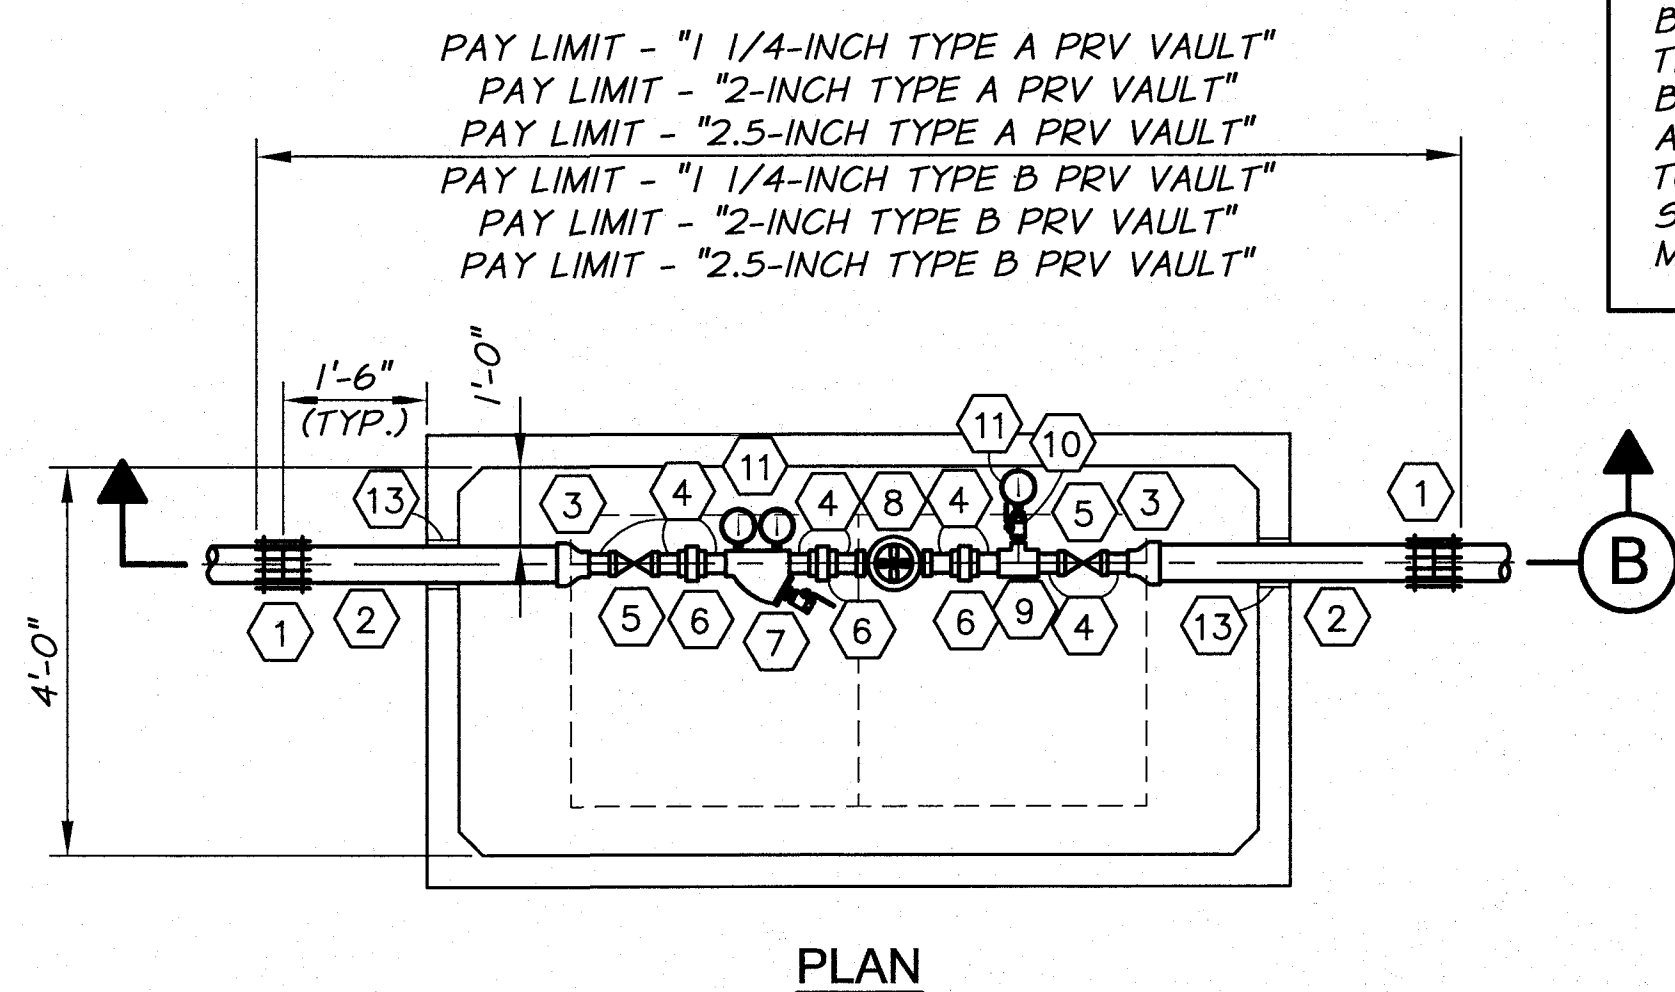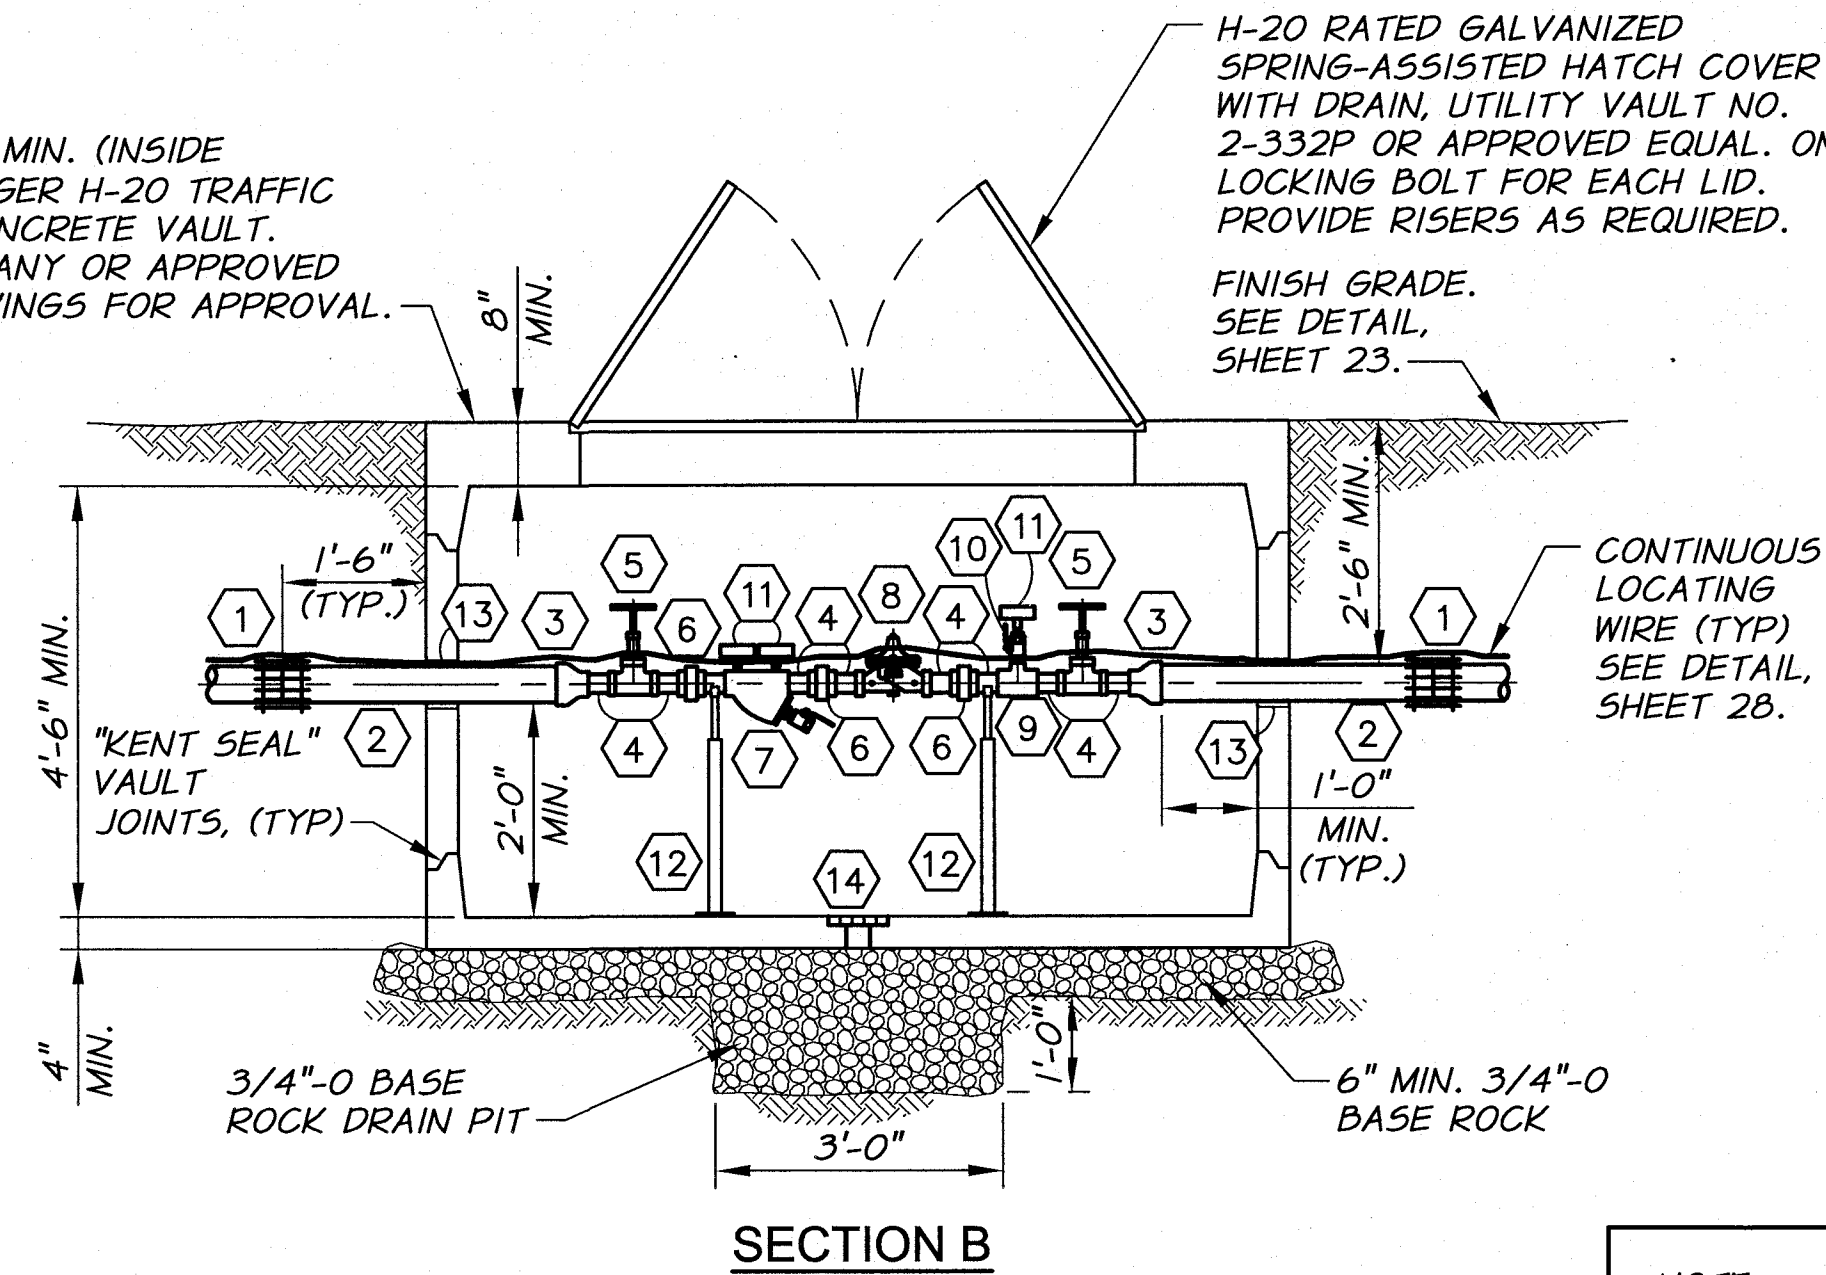


NOTES:
 1. SET FRAME AND COVER TO GRADE AND PROVIDE GRADE RINGS AS REQUIRED.
 2. PIPE SUPPORTS TO BE SIZED APPROPRIATELY FOR PIPE AND INSTALLED PER MANUFACTURER'S RECOMMENDATIONS.
 3. ALL WORK SHOWN IN THIS DETAIL, INCLUDING ANY REQUIRED SURFACE RESTORATION, SHALL BE INCLUDED IN THE "___-INCH TYPE A OR B PRESSURE REDUCING VALVE" PAY ITEM.

1 1/4", 2", AND 2 1/2" PRESSURE REDUCING VALVE VAULT DETAIL

TYPE A OR TYPE B
N.T.S.

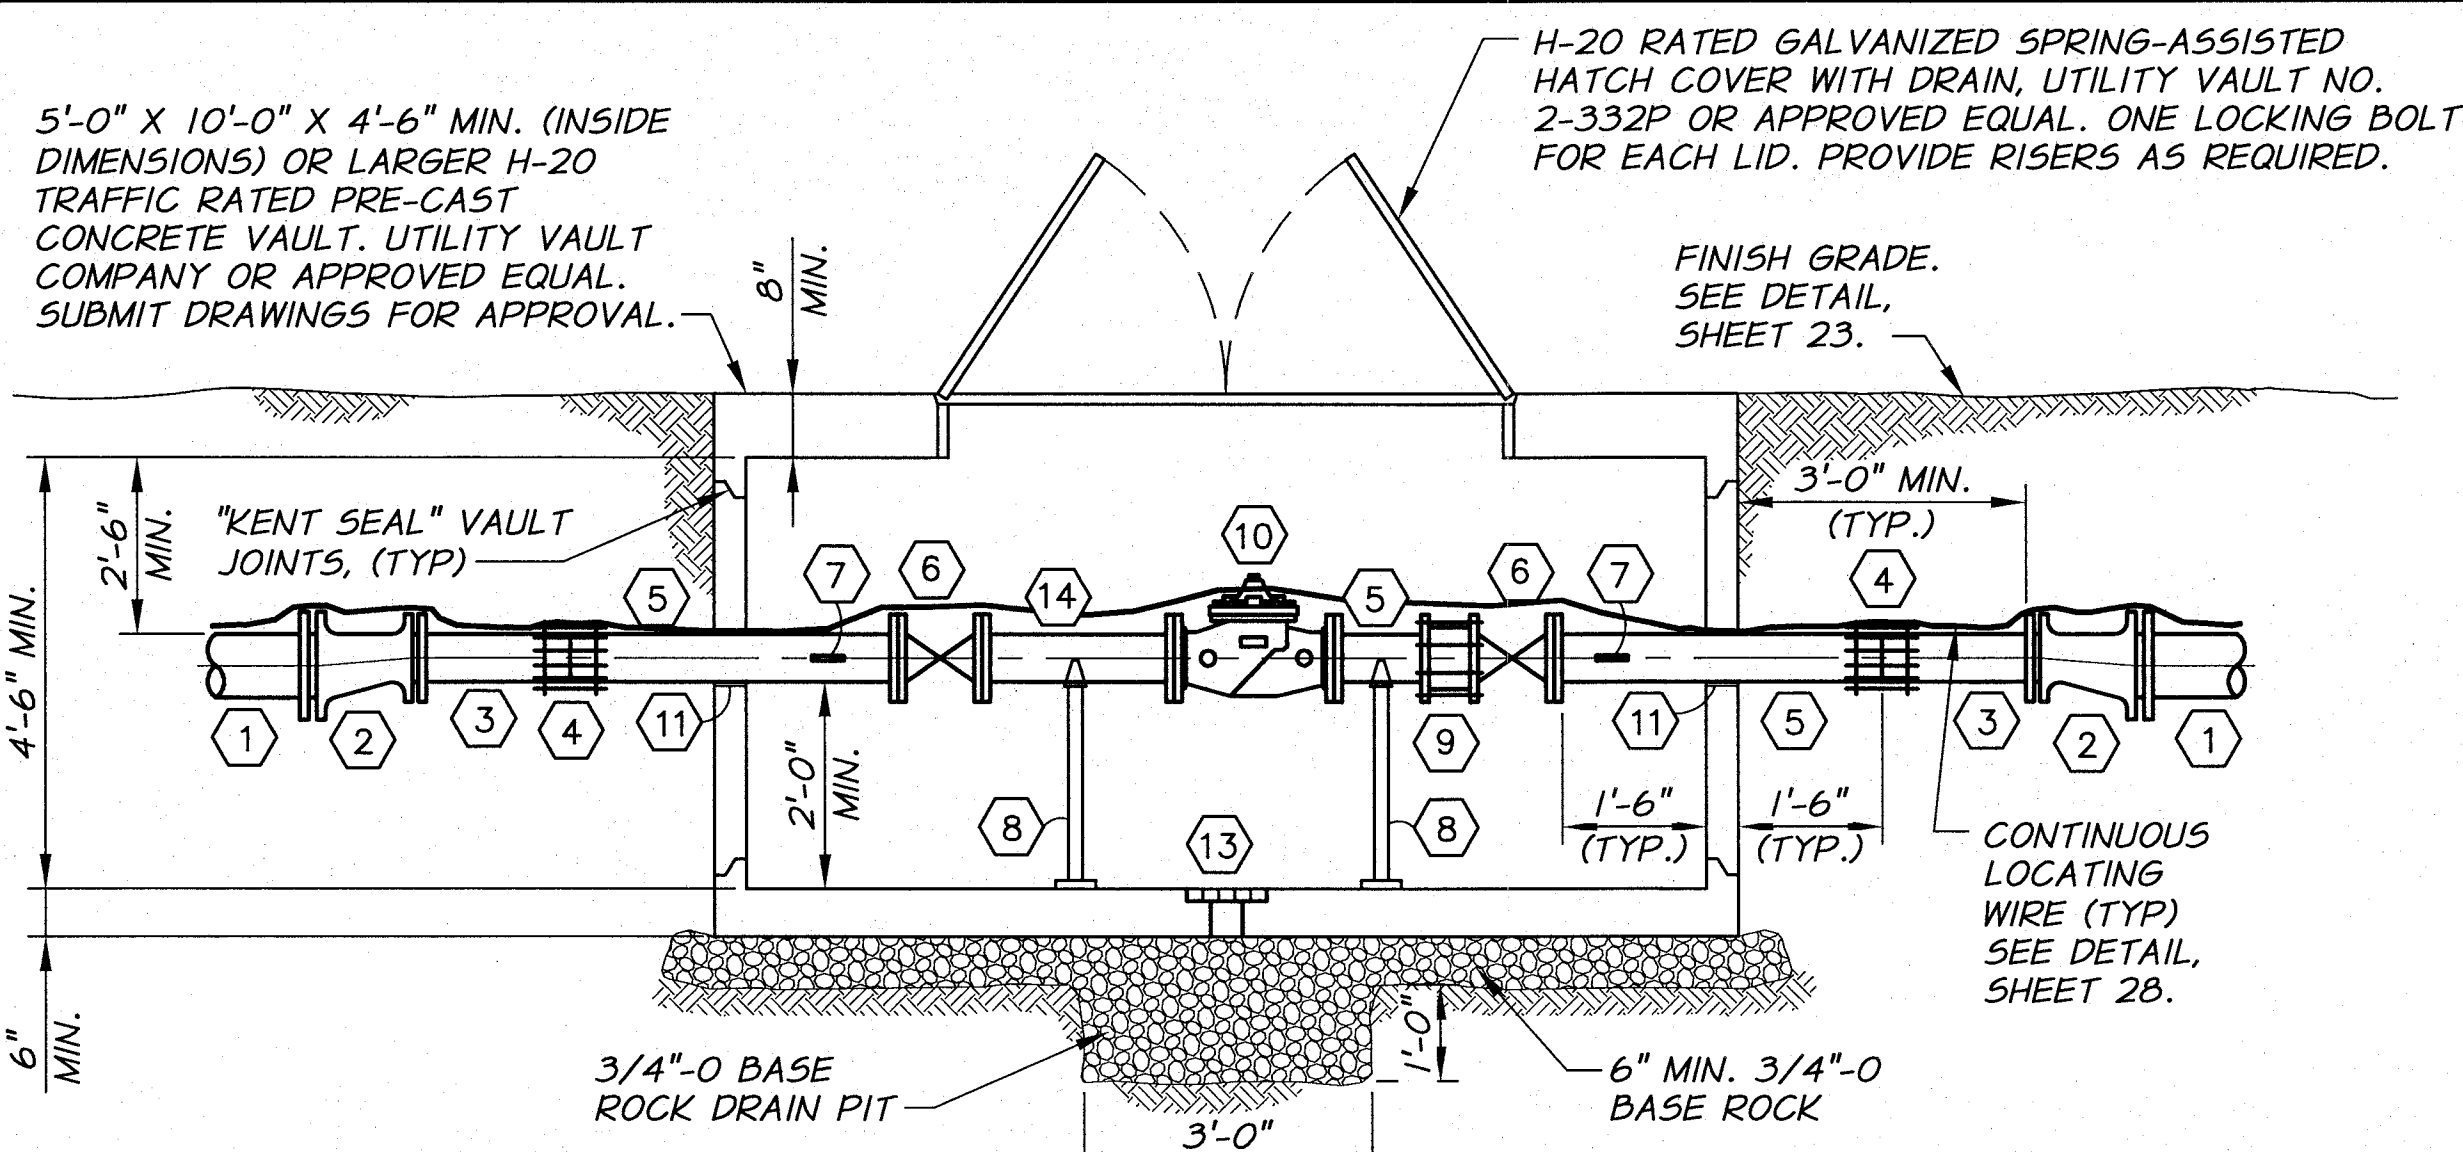

SECTION A

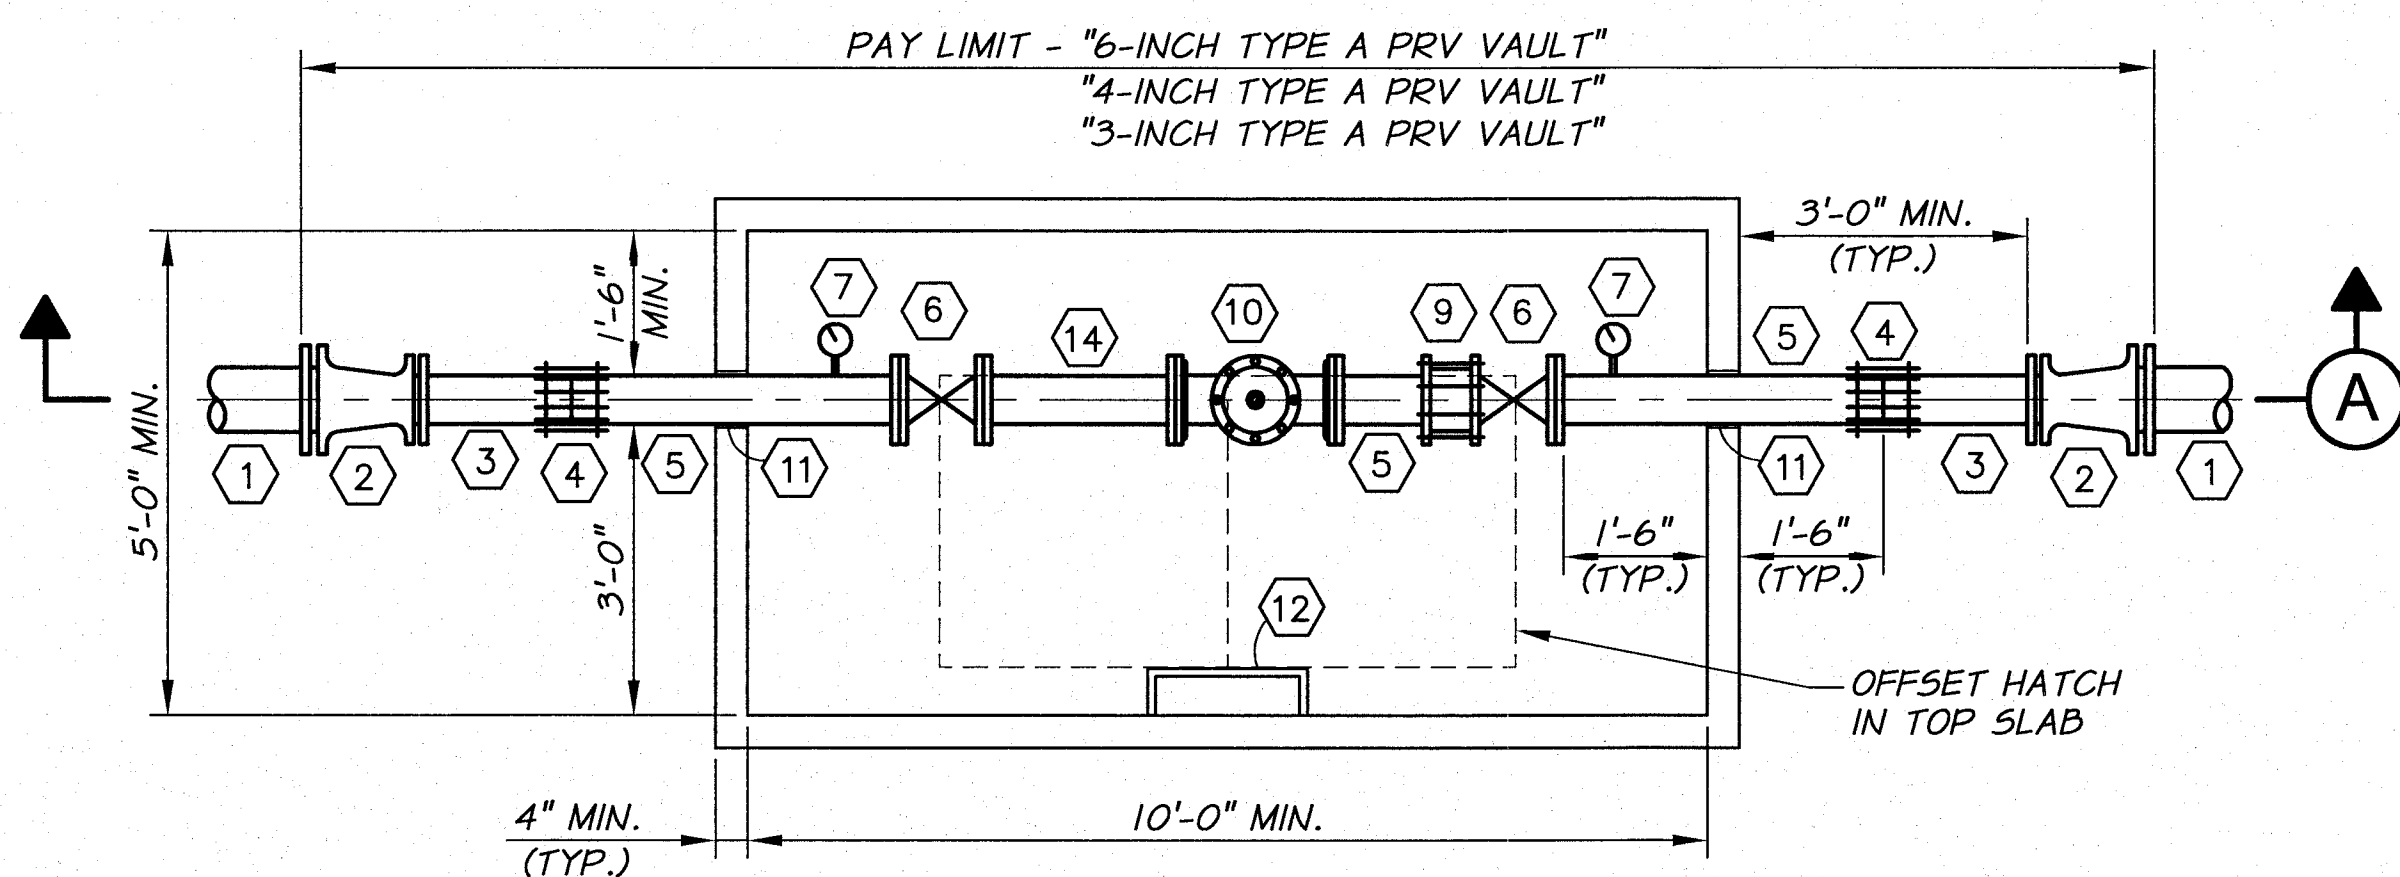

PLAN


NOTES:
 1. PIPING SIZE TO MATCH CONTROL VALVE SIZE UNLESS OTHERWISE NOTED.
 2. SET FRAME AND COVER TO GRADE AND PROVIDE GRADE RINGS AS REQUIRED.
 3. PIPE SUPPORTS TO BE SIZED APPROPRIATELY FOR PIPE AND INSTALLED PER MANUFACTURER'S RECOMMENDATIONS.
 4. ALL WORK SHOWN IN THIS DETAIL, INCLUDING ANY REQUIRED SURFACE RESTORATION, SHALL BE INCLUDED IN THE "___-INCH PRESSURE REDUCING VALVE" PAY ITEM.

FITTING SCHEDULE

- 1 PVC PIPING, SIZE PER MAIN LINE
- 2 MJ ECCENTRIC REDUCER
- 3 PE D.I. SPOOL, LENGTH AS REQUIRED
- 4 COUPLING
- 5 FLG X PE D.I. SPOOL, LENGTH AS REQUIRED
- 6 FLG GATE VALVE WITH HANDWHEEL OPERATOR
- 7 4" S.S. PRESSURE GAUGE, GLYCERIN FILLED, 0-150 P.S.I. WITH 2 P.S.I. GRADUATIONS, ISOLATION VALVE AND FITTINGS AS REQUIRED. TAP D.I. PIPE AS REQUIRED. ORIENT GAUGE SO THAT FACE IS CLEARLY VISIBLE FROM VAULT ACCESS OPENING.
- 8 PIPE SUPPORT. SEE TYPICAL PIPE SUPPORT DETAIL SHEET 26.
- 9 RESTRAINED FLANGE COUPLING ADAPTER
- 10 FLG PRESSURE REDUCING VALVE, CLA-VAL MODEL 90-01 FLANGED, OR APPROVED EQUAL.
- 11 SEAL PIPE PENETRATIONS WATERTIGHT WITH NON-SHRINK GROUT
- 12 OSHA APPROVED GALVANIZED STEEL LADDER WITH 4 FOOT REMOVABLE EXTENSION
- 13 BRASS GRATED DRAIN WITH KNOCKOUT HOLE FOR DRAIN PIPE. DO NOT PROVIDE DRAIN IN HIGH GROUND WATER AREAS.
- 14 FLG DI SPOOL X 2 FT. LONG

3", 4", AND 6" TYPE A PRESSURE REDUCING VALVE VAULT DETAIL

N.T.S.

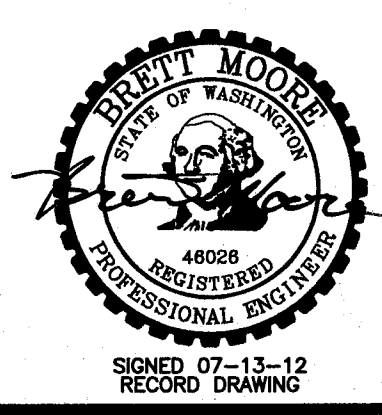

DESIGNED BY	R. HARRIS	DATE	2011
DRAWN BY	D. CHRISTMAN	DATE	2011
REVIEWED BY	B. MOORE	DATE	

REVISION: _____


HORIZ. SCALE: NONE VERT. SCALE: _____

JOB NUMBER: 1199-336 DATE: 2011

ACAD FILE: VaultDets-PH3A.dwg

COPYRIGHT 2011 BY ANDERSON-PERRY & ASSOC., INC.

RECORD DRAWINGS
 These record drawings have been prepared, in part, on the basis of information compiled and furnished by others. They may contain some discrepancies and omissions, and do not necessarily represent "exact" field conditions. The Owner and the Engineer accept no responsibility for their accuracy.

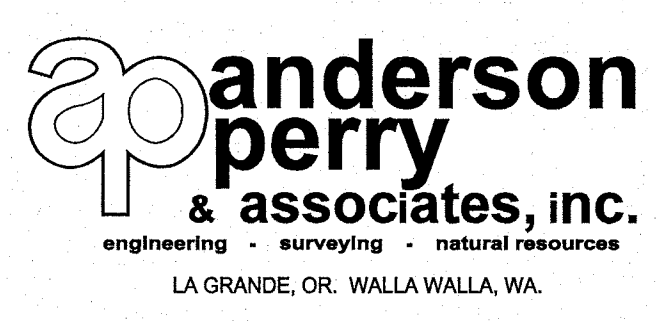

BENTON IRRIGATION DISTRICT
 IRRIGATION SYSTEM IMPROVEMENTS
 PHASE 3A
 VALVE VAULT DETAILS I


H-20 TRAFFIC RATED PRE-CAST CONCRETE VAULT. UTILITY VAULT COMPANY OR APPROVED EQUAL. SUBMIT DRAWINGS FOR APPROVAL. 4'-0" X 8'-6" X 4'-6" MIN. (INSIDE DIMENSIONS) FOR 1 1/4" VALVE AND 4'-0" X 10'-6" X 4'-6" MIN. (INSIDE DIMENSIONS) FOR 2" AND 2 1/2" VALVE

H-20 RATED GALVANIZED SPRING-ASSISTED HATCH COVER WITH DRAIN, UTILITY VAULT NO. 2-332P OR APPROVED EQUAL. ONE LOCKING BOLT FOR EACH LID. PROVIDE RISERS AS REQUIRED.


FINISH GRADE. SEE DETAIL, SHEET 23.

FITTING SCHEDULE

- ① TRANSITION COUPLING
- ② GIP, SIZE AS SHOWN ON PLANS
- ③ THREADED GIP REDUCER WHERE REQUIRED
- ④ 1 1/4", 2", OR 2 1/2" THREADED GIP
- ⑤ BRASS THREADED GATE VALVE
- ⑥ GIP UNION
- ⑦ SONNTAG ALUMINUM Y FILTER WITH 3/32 SCREEN
- ⑧ 1 1/4", 2" OR 2 1/2" THREADED PRESSURE REDUCING VALVE, CLA-VAL 90-01 FOR TYPE A, 1 1/4", 2", OR 2 1/2" THREADED PRESSURE REDUCING VALVE, CLA-VAL 990 FOR TYPE B.
- ⑨ SIZE x 3/4" THREADED GIP TEE
- ⑩ 3/4" THREADED BRASS BALL VALVE WITH 3/4"x1/4" NPT BUSHING AND QUICK COUPLING
- ⑪ 4" 55 GLYCERIN FILLED PRESSURE GAUGE WITH FITTINGS AS REQUIRED. ORIENT GAUGE SO THAT FACE IS CLEARLY VISIBLE FROM VAULT ACCESS OPENING.
- ⑫ PIPE SUPPORT. SEE DETAIL, SHEET 26.
- ⑬ SEAL PIPE PENETRATIONS WATERTIGHT WITH NON-SHRINK GROUT
- ⑭ BRASS GRATED DRAIN WITH KNOCKOUT HOLE FOR DRAIN PIPE. DO NOT PROVIDE DRAIN IN HIGH GROUND WATER AREA.
- ⑮ DOLE FLOW CONTROL VALVE. SIZE AS SHOWN ON PLANS
- ⑯ THREADED RAISED FACE FLANGE WITH GASKET MATCHING FACE OF FLANGE. 4 EA. STAINLESS STEEL BOLTS AND NUTS. BOLT LENGTH AS REQUIRED TO PASS THROUGH ALL FLANGES.

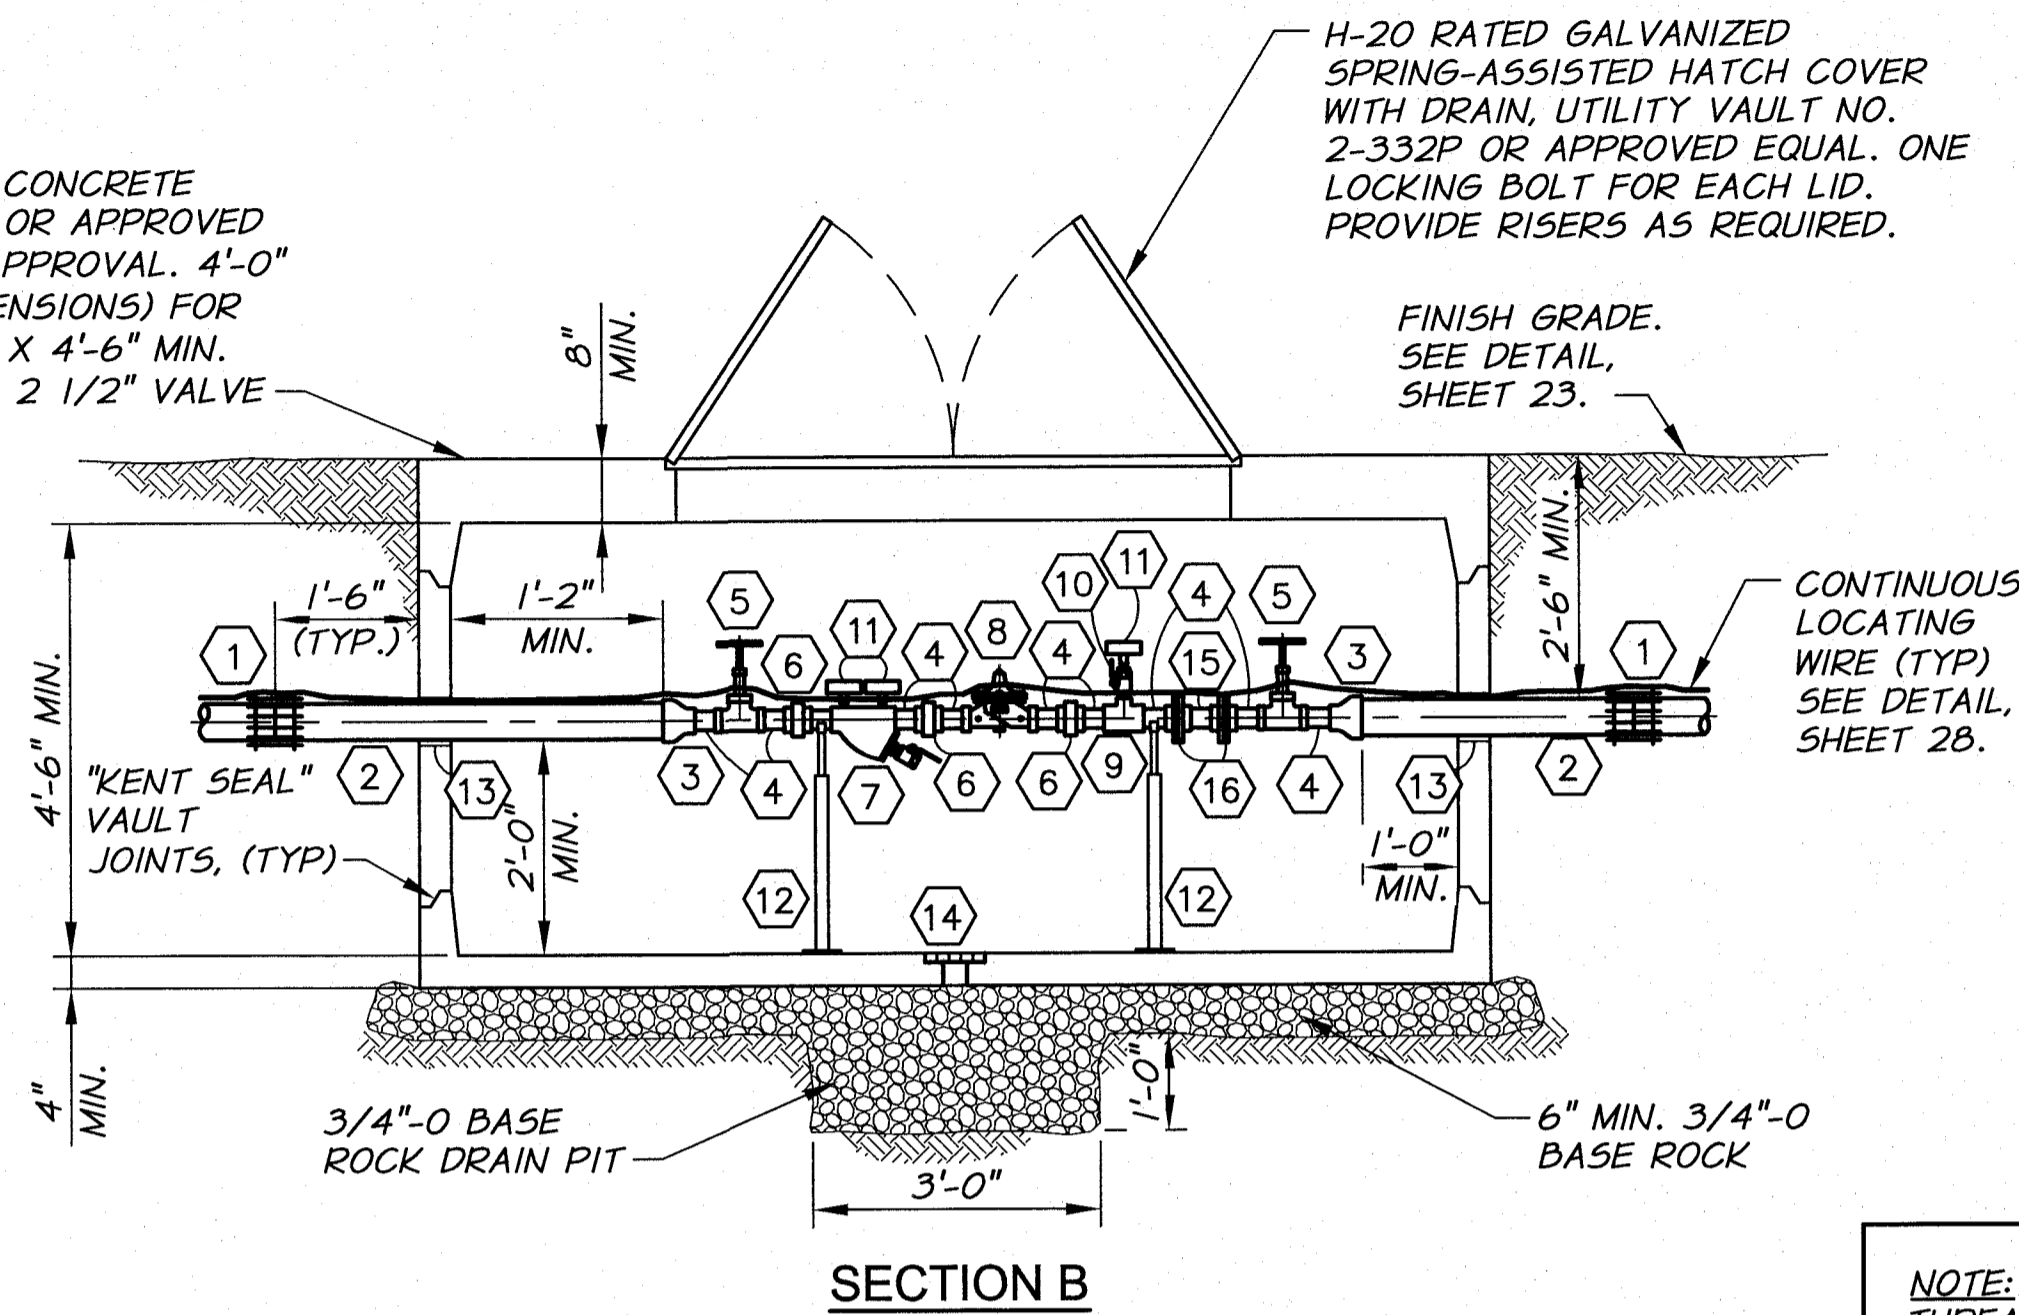

PAY LIMIT - "1 1/4-INCH TYPE A PRV VAULT WITH DOLE"
 PAY LIMIT - "2-INCH TYPE A PRV VAULT WITH DOLE"
 PAY LIMIT - "2.5-INCH TYPE A PRV VAULT WITH DOLE"
 PAY LIMIT - "1 1/4-INCH TYPE B PRV VAULT WITH DOLE"
 PAY LIMIT - "2-INCH TYPE B PRV VAULT WITH DOLE"
 PAY LIMIT - "2.5-INCH TYPE B PRV VAULT WITH DOLE"

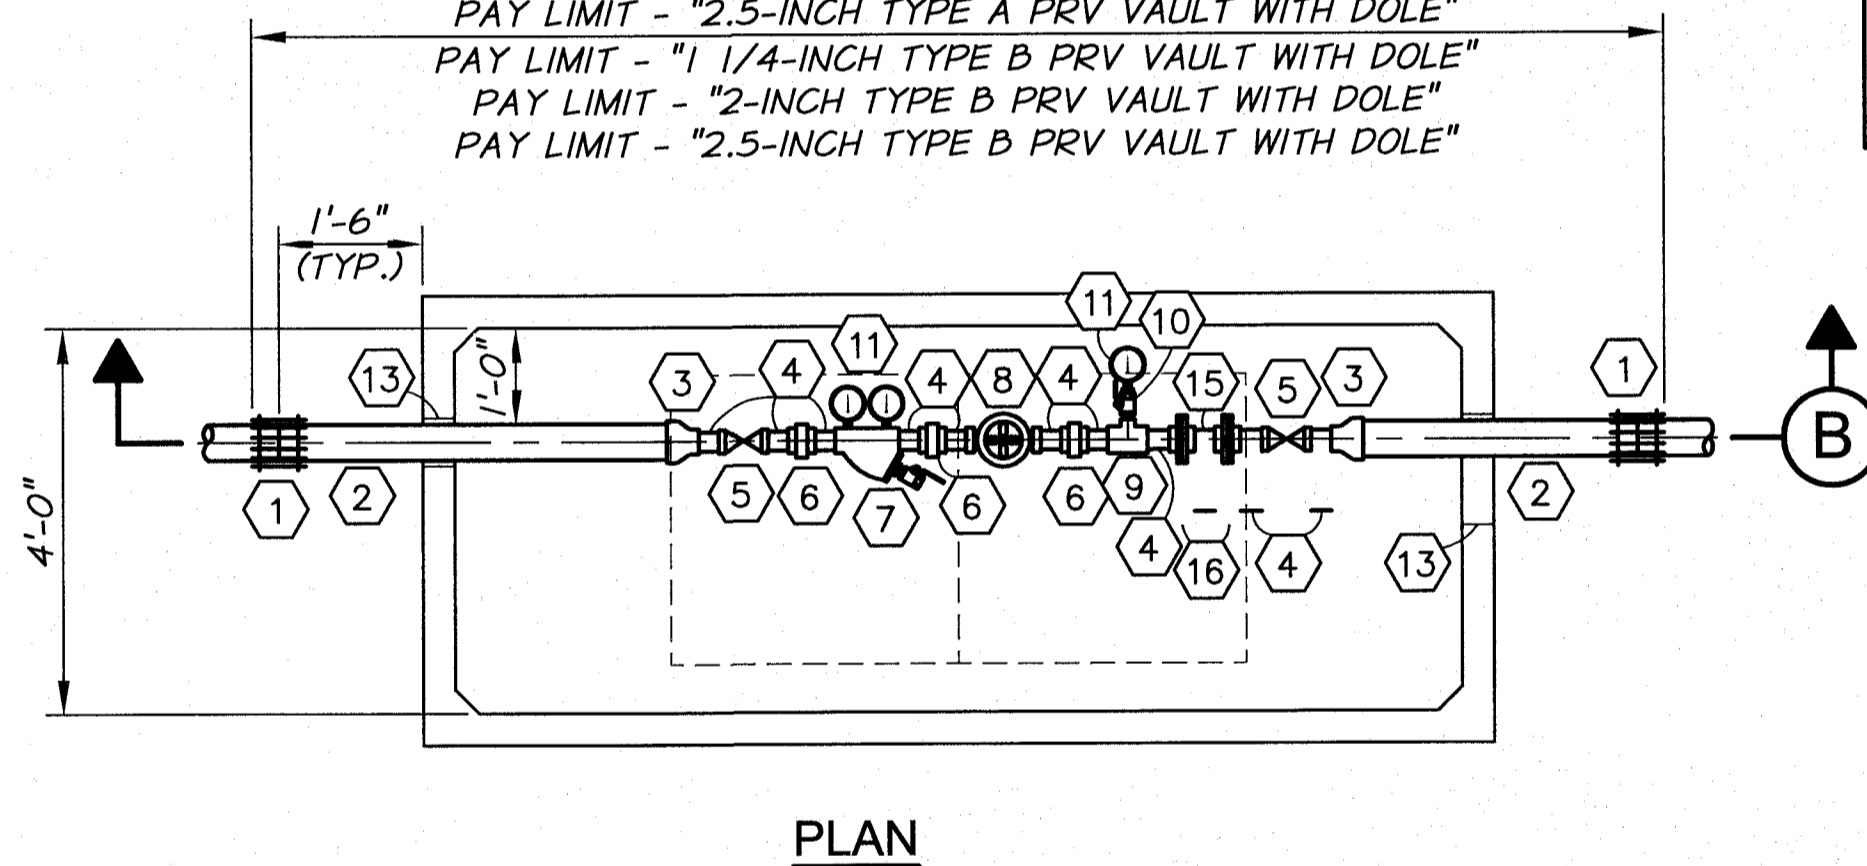

- NOTES:**
1. SET FRAME AND COVER TO GRADE AND PROVIDE GRADE RINGS AS REQUIRED.
 2. PIPE SUPPORTS TO BE SIZED APPROPRIATELY FOR PIPE AND INSTALLED PER MANUFACTURER'S RECOMMENDATIONS.
 3. ALL WORK SHOWN IN THIS DETAIL, INCLUDING ANY REQUIRED SURFACE RESTORATION, SHALL BE INCLUDED IN THE "1-INCH TYPE A OR B PRV VAULT WITH DOLE" PAY ITEM.



1 1/4", 2", AND 2 1/2" PRV VAULT WITH DOLE FCV DETAIL

TYPE A OR TYPE B
 N.T.S.

H-20 TRAFFIC RATED PRE-CAST CONCRETE VAULT. UTILITY VAULT COMPANY OR APPROVED EQUAL. SUBMIT DRAWINGS FOR APPROVAL. 4'-6" X 10'-0" X 4'-6" MIN. (INSIDE DIMENSIONS)

H-20 RATED GALVANIZED SPRING-ASSISTED HATCH COVER WITH DRAIN, UTILITY VAULT NO. 2-332P OR APPROVED EQUAL. ONE LOCKING BOLT FOR EACH LID. PROVIDE RISERS AS REQUIRED.

FINISH GRADE. SEE DETAIL, SHEET 23.

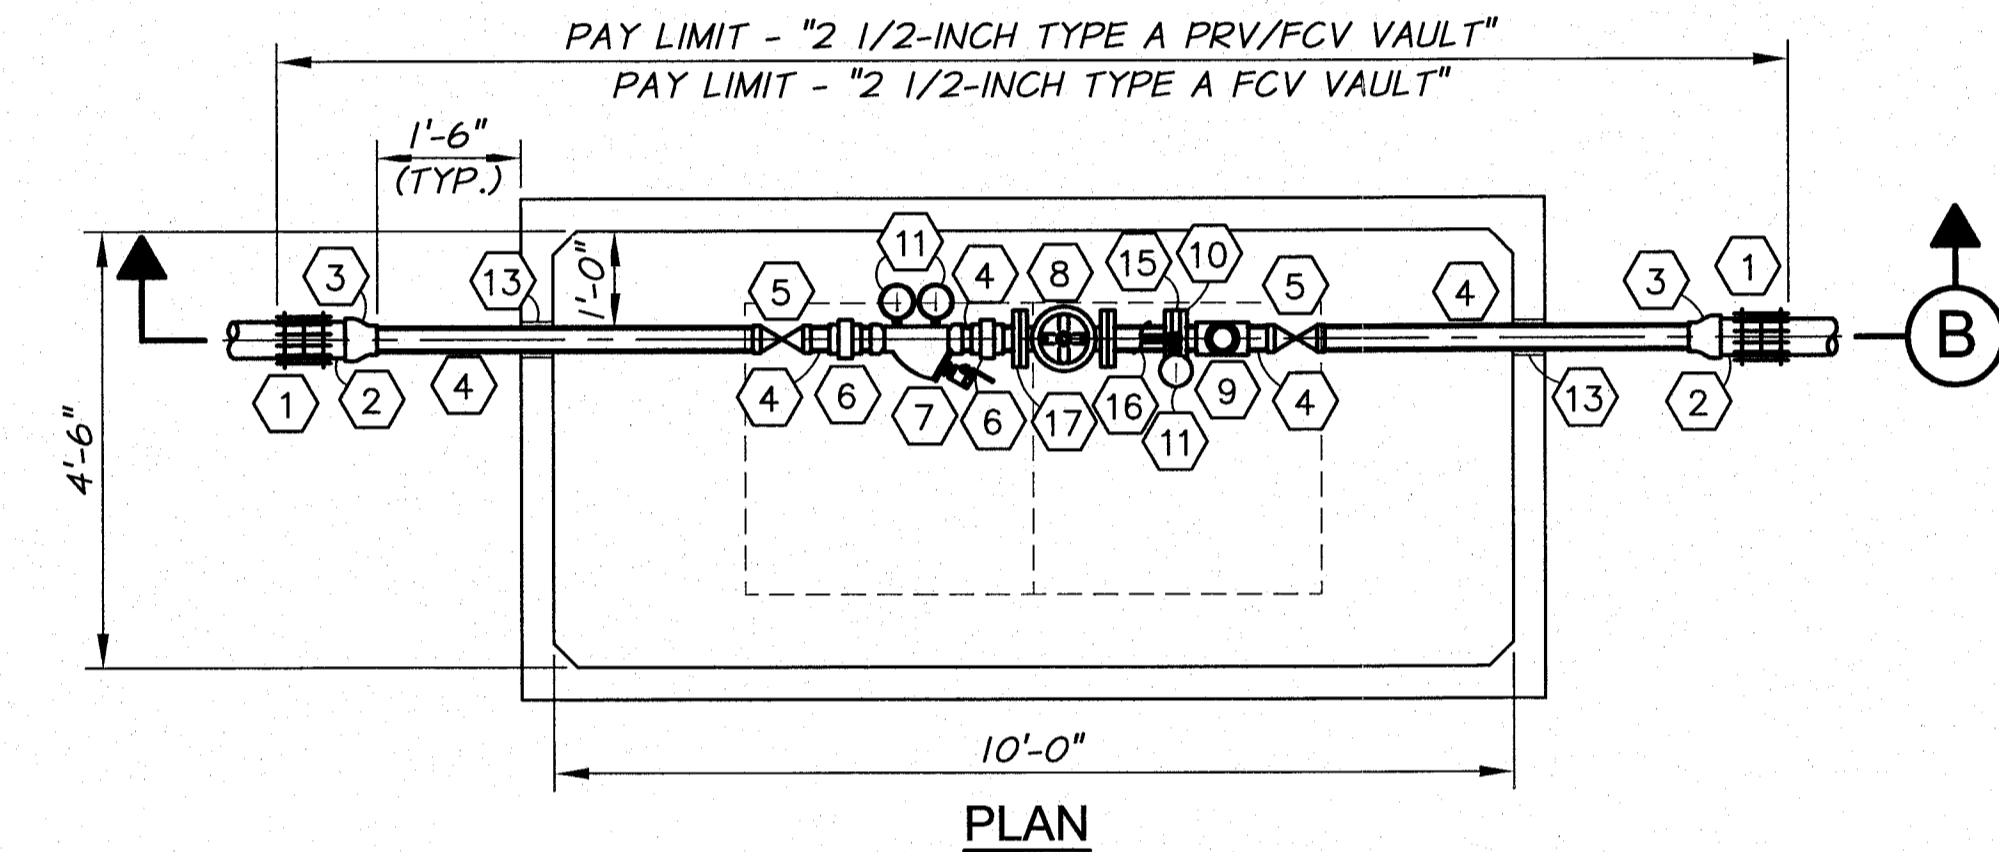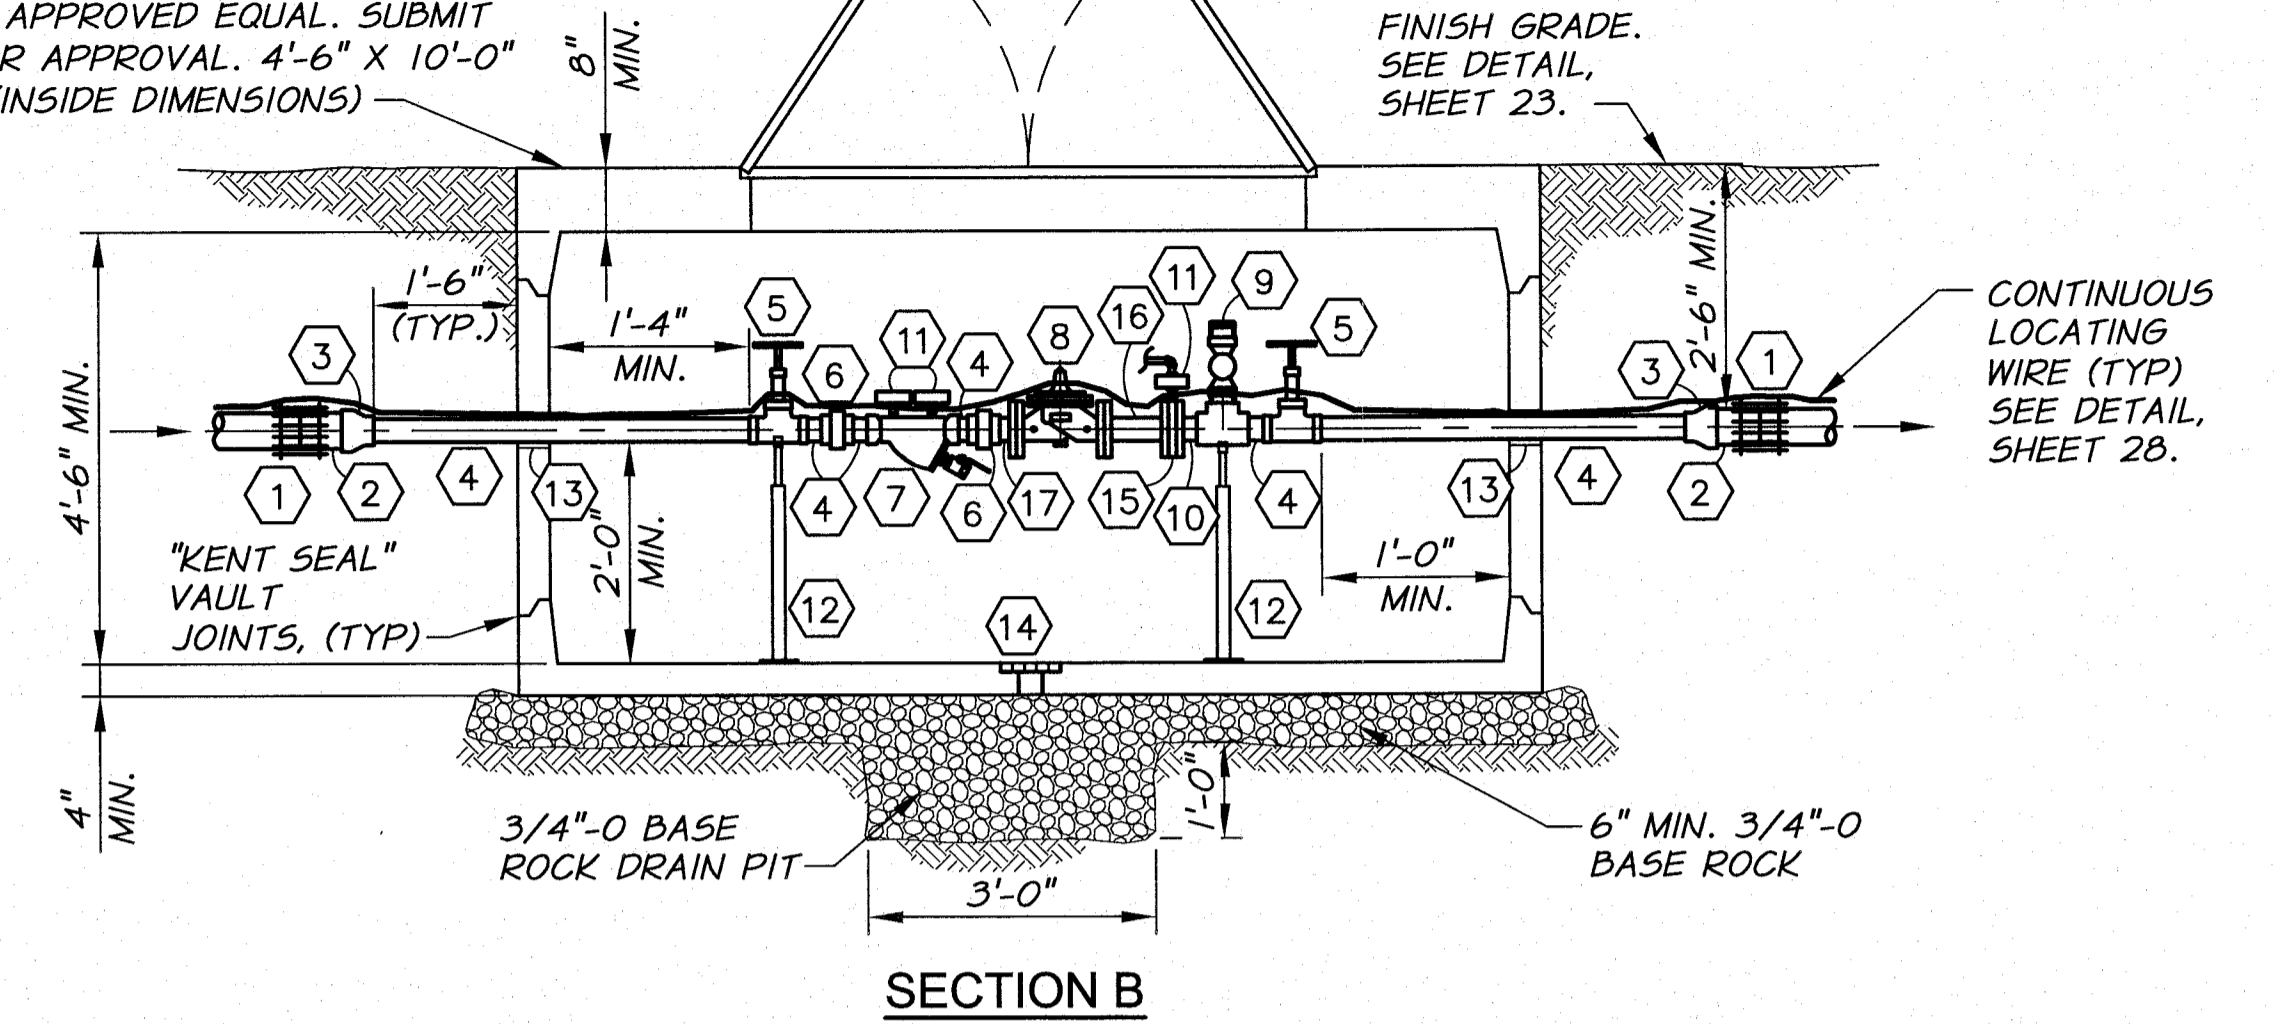


- NOTES:**
1. SET FRAME AND COVER TO GRADE AND PROVIDE GRADE RINGS AS REQUIRED.
 2. PIPE SUPPORTS TO BE SIZED APPROPRIATELY FOR PIPE AND INSTALLED PER MANUFACTURER'S RECOMMENDATIONS.
 3. ALL WORK SHOWN IN THIS DETAIL, INCLUDING ANY REQUIRED SURFACE RESTORATION, SHALL BE INCLUDED IN THE PAY ITEM.

FITTING SCHEDULE

- ① TRANSITION COUPLING
- ② GIP, SIZE AS SHOWN ON PLANS
- ③ THREADED GIP REDUCER WHERE REQUIRED
- ④ 2 1/2" THREADED GIP
- ⑤ BRASS THREADED GATE VALVE
- ⑥ GIP UNION AND BUSHINGS AS REQUIRED
- ⑦ 3" SONNTAG ALUMINUM Y FILTER WITH 3/32 SCREEN, FITTINGS AS REQUIRED
- ⑧ 2 1/2" FLANGED PRESSURE REDUCING/FLOW CONTROL VALVE, CLA-VAL MODEL 496-01AB. FOR FLOW CONTROL ONLY, USE CLA-VAL MODEL 406-01AB.
- ⑨ THREADED 2 1/2" GIP TEE WITH BALL VALVE, GIP, AND CAM-LOCK ADAPTER AND CAP
- ⑩ RAISED FACE FLANGE X THREADED GIP SPOOL
- ⑪ 4" 55 GLYCERIN FILLED PRESSURE GAUGE AND ISOLATION VALVE WITH FITTINGS AS REQUIRED ON ORIFICE PILOT PIPING. ORIENT GAUGE SO THAT FACE IS CLEARLY VISIBLE FROM VAULT ACCESS OPENING.
- ⑫ PIPE SUPPORT. SEE DETAIL, SHEET 26.
- ⑬ SEAL PIPE PENETRATIONS WATERTIGHT WITH NON-SHRINK GROUT
- ⑭ BRASS GRATED DRAIN WITH KNOCKOUT HOLE FOR DRAIN PIPE. DO NOT PROVIDE DRAIN IN HIGH GROUND WATER AREA.
- ⑮ ORIFICE PLATE
- ⑯ FLG X RAISED FACE FLG GIP SPOOL X 8" LG.
- ⑰ FLG X THREADED GIP SPOOL

2 1/2" TYPE A PRV/FCV AND FCV VAULT DETAIL


N.T.S.

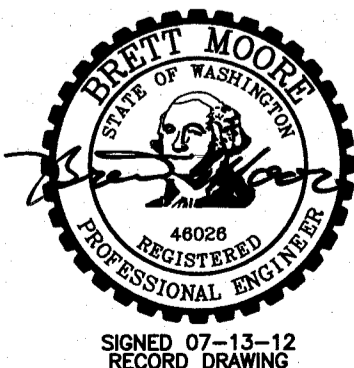

DESIGNED BY	R. HARRIS	DATE	2011
DRAWN BY	D. CHRISTMAN	JOB NUMBER	1199-336
REVIEWED BY	D. MOORE	ACAD FILE	VaultDets-PH3A.dwg
COPYRIGHT 2011 BY ANDERSON-PERRY & ASSOC., INC.			

RECORD DRAWINGS

These record drawings have been prepared, in part, on the basis of information compiled and furnished by others. They may contain some discrepancies and omissions, and do not necessarily represent "exact" field conditions. The Owner and the Engineer accept no responsibility for their accuracy.

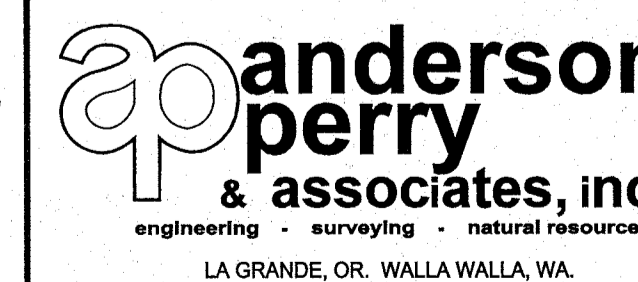



**BENTON IRRIGATION DISTRICT
 IRRIGATION SYSTEM IMPROVEMENTS
 PHASE 3A**

VALVE VAULT DETAILS II

SHEET

22



ARCHIVED

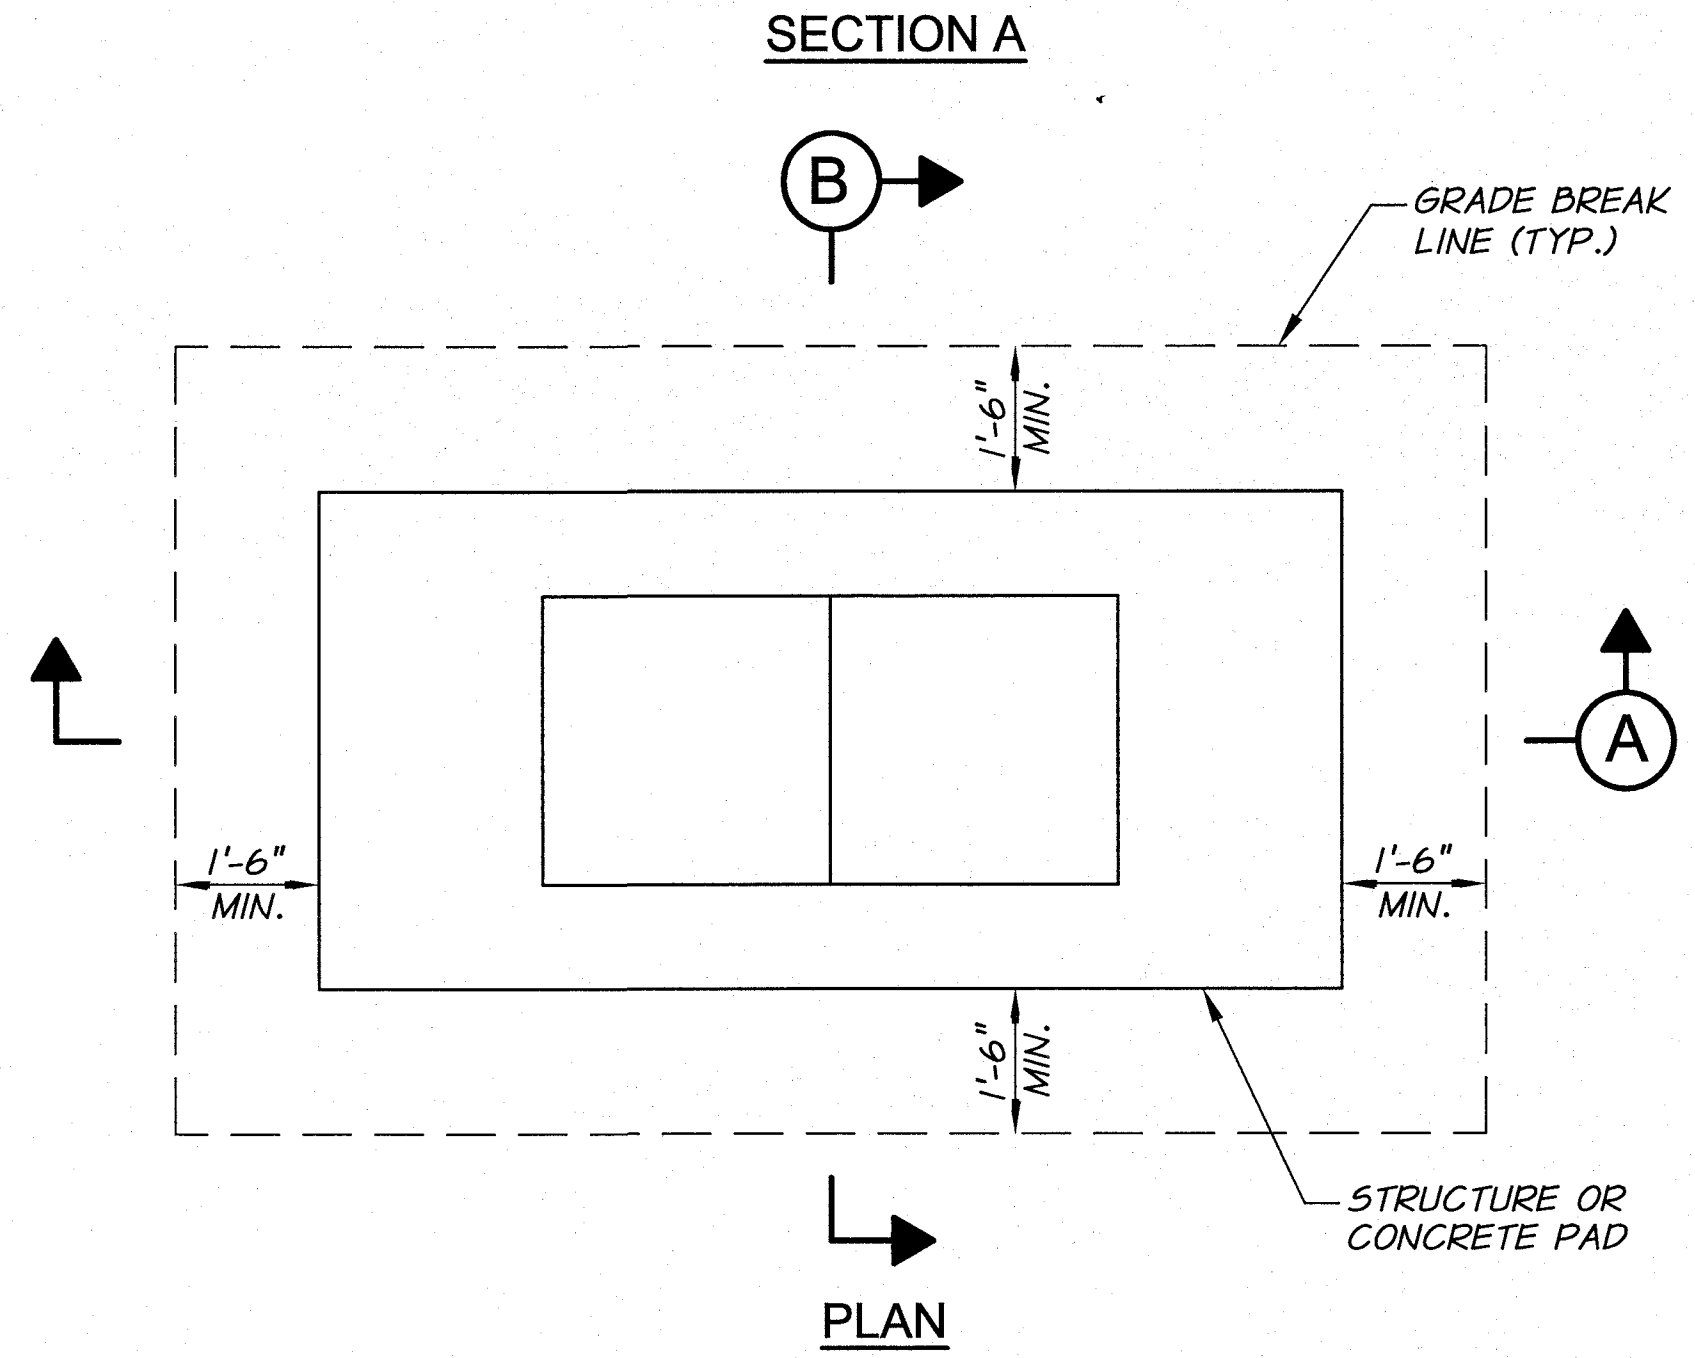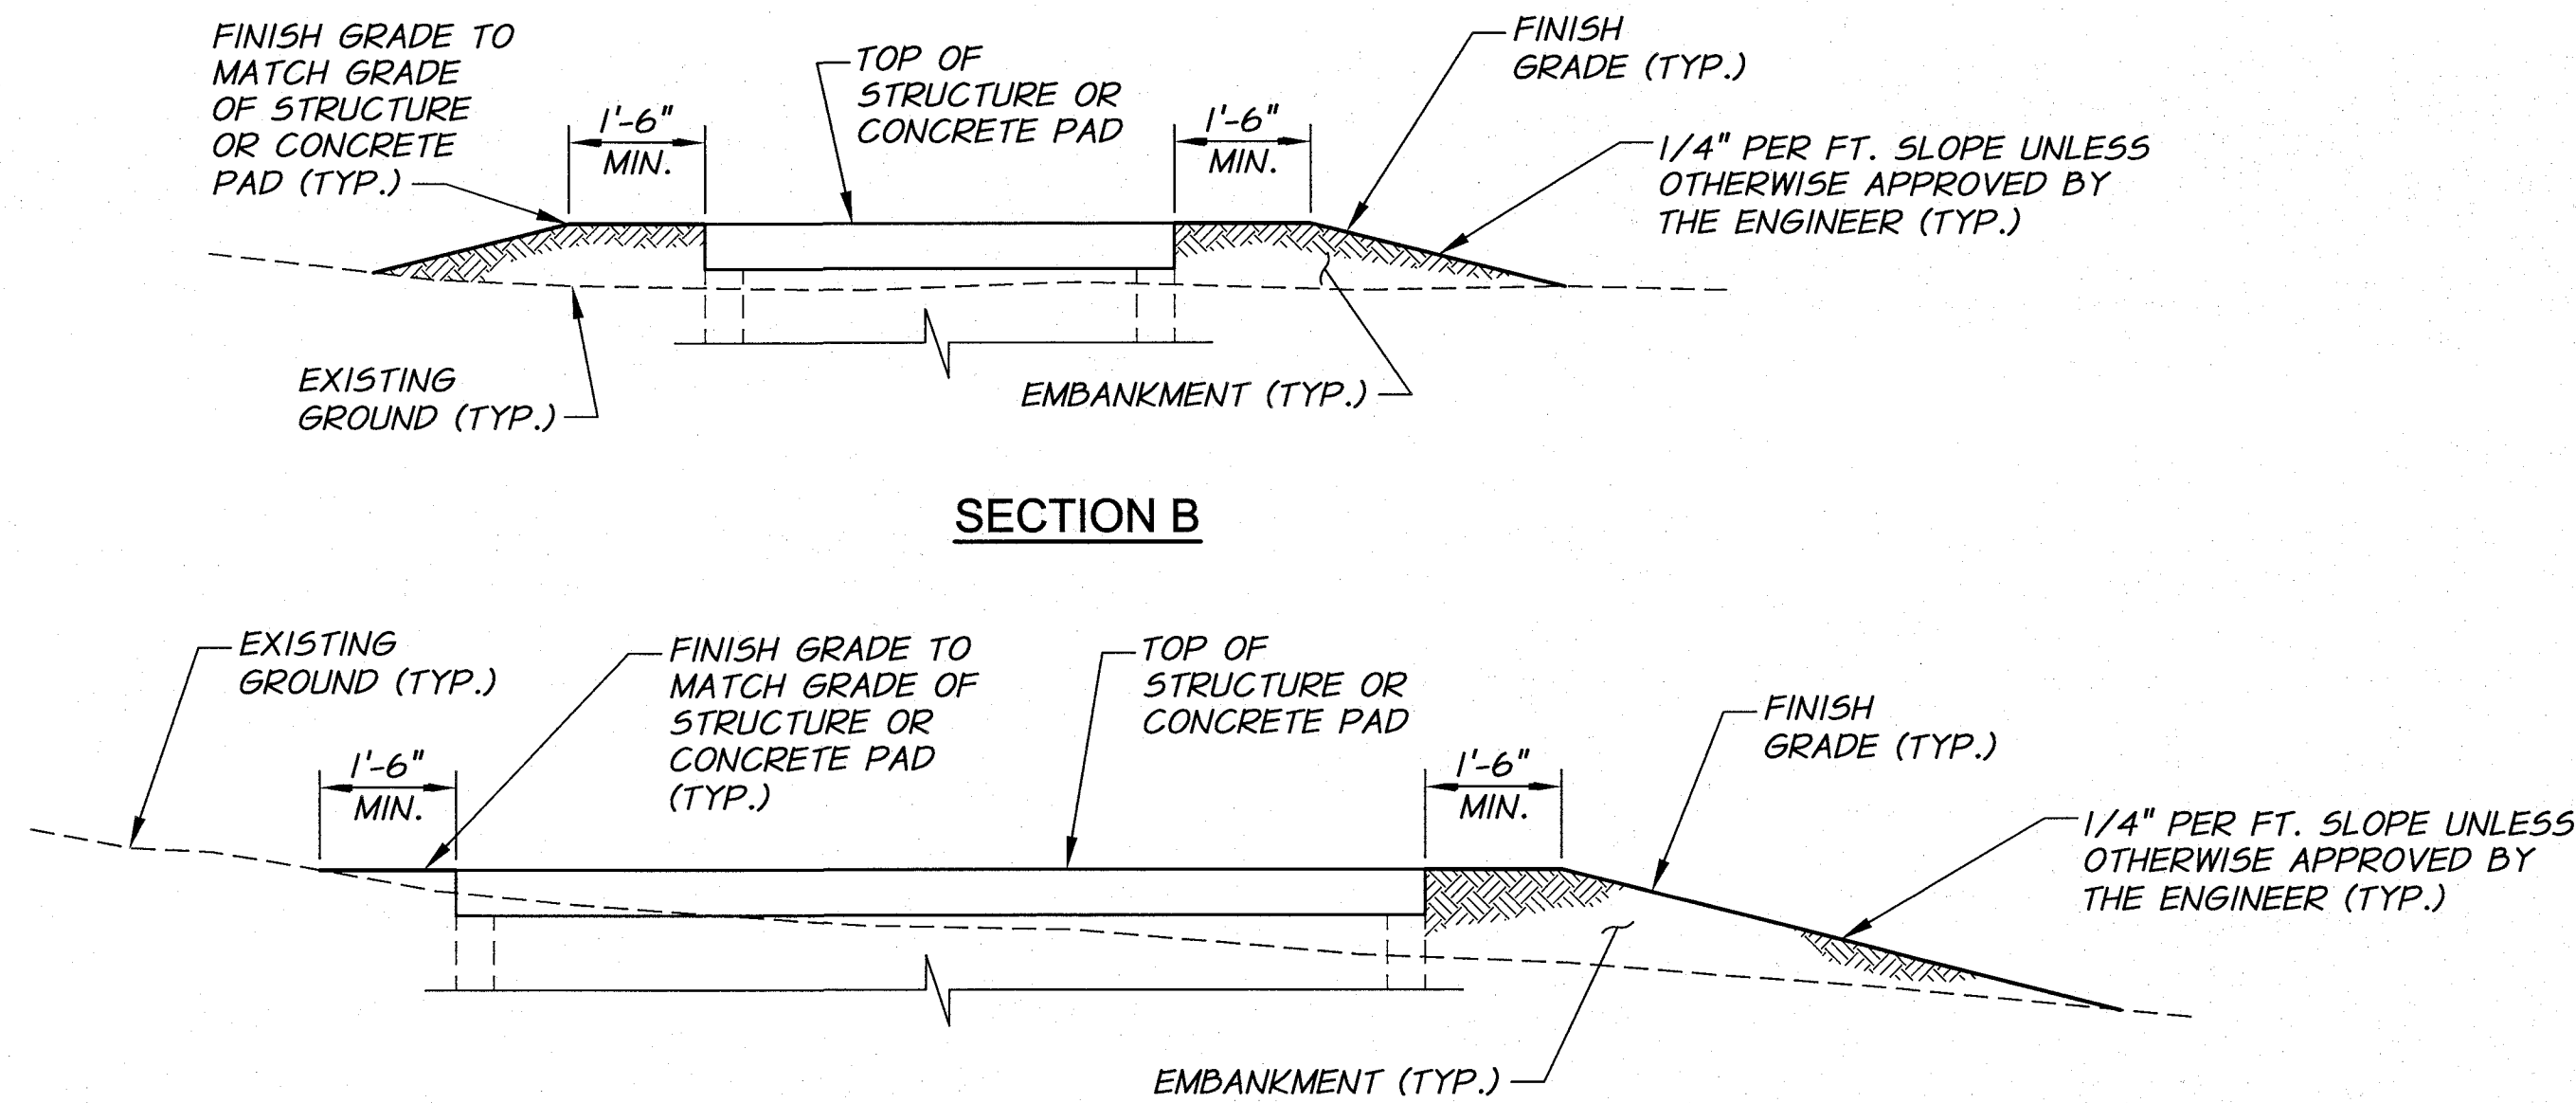


GRADING DETAIL
N.T.S.

FITTING SCHEDULE

- 51 PVC MAIN PIPING
- 52 COUPLING ADAPTER
- 53 GIP, SIZE OF MAIN
- 54 BRASS THREADED GATE VALVE
- 55 THREADED RAISED FACE FLANGE WITH GASKET MATCHING FACE OF FLANGE. 4 EA. STAINLESS STEEL BOLTS AND NUTS. BOLT LENGTH AS REQUIRED TO PASS THROUGH ALL FLANGES.
- 56 DOLE FLOW CONTROL VALVE, SIZE SPECIFIED ON DRAWINGS
- 57 54" PRECAST MANHOLE WITH H2O TRAFFIC RATED FLAT TOP AND 24" MANHOLE COVER WITH FRAME CAST INTO SLAB
- 58 SEAL PIPE PENETRATIONS WATERTIGHT WITH NON-SHRINK GROUT

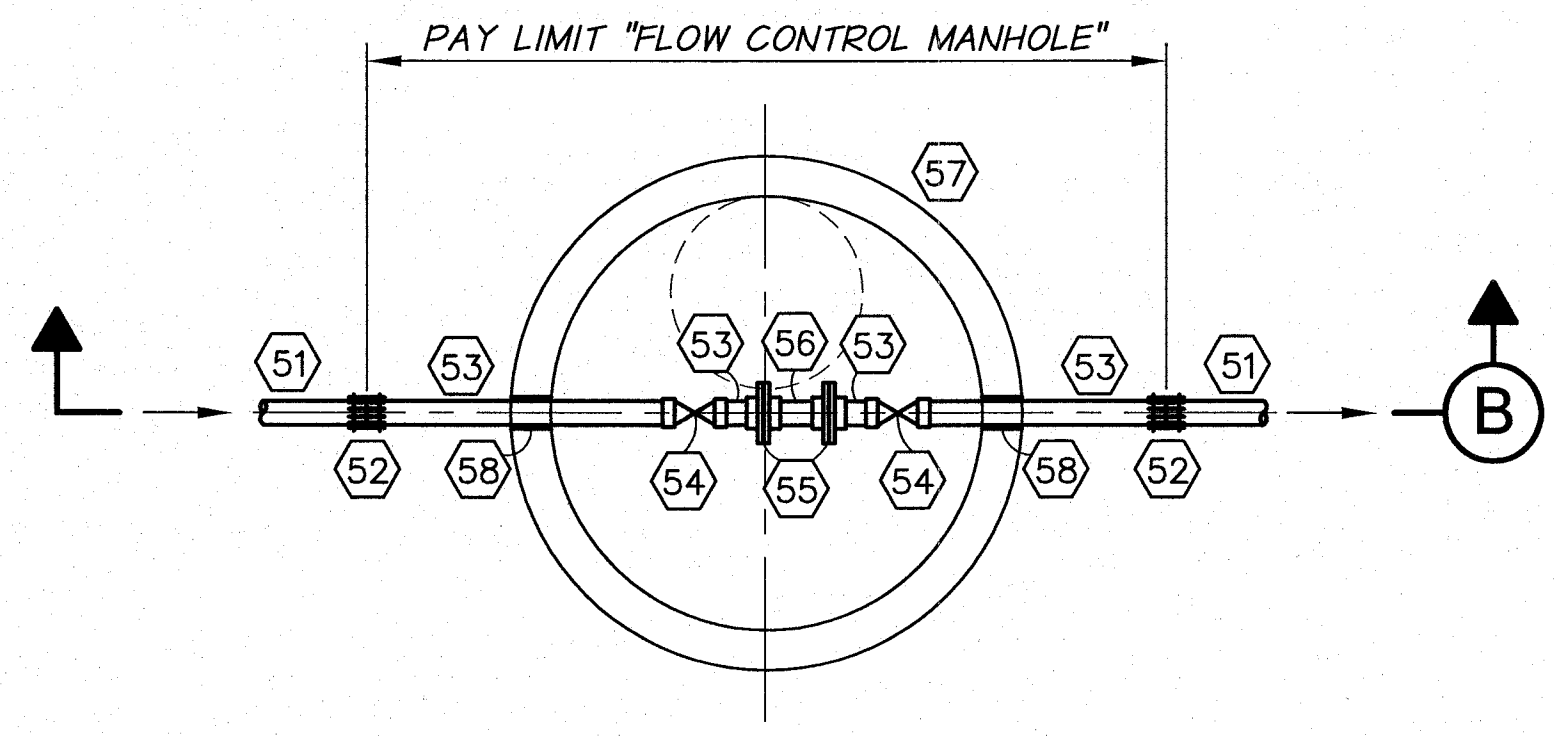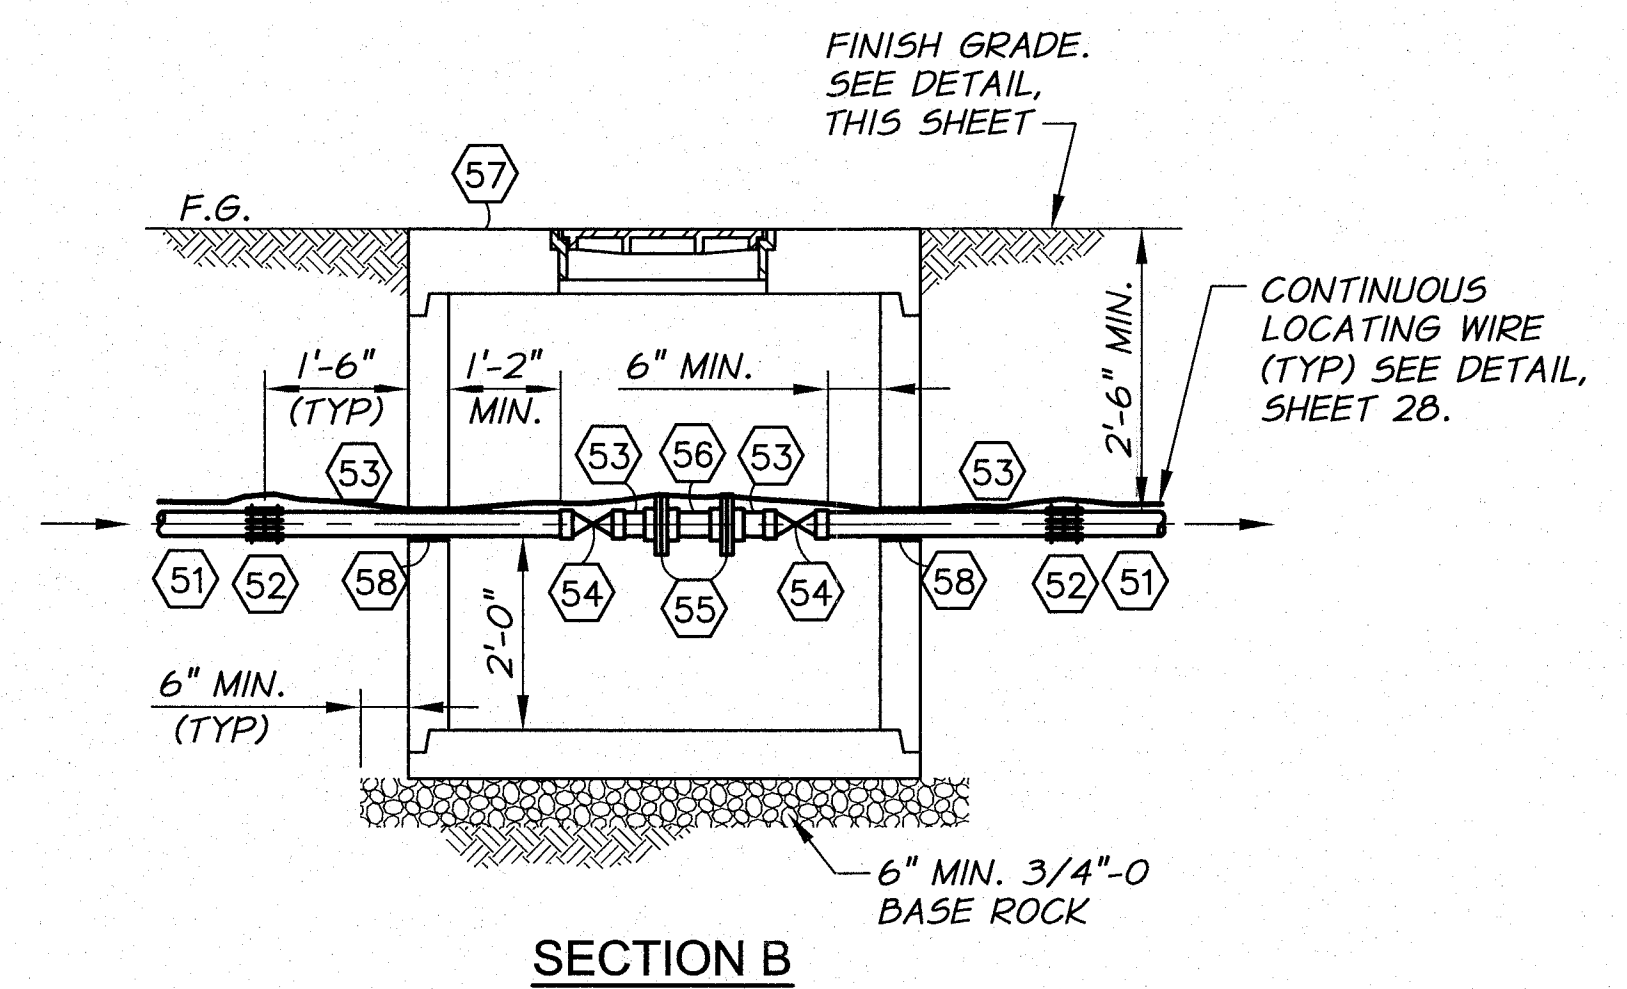


FLOW CONTROL MANHOLE DETAIL
N.T.S.

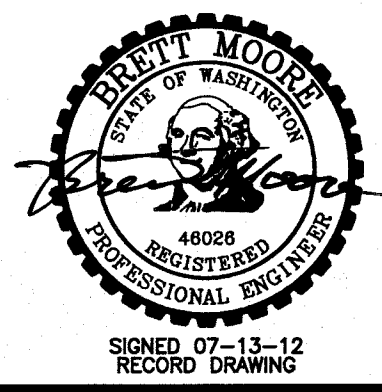

DESIGNED BY	R. HARRIS	JOB NUMBER	1199-336	DATE	2011
DRAWN BY	D. CHRISTMAN	ACAD FILE	VaultDets-PH3A.dwg		
REVIEWED BY	B. MOORE	COPYRIGHT 2011 BY ANDERSON-PERRY & ASSOC., INC.			

RECORD DRAWINGS
These record drawings have been prepared, in part, on the basis of information compiled and furnished by others. They may contain some discrepancies and omissions, and do not necessarily represent "exact" field conditions. The Owner and the Engineer accept no responsibility for their accuracy.

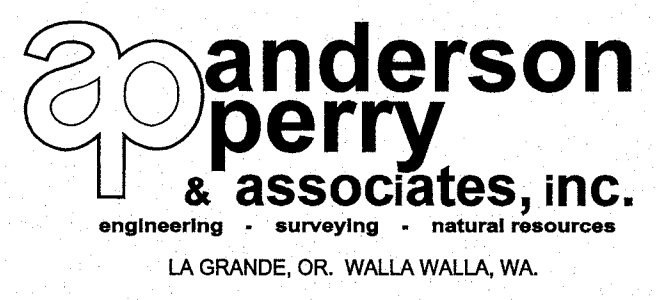


BENTON IRRIGATION DISTRICT
IRRIGATION SYSTEM IMPROVEMENTS
PHASE 3A
VALVE VAULT DETAILS III


FITTING SCHEDULE

- 1 SERVICE LINE PVC PIPING
- 2 MJ ECCENTRIC REDUCER
- 3 CLASS 200 PVC PIPING (SAME SIZE AS CONTROL VALVE)
- 4 MJ GATE VALVE WITH VALVE BOX. SEE DETAIL, SHEET 28.
- 5 COUPLING
- 6 FLG X PE D.I. SPOOL, LENGTH AS REQUIRED (SAME SIZE AS CONTROL VALVE)
- 7 FOR 3" STATION: 3" FLG DI SPOOL X 1'-8" LG. FOR 4" STATION: 4" FLG GIP SPOOL X 4'-0" LG. FOR 6" STATION: 6" FLG DI SPOOL X 4'-0" LG. FOR 8" STATION: 8" FLG DI SPOOL X 4'-0" LG.
- 8 FOR 3" STATION: 3" MICROMETER FLOWMETER MODEL MW500 FOR 4" STATION: 4" MICROMETER FLOWMETER MODEL LP22 FOR 6" STATION: 6" MICROMETER FLOWMETER MODEL LP32 FOR 8" STATION: 8" MICROMETER FLOWMETER MODEL LP32
- 9 FOR PRV/FCV SERVICE ONLY: 3/4" TAPPING SADDLE WITH 3/4" THREADED BRASS BALL VALVE, 3/4"x1/4" BUSHING, AND BRASS QUICK COUPLING PLUG (UNVALVED)
- 10 CLA-VAL 40-01 FLOW CONTROL OR 49-01 COMBINATION FLOW CONTROL AND PRESSURE REDUCING VALVE, TYPE AS SHOWN ON PLANS. SEE TABLE 1, THIS SHEET, AND SPECIFICATIONS FOR DETAILS.
- 11 RESTRAINED FLANGE COUPLING ADAPTER
- 12 BRASS QUICK COUPLING PLUG (UNVALVED) AND FITTINGS AS REQUIRED ON ORIFICE PILOT PIPING. PROVIDE ADDITIONAL ISOLATION VALVE.
- 13 PE DI SPOOL LENGTH AS REQUIRED (SAME SIZE AS CONTROL VALVE)
- 14 FLANGE COUPLING ADAPTER AND FITTINGS AS REQUIRED
- 15 FLG SIZE x SIZE x SIZE TEE, BRANCH NOT TO EXCEED 6"
- 16 FLG x MJ GATE VALVE WITH VALVE BOX. SEE DETAIL, SHEET 28.
- 17 ORIFICE PLATE
- 18 FLG x PE SPOOL, LENGTH AS REQUIRED, FITTINGS AS REQUIRED
- 19 MAINGUARD BLOW-OFF #7600 (SEE TABLE 1, THIS SHEET). ENCLOSURE TO BE CARSON INDUSTRIES MODEL H2436 TRAFFIC BEARING VAULT AND LID WITH EXTENSIONS AS REQUIRED.
- 20 OSHA APPROVED GALVANIZED STEEL LADDER WITH 4 FOOT REMOVABLE EXTENSION
- 21 PIPE SUPPORT. SEE TYPICAL PIPE SUPPORT DETAIL SHEET 26.
- 22 SEAL PIPE PENETRATIONS WATERTIGHT WITH NON-SHRINK GROUT
- 23 BRASS GRATED DRAIN WITH KNOCKOUT HOLE FOR DRAIN PIPE. DO NOT PROVIDE DRAIN IN HIGH GROUND WATER AREA.
- 24 FLG x PE DI SPOOL x 2 FT. LONG (SAME SIZE AS CONTROL VALVE)

STATION SIZE	CONTROL VALVE SIZE	BLOW-OFF INLET	BLOW-OFF OUTLET	GATE VALVE SIZE
3-INCH	3"	4"	4"	3"
4-INCH	4"	4"	4"	4"
6-INCH	6"	6"	4"	6"
8-INCH	8"	6"	4"	8"

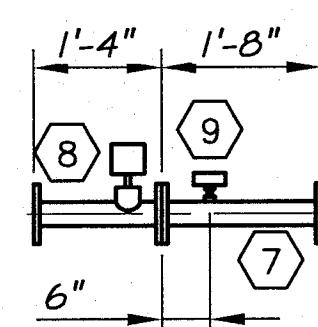


4" SERVICE

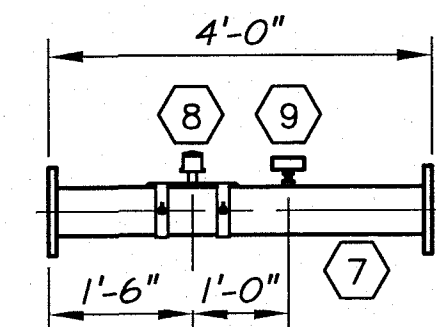


6" AND 8" SERVICE

FLOWMETER PIPING DETAIL

N.T.S.

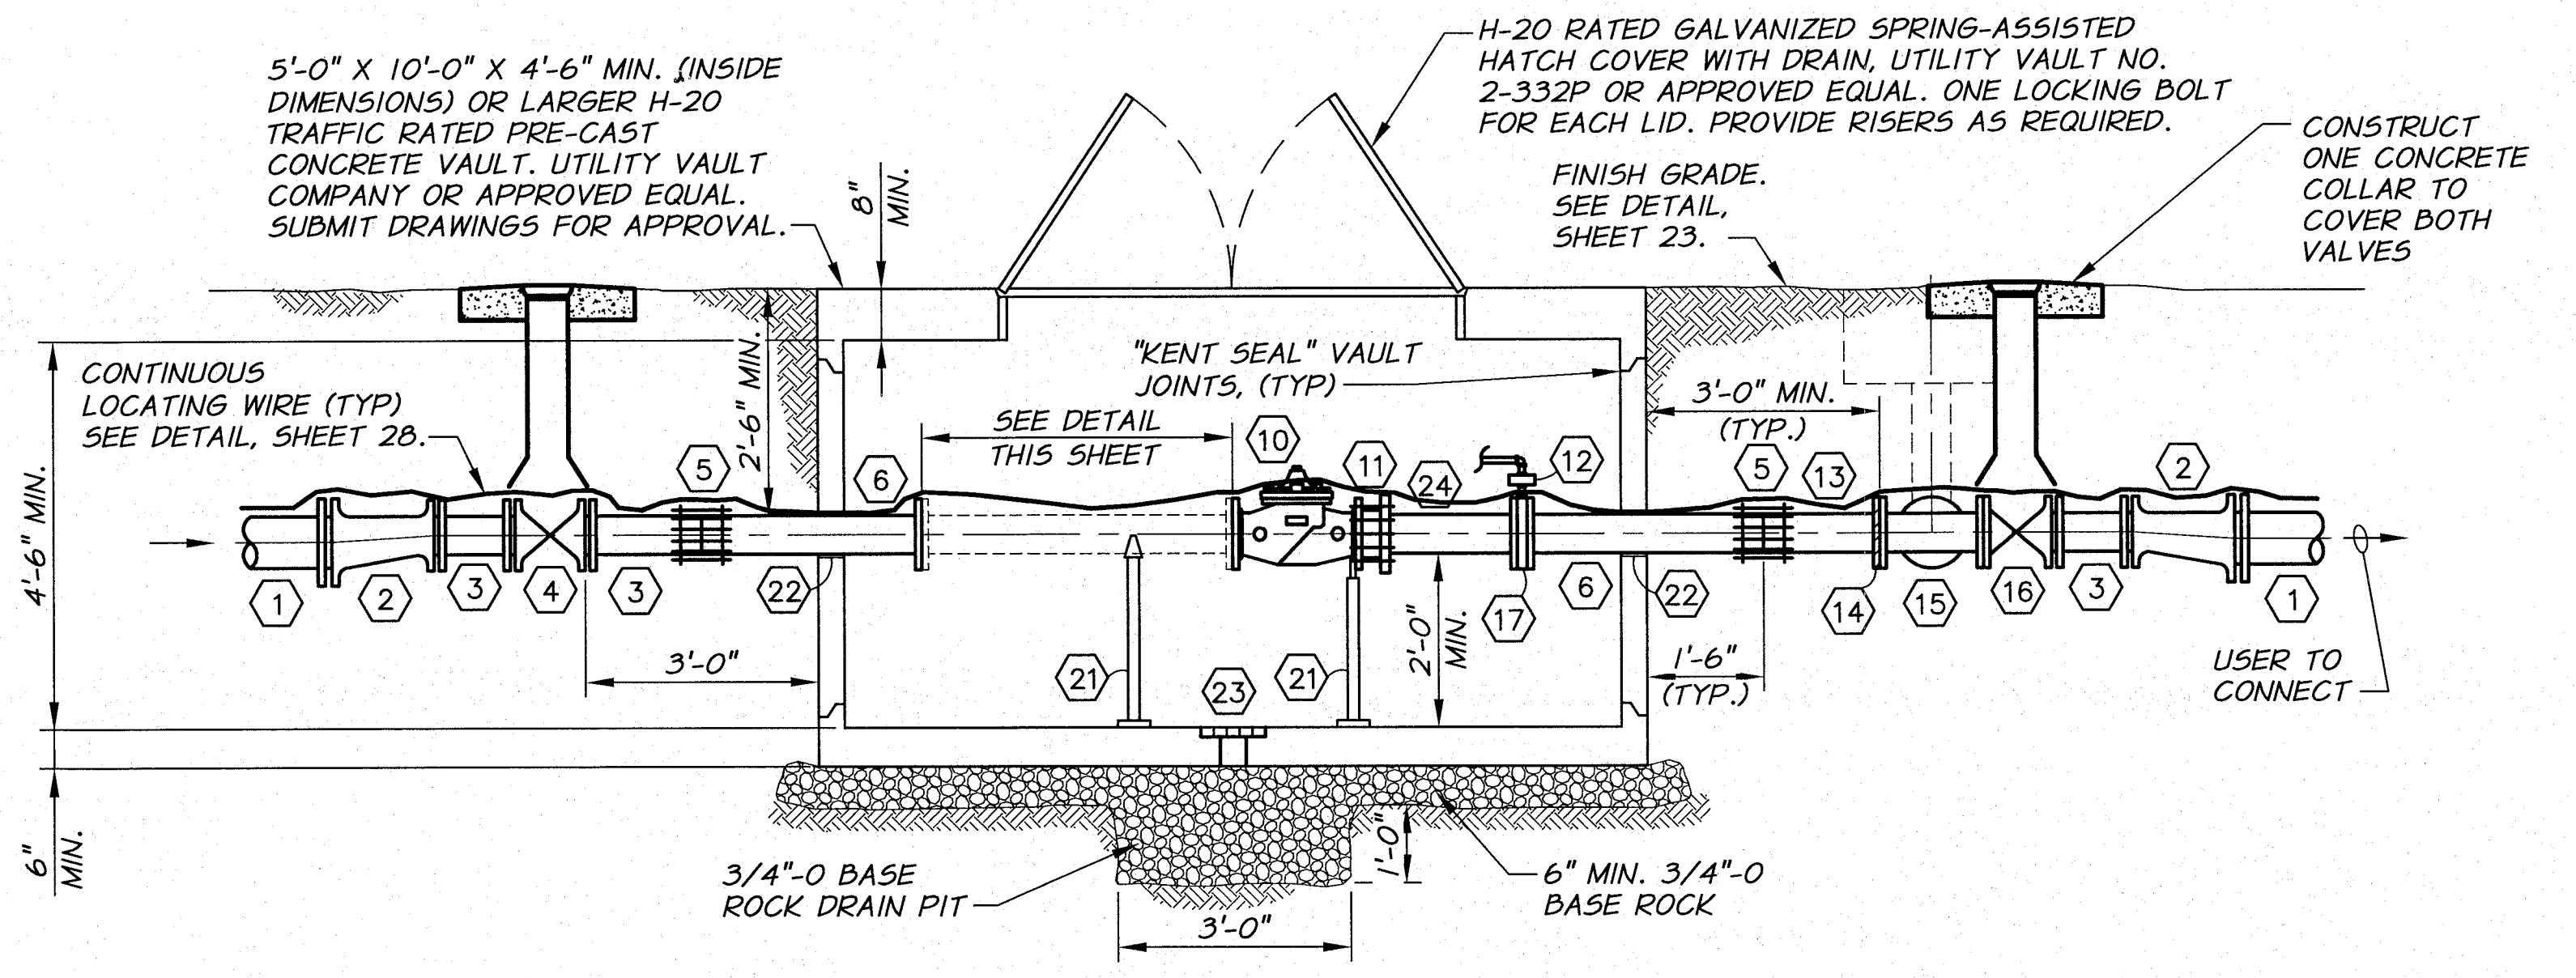

SECTION A

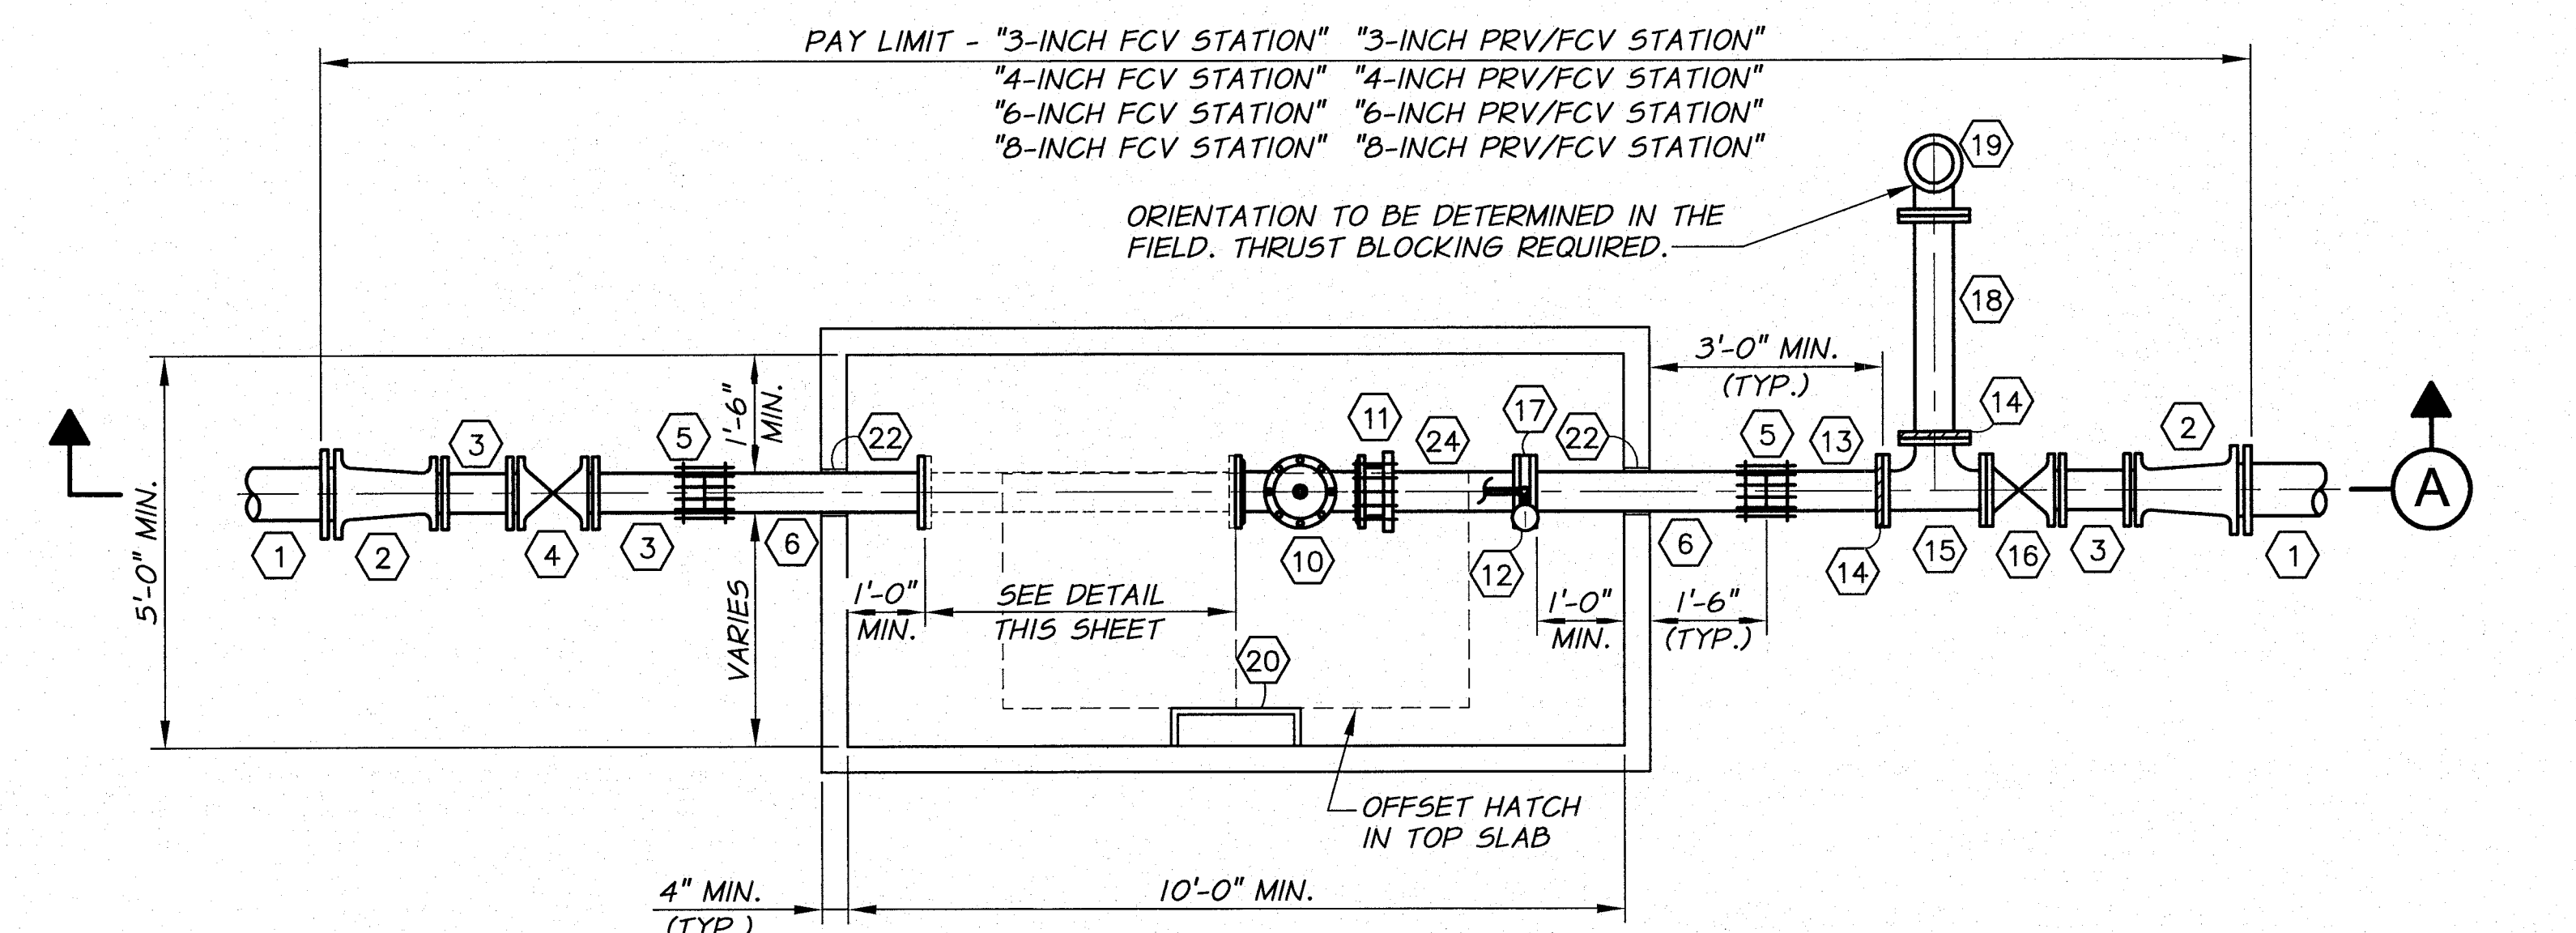


PLAN

- NOTES:**
1. PIPING SIZE TO MATCH CONTROL VALVE SIZE UNLESS OTHERWISE NOTED.
 2. SET FRAME AND COVER TO GRADE AND PROVIDE GRADE RINGS AS REQUIRED.
 3. PIPE SUPPORTS TO BE SIZED APPROPRIATELY FOR PIPE AND INSTALLED PER MANUFACTURER'S RECOMMENDATIONS.
 4. ALL WORK SHOWN IN THIS DETAIL, INCLUDING ANY REQUIRED SURFACE RESTORATION, SHALL BE INCLUDED IN THE "...-INCH FCV STATION" OR THE "...-INCH PRV/FCV STATION" PAY ITEM.


3", 4", 6", AND 8" FCV AND PRV/FCV STATION DETAIL

N.T.S.

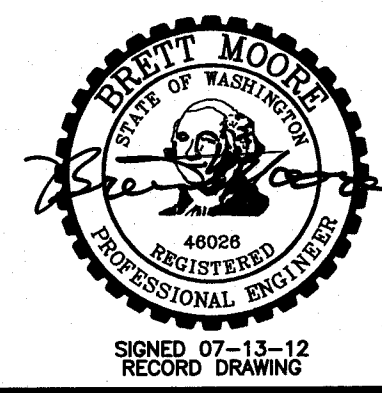


REVISION	BY	DATE	HORIZ. SCALE 1/2"=1'-0"	VERT. SCALE
DESIGNED BY R. HARRIS			JOB NUMBER 1199-336	DATE 2011
DRAWN BY D. CHRISTMAN			ACAD FILE: VaultDets-PH3A.dwg	
REVIEWED BY B. MOORE			COPYRIGHT 2011 BY ANDERSON-PERRY & ASSOC., INC.	


RECORD DRAWINGS
These record drawings have been prepared, in part, on the basis of information compiled and furnished by others. They may contain some discrepancies and omissions, and do not necessarily represent "exact" field conditions. The Owner and the Engineer accept no responsibility for their accuracy.

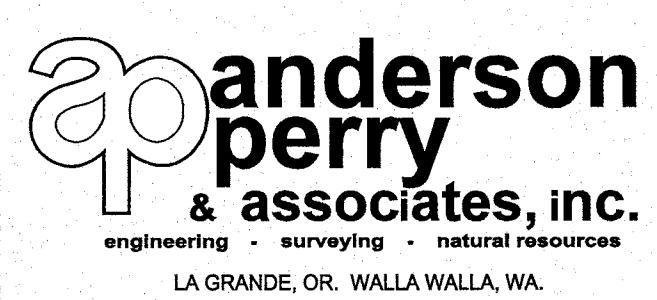

BENTON IRRIGATION DISTRICT
IRRIGATION SYSTEM IMPROVEMENTS
PHASE 3A
VALVE STATION DETAILS II

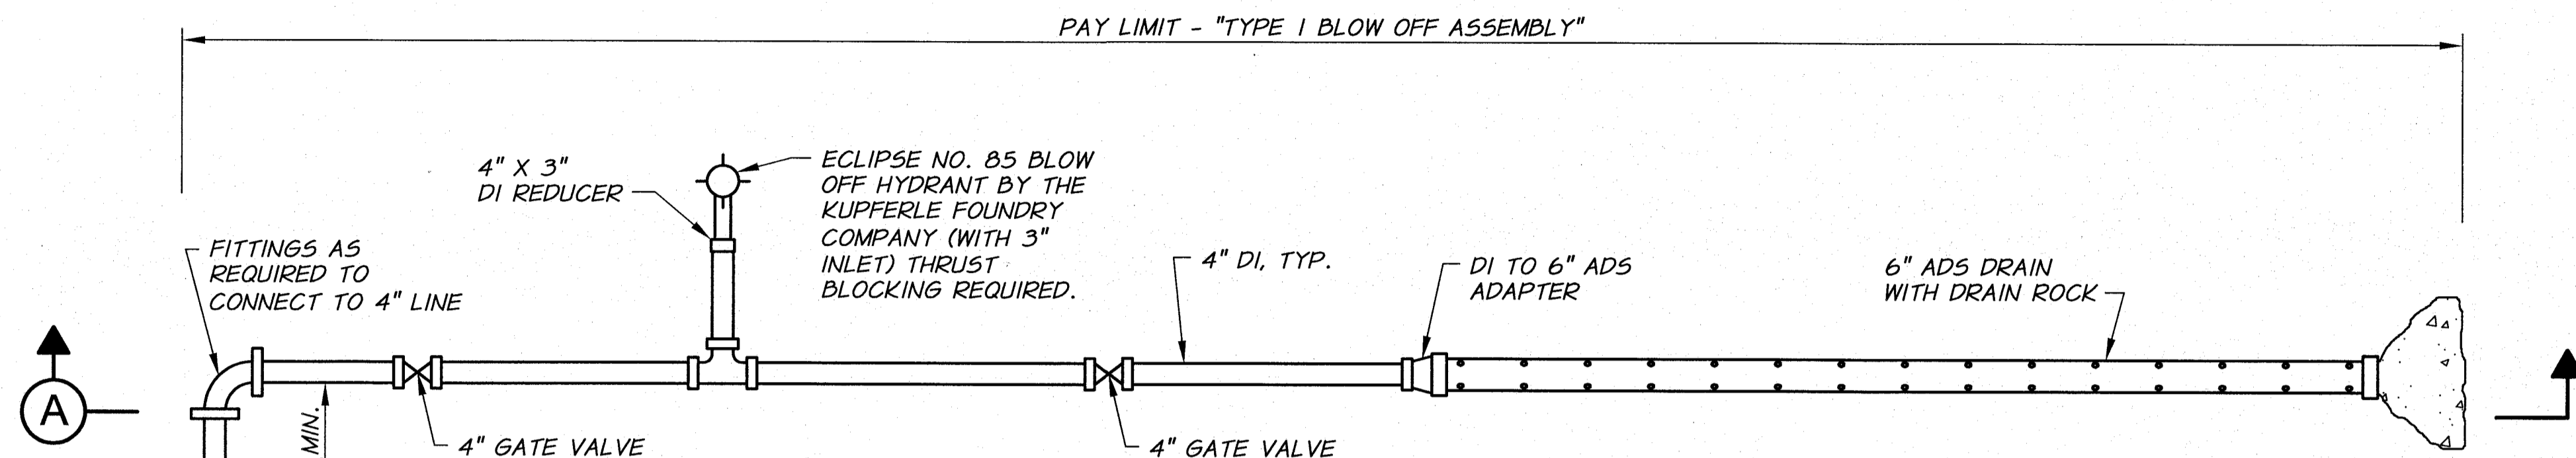


PLAN

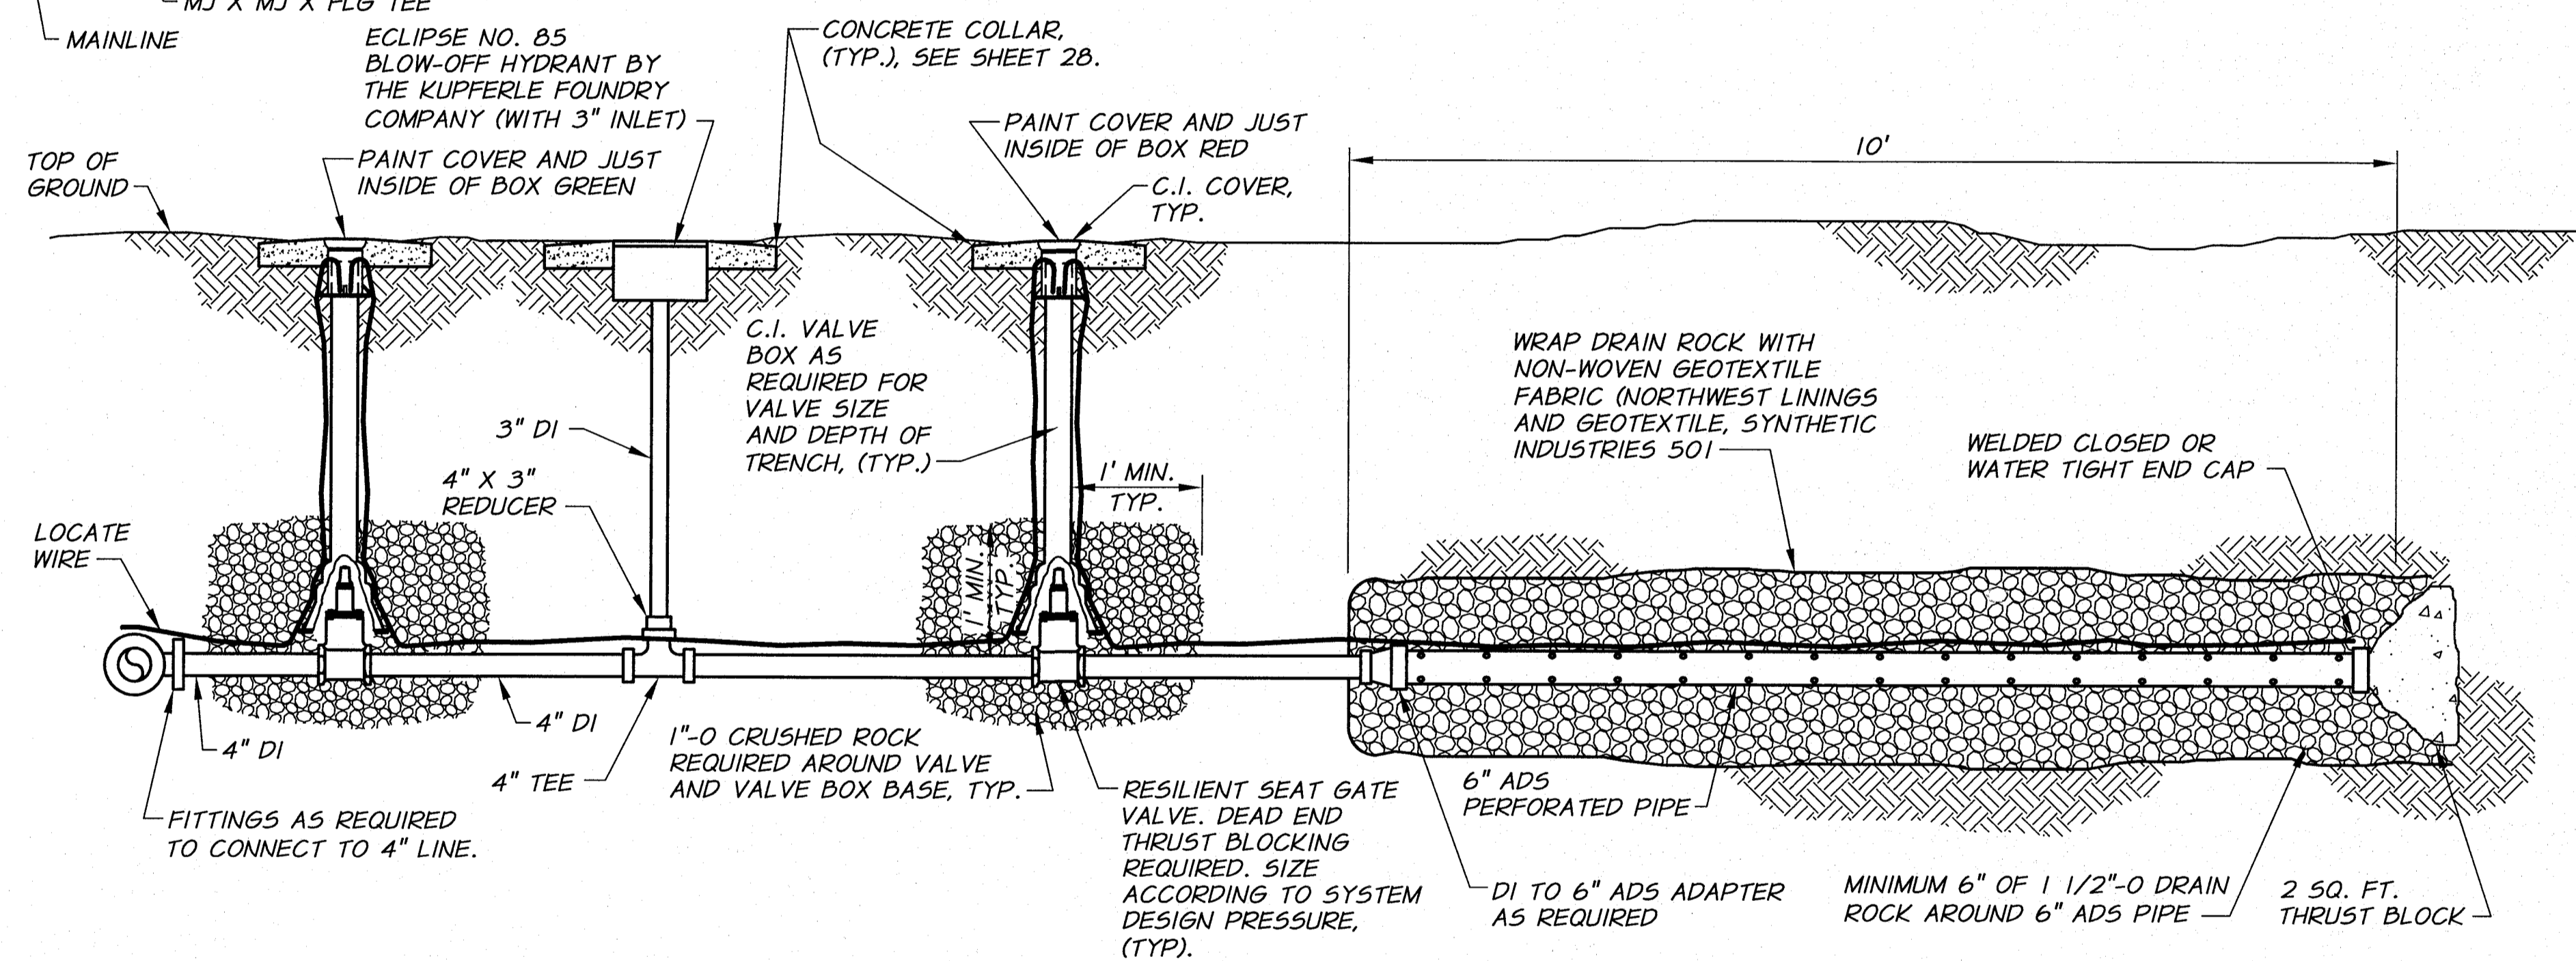


SECTION A
TYPE 1 BLOW-OFF ASSEMBLY DETAIL
N.T.S.

NOTE:
BLOW-OFF TO BE FIELD
LOCATED BY THE ENGINEER
PRIOR TO CONSTRUCTION
(INCLUDING ORIENTATION).

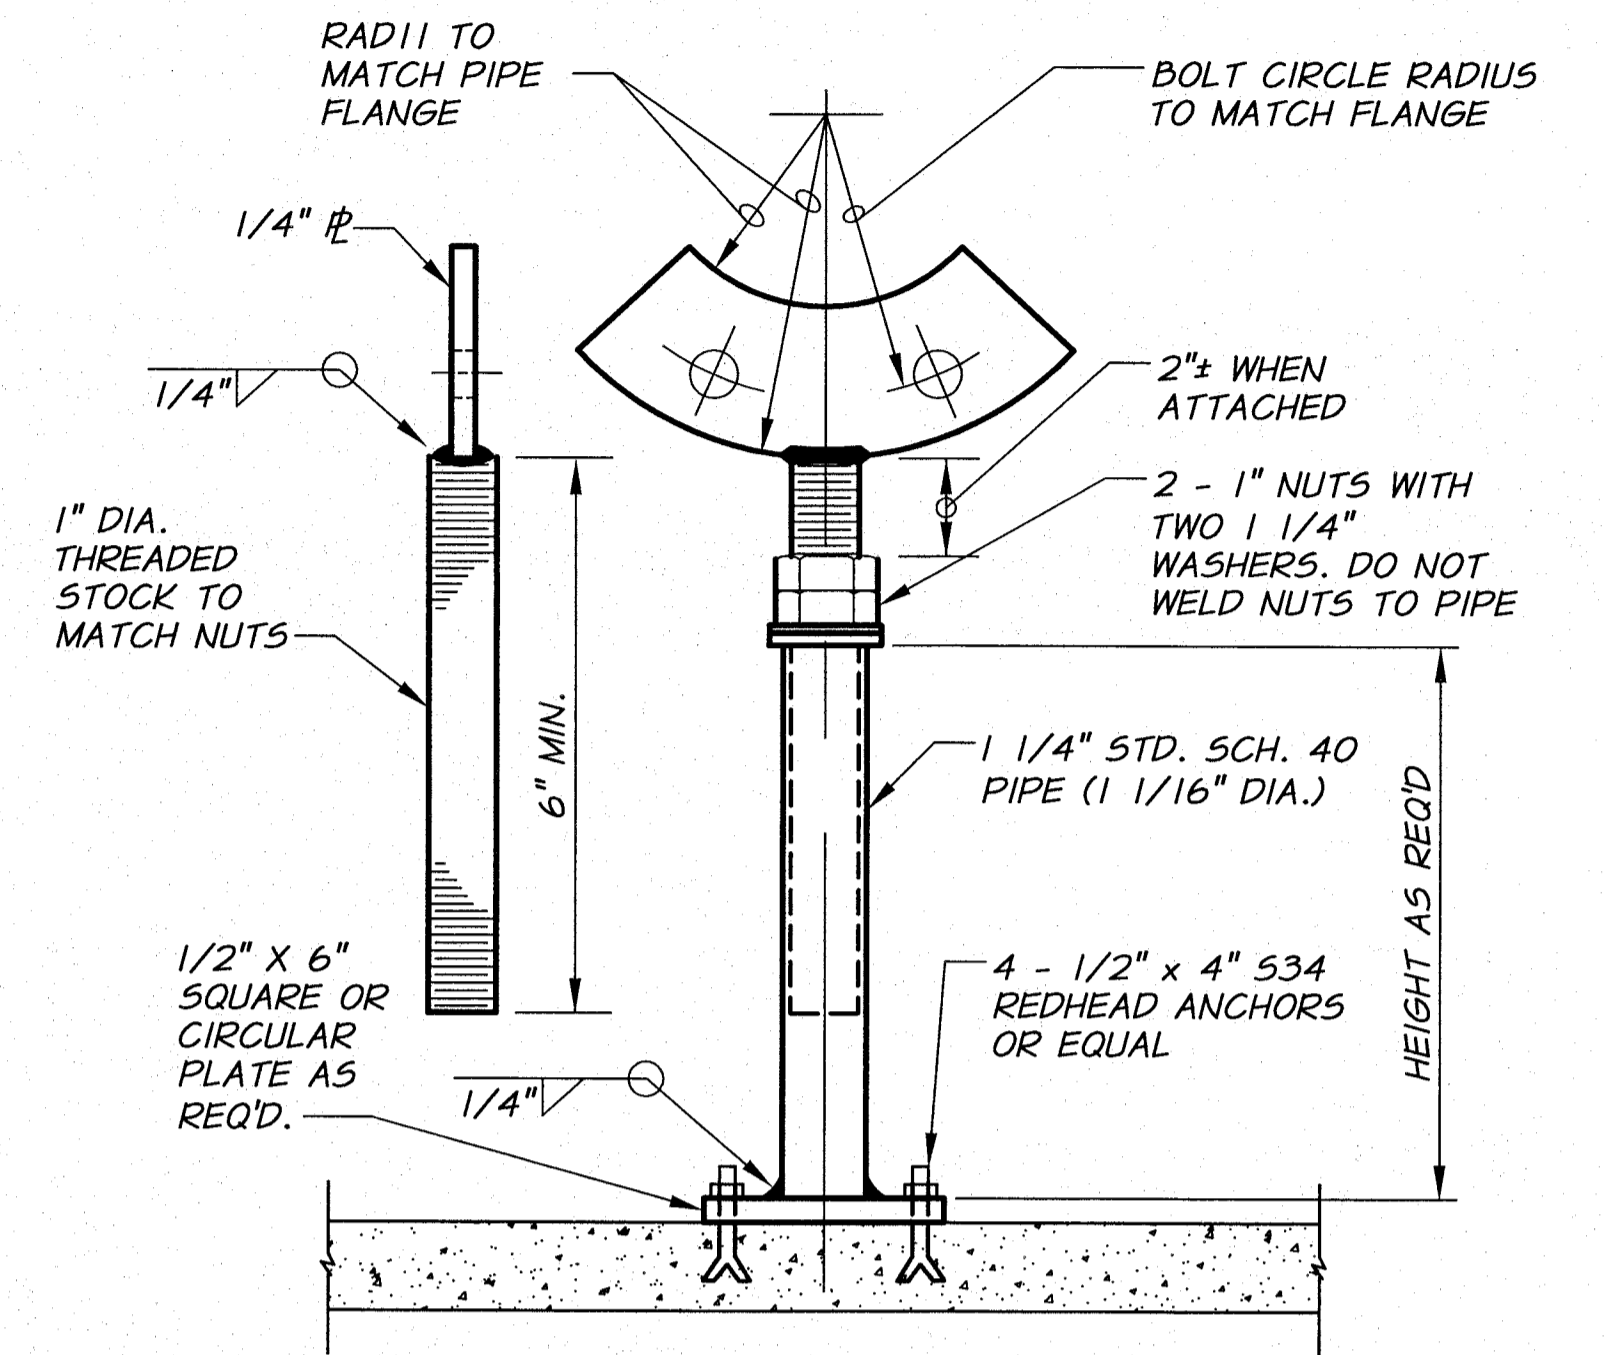


PIPE SUPPORT DETAIL

N.T.S.

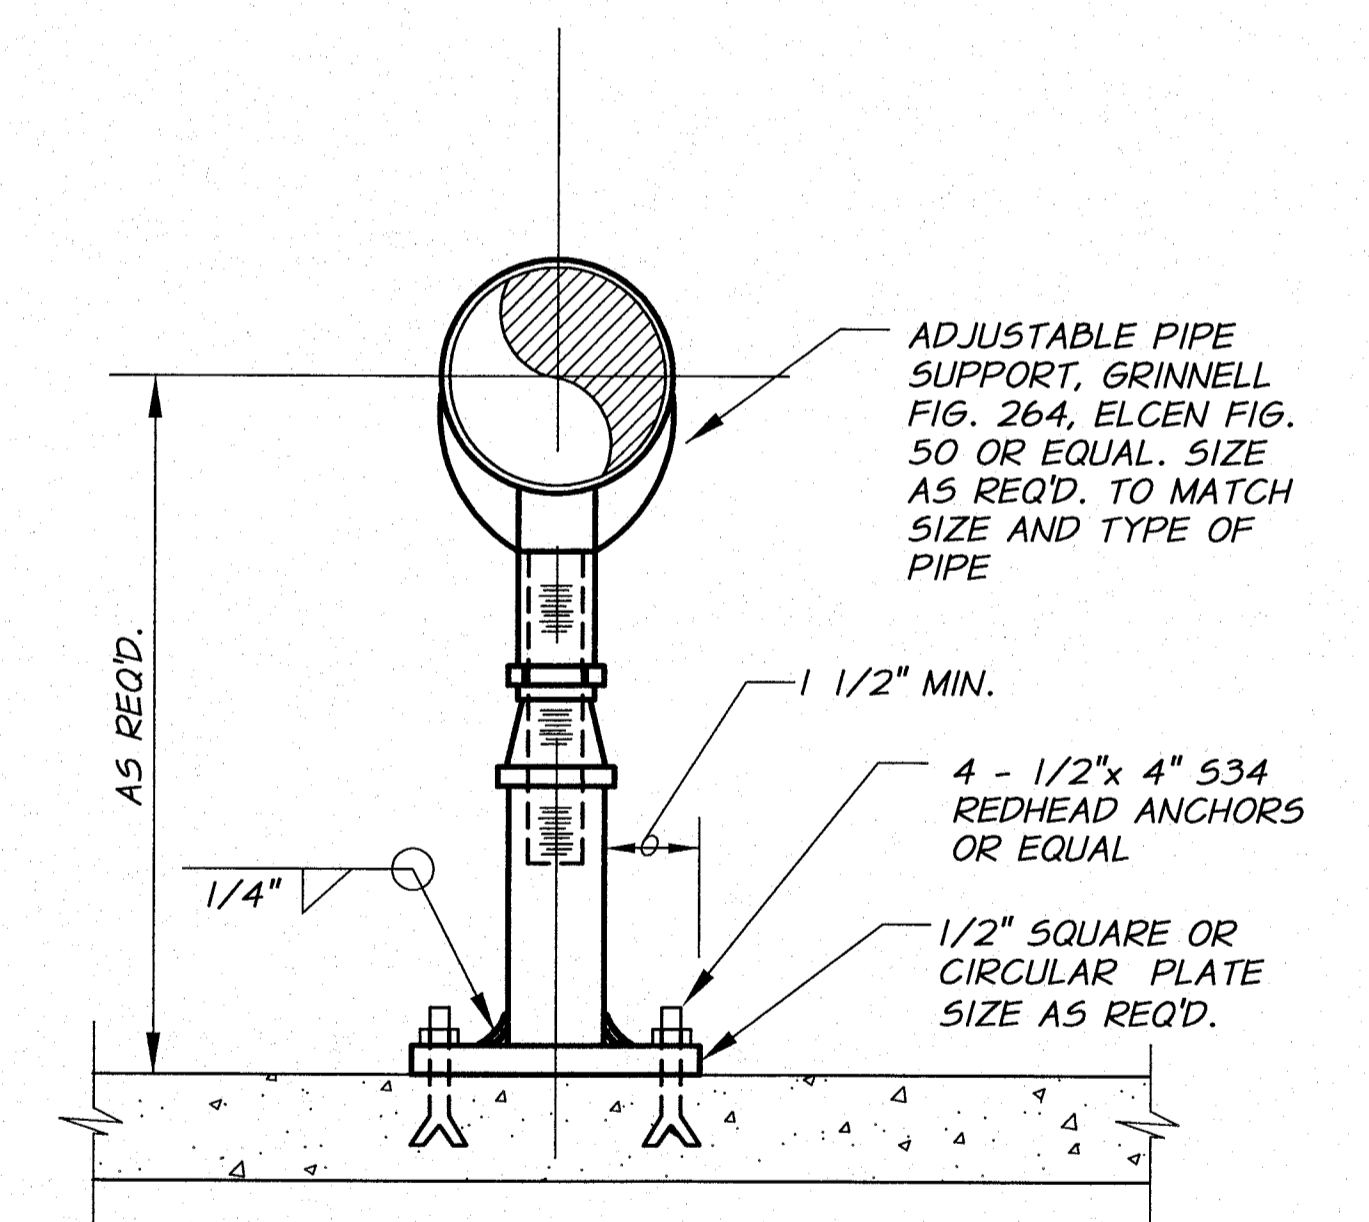

PIPE SUPPORT DETAIL


N.T.S.

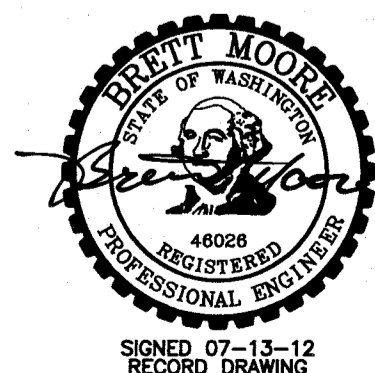

REVISION	BY	DATE	HORIZ. SCALE	VERT. SCALE
DESIGNED BY	R. HARRIS		NONE	
DRAWN BY	D. CHRISTMAN		JOB NUMBER	1199-336
REVIEWED BY	B. MOORE		ACAD FILE	irrgDets-PH3A.dwg
			DATE	2011
COPYRIGHT 2011 BY ANDERSON-PERRY & ASSOC., INC.				

RECORD DRAWINGS

These record drawings have been prepared, in part, on the basis of information compiled and furnished by others. They may contain some discrepancies and omissions, and do not necessarily represent "exact" field conditions. The Owner and the Engineer accept no responsibility for their accuracy.

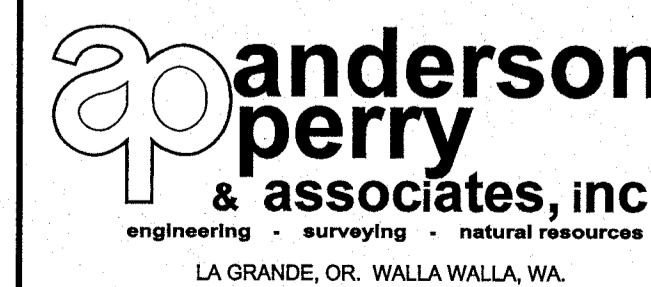


BENTON IRRIGATION DISTRICT
IRRIGATION SYSTEM IMPROVEMENTS
PHASE 3A

MISCELLANEOUS DETAILS I

SHEET


26

ARCHIVED

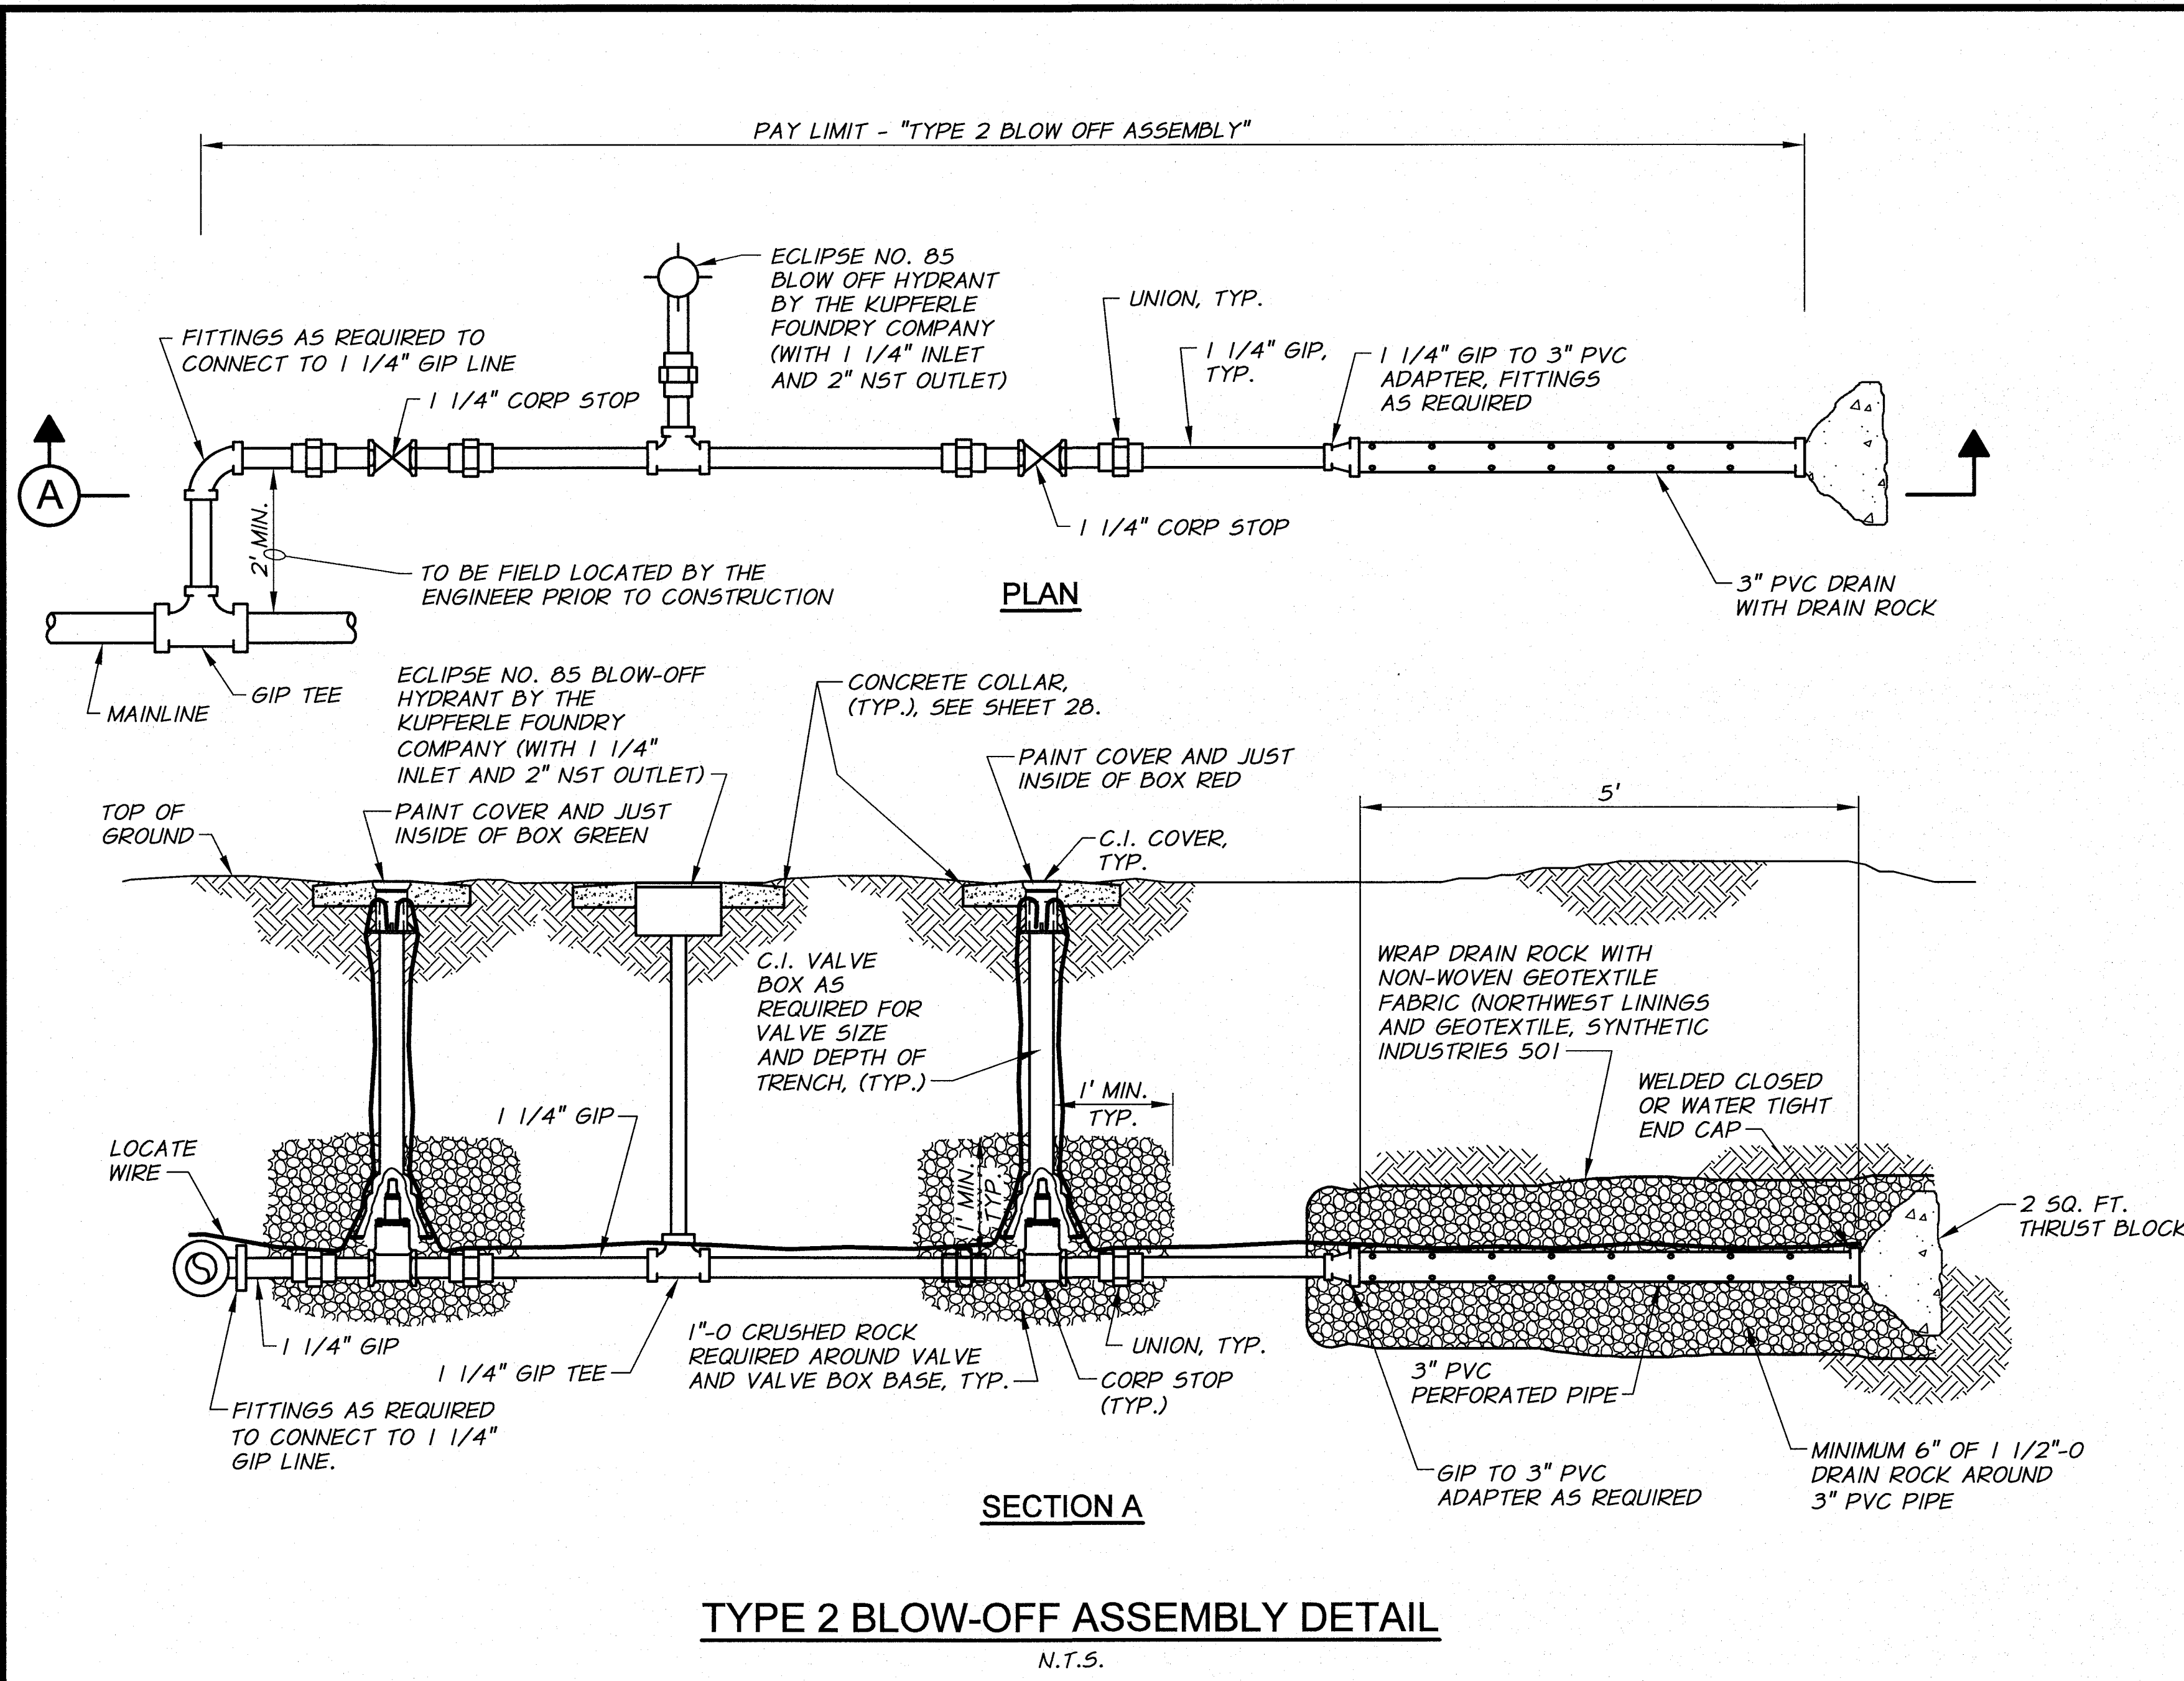

SECTION A
TYPE 2 BLOW-OFF ASSEMBLY DETAIL
N.T.S.

NOTE:
BLOW-OFF TO BE FIELD
LOCATED BY THE ENGINEER
PRIOR TO CONSTRUCTION
(INCLUDING ORIENTATION).

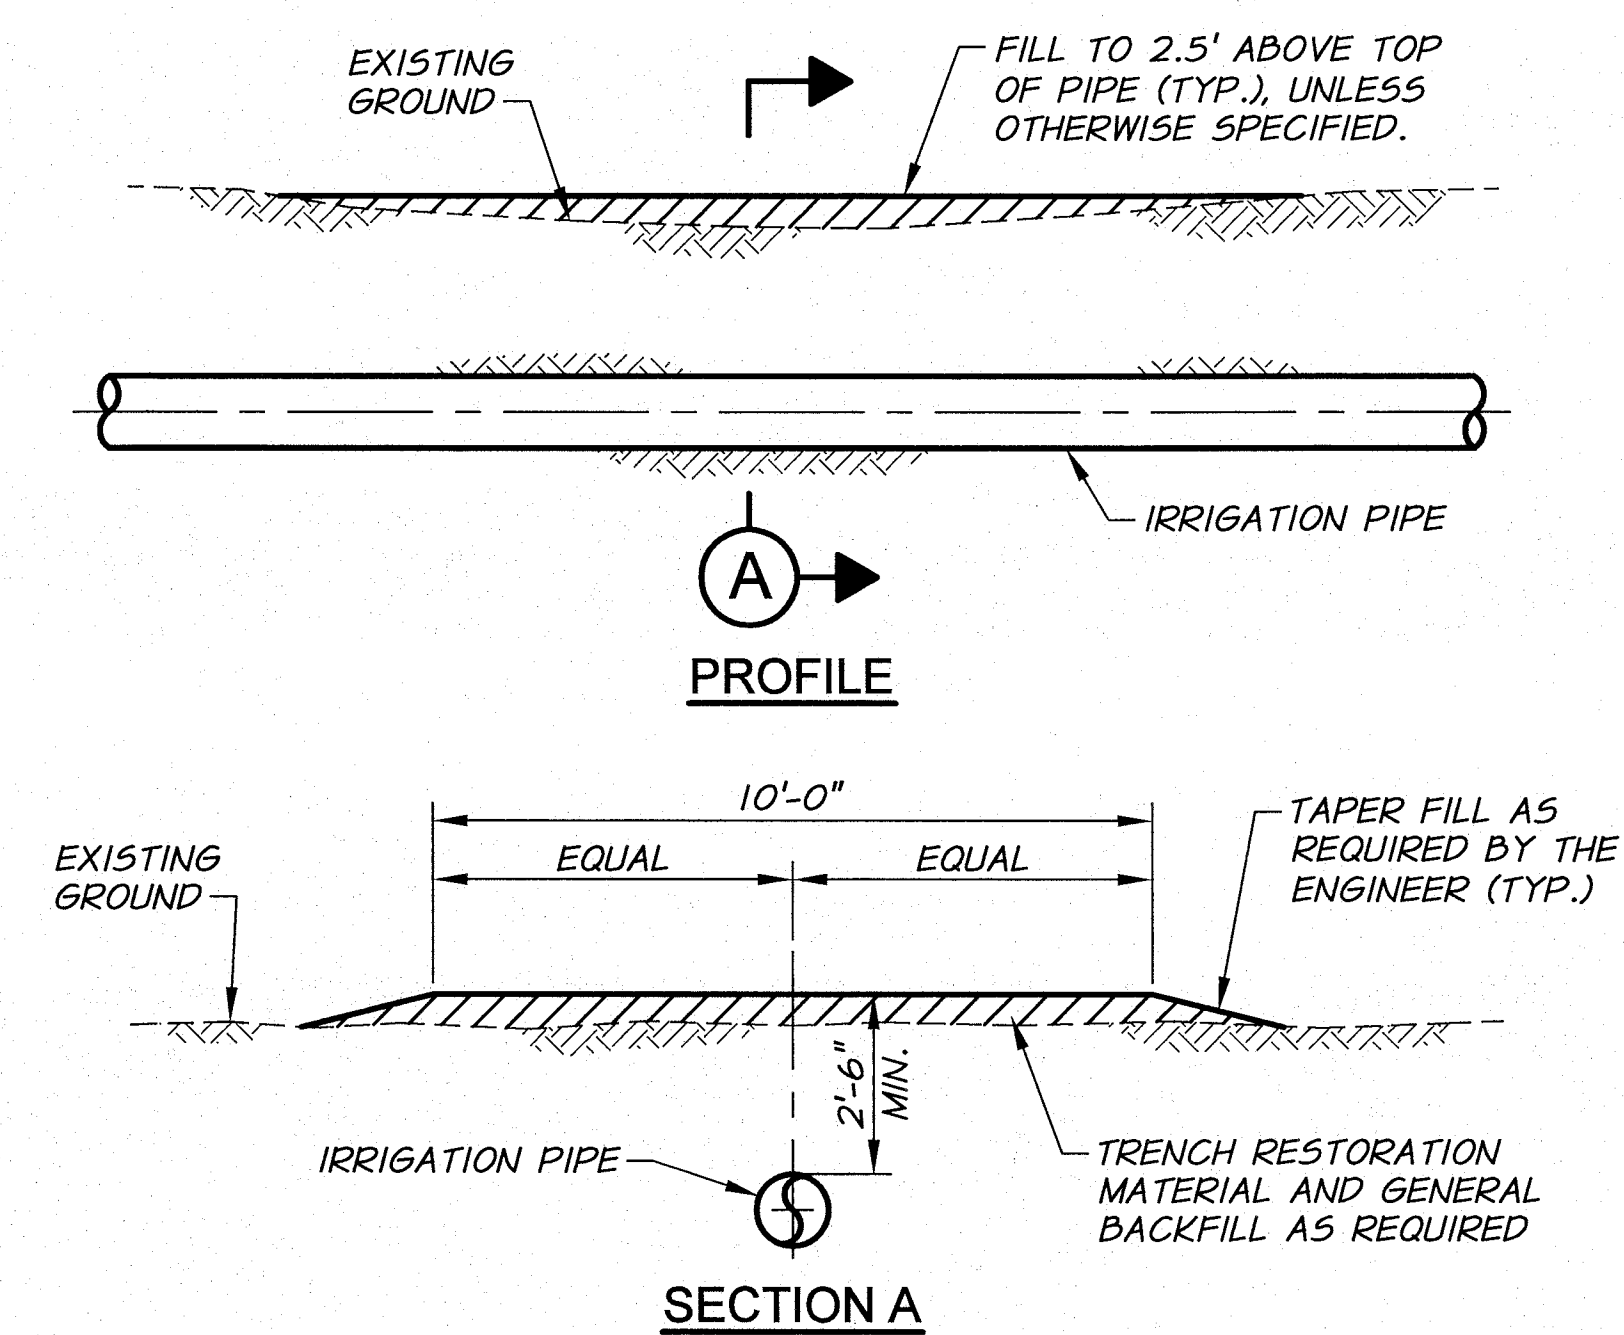

TYPICAL PIPELINE LOW AREA BACKFILL DETAIL
N.T.S.


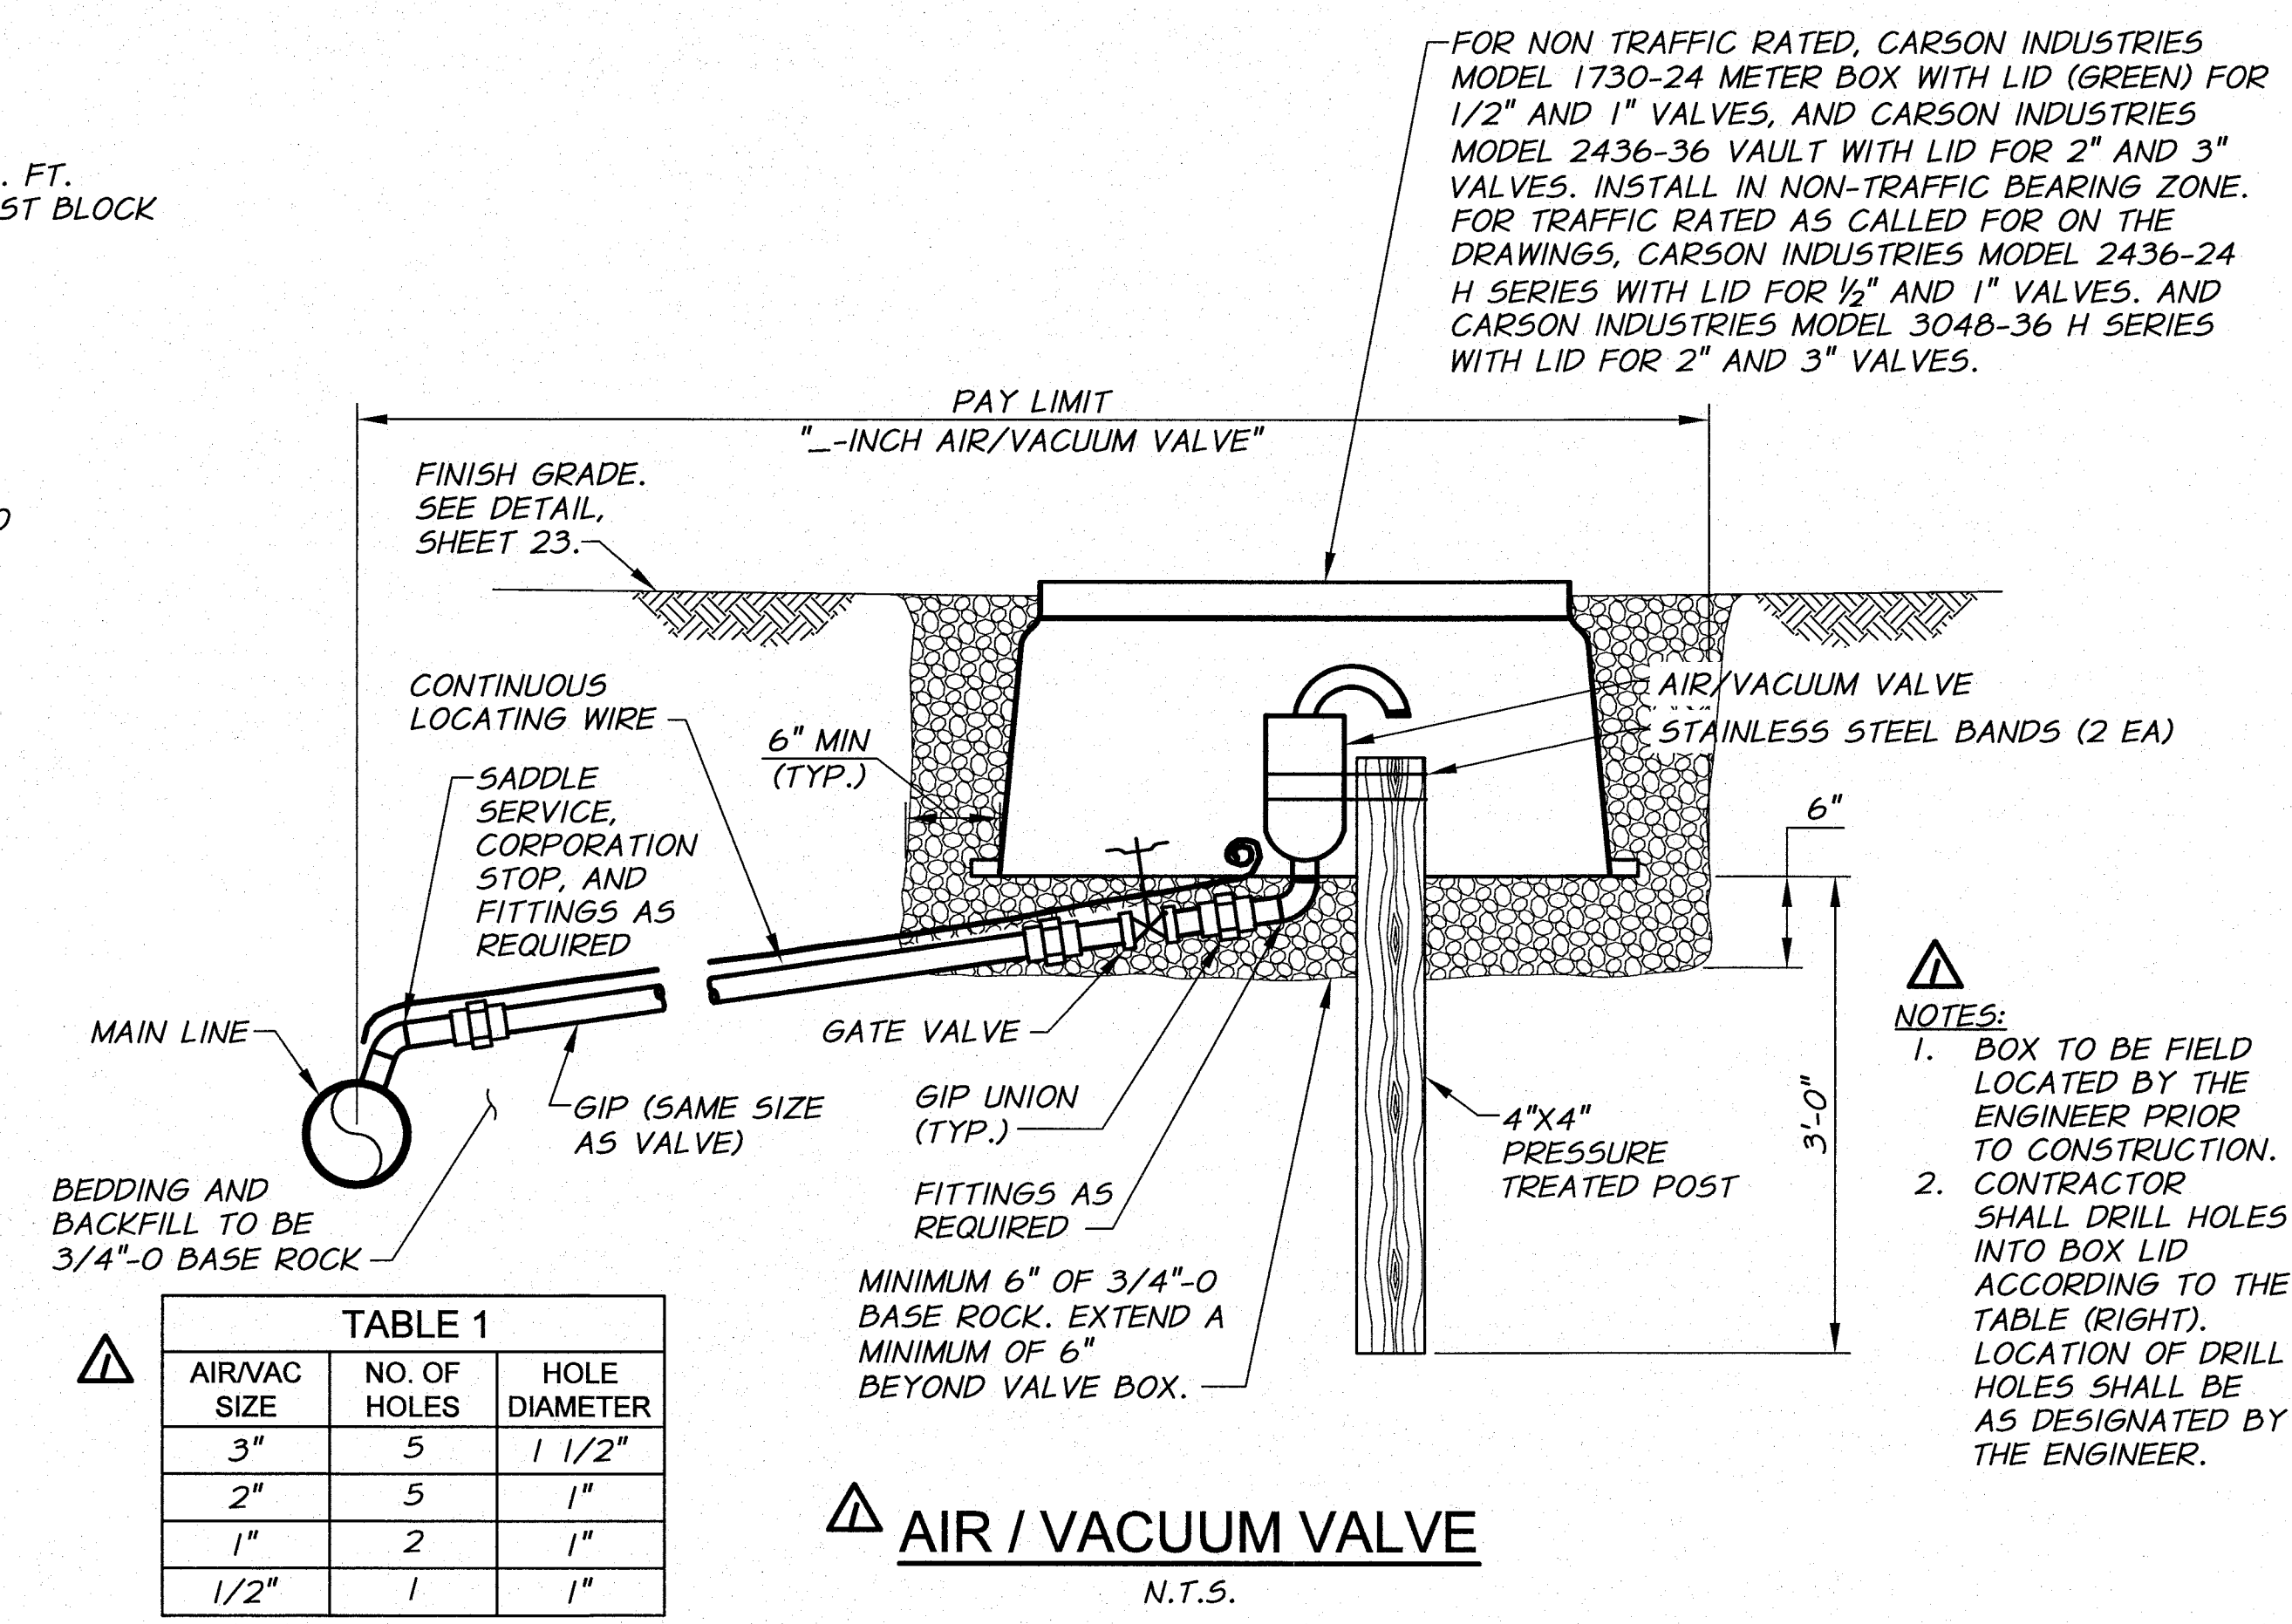


TABLE 1

AIR/VAC SIZE	NO. OF HOLES	HOLE DIAMETER
3"	5	1 1/2"
2"	5	1"
1"	2	1"
1/2"	1	1"


AIR / VACUUM VALVE
N.T.S.

- NOTES:**
1. BOX TO BE FIELD LOCATED BY THE ENGINEER PRIOR TO CONSTRUCTION.
 2. CONTRACTOR SHALL DRILL HOLES INTO BOX LID ACCORDING TO THE TABLE (RIGHT). LOCATION OF DRILL HOLES SHALL BE AS DESIGNATED BY THE ENGINEER.

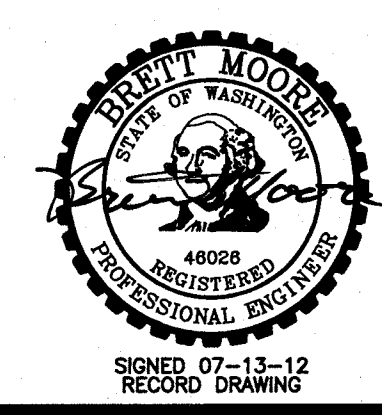


RECORD DRAWING		BY	B.M.	DATE	7/12
DESIGNED BY	R. HARRIS	HORIZ. SCALE	NONE	DATE	2011
DRAWN BY	D. CHRISTMAN	JOB NUMBER	1199-336	ACAD FILE	IrrgDets-PH3A.dwg
REVIEWED BY	B. MOORE	COPYRIGHT 2011 BY ANDERSON-PERRY & ASSOC., INC.			

RECORD DRAWINGS
These record drawings have been prepared, in part, on the basis of information compiled and furnished by others. They may contain some discrepancies and omissions, and do not necessarily represent "exact" field conditions. The Owner and the Engineer accept no responsibility for their accuracy.

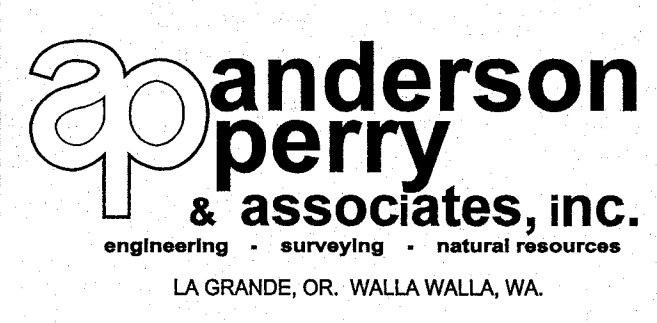


BENTON IRRIGATION DISTRICT
IRRIGATION SYSTEM IMPROVEMENTS
PHASE 3A
MISCELLANEOUS DETAILS II

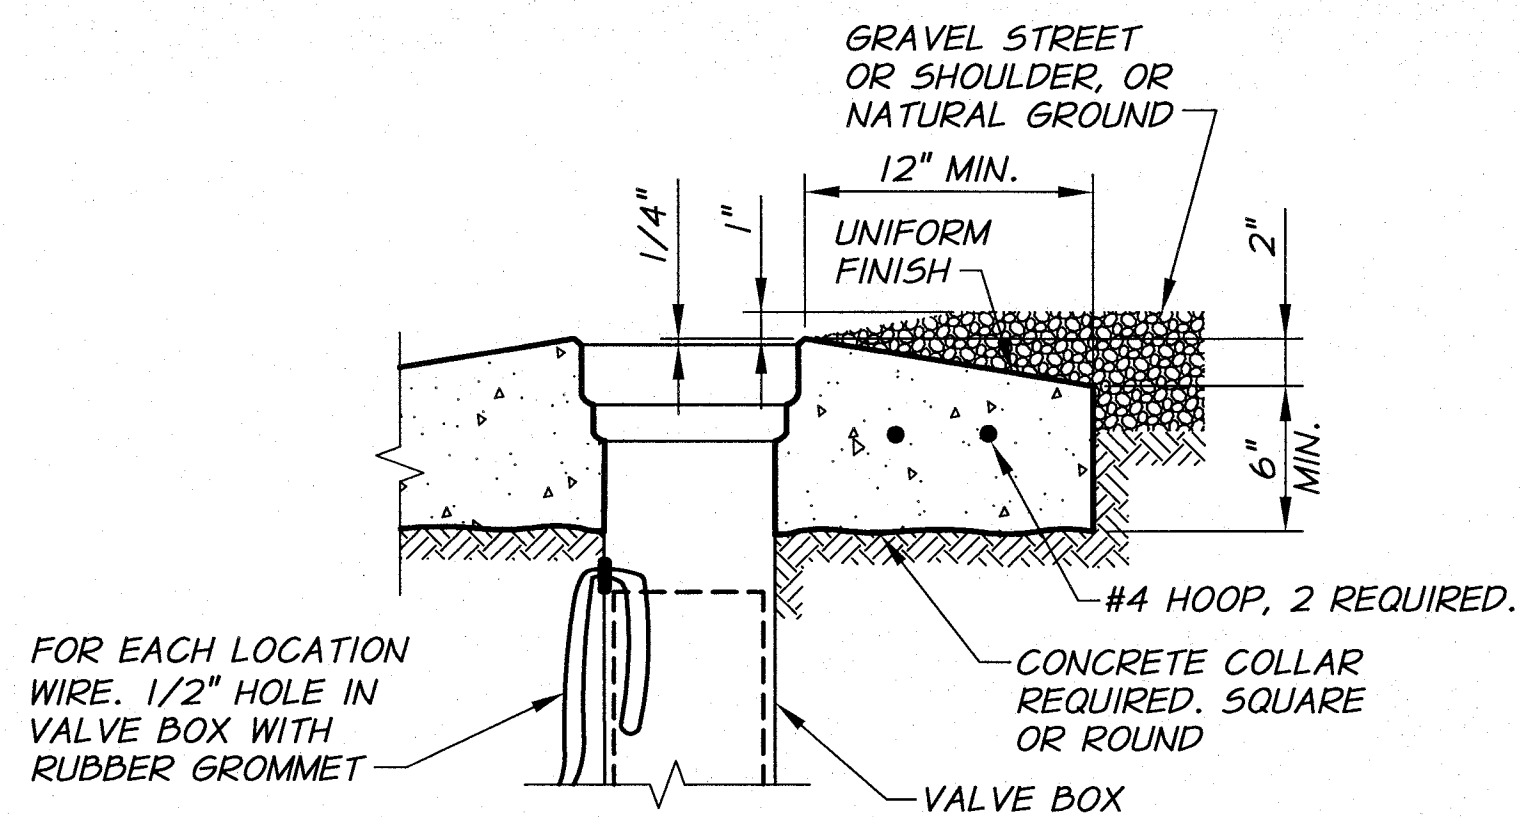

- REQUIREMENTS FOR CONCRETE COLLARS:
1. CONCRETE: 3/4", 7 SACK, 4000 PSI AT 28 DAYS, 2" TO 4" SLUMP, 4-7% AIR.
 2. COLLAR TO BE FORMED AND UNIFORMLY ROUND.
 3. SMOOTH BROOMED FINISH REQUIRED.
 4. APPLY CONCRETE CURING COMPOUND.
 5. PROTECT FROM TRAFFIC FOR 4 DAYS MIN.

CONCRETE COLLAR DETAIL
IN GRAVEL STREETS OR NATURAL GROUND
N.T.S.


NOTE:
CONCRETE COLLAR REQUIRED IF VALVE BOX GRADE IS ADJUSTED AFTER ASPHALT PAVEMENT WORK IS PERFORMED. IF GRADE ADJUSTMENT OCCURS PRIOR TO ASPHALT PAVEMENT WORK THEN CONCRETE COLLAR IS NOT REQUIRED.

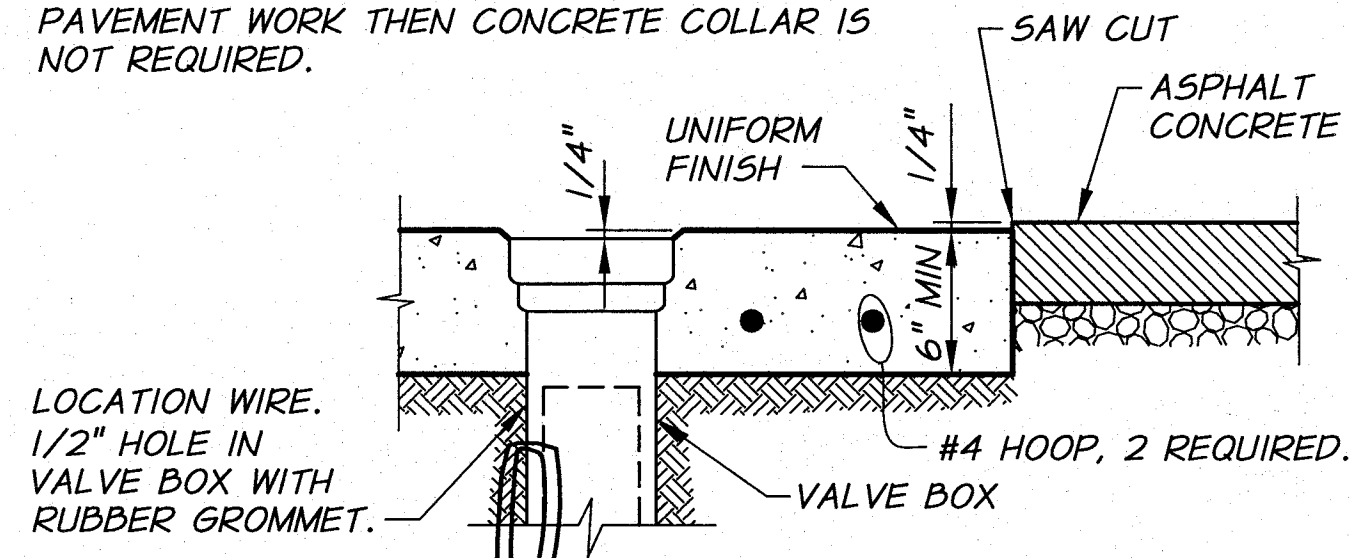


TYPICAL SECTION

- REQUIREMENTS FOR CONCRETE COLLARS:
1. CONCRETE: 3/4", 7 SACK, 4000 PSI AT 28 DAYS, 2" TO 4" SLUMP, 4-7% AIR.
 2. SMOOTH BROOMED FINISH REQUIRED.
 3. APPLY CONCRETE CURING COMPOUND.
 4. PROTECT FROM TRAFFIC FOR 4 DAYS MINIMUM.


VALVE BOX CONCRETE COLLAR DETAIL
IN ASPHALT PAVEMENT
N.T.S.

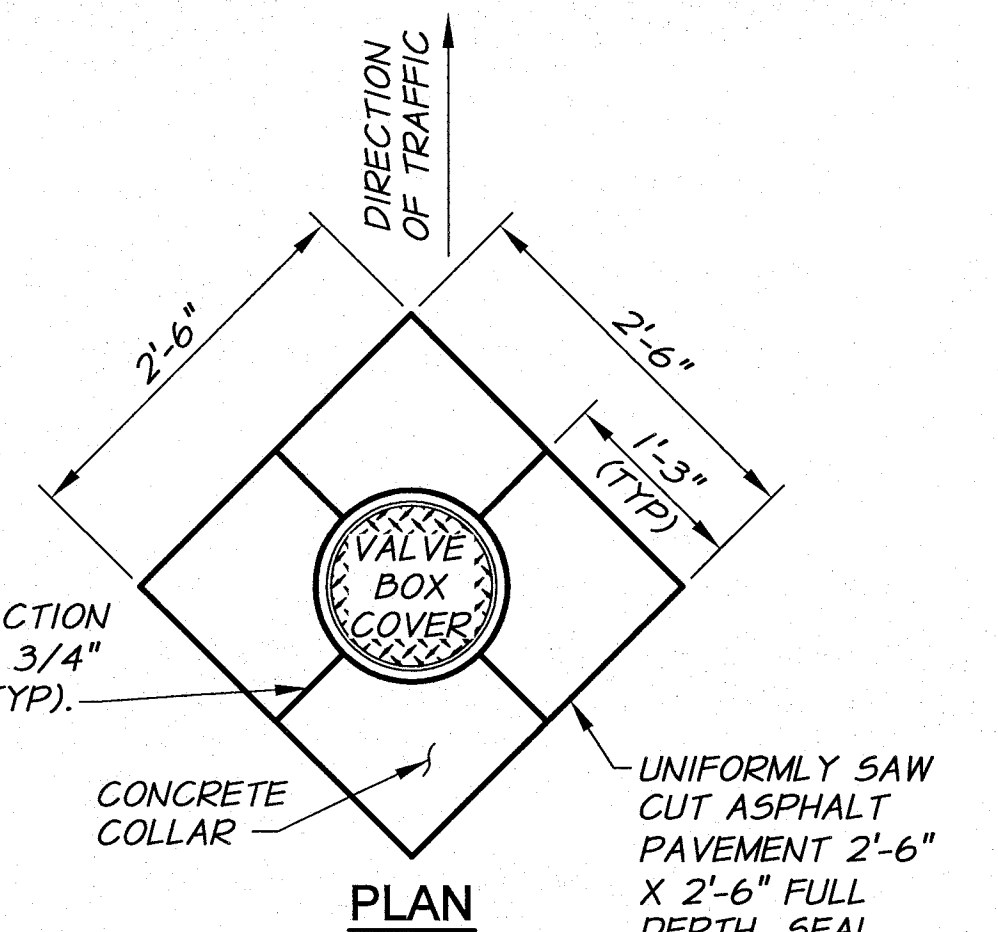


PLAN

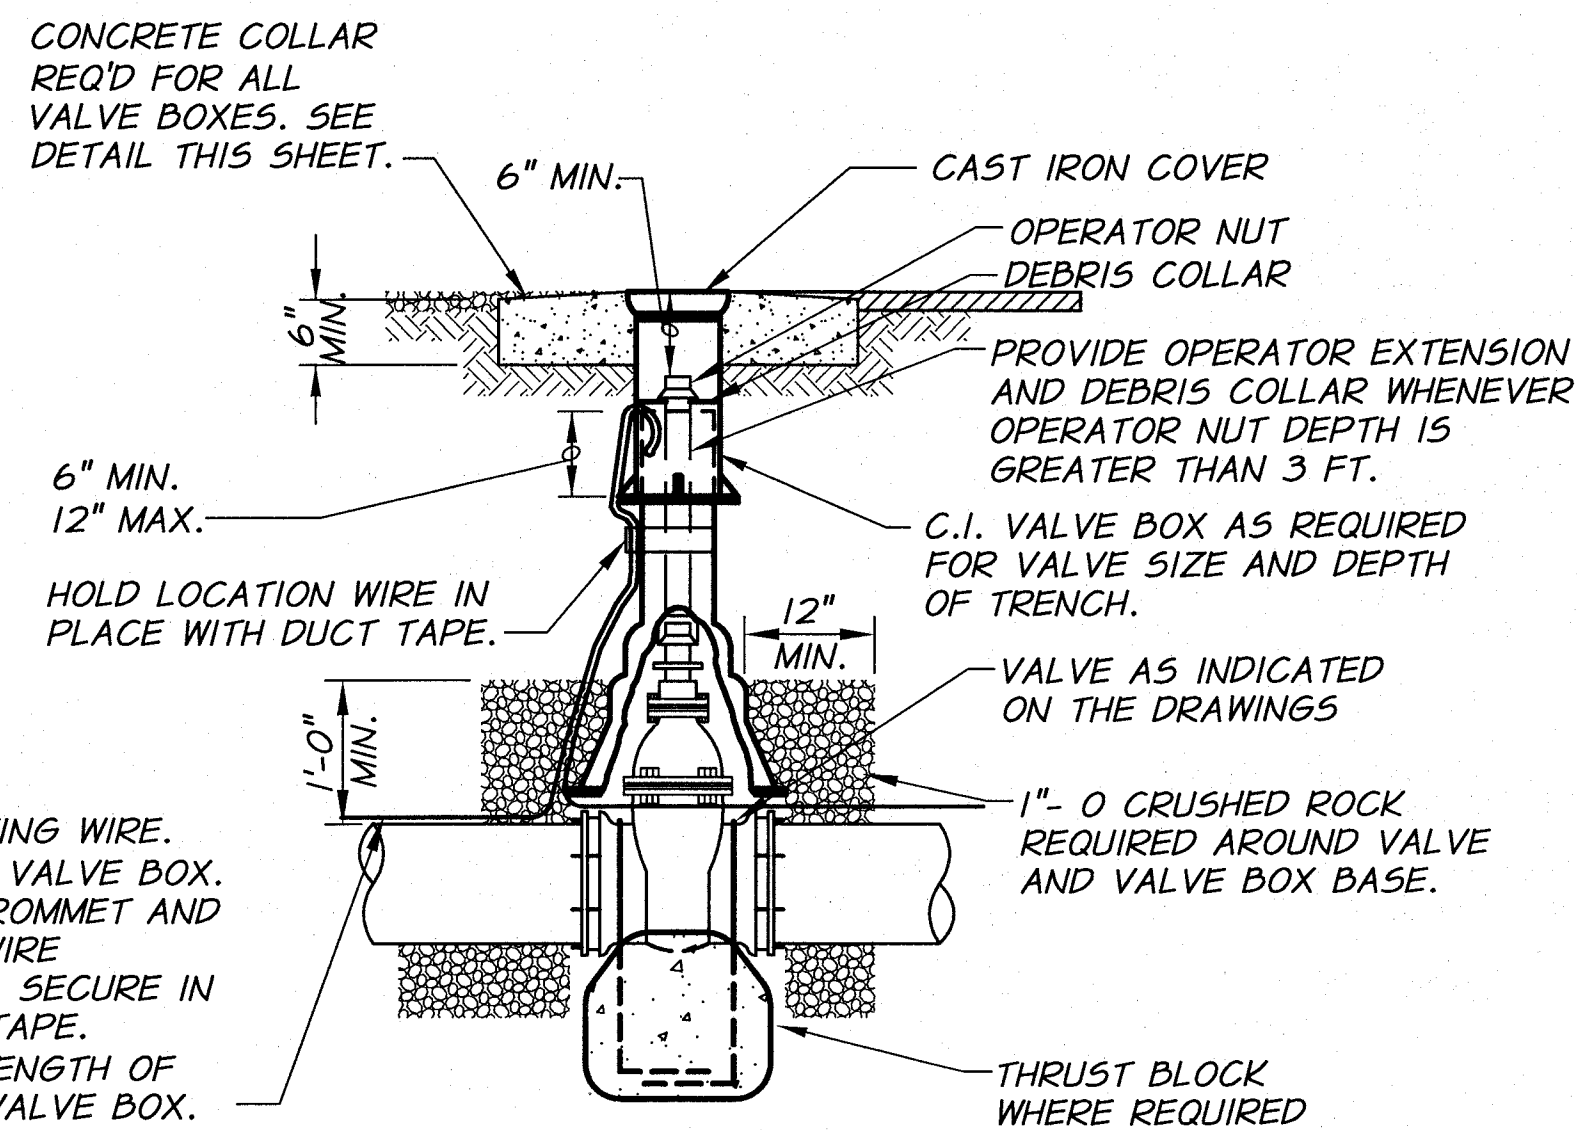


VALVE BOX EXTENSION DETAIL
N.T.S.

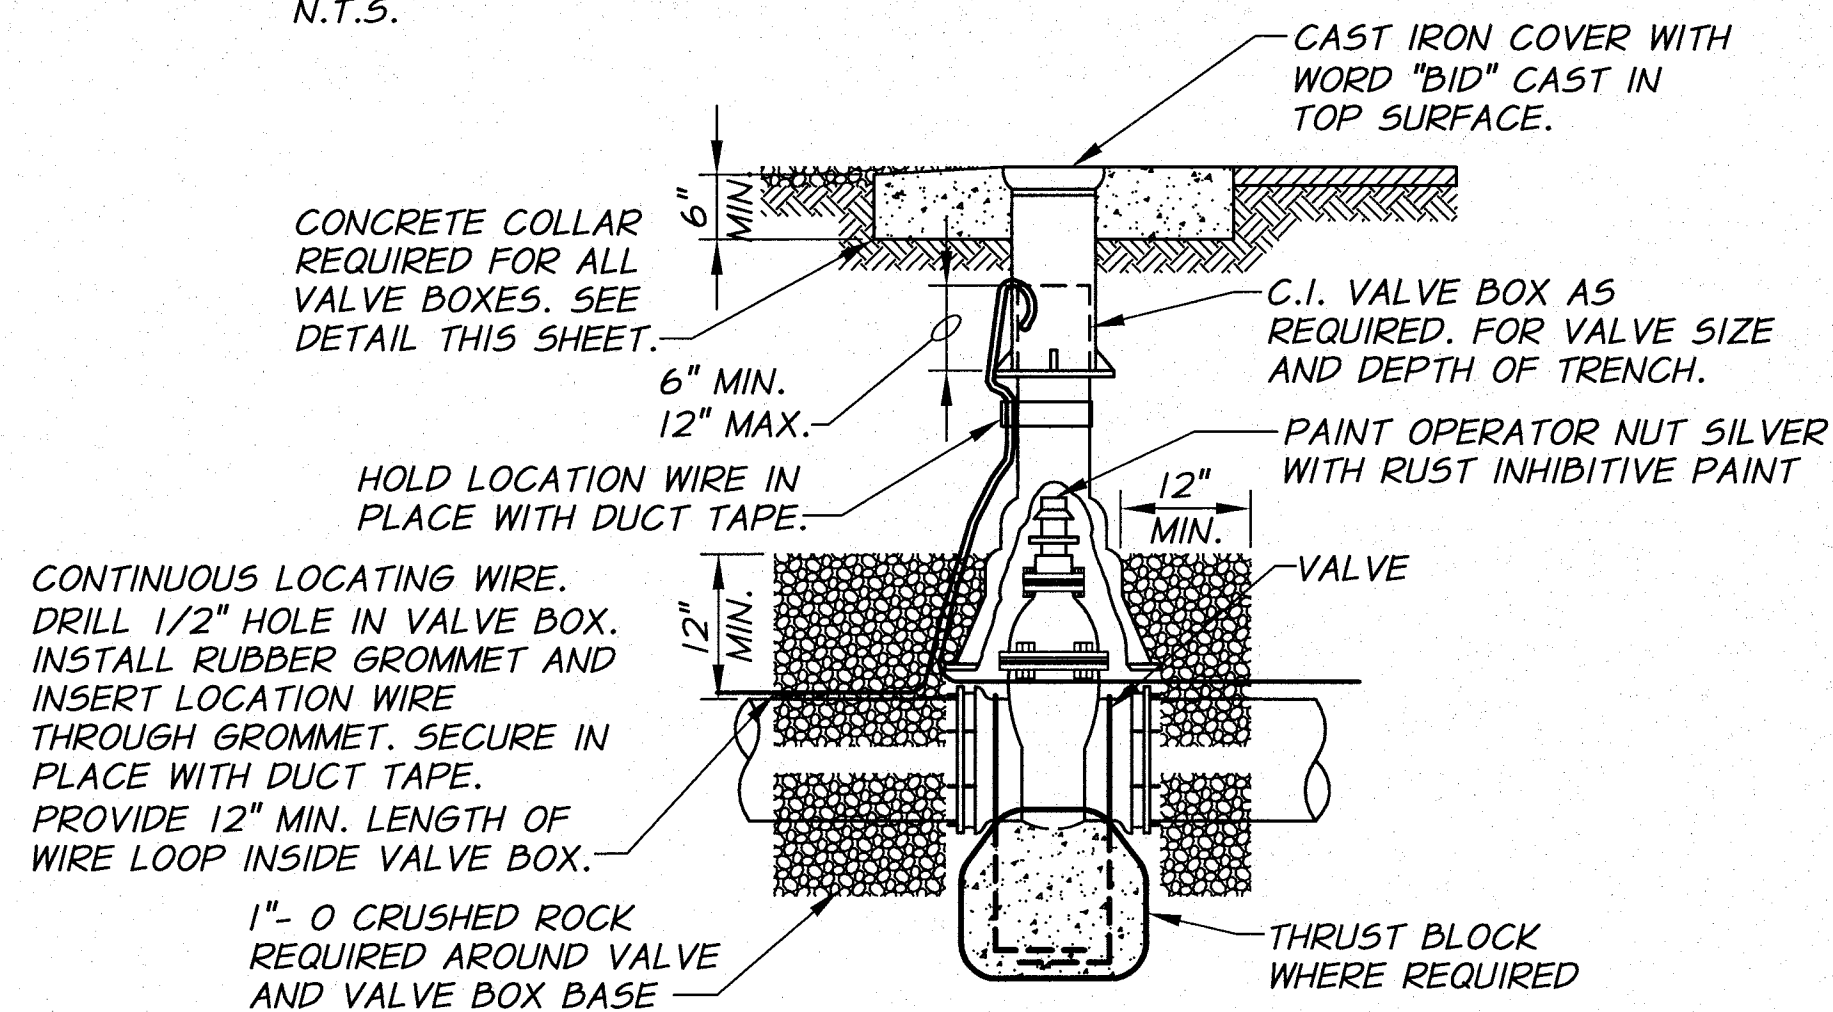


VALVE BOX DETAIL
N.T.S.

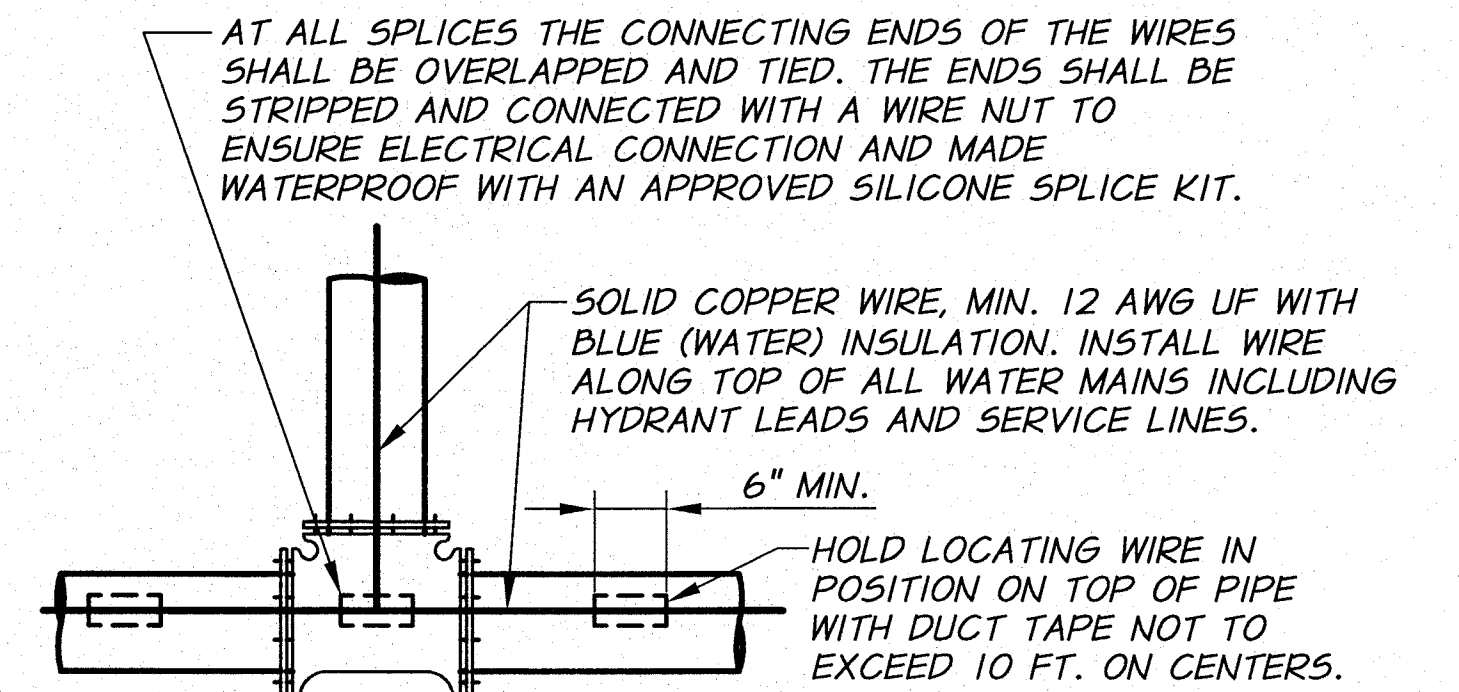

CONTINUOUS LOCATING WIRE DETAIL
N.T.S.

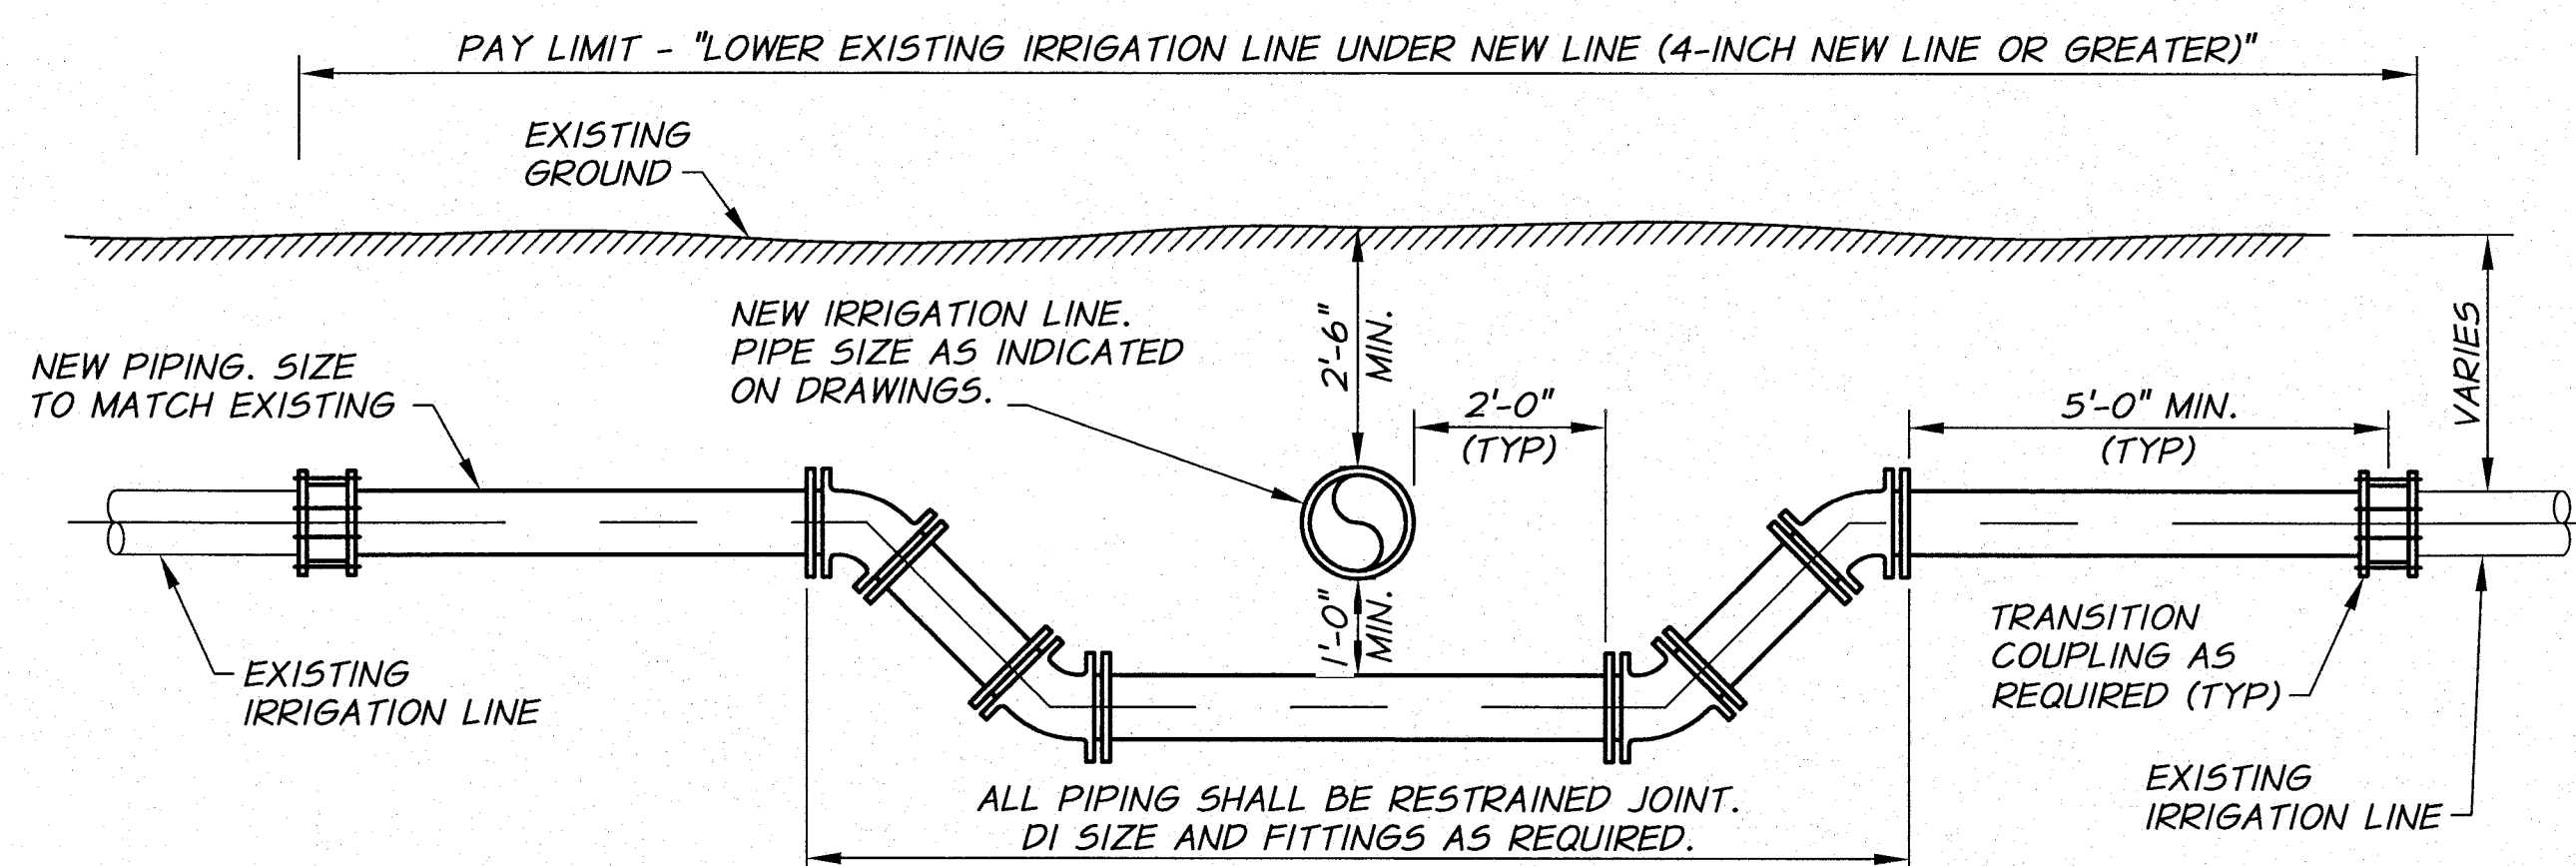


LOWER EXISTING IRRIGATION LINE UNDER NEW
SECTION
N.T.S.

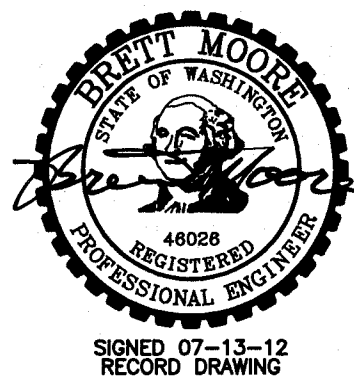

REVISION	BY	DATE	HORIZ. SCALE	NONE	VERT. SCALE
DESIGNED BY	R. HARRIS		JOB NUMBER	1199-336	DATE
DRAWN BY	D. CHRISTMAN		ACAD FILE	lrrgDets2-PH3A.dwg	
REVIEWED BY	B. MOORE		COPYRIGHT 2011 BY ANDERSON-PERRY & ASSOC., INC.		

RECORD DRAWINGS

These record drawings have been prepared, in part, on the basis of information compiled and furnished by others. They may contain some discrepancies and omissions, and do not necessarily represent "exact" field conditions. The Owner and the Engineer accept no responsibility for their accuracy.

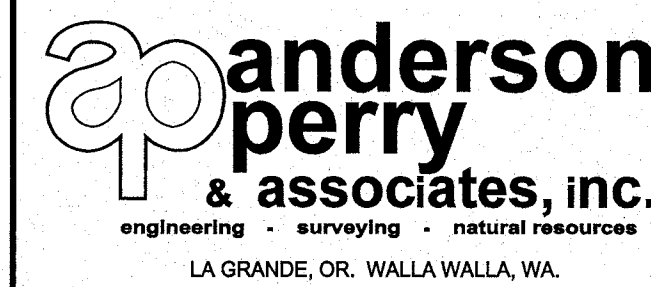

BENTON IRRIGATION DISTRICT
IRRIGATION SYSTEM IMPROVEMENTS
PHASE 3A

MISCELLANEOUS DETAILS III

SHEET


28

ARCHIVED


FITTING SCHEDULE

- ① PVC PIPE AS SHOWN ON PLANS
- ② SCH 80 PVC TRANSITION COUPLING AND FITTINGS AS REQUIRED. FEMALE CONNECTION TO GIP.
- ③ SCH 40 GIP
- ④ BRASS THREADED BALL VALVE
- ⑤ G.I.P. UNION
- ⑥ SONNTAG ALUMINUM Y-FILTER WITH 40 MESH FILTER SCREEN. 1 1/4" FOR 1 1/2" MAIN, AND 2" FOR 2" MAIN WITH FITTINGS AS REQUIRED. INCLUDE 2 EACH 3/4" THREADED BRASS BALL VALVE WITH 3/4"x1/4" BUSHING AND BRASS QUICK COUPLING PLUG (UNVALVED) FOR OWNER GAUGE.
- ⑦ CARSON INDUSTRIES MODEL 2436-48 H SERIES BOX WITH LID

NOTE:
 THREAD CLEARANCE SHALL BE 3/8" MINIMUM. OVER TIGHTENED FITTINGS WILL BE REJECTED AND PIPING ASSEMBLY REASSEMBLED TO MEET REQUIREMENTS. SEE SPECIFICATIONS FOR MORE DETAILS.

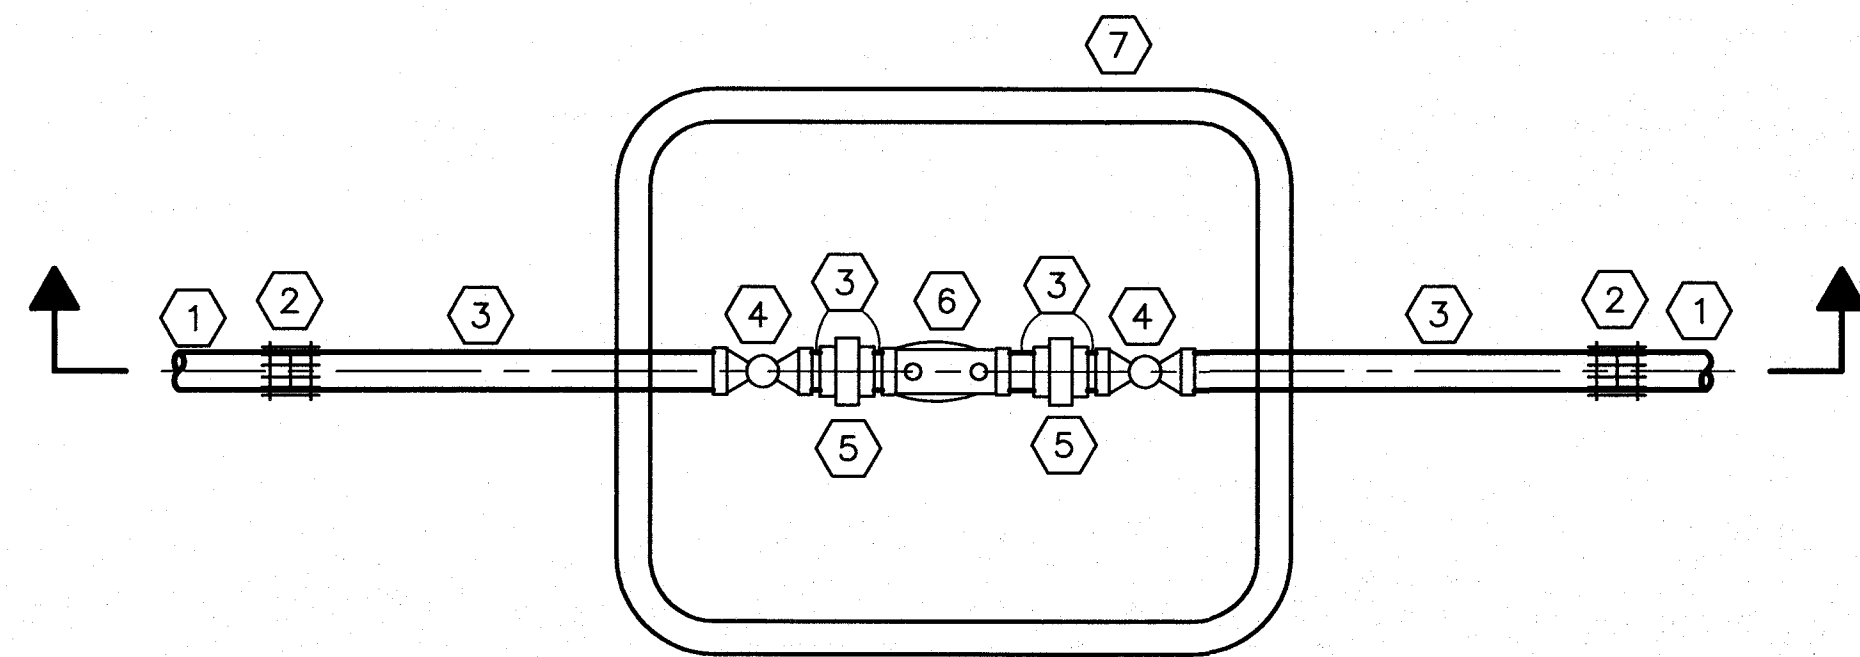

PLAN

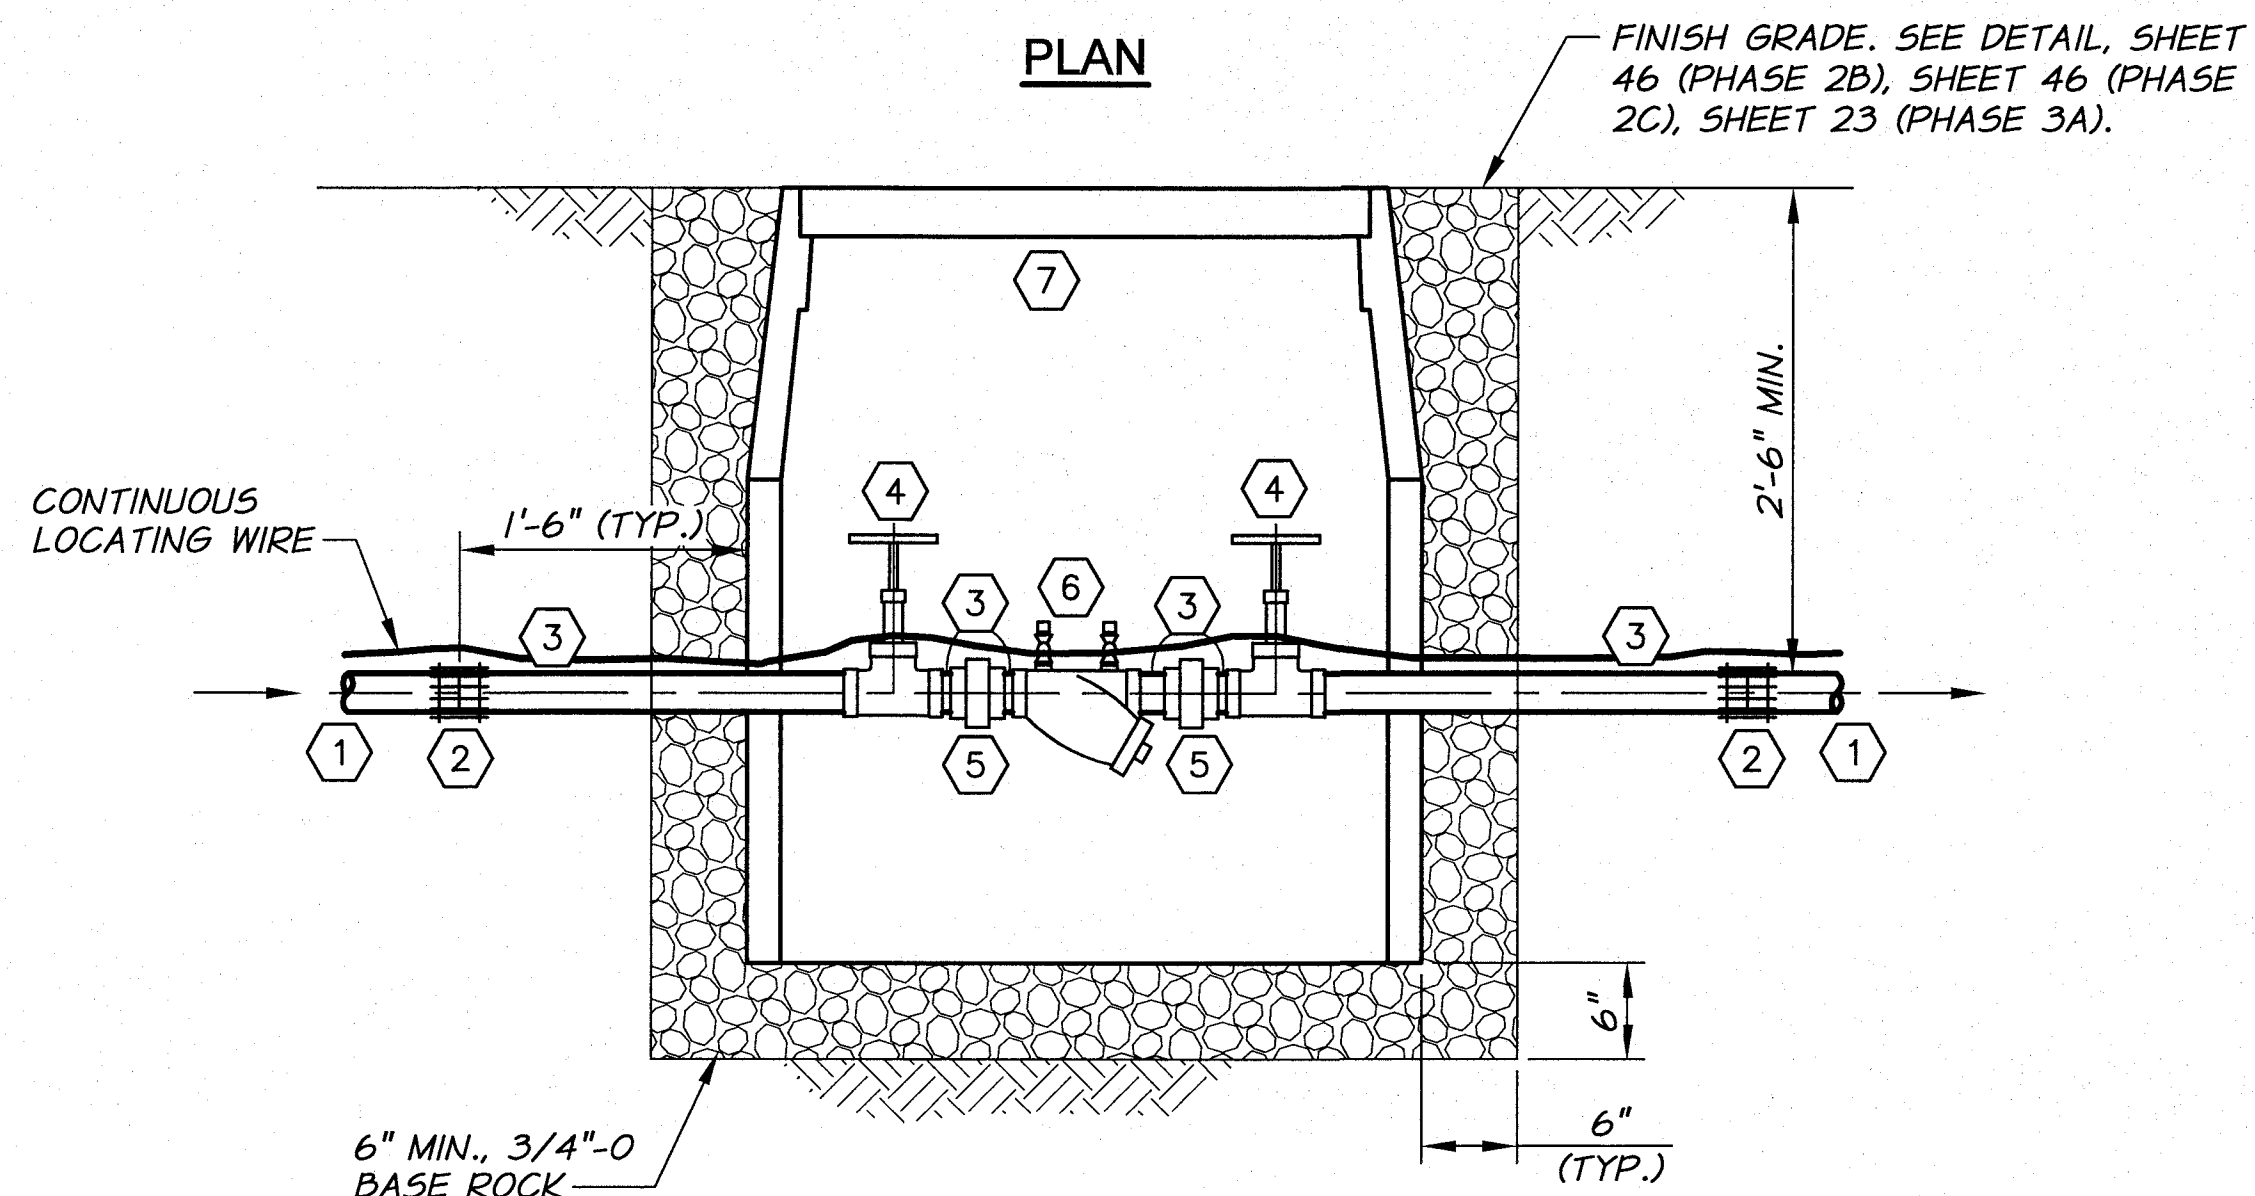


SECTION


TYPICAL 1 1/2" AND 2" IN-LINE FILTER VAULT DETAIL
 N.T.S.

FITTING SCHEDULE

- ①① PVC PIPE AS SHOWN ON PLANS
- ①② SCH 80 PVC TRANSITION COUPLING AND FITTINGS AS REQUIRED. FEMALE CONNECTION TO GIP.
- ①③ SCH 40 GIP
- ①④ BUTTERFLY VALVE WITH WHEEL OPERATOR AND POSITION INDICATOR
- ①⑤ FLANGE ADAPTER
- ①⑥ SONNTAG ALUMINUM Y-FILTER WITH 40 MESH FILTER SCREEN. 3" FOR 3" MAIN, AND 4" FOR 4" MAIN WITH FITTINGS AS REQUIRED. INCLUDE 2 EACH 3/4" THREADED BRASS BALL VALVE WITH 3/4"x1/4" BUSHING AND BRASS QUICK COUPLING PLUG (UNVALVED) FOR OWNER GAUGE.
- ①⑦ CARSON INDUSTRIES MODEL 2448-48 H SERIES BOX WITH LID

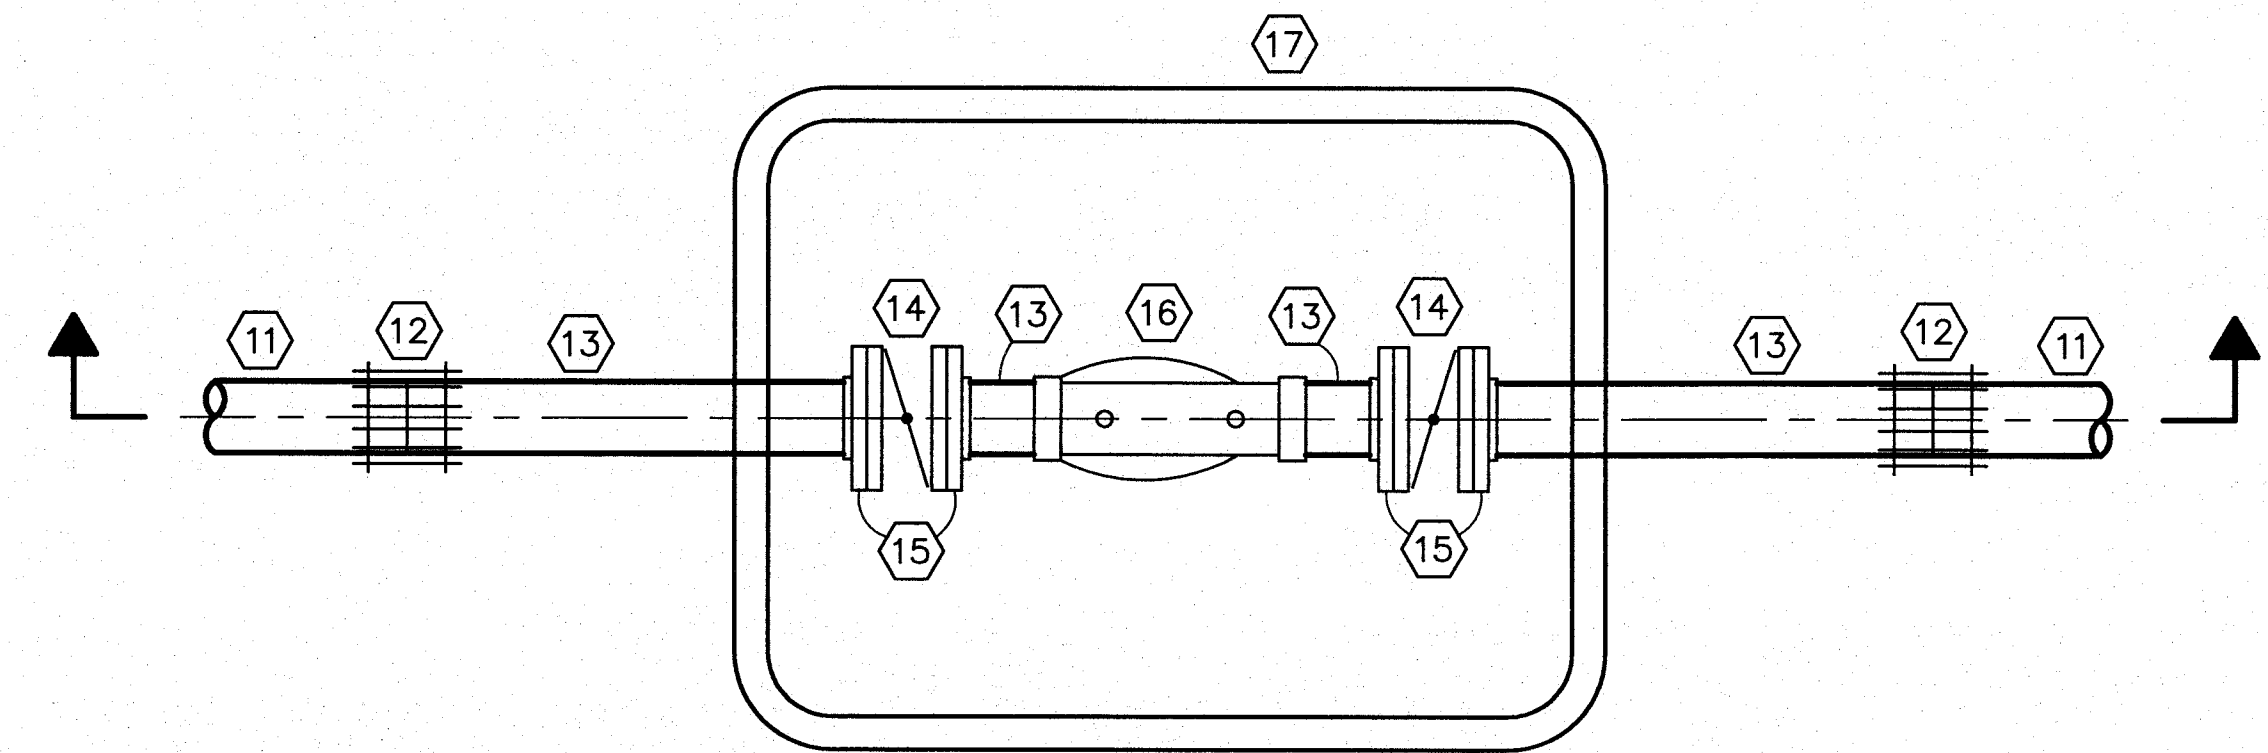


PLAN

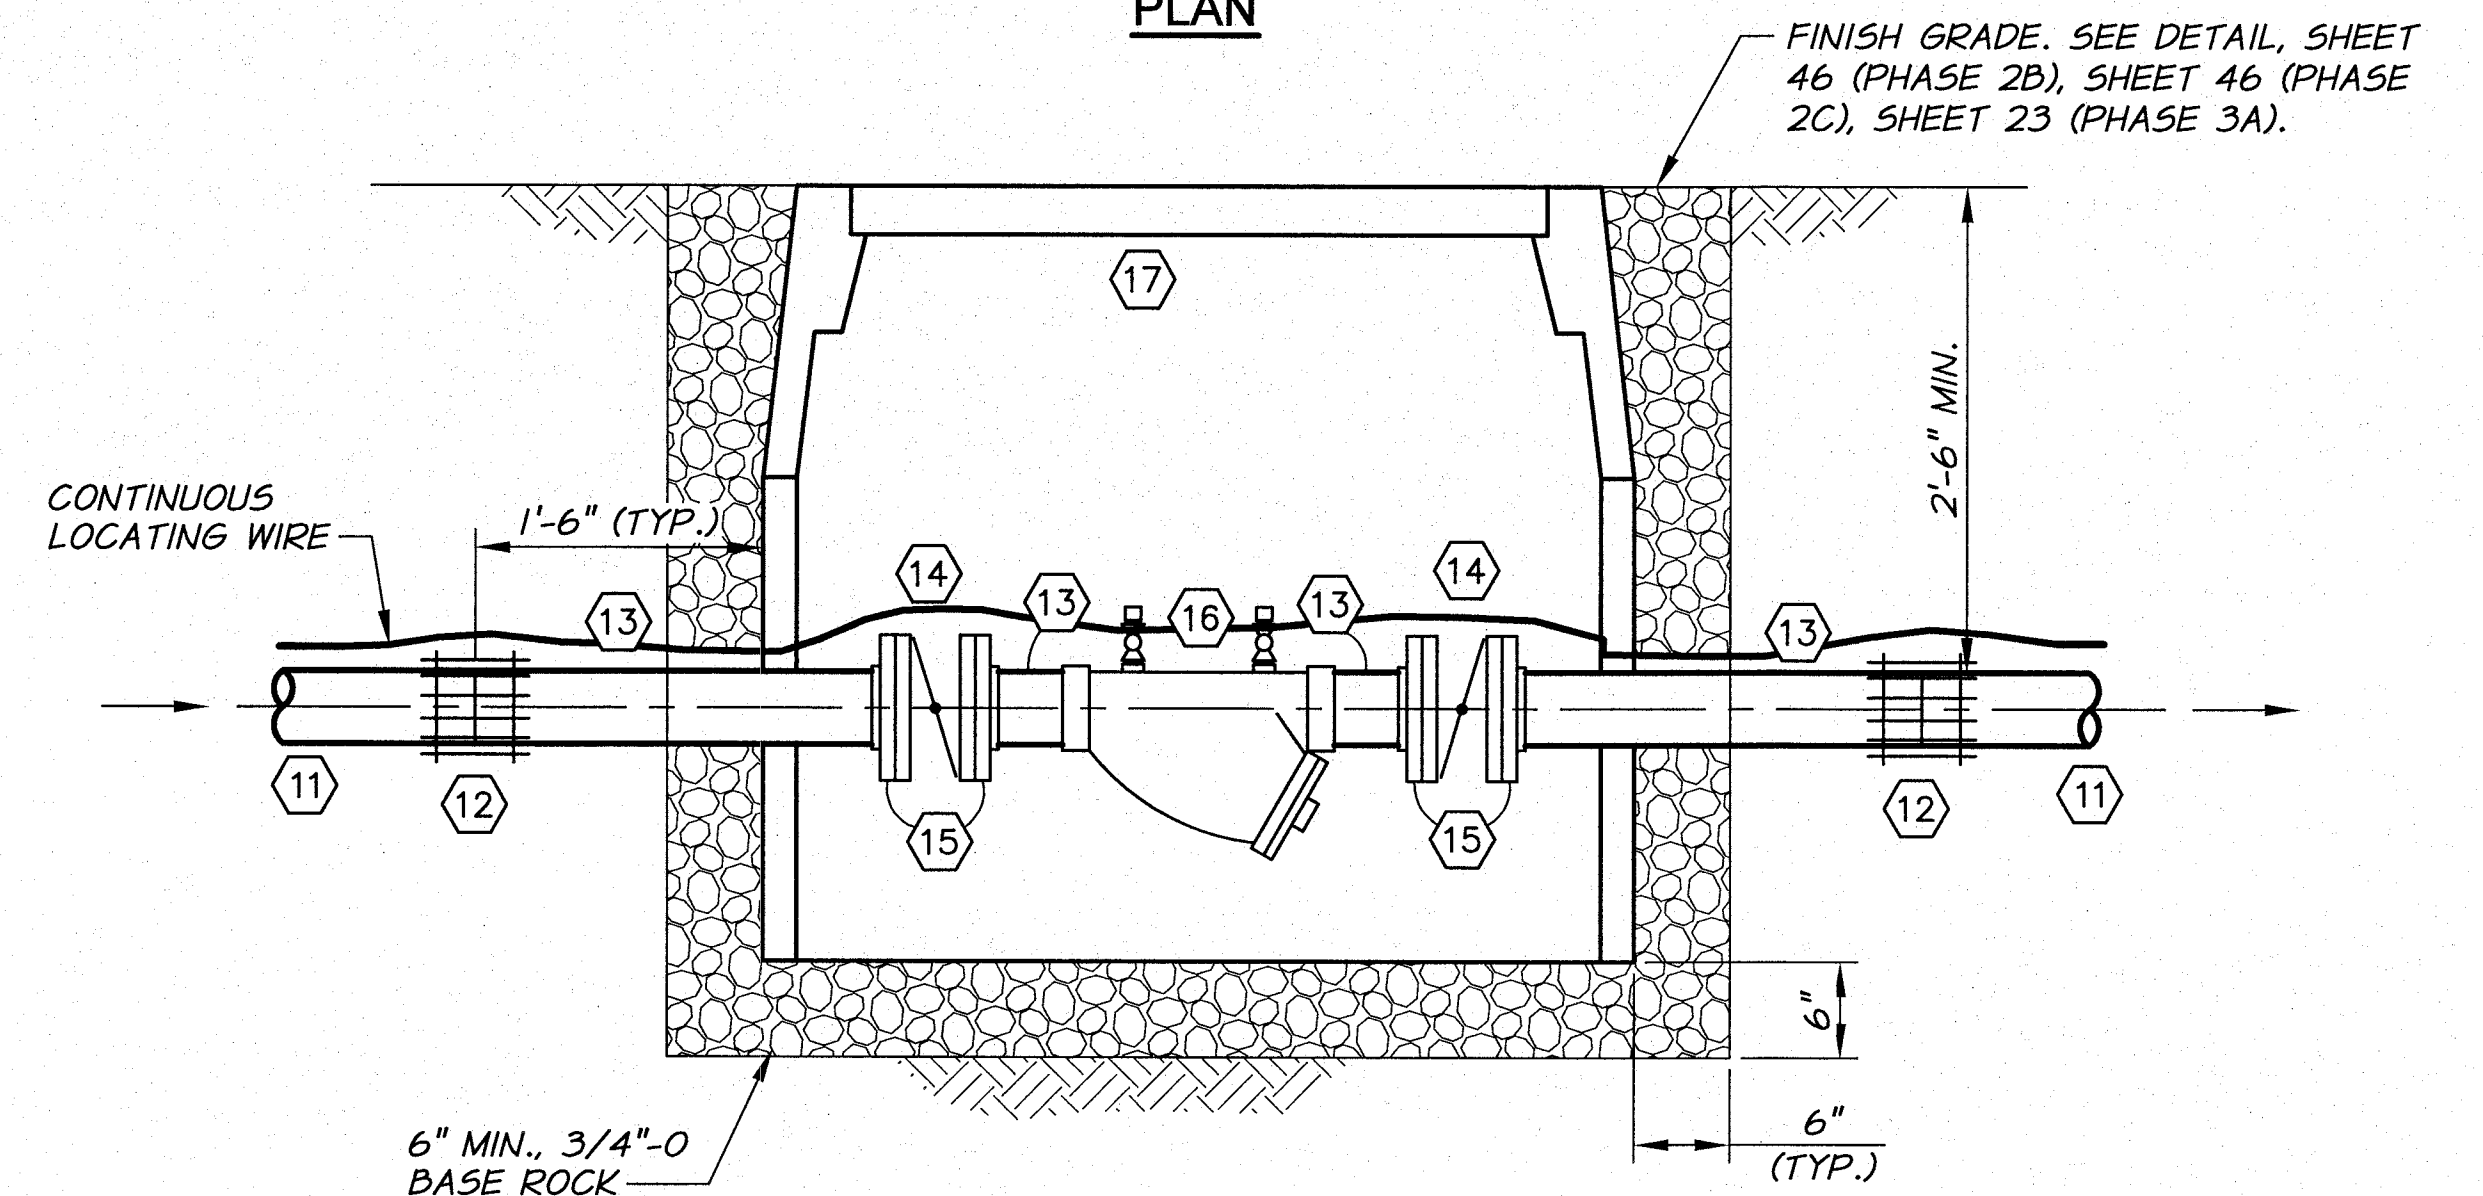

SECTION


TYPICAL 3" AND 4" IN-LINE FILTER VAULT DETAIL
 N.T.S.

▲ ADDED SHEET

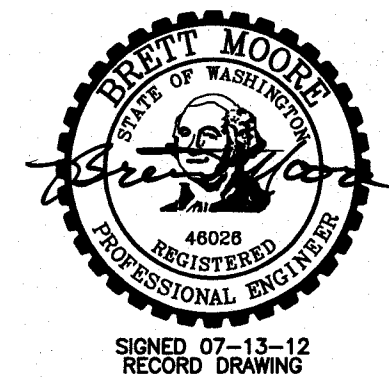

RECORD DRAWING		BY	B.M.	DATE	7/12
DESIGNED BY	R. HARRIS	HORZ. SCALE	NONE	VERT. SCALE	
DRAWN BY	D. CHRISTMAN	JOB NUMBER	1199-336	DATE	2011
REVIEWED BY	B. MOORE	ACAD FILE	InlineFilter-Ph3A.dwg		
COPYRIGHT 2011 BY ANDERSON-PERRY & ASSOC., INC.					

RECORD DRAWINGS
 These record drawings have been prepared, in part, on the basis of information compiled and furnished by others. They may contain some discrepancies and omissions, and do not necessarily represent "exact" field conditions. The Owner and the Engineer accept no responsibility for their accuracy.

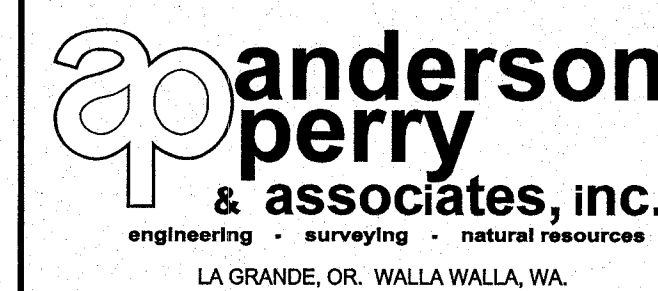


BENTON IRRIGATION DISTRICT
 IRRIGATION SYSTEM IMPROVEMENTS
 PHASE 3A
 MISCELLANEOUS DETAILS IV

SHEET
28A


ARCHIVED

THE TOP 18" OF TOPSOIL IN THE EXCAVATION AREA SHALL BE REMOVED AND STOCKPILED AT A SEPARATE LOCATION FROM GENERAL TRENCH EXCAVATION. THIS TOPSOIL SHALL NOT BE MIXED OR CONTAMINATED WITH ANY OTHER MATERIAL. UPON COMPLETION OF THE TRENCH BACKFILL, AND AFTER ALL ROCKS AND UNSUITABLE MATERIAL HAVE BEEN REMOVED FROM WORK AREA, THE TOPSOIL SHALL BE REPLACED AND GRADED TO MATCH EXISTING GROUND. THE DISTURBED AREA SHALL THEN BE HYDROSEED ACCORDING TO HYDROSEED RESTORATION.

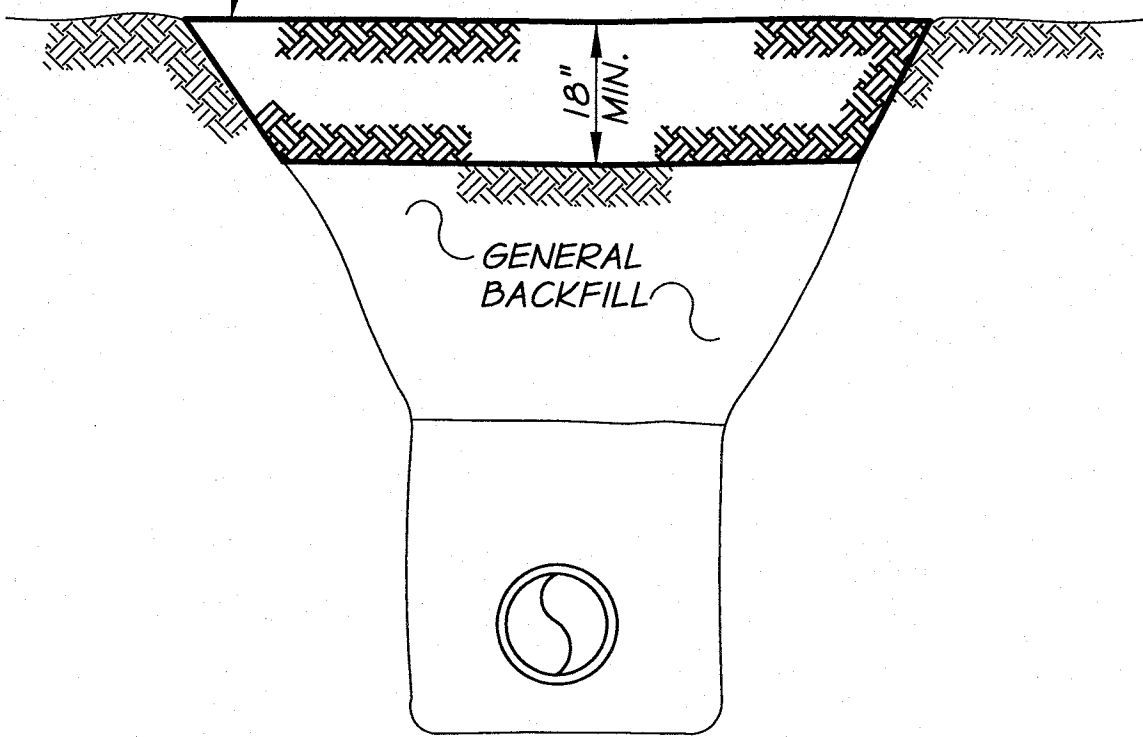


TRENCH RESTORATION
AGRICULTURAL AREAS
N.T.S.

REMOVE DEBRIS AND ROCK WHICH ARE NOT TYPICAL TO THE AREA. REPLACE TOPSOIL EQUAL TO EXISTING OR 6" WHICH EVER IS GREATER. RAKE AND SHAPE TO MATCH EXISTING. HYDROSEED PER HYDROSEED RESTORATION.

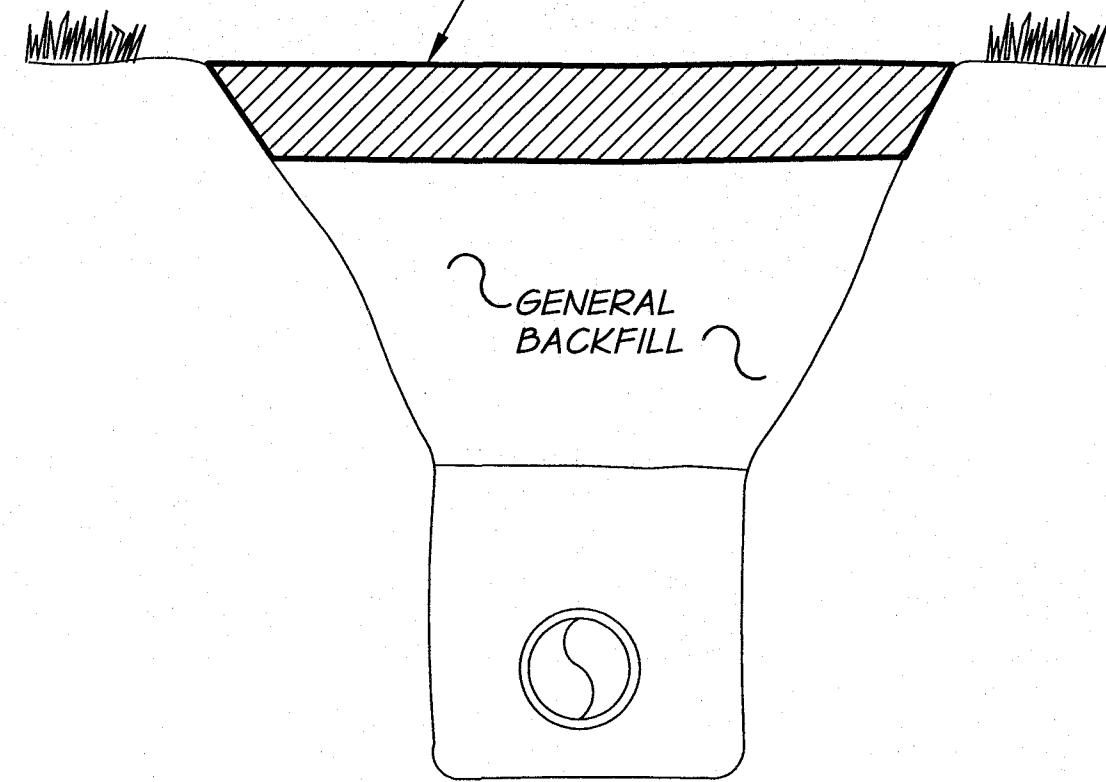


TRENCH RESTORATION
LAWNS & LANDSCAPED AREAS
N.T.S.

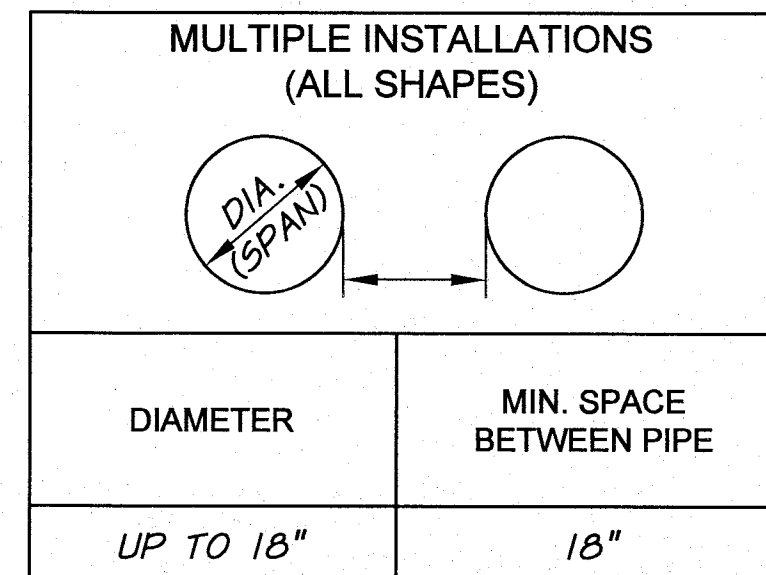


NOTES
1. SURFACING OF PAVED AREAS SHALL COMPLY WITH STREET CUT STANDARD DRAWING.


TRENCH BACKFILL AND BEDDING TABLE			
	ASPHALT SURFACE RESTORATION	GRAVEL STREETS, ROADWAYS, SHOULDERS AND PARKING AREAS	GENERAL / HYDROSEED RESTORATION AREAS
SURFACE	SURFACING MATCHING EXISTING	3/4"-0 GRAVEL AGGREGATE (FOR THICKNESS SEE DETAIL THIS SHEET)	TOPSOIL OR AS DIRECTED
BASE MATERIAL UNDER SURFACE	3/4"-0 BASE ROCK	GENERAL BACKFILL	TOPSOIL OR AS DIRECTED
GENERAL BACKFILL	3/4"-0 BASE ROCK	GENERAL BACKFILL	GENERAL BACKFILL
SELECT BACKFILL	3/4"-0 BASE ROCK	3/4"-0 BASE ROCK	3/4"-0 BASE ROCK
BEDDING	3/4"-0 BASE ROCK	3/4"-0 BASE ROCK	3/4"-0 BASE ROCK

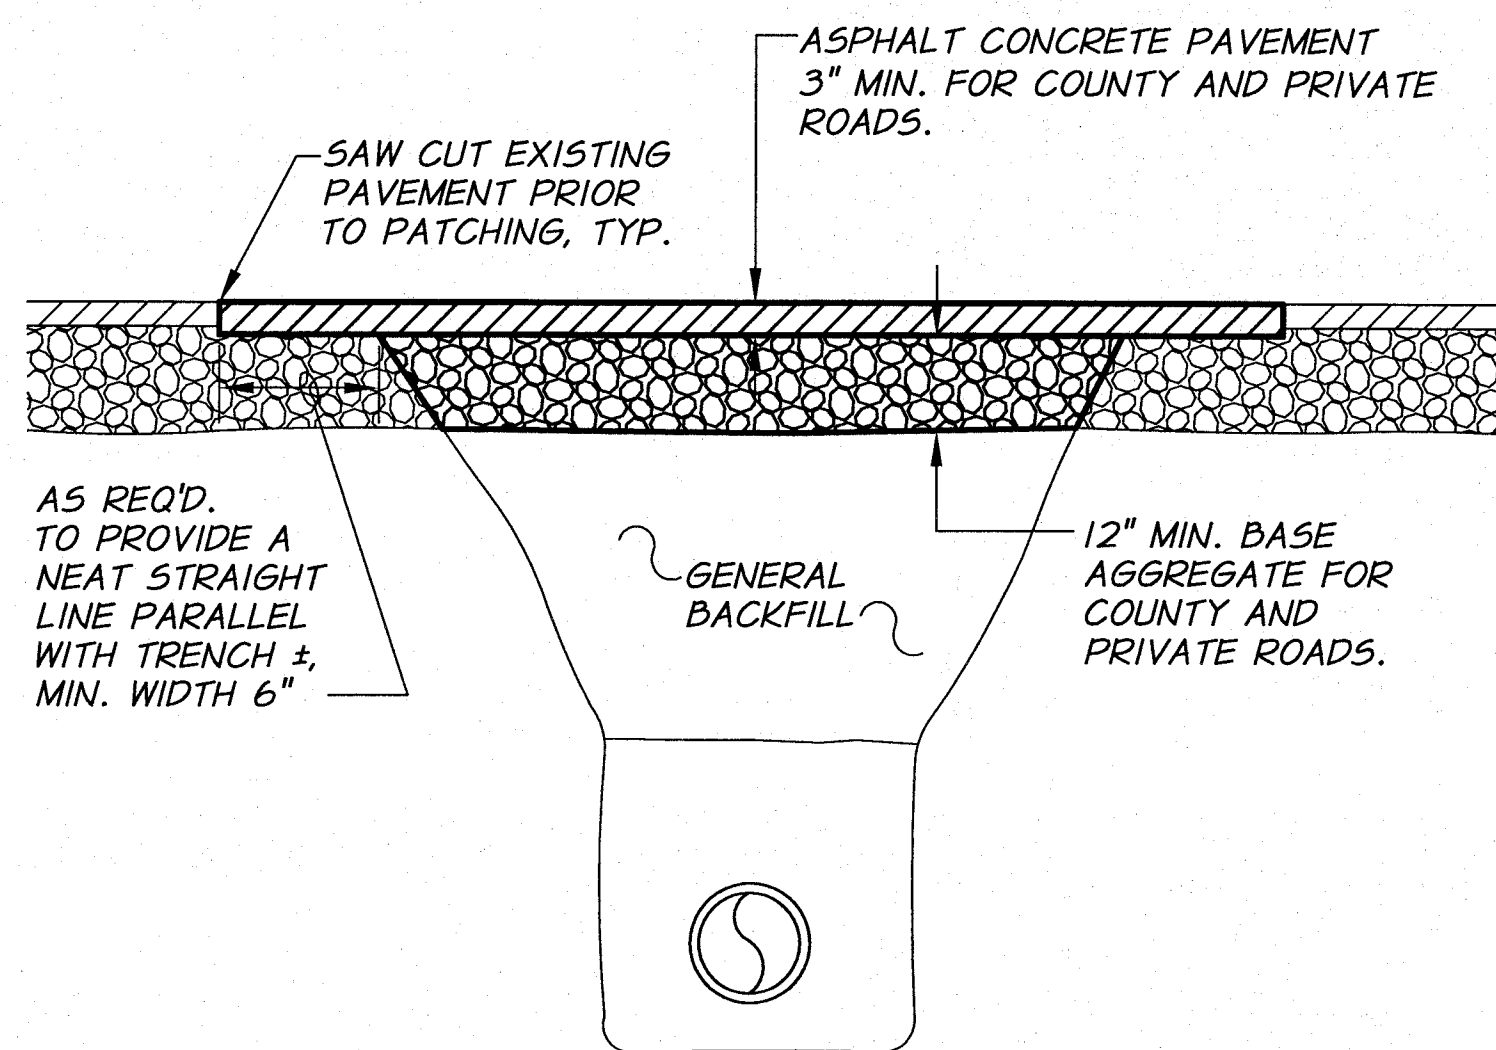


TRENCH RESTORATION
PAVED STREETS AND ROADWAYS
("ASPHALT SURFACE RESTORATION" PAY ITEM)
N.T.S.

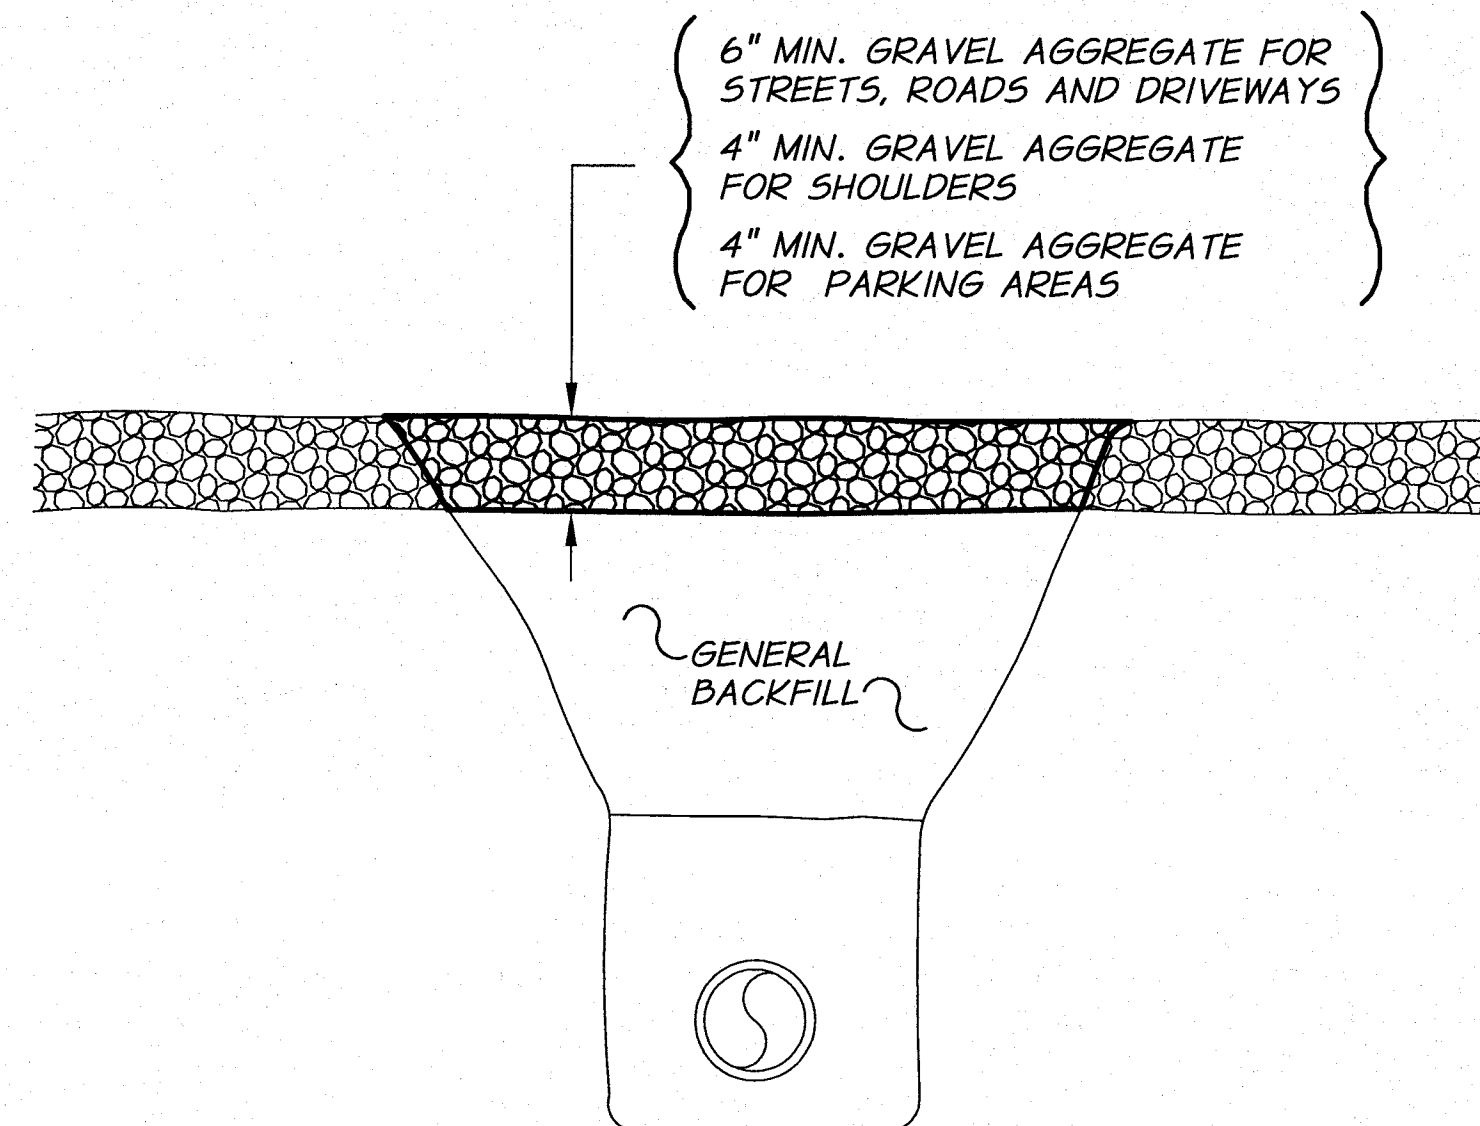


TRENCH RESTORATION
GRAVEL STREETS, ROADWAYS, SHOULDERS, AND PARKING AREAS
("GRAVEL SURFACE RESTORATION" PAY ITEM)
N.T.S.

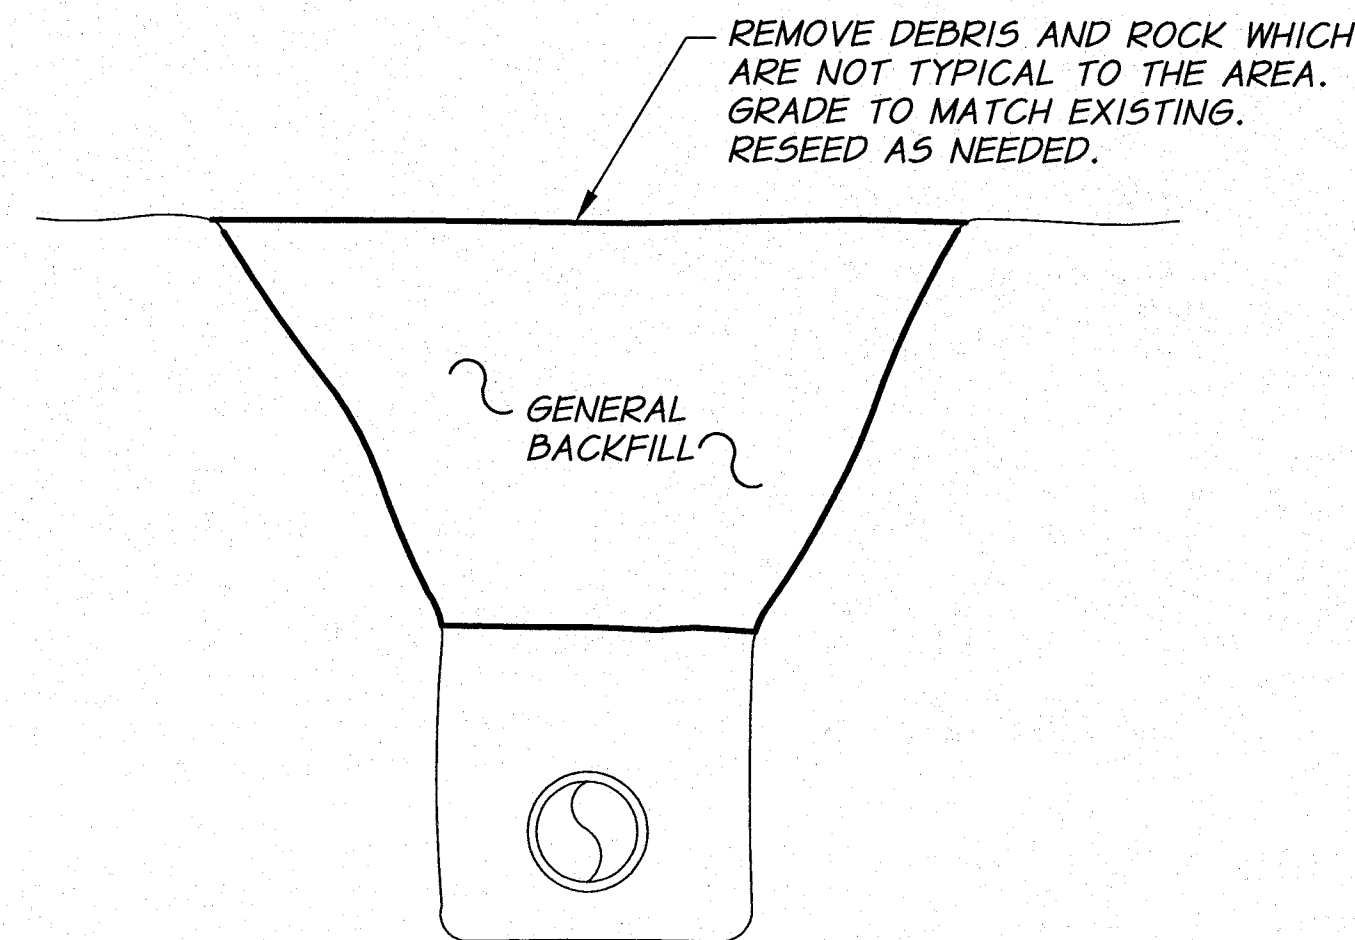

TRENCH RESTORATION
GENERAL AREAS
N.T.S.

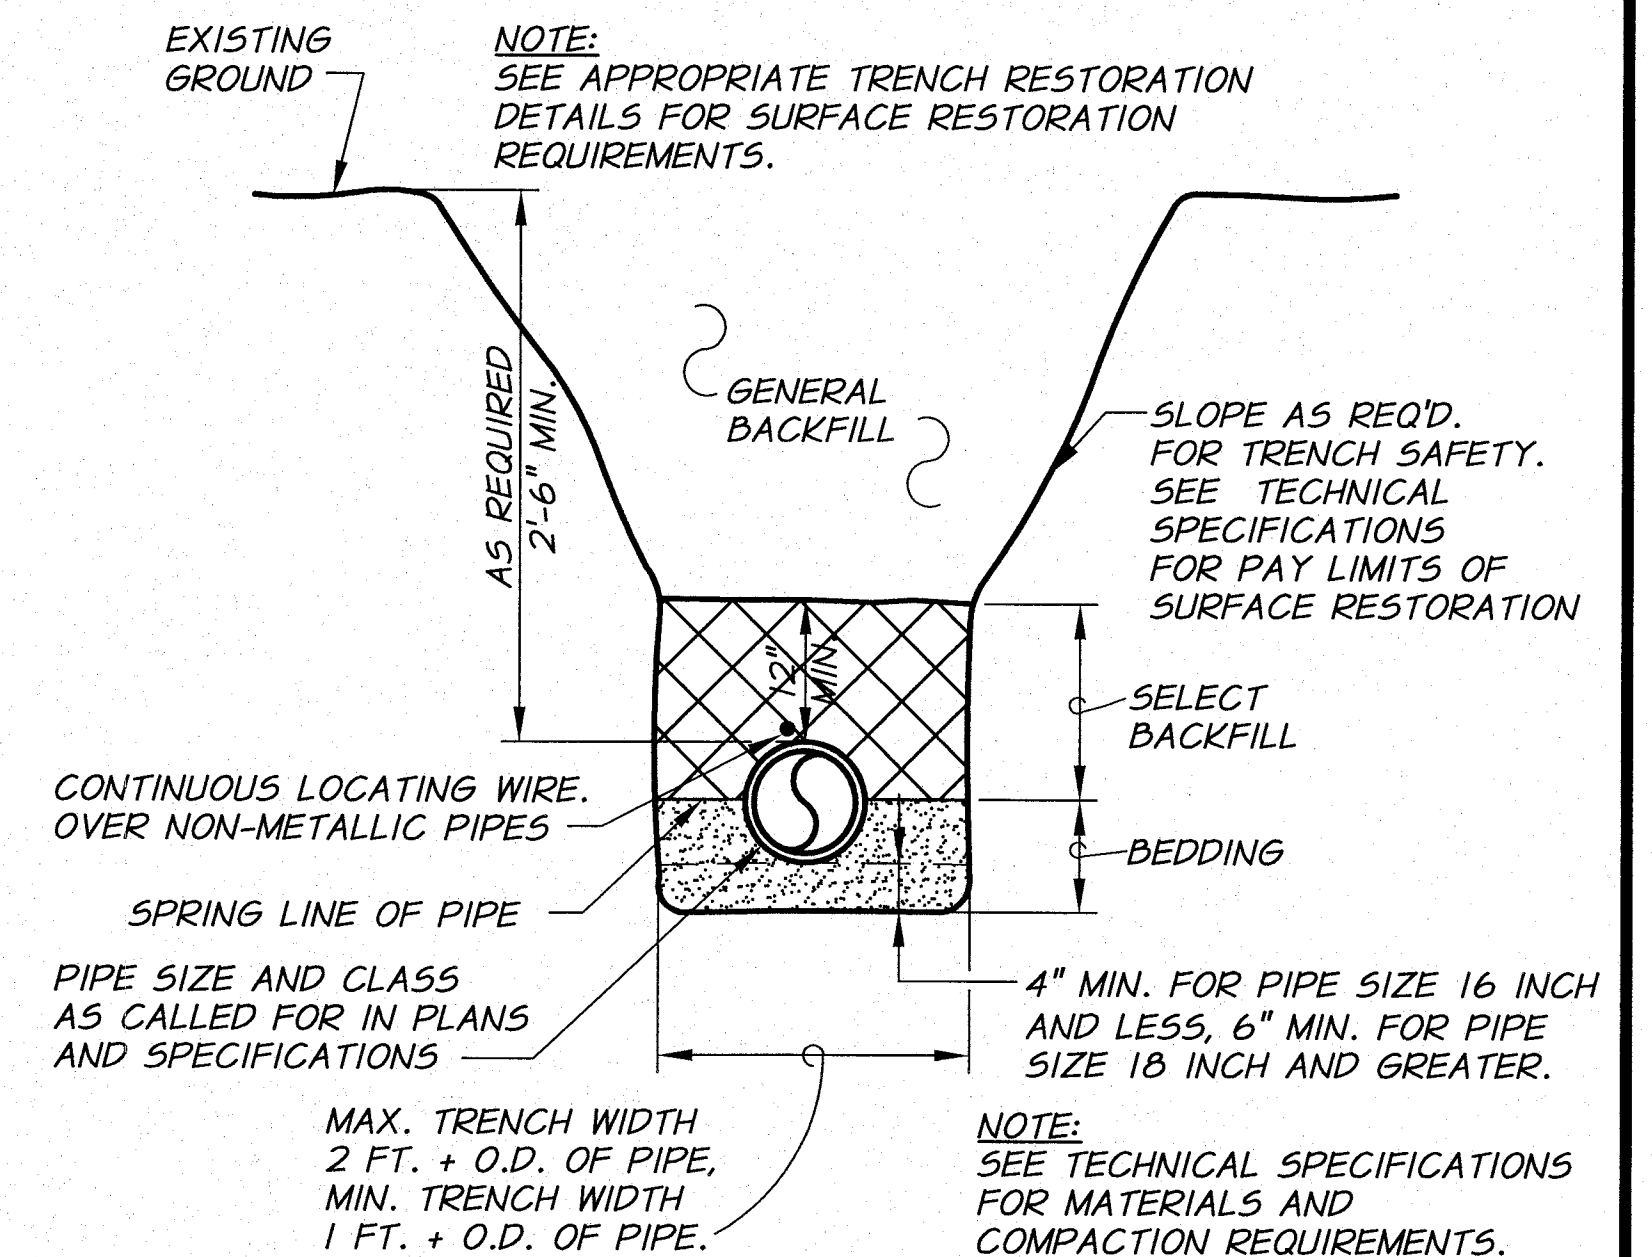


TRENCH EXCAVATION AND BACKFILL
N.T.S.

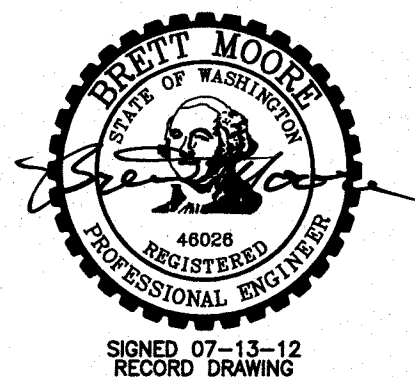

REVISION	BY	DATE	HORIZ. SCALE	VERT. SCALE
DESIGNED BY	R. HARRIS		NONE	
DRAWN BY	D. CHRISTMAN		JOB NUMBER	1199-336
REVIEWED BY	B. MOORE		DATE	2011
			ACAD FILE	TrenchDets-PH3A.dwg
COPYRIGHT 2011 BY ANDERSON-PERRY & ASSOC., INC.				

RECORD DRAWINGS

These record drawings have been prepared, in part, on the basis of information compiled and furnished by others. They may contain some discrepancies and omissions, and do not necessarily represent "exact" field conditions. The Owner and the Engineer accept no responsibility for their accuracy.

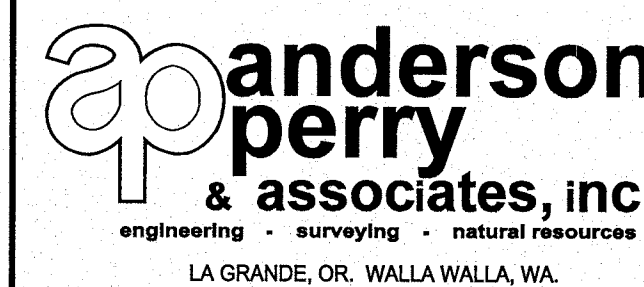

BENTON IRRIGATION DISTRICT
IRRIGATION SYSTEM IMPROVEMENTS
PHASE 3A

TRENCH DETAILS

SHEET

29

THRUST BLOCK NOTES

- THRUST BLOCKS SHALL BE REQUIRED AT THE FOLLOWING LOCATIONS:
 - ALL CHANGES IN DIRECTION.
 - ALL DEAD-ENDS.
 - ALL VALVES 8-INCHES AND LARGER SHALL BE SIZE FOR CLOSED CONDITION EXCEPTIONS:
 - WHEN RESTRAINED JOINT PIPE IS USED ON BOTH SIDES OF VALVE.
 - WHEN VALVE IS RESTRAINED JOINT CONNECTED TO A FITTING WHICH HAS APPROPRIATE THRUST BLOCKING.
 - AT LOCATIONS SPECIFICALLY CALLED OUT ON THE DRAWINGS.
 - AT TEMPORARY DEAD ENDS DURING PIPE INSTALLATIONS AS REQUIRED FOR TEMPORARY PRESSURE TESTING.
 - AT OTHER LOCATIONS REQUIRED BY THE ENGINEER.
- THRUST BLOCKS SHALL BE SIZED AS REQUIRED BY SOIL CONDITIONS AND DESIGN PRESSURE.
- PLACE CONCRETE AGAINST UNDISTURBED TRENCH WALL.
- CONCRETE SHALL BE 2,500 PSI MINIMUM.
- ALL CONCRETE SHALL BE PLACED SO THAT PIPE, FITTING JOINTS, BOLTS AND NUTS, ETC., WILL BE ACCESSIBLE FOR REPAIRS.
- PLACE ONE LAYER OF VISQUEEN BETWEEN FITTING AND CONCRETE TO FACILITATE FUTURE REMOVAL OF THRUST BLOCK IF REQUIRED.
- ANCHOR RODS SHALL BE 3/4" DIAMETER GALVANIZED STEEL RODS OR #6 EPOXY COATED REINFORCEMENT BAR, AASHTO M284, HAVING AN 18" MINIMUM EMBEDMENT IN CONCRETE.
- IF THE REQUIRED BEARING AREA IS LESS THAN 1 SQUARE FOOT, A THRUST BLOCK SHALL NOT BE REQUIRED.
- WHERE THRUST BLOCK IS NOT DESIGNATED, ALL THRUST BLOCKS SHALL BE SIZED PER THE PRESSURES SHOWN IN THE TECHNICAL SPECIFICATIONS, UNLESS OTHERWISE NOTED.

DETERMINATION OF THRUST BLOCK BEARING AREA

NOTE: WHEN THRUST BLOCK BEARING AREA IS NOT SPECIFIED ON THE PLANS OR DETERMINED BY THE ENGINEER, THE FOLLOWING PROCEDURE SHALL BE USED TO DETERMINE REQUIRED BEARING AREA.

- DETERMINE THRUST (T) FOR TYPE OF FITTING OR JOINT AND SIZE OF PIPE FROM TABLE NO. 1 OR TABLE NO. 3.
- DETERMINE BEARING CAPACITY (B) OF SOIL FROM TABLE NO. 2.
- DETERMINE REQUIRED BEARING AREA (A) AS FOLLOWS:
 $A = T - B$

EXAMPLE: DESIGN PRESSURE = 175 PSI
 PIPE = 12"
 FITTING = TEE
 SOIL - SANDY GRAVEL

FROM TABLE NO. 1: T = 15,050 LB.
 FROM TABLE NO. 2: B = 3000 LB/SQ.FT.
 $A = \frac{15,050}{3,000} \times 1.75 = 8.8 \text{ SQ.FT.} = 9 \text{ SQ.FT. (ROUND UP TO NEAREST 3,000 WHOLE SQ.FT.)}$

TABLE NO. 1
THRUST AT FITTINGS IN POUNDS AT 100 PSI OF PRESSURE

PIPE SIZE	TEES AND DEAD ENDS	90° BEND	45° BEND	22 1/2° BEND	11 1/4° BEND
4"	1,680	2,310	1,290	660	340
6"	3,770	5,320	2,890	1,480	750
8"	6,690	9,460	5,120	2,620	1,320
10"	10,440	14,780	8,010	4,090	2,050
12"	15,050	21,280	11,520	5,880	2,960
14"	20,490	28,960	15,680	8,000	4,020
16"	26,750	37,830	20,470	10,440	5,260
18"	33,850	47,870	25,910	13,210	6,640
20"	41,790	59,090	31,980	16,310	8,190
24"	60,170	85,100	46,060	23,490	11,800

NOTE: FOR WATER PRESSURES DIFFERENT THAN 100 PSI, MULTIPLY THRUST FOUND IN TABLE NO. 1 BY REQUIRED PROPORTION.
 EXAMPLE: DESIGN PRESSURE = 175 PSI.
 MULTIPLY VALUE IN TABLE BY 1.75


TABLE NO. 2

SOIL	SAFE BEARING LOAD LB/SQ.FT.
SOFT CLAY	500
SILT	1,000
SAND	2,000
SAND AND GRAVEL	3,000
SAND AND GRAVEL CEMENTED WITH CLAY	4,000
HARD CLAY	4,000

TABLE NO. 3
SIDE THRUST PER 100 LB./SQ.IN. PRESSURE PER DEGREE OF DEFLECTION


PIPE SIZE	SIDE THRUST-LB	PIPE SIZE	SIDE THRUST-LB
4"	N/A	14"	360
6"	N/A	16"	470
8"	N/A	18"	600
10"	190	20"	730
12"	270	24"	1,050

MULTIPLY THRUST BY DEGREE OF DEFLECTION TO OBTAIN TOTAL THRUST

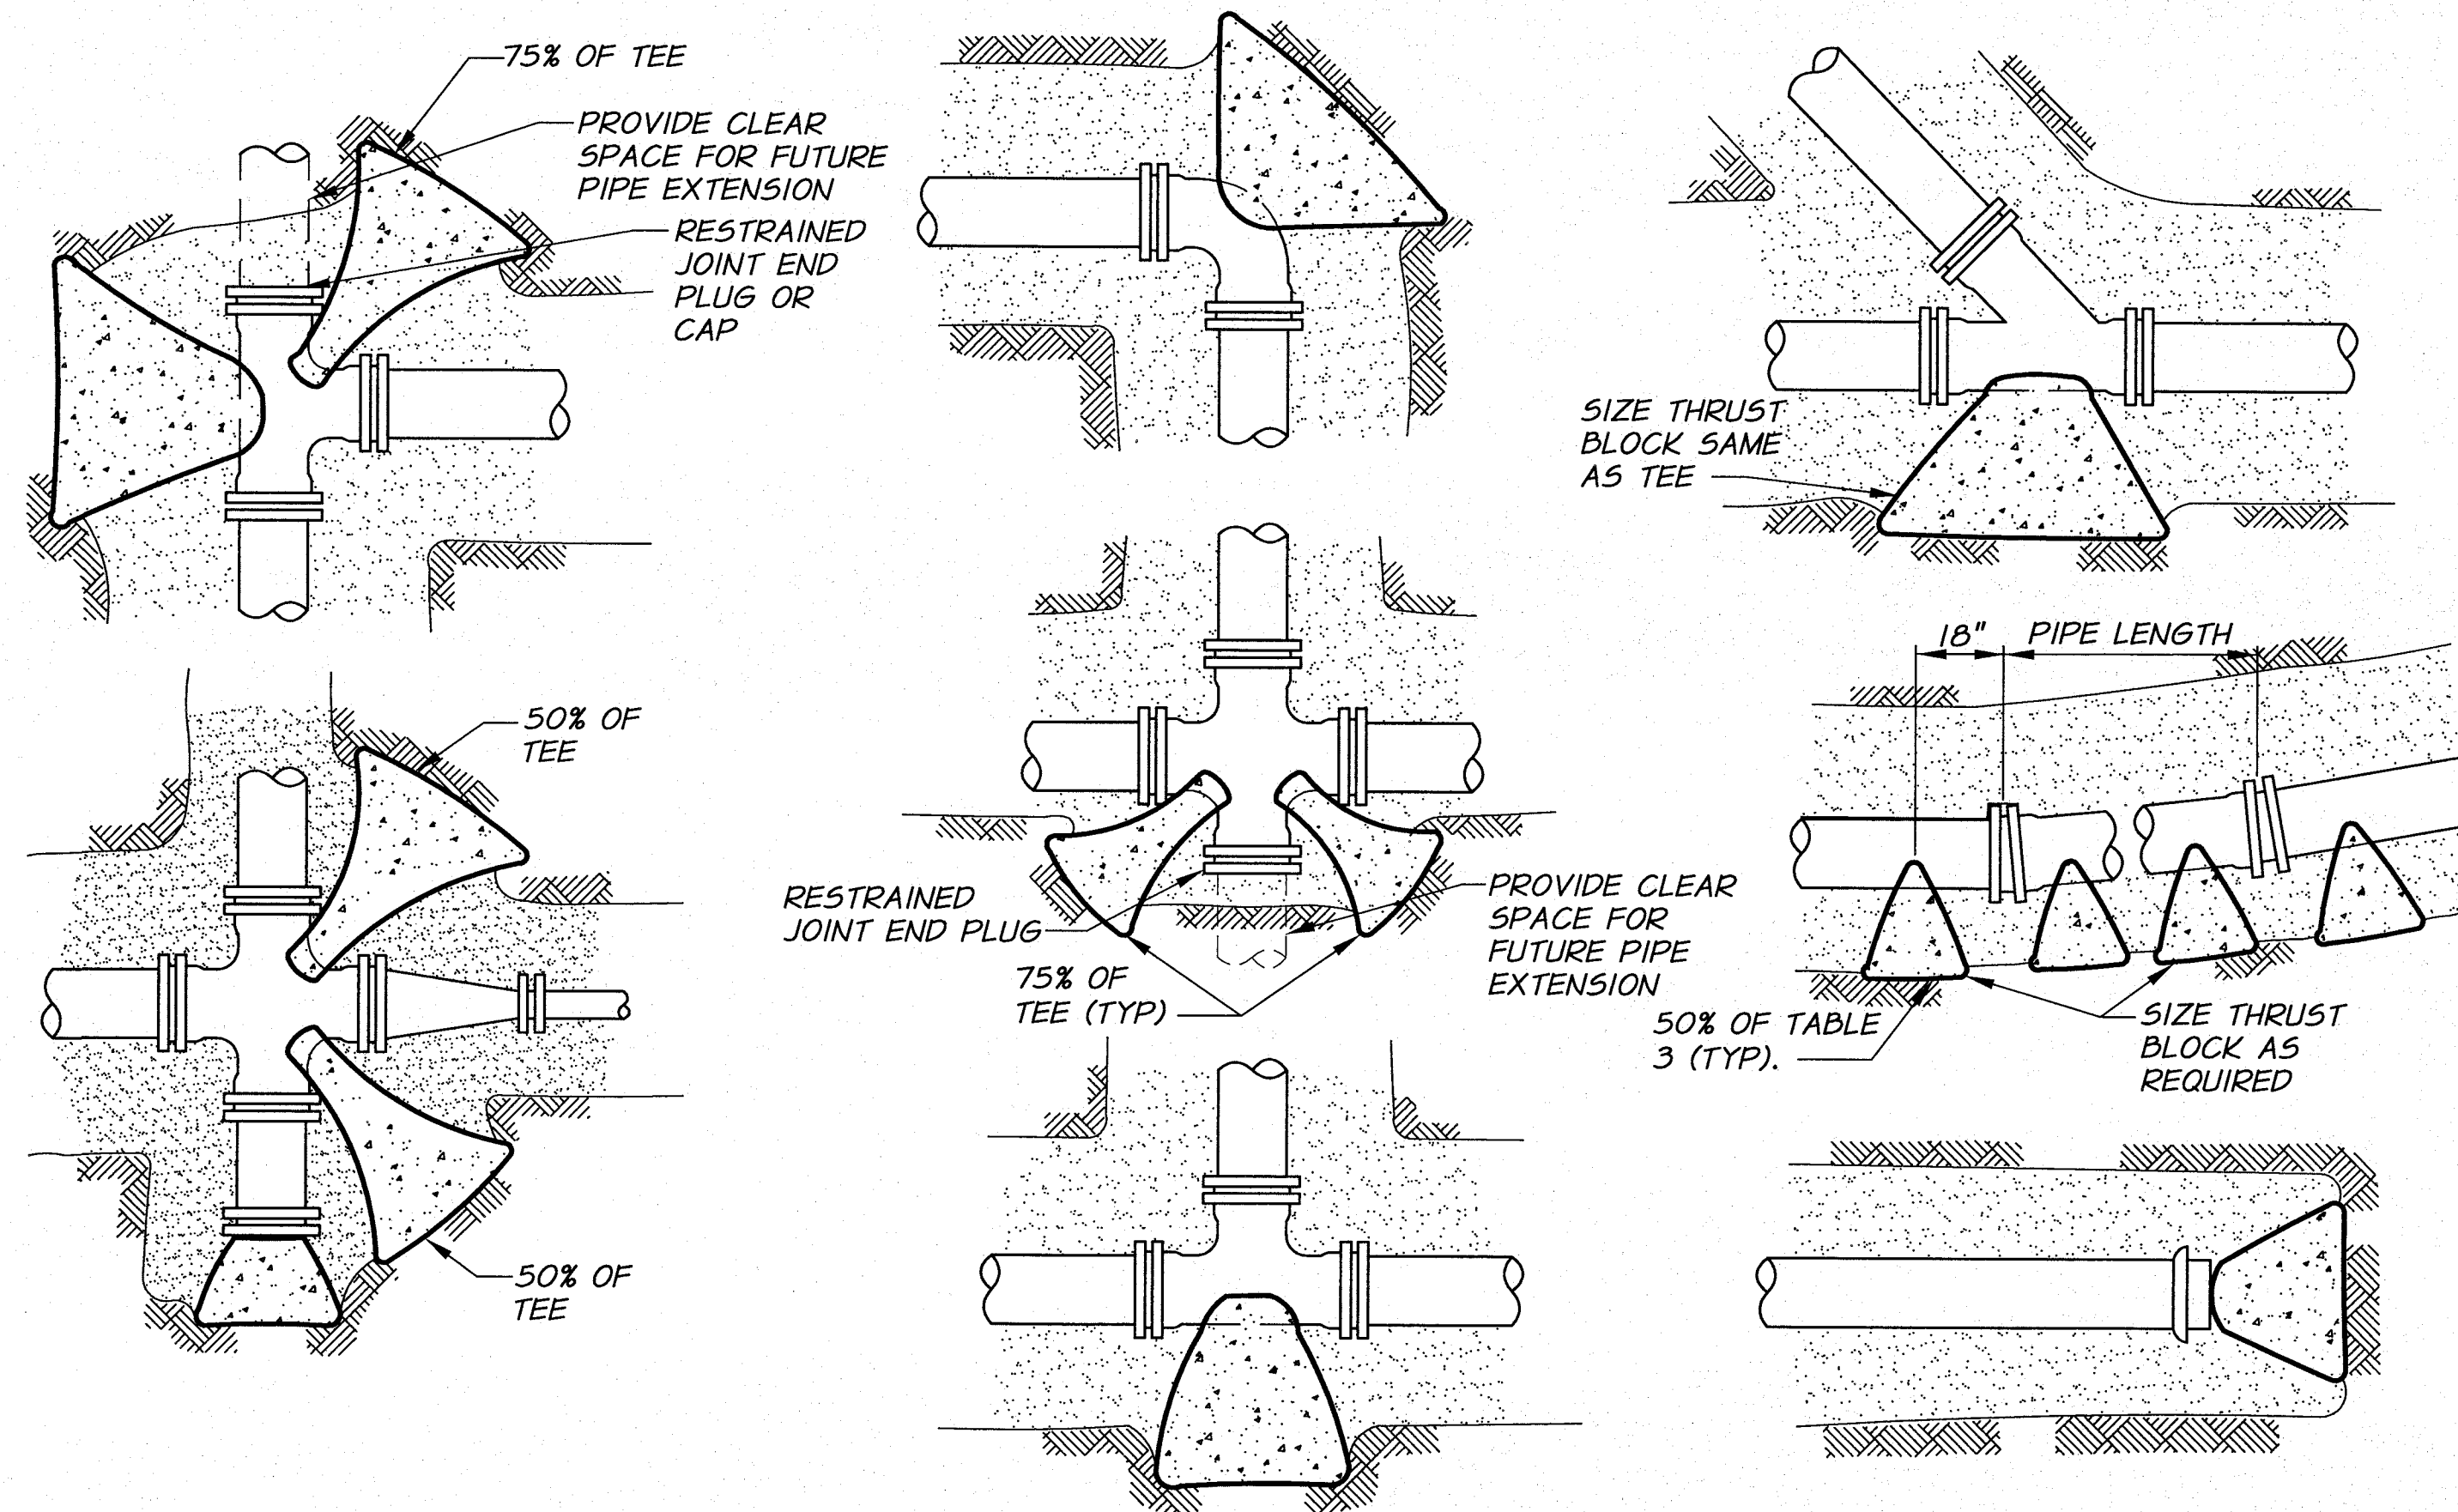


TYPICAL THRUST BLOCK LOCATIONS

PLAN VIEWS

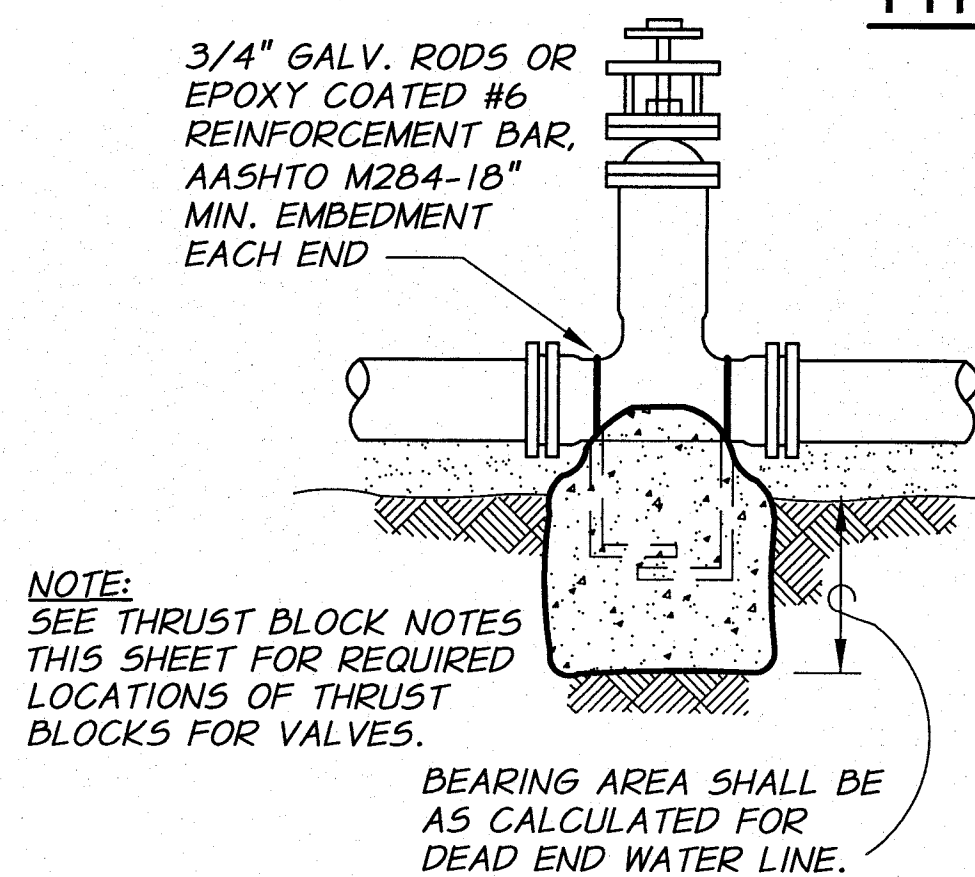


TYPICAL VALVE THRUST BLOCK

NOTE: NOT REQUIRED FOR VALVES WITH FLANGED CONNECTION TO TEE WITH THRUST BLOCK.

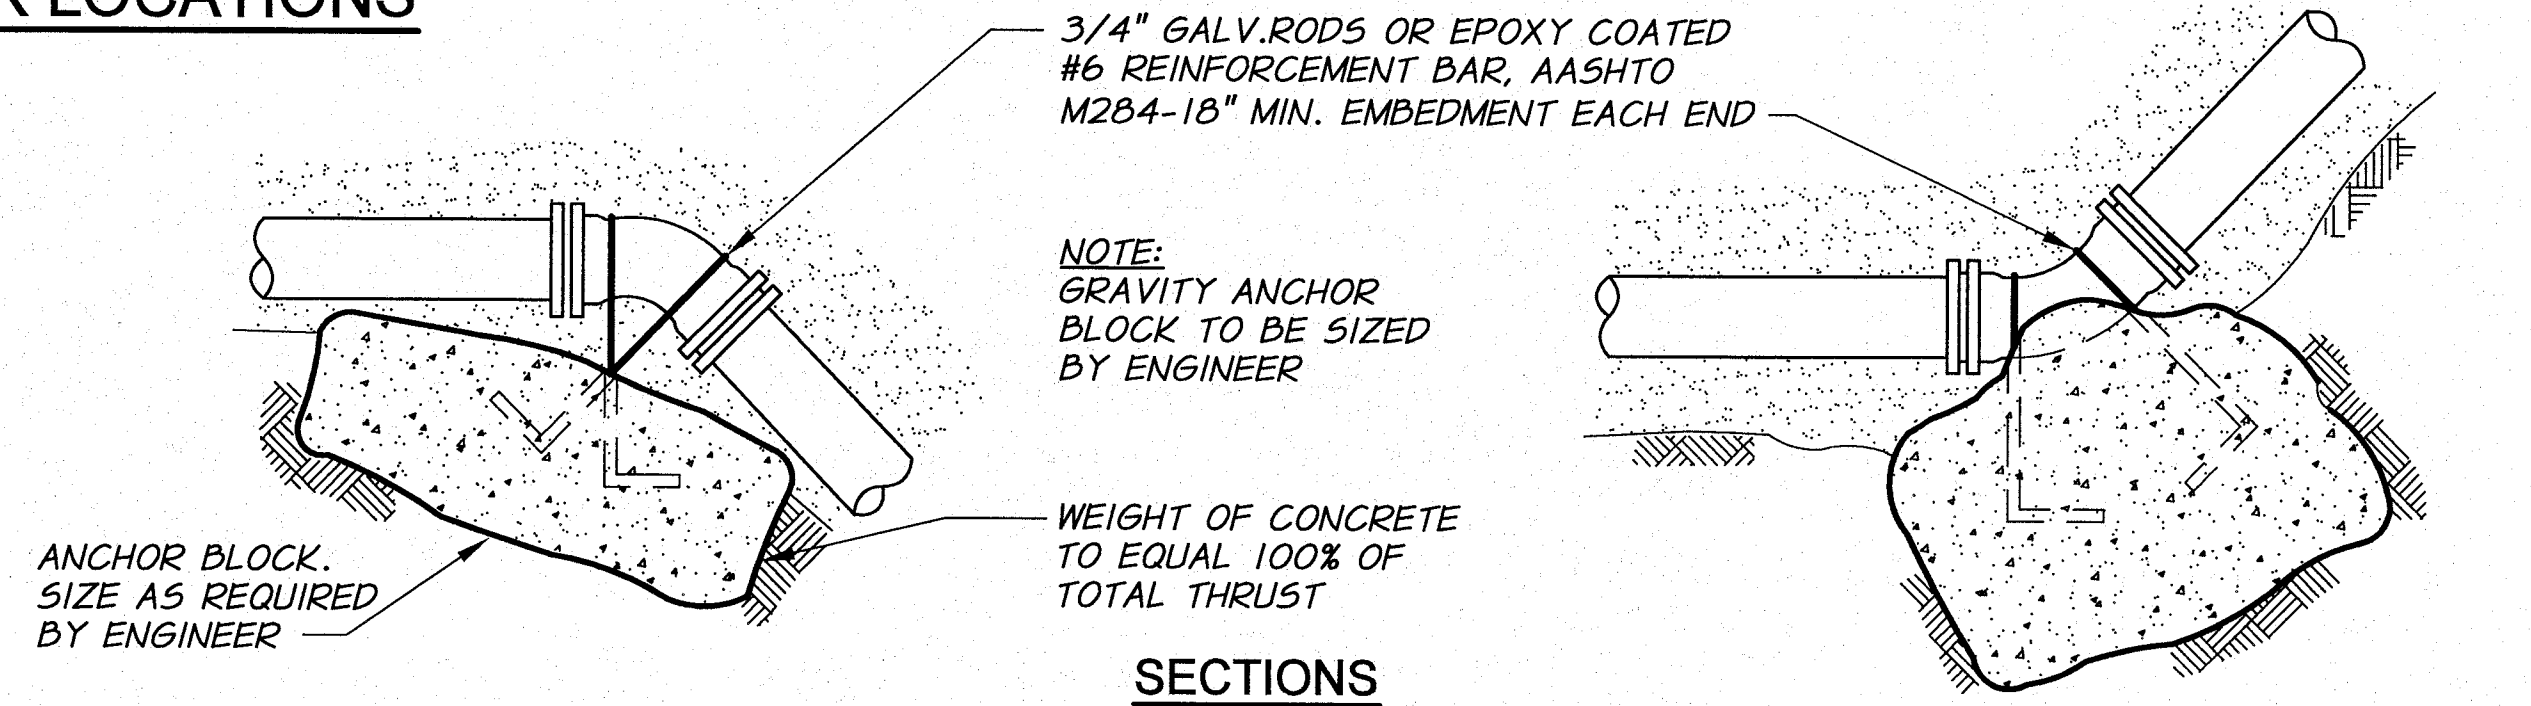


SECTIONS

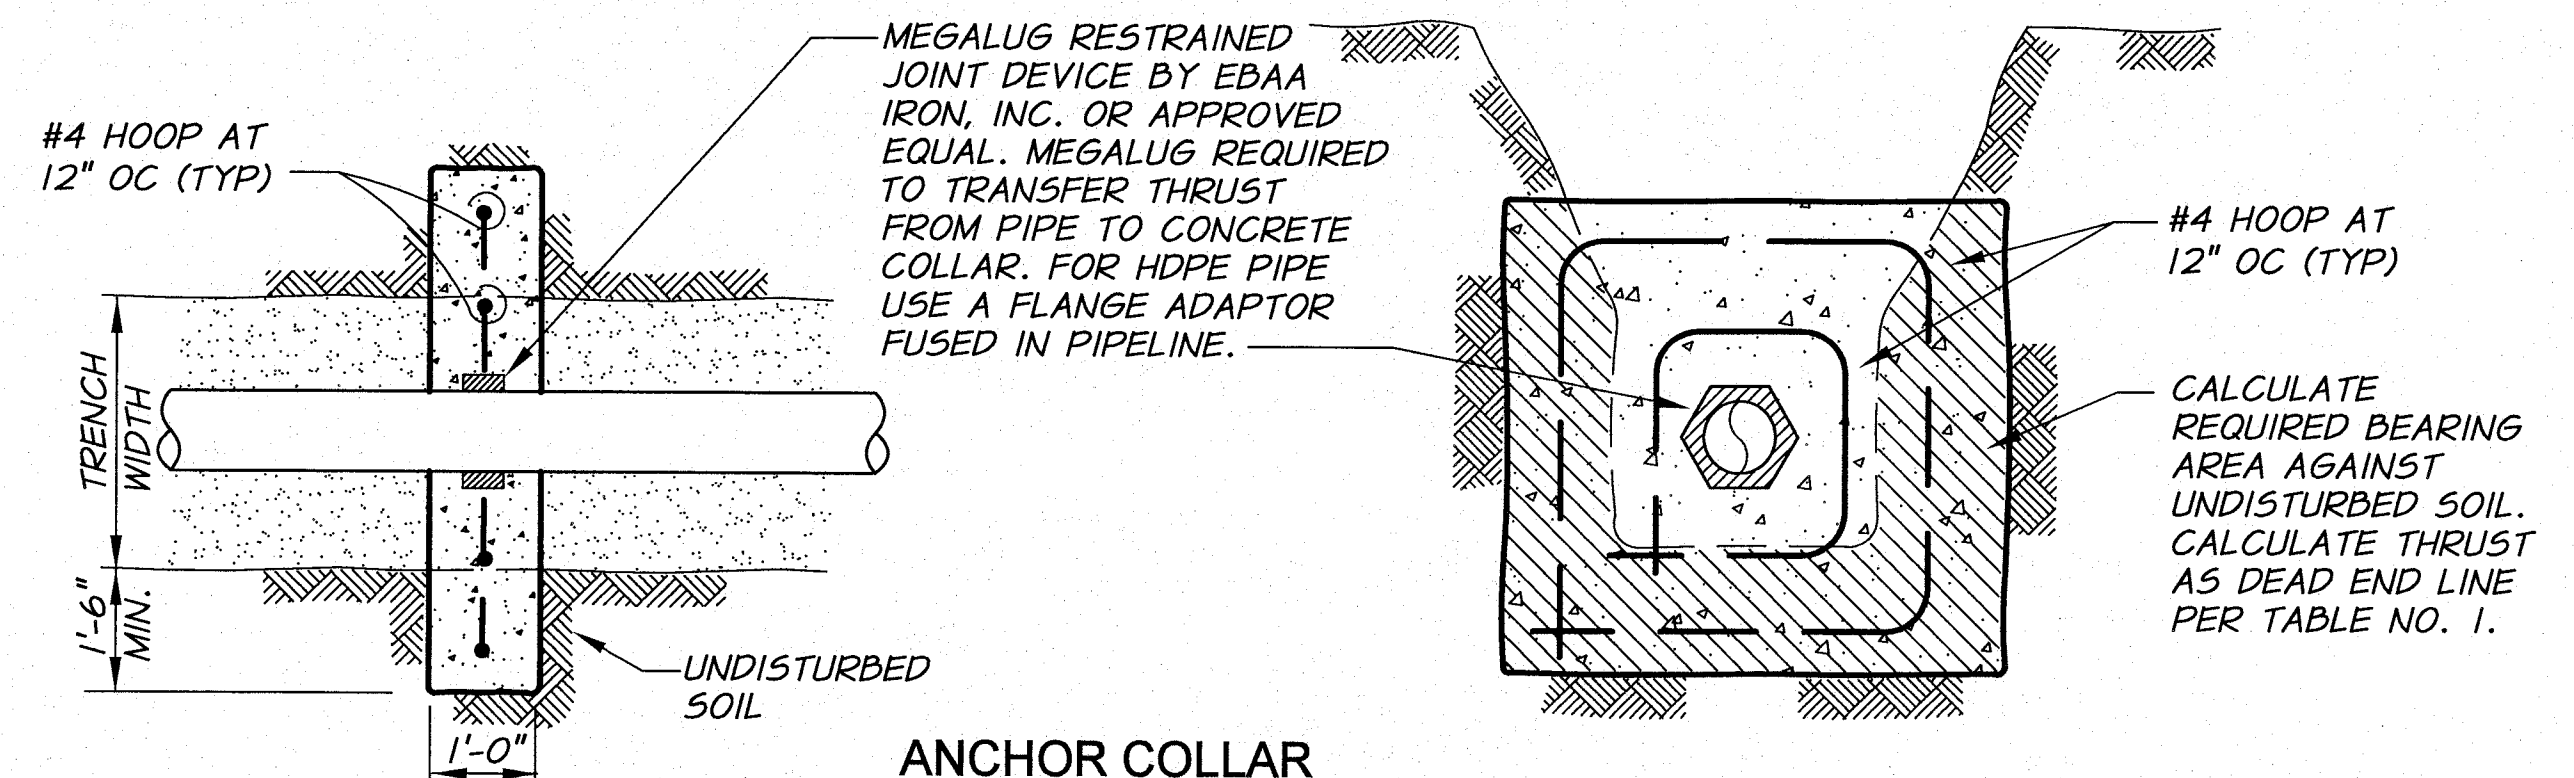

ANCHOR COLLAR


TYPICAL ANCHOR BLOCKS

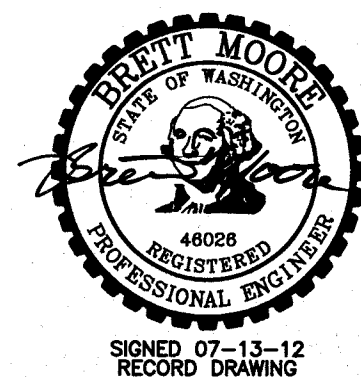

DESIGNED BY R. HARRIS	DATE	HORIZ. SCALE NONE	VERT. SCALE
DRAWN BY D. CHRISTMAN	DATE 2011	JOB NUMBER 1199-336	ACAD FILE Thrust-PH3 A.dwg
REVIEWED BY B. MOORE	COPYRIGHT 2011 BY ANDERSON-PERRY & ASSOC., INC.		

RECORD DRAWINGS

These record drawings have been prepared, in part, on the basis of information compiled and furnished by others. They may contain some discrepancies and omissions, and do not necessarily represent "exact" field conditions. The Owner and the Engineer accept no responsibility for their accuracy.

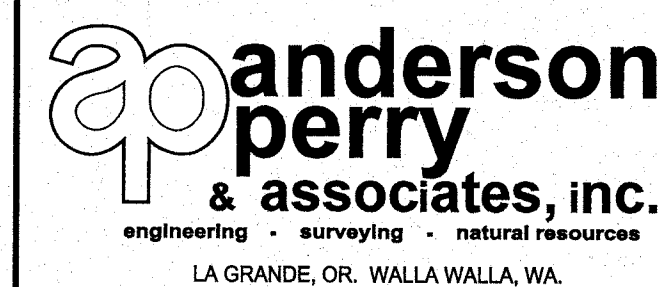

BENTON IRRIGATION DISTRICT
IRRIGATION SYSTEM IMPROVEMENTS
PHASE 3A

THRUST BLOCK DETAILS

SHEET

30