


SURFACE RESTORATION SCHEDULE		
LINE	LOCATION (STA.)	DESCRIPTION
E	1+00 TO 7+00	GRAVEL
	SERVICE AT 6+57	ASPHALT AND GRAVEL
F	1+00 TO 11+00	GRAVEL
	SERVICE AT 7+15	ASPHALT AND GRAVEL

GRADE CONTROL SCHEDULE			
LINE	FROM STA.	TO STA.	CONTINUOUS SLOPE DIRECTION
E	1+00	7+00	DOWNWARD
	4+00	11+00	DOWNWARD
F	1+00	4+00	UPWARD

- NOTES:**
- MINIMUM COVER FROM FINISH GRADE TO TOP OF PIPE SHALL BE 2.5 FEET.
 - MINIMUM SLOPE OF INSTALLED PIPING SHALL BE 0.003 FT/FT.
 - LOT LINES AND RIGHT-OF-WAYS SHOWN ARE APPROXIMATE ONLY.


WORK ITEMS

- (A) EXISTING IRRIGATION LINE ALONG OR CROSSING ALIGNMENT. EXACT LOCATION UNKNOWN. REMOVE AND PLUG AS REQUIRED FOR NEW LINE INSTALLATION.
- (C) EXISTING IRRIGATION LINE ALONG ALIGNMENT TO BE ABANDONED. REMOVE AND PLUG AS REQUIRED FOR NEW LINE INSTALLATION.

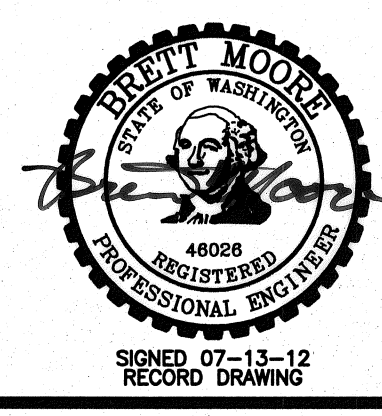

REVISION	BY	DATE	HORIZ. SCALE	VERT. SCALE
RECORD DRAWING	B.M.	7/12	1" = 50'	
LINE 'E' LOCATION ADJUSTMENT	B.M.	9/11		
DESIGNED BY	R. HARRIS		JOB NUMBER	1199-336
DRAWN BY	D. CHRISTMAN		DATE	2011
REVIEWED BY	B. MOORE		ACAD FILE:	PNP-KendallSouth.dwg
COPYRIGHT 2011 BY ANDERSON-PERRY & ASSOC., INC.				

RECORD DRAWINGS
 These record drawings have been prepared, in part, on the basis of information compiled and furnished by others. They may contain some discrepancies and omissions, and do not necessarily represent "exact" field conditions. The Owner and the Engineer accept no responsibility for their accuracy.

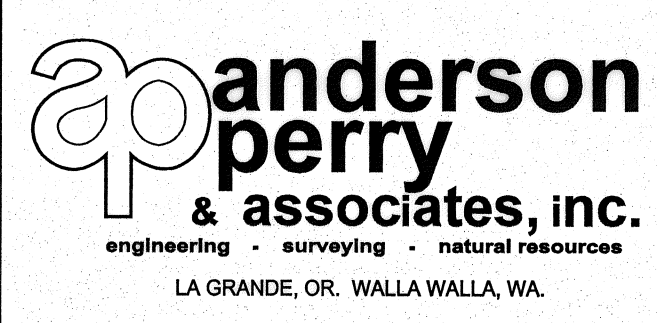

BENTON IRRIGATION DISTRICT
 IRRIGATION SYSTEM IMPROVEMENTS
 PHASE 3A
 KENDALL RD. SOUTH PIPING
 LINE E STA. 1+00 TO 7+00 AND LINE F STA. 1+00 TO 11+00