


SURFACE RESTORATION SCHEDULE		
LINE	LOCATION (STA.)	DESCRIPTION
F	11+00 TO 20+20	GRAVEL
F	SERVICE AT 20+20	ASPHALT AND GRAVEL

GRADE CONTROL SCHEDULE			
LINE	FROM STA.	TO STA.	CONTINUOUS SLOPE DIRECTION
F	11+00	15+35	DOWNWARD
F	15+35	20+56	UPWARD


- NOTES:**
1. MINIMUM COVER FROM FINISH GRADE TO TOP OF PIPE SHALL BE 2.5 FEET.
  2. MINIMUM SLOPE OF INSTALLED PIPING SHALL BE 0.003 FT/FT.
  3. LOT LINES AND RIGHT-OF-WAYS SHOWN ARE APPROXIMATE ONLY.

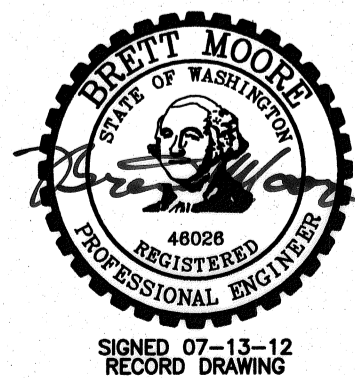

RECORD DRAWING		B.M.	7/12	SCALE IN FEET 0 50 100 150	
DESIGNED BY	R. HARRIS	BY		HORIZ. SCALE	1"=50'
DRAWN BY	D. CHRISTMAN	DATE		VERT. SCALE	
REVIEWED BY	B. MOORE	JOB NUMBER	1199-336	DATE	2011
		ACAD FILE	PNP-KendallSouth.dwg		
COPYRIGHT 2011 BY ANDERSON-PERRY & ASSOC., INC.					

**RECORD DRAWINGS**

These record drawings have been prepared, in part, on the basis of information compiled and furnished by others. They may contain some discrepancies and omissions, and do not necessarily represent "exact" field conditions. The Owner and the Engineer accept no responsibility for their accuracy.

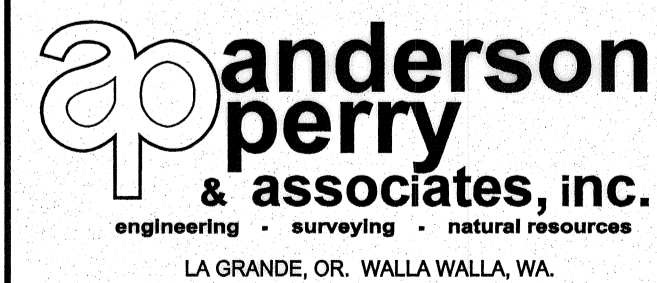

**BENTON IRRIGATION DISTRICT  
IRRIGATION SYSTEM IMPROVEMENTS  
PHASE 3A**

**KENDALL RD. SOUTH PIPING  
LINE F STA. 11+00 TO STA. 20+56**

SHEET

**10**

ARCHIVED