


WORK ITEMS

- (A) EXISTING IRRIGATION LINE ALONG OR CROSSING ALIGNMENT. EXACT LOCATION UNKNOWN. REMOVE AND PLUG AS REQUIRED FOR NEW LINE INSTALLATION.
- (B) EXISTING IRRIGATION CONTROL STRUCTURE TO BE REMOVED.
- (C) EXISTING IRRIGATION LINE ALONG ALIGNMENT TO BE ABANDONED. REMOVE AND PLUG AS REQUIRED FOR NEW LINE INSTALLATION.

SURFACE RESTORATION SCHEDULE		
LINE	LOCATION (STA.)	DESCRIPTION
G	1+00 TO 9+05	HYDROSEED AND GRAVEL
	9+05 TO 9+25	ASPHALT AND GRAVEL
	9+25 TO 12+00	HYDROSEED AND GRAVEL
H	1+00 TO 1+40	ASPHALT AND GRAVEL
	1+40 TO 3+68	GRAVEL

GRADE CONTROL SCHEDULE			
LINE	FROM STA.	TO STA.	CONTINUOUS SLOPE DIRECTION
G	1+00	6+07	UPWARD
	6+07	12+00	DOWNWARD
H	1+00	3+68	UPWARD


- NOTES:**
- MINIMUM COVER FROM FINISH GRADE TO TOP OF PIPE SHALL BE 2.5 FEET.
 - MINIMUM SLOPE OF INSTALLED PIPING SHALL BE 0.003 FT/FT.
 - LOT LINES AND RIGHT-OF-WAYS SHOWN ARE APPROXIMATE ONLY.

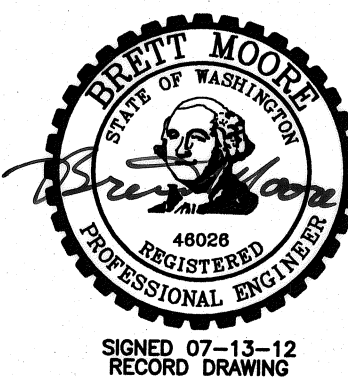

RECORD DRAWING		B.M.	7/12
DESIGNED BY	R. HARRIS	DATE	
DRAWN BY	D. CHRISTMAN	HORIZ. SCALE	1" = 50'
REVIEWED BY	B. MOORE	VERT. SCALE	
		JOB NUMBER	1199-336
		DATE	2011
		ACAD FILE:	PNP-OIEHighway.dwg
COPYRIGHT 2011 BY ANDERSON-PERRY & ASSOC., INC.			

RECORD DRAWINGS

These record drawings have been prepared, in part, on the basis of information compiled and furnished by others. They may contain some discrepancies and omissions, and do not necessarily represent "exact" field conditions. The Owner and the Engineer accept no responsibility for their accuracy.

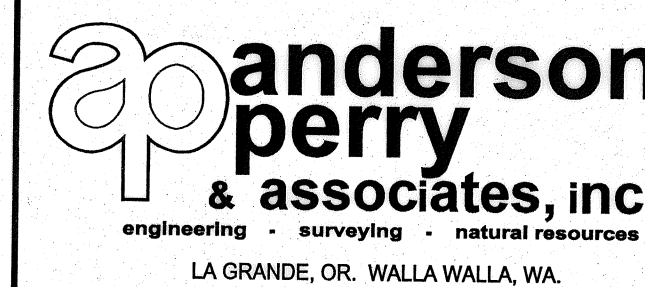

**BENTON IRRIGATION DISTRICT
IRRIGATION SYSTEM IMPROVEMENTS
PHASE 3A**

O.I.E. HIGHWAY PIPING
LINE G STA. 1+00 TO STA. 12+00 AND LINE H

SHEET

11