


SURFACE RESTORATION SCHEDULE		
LINE	LOCATION (STA.)	DESCRIPTION
▽	1+00 TO 5+50	HYDROSEED
	5+50 TO 6+00	ASPHALT AND GRAVEL
	6+00 TO 7+61	HYDROSEED


GRADE CONTROL SCHEDULE			
LINE	FROM STA.	TO STA.	CONTINUOUS SLOPE DIRECTION
▽	1+00	2+75	DOWNWARD
	2+75	5+50	UPWARD
	5+50	7+61	DOWNWARD

- NOTES:**
- MINIMUM COVER FROM FINISH GRADE TO TOP OF PIPE SHALL BE 2.5 FEET.
 - MINIMUM SLOPE OF INSTALLED PIPING SHALL BE 0.003 FT/FT.
 - LOT LINES AND RIGHT-OF-WAYS SHOWN ARE APPROXIMATE ONLY.

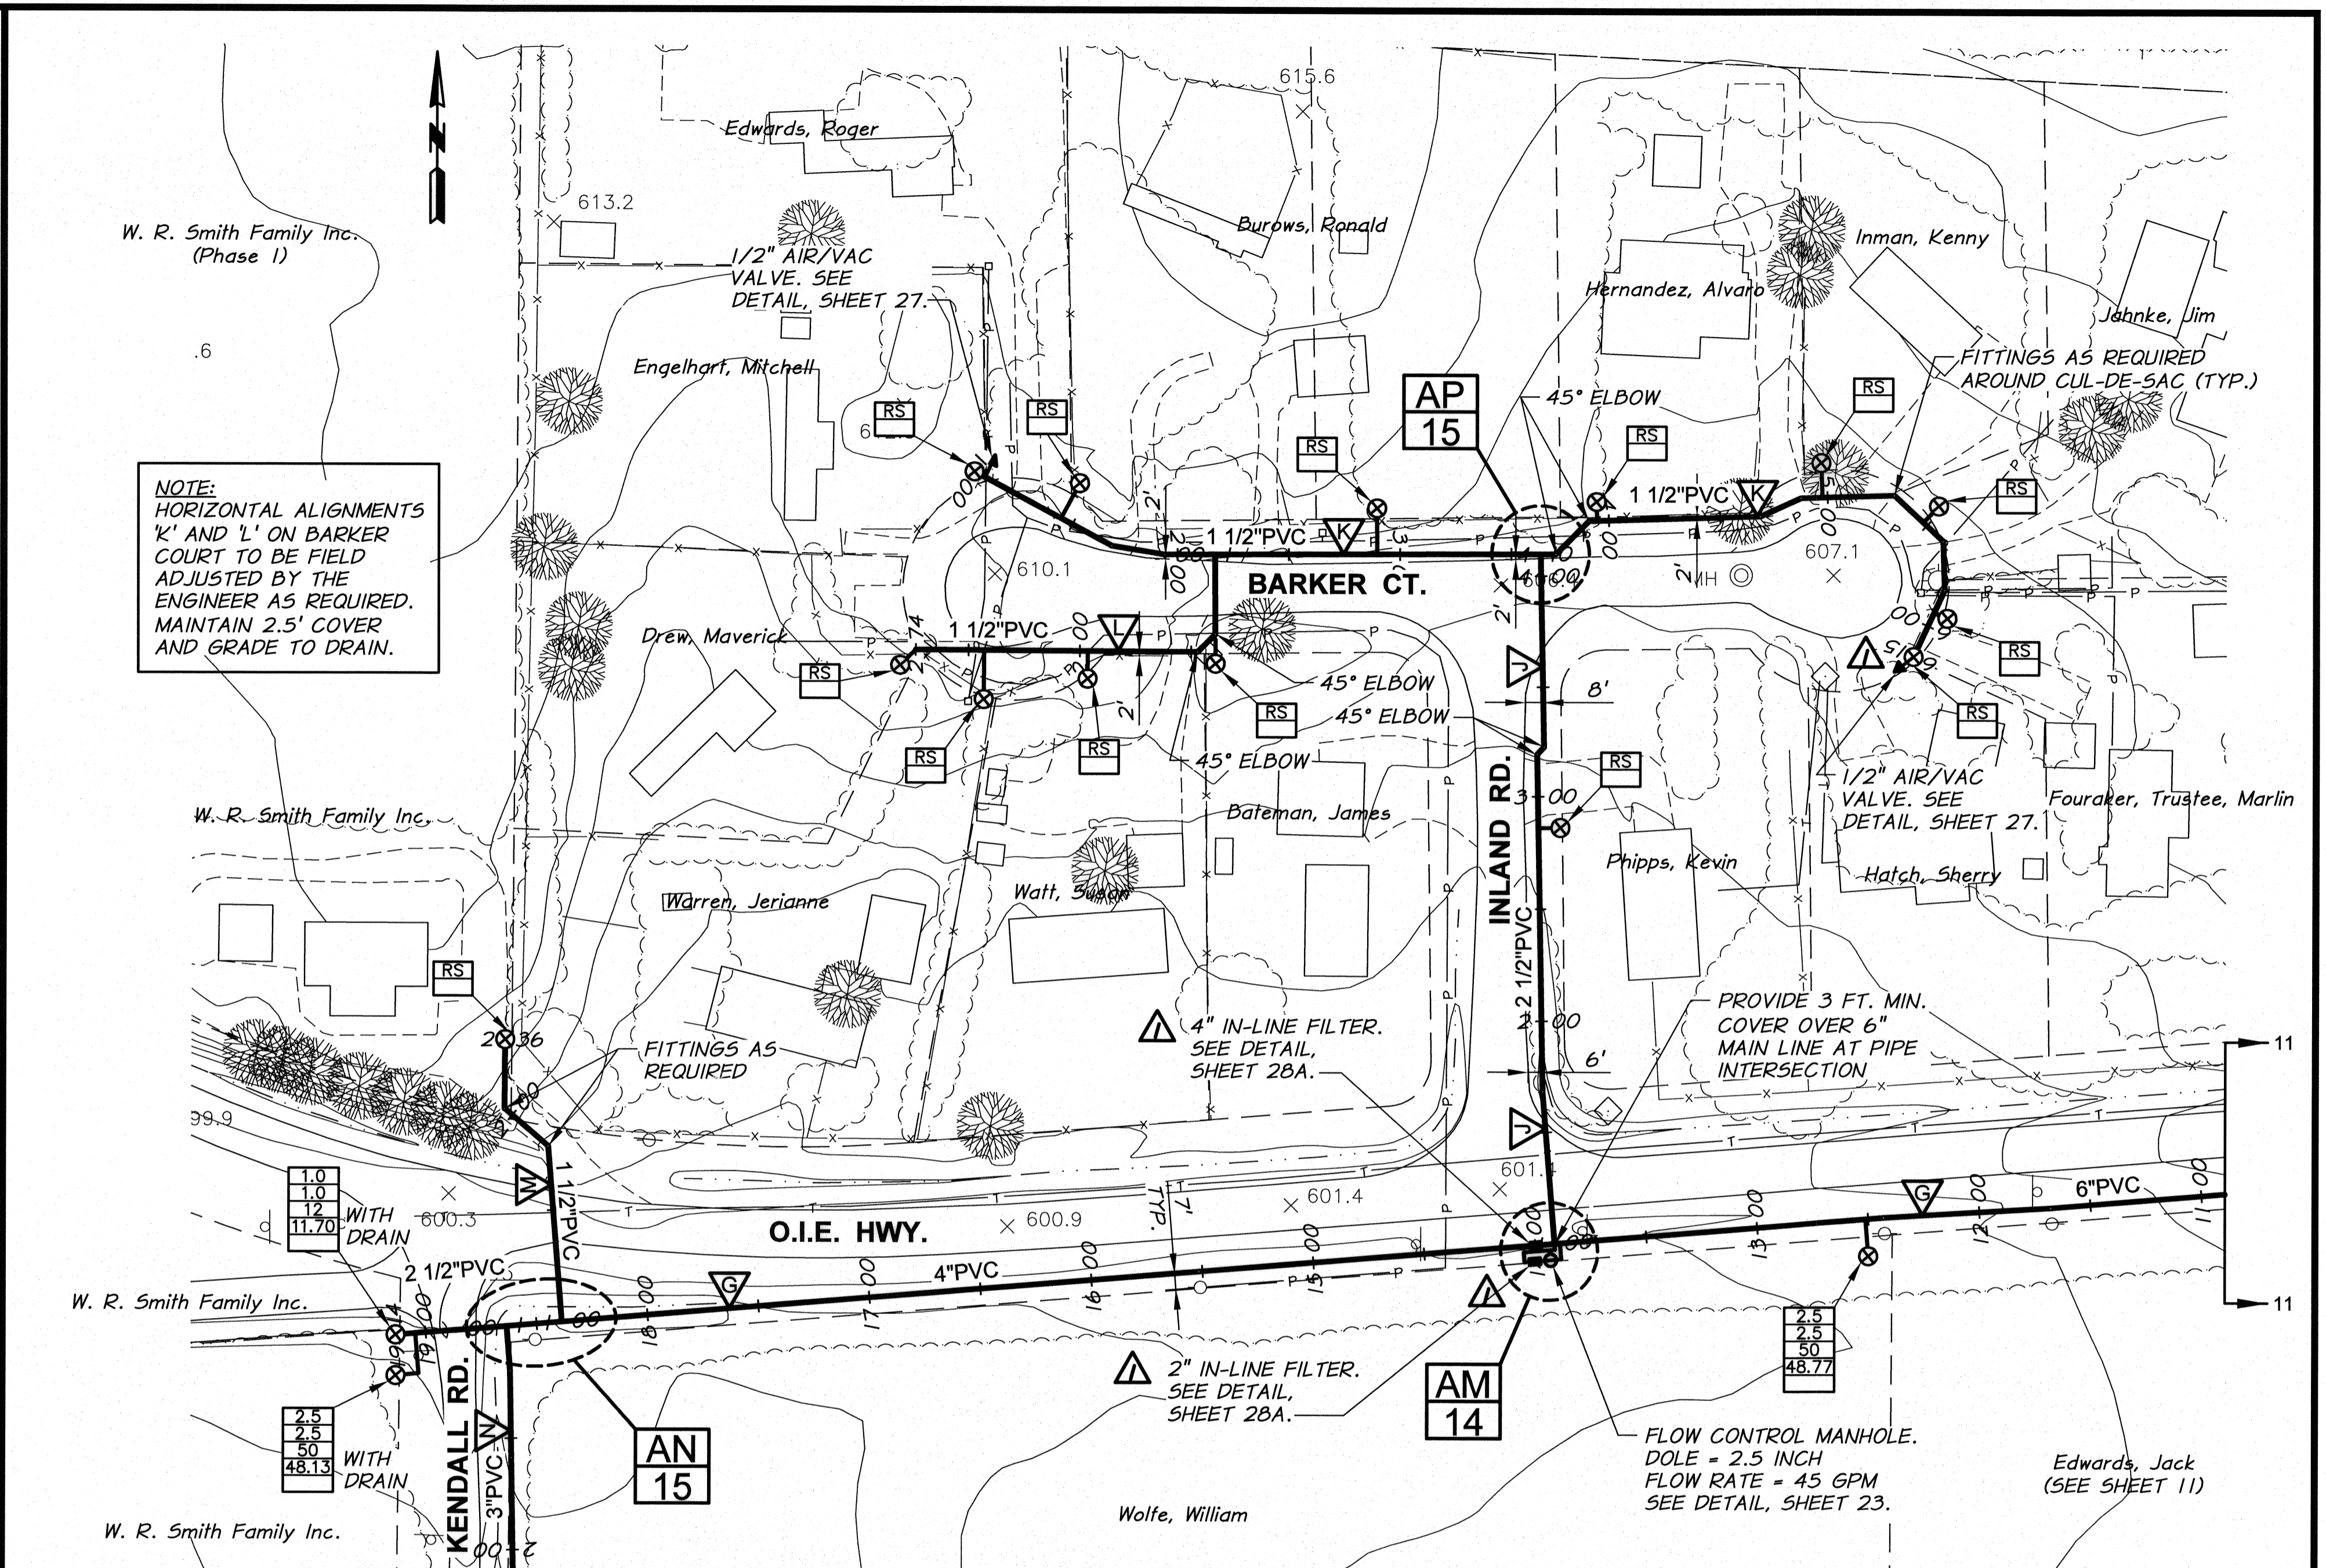


SURFACE RESTORATION SCHEDULE		
LINE	LOCATION (STA.)	DESCRIPTION
▽	12+00 TO 18+70	HYDROSEED AND GRAVEL
	18+70 TO 19+00	ASPHALT AND GRAVEL
	19+00 TO 19+13	HYDROSEED AND GRAVEL
▽	1+00 TO 1+60	ASPHALT AND GRAVEL
	1+60 TO 3+60	GRAVEL
▽	3+60 TO 4+10	ASPHALT AND GRAVEL
	1+00 TO 6+15	HYDROSEED AND GRAVEL
▽	1+00 TO 1+30	ASPHALT AND GRAVEL
	1+30 TO 2+78	HYDROSEED AND GRAVEL
▽	1+00 TO 1+30	HYDROSEED AND GRAVEL
	1+30 TO 1+60	ASPHALT AND GRAVEL
	1+60 TO 1+95	GRAVEL
	1+95 TO 2+33	HYDROSEED


GRADE CONTROL SCHEDULE			
LINE	FROM STA.	TO STA.	CONTINUOUS SLOPE DIRECTION
▽	12+00	19+13	DOWNWARD
▽	1+00	4+10	UPWARD
▽	1+00	3+63	DOWNWARD
	3+63	6+15	UPWARD
▽	1+00	2+78	UPWARD
▽	1+00	2+33	UPWARD

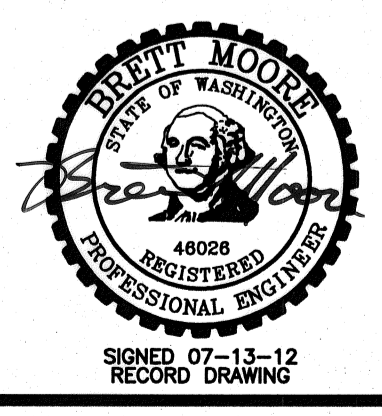

RECORD DRAWING		BY	B.M.	DATE	7/12
DESIGNED BY	R. HARRIS	JOB NUMBER	1199-336		
DRAWN BY	D. CHRISTMAN	DATE	2011		
REVIEWED BY	B. MOORE	ACAD FILE	PNP-OIEHighway.dwg		
COPYRIGHT 2011 BY ANDERSON-PERRY & ASSOC., INC.					

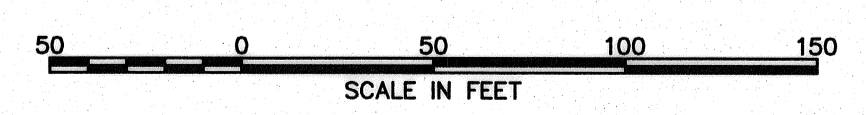

RECORD DRAWINGS
 These record drawings have been prepared, in part, on the basis of information compiled and furnished by others. They may contain some discrepancies and omissions, and do not necessarily represent "exact" field conditions. The Owner and the Engineer accept no responsibility for their accuracy.

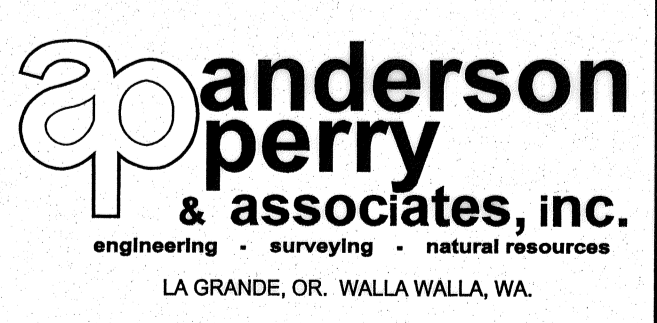

BENTON IRRIGATION DISTRICT
 IRRIGATION SYSTEM IMPROVEMENTS
 PHASE 3A
 O.I.E. HIGHWAY PIPING
 LINE G STA. 12+00 TO 19+13 AND LINES J, K, L, M, AND R

SHEET
12