

**WORK ITEMS**


Ⓒ EXISTING IRRIGATION LINE ALONG ALIGNMENT TO BE ABANDONED. REMOVE AND PLUG AS REQUIRED FOR NEW LINE INSTALLATION.

SURFACE RESTORATION SCHEDULE		
LINE	LOCATION (STA.)	DESCRIPTION
DUSTY LANE	1+00 TO 2+90	GRAVEL
	2+90 TO 5+15	ASPHALT
	5+15 TO 12+85	HYDROSEED AND GRAVEL
	12+85 TO 13+10	ASPHALT
	13+10 TO 14+91	HYDROSEED AND GRAVEL
	SERVICE AT 2+80	ASPHALT, GRAVEL, HYDROSEED
	SERVICE AT 5+15	ASPHALT, GRAVEL, HYDROSEED
	SERVICE AT 7+05	ASPHALT, GRAVEL, HYDROSEED
	SERVICE AT 8+95	ASPHALT, GRAVEL, HYDROSEED
	SERVICE AT 10+75	ASPHALT, GRAVEL, HYDROSEED
	SERVICE AT 14+85	ASPHALT, GRAVEL, HYDROSEED


SURFACE RESTORATION SCHEDULE		
LINE	LOCATION (STA.)	DESCRIPTION
WINDY LANE	1+00 TO 7+80	HYDROSEED AND GRAVEL
	7+80 TO 10+85	GRAVEL
	10+85 TO 11+10	ASPHALT
	11+10 TO 11+85	HYDROSEED AND GRAVEL
	11+85 TO 13+29	GRAVEL
	SERVICE AT 4+30	ASPHALT, GRAVEL, HYDROSEED
	SERVICE AT 5+02	ASPHALT, GRAVEL, HYDROSEED
	SERVICE AT 7+08	ASPHALT, GRAVEL, HYDROSEED
	SERVICE AT 8+85	ASPHALT, GRAVEL, HYDROSEED
	SERVICE AT 12+70	ASPHALT, GRAVEL, HYDROSEED

GRADE CONTROL SCHEDULE			
LINE	FROM STA.	TO STA.	CONTINUOUS SLOPE DIRECTION
DUSTY LANE	1+00	11+50	UPWARD
DUSTY LANE	11+50	14+91	DOWNWARD
WINDY LANE	1+00	13+29	UPWARD

- NOTES:**
- MINIMUM COVER FROM FINISH GRADE TO TOP OF PIPE SHALL BE 2.5 FEET.
  - MINIMUM SLOPE OF INSTALLED PIPING SHALL BE 0.003 FT/FT.
  - LOT LINES AND RIGHT-OF-WAYS SHOWN ARE APPROXIMATE ONLY.
  - IT IS ANTICIPATED THE TELEPHONE, POWER, CABLE T.V., WATER, AND SEWER THAT EXIST WITHIN THE STREET AND UTILITY CORRIDOR AND INDIVIDUALLY PROVIDE SERVICE TO EACH LOT WILL BE ENCOUNTERED DURING CONSTRUCTION. CONTRACTOR SHALL PLAN FOR CROSSING AND/OR EXCAVATING ALONG THESE UTILITIES AT EACH LOT AND/OR WITHIN THE STREET AND UTILITY CORRIDOR WITHOUT ADDITIONAL COMPENSATION.
  - SERVICES LOCATED DOWNHILL OF MAIN LINE ARE TO DRAIN BACK TO MAIN LINE, UNLESS DESIGNATED "WITH DRAIN".

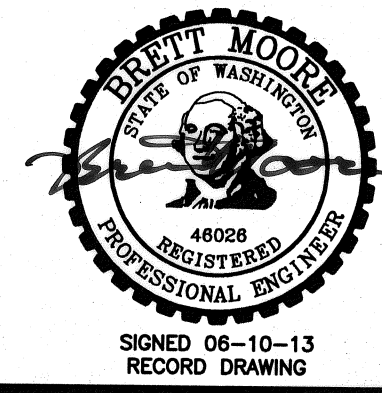


REVISION		BY	DATE
RECORD DRAWING		B.M.	4/13
DESIGNED BY	M. OWENS		
DRAWN BY	D. CHRISTMAN		
REVIEWED BY	B. MOORE		

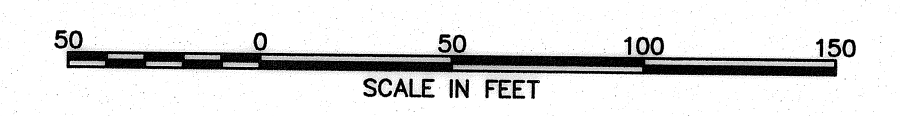

HORIZ. SCALE	1" = 50'	VERT. SCALE	
JOB NUMBER	1199-336	DATE	2012
ACAD FILE	PNP-ThunderRd.dwg		
COPYRIGHT 2012 BY ANDERSON-PERRY & ASSOC., INC.			

**RECORD DRAWINGS**  
 JUNE 10, 2013  
 These record drawings have been prepared, in part, on the basis of information compiled and furnished by others. They may contain some discrepancies and omissions, and do not necessarily represent "exact" field conditions. The Owner and the Engineer accept no responsibility for their accuracy.

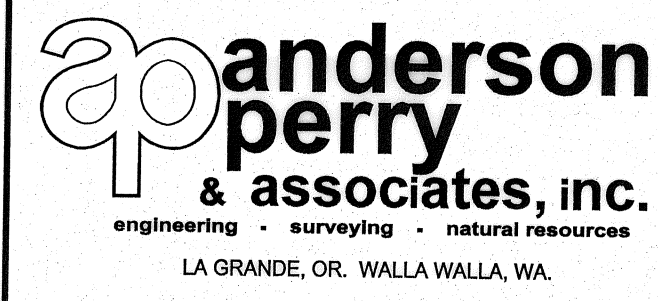

**BENTON IRRIGATION DISTRICT**  
 IRRIGATION SYSTEM IMPROVEMENTS  
 PHASE 3B  
 THUNDER ROAD PIPING  
 DUSTY LANE - WINDY LANE

SHEET  
**4**