

| SURFACE RESTORATION SCHEDULE | | |
|--------------------------------|----------------------------|----------------------------|
| LINE | LOCATION (STA.) | DESCRIPTION |
| LIGHTNING LANE AND SANDY COURT | 1+00 TO 1+50 | ASPHALT |
| | 1+50 TO 2+75 | GRAVEL |
| | 2+75 TO 4+75 | LANDSCAPE |
| | 4+75 TO 6+78 | GRAVEL |
| | SERVICE AT 3+85 | ASPHALT, GRAVEL, HYDROSEED |
| | SERVICE AT 4+62 | ASPHALT, GRAVEL, HYDROSEED |
| SERVICE AT 6+03 | ASPHALT, GRAVEL, HYDROSEED | |



| GRADE CONTROL SCHEDULE | | | |
|--------------------------------|-----------|---------|----------------------------|
| LINE | FROM STA. | TO STA. | CONTINUOUS SLOPE DIRECTION |
| LIGHTNING LANE AND SANDY COURT | 1+00 | 4+62 | DOWNWARD |
| | 4+62 | 6+78 | UPWARD |

NOTES:

- MINIMUM COVER FROM FINISH GRADE TO TOP OF PIPE SHALL BE 2.5 FEET.
- MINIMUM SLOPE OF INSTALLED PIPING SHALL BE 0.003 FT/FT.
- LOT LINES AND RIGHT-OF-WAYS SHOWN ARE APPROXIMATE ONLY.
- IT IS ANTICIPATED THE TELEPHONE, POWER, CABLE T.V., WATER, AND SEWER THAT EXIST WITHIN THE STREET AND UTILITY CORRIDOR AND INDIVIDUALLY PROVIDE SERVICE TO EACH LOT WILL BE ENCOUNTERED DURING CONSTRUCTION. CONTRACTOR SHALL PLAN FOR CROSSING AND/OR EXCAVATING ALONG THESE UTILITIES AT EACH LOT AND/OR WITHIN THE STREET AND UTILITY CORRIDOR WITHOUT ADDITIONAL COMPENSATION.
- SERVICES LOCATED DOWNHILL OF MAIN LINE ARE TO DRAIN BACK TO MAIN LINE, UNLESS DESIGNATED "WITH DRAIN".

WORK ITEMS

- (B) EXISTING IRRIGATION CONTROL STRUCTURE TO BE REMOVED.
- (C) EXISTING IRRIGATION LINE ALONG ALIGNMENT TO BE ABANDONED. REMOVE AND PLUG AS REQUIRED FOR NEW LINE INSTALLATION.

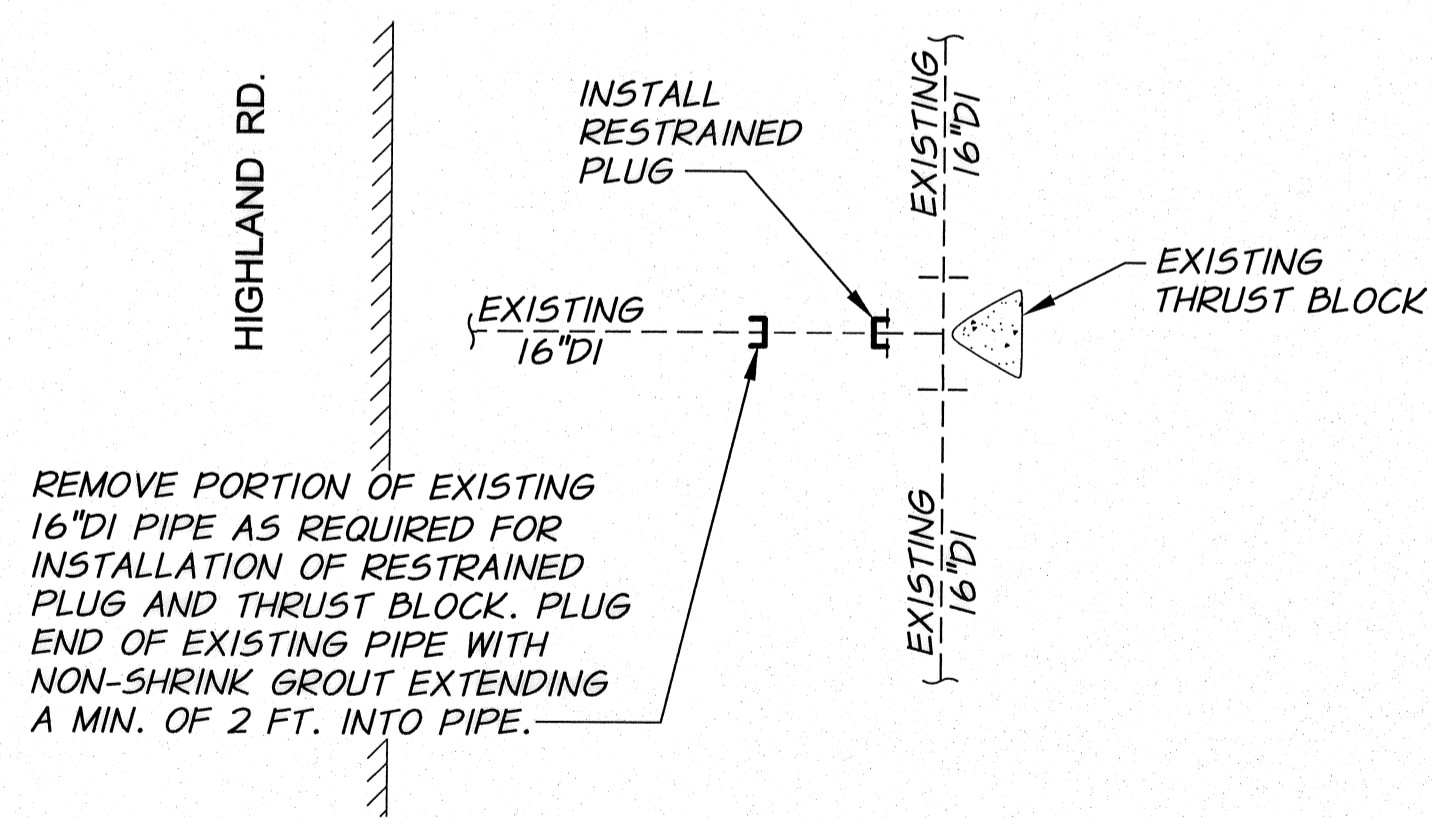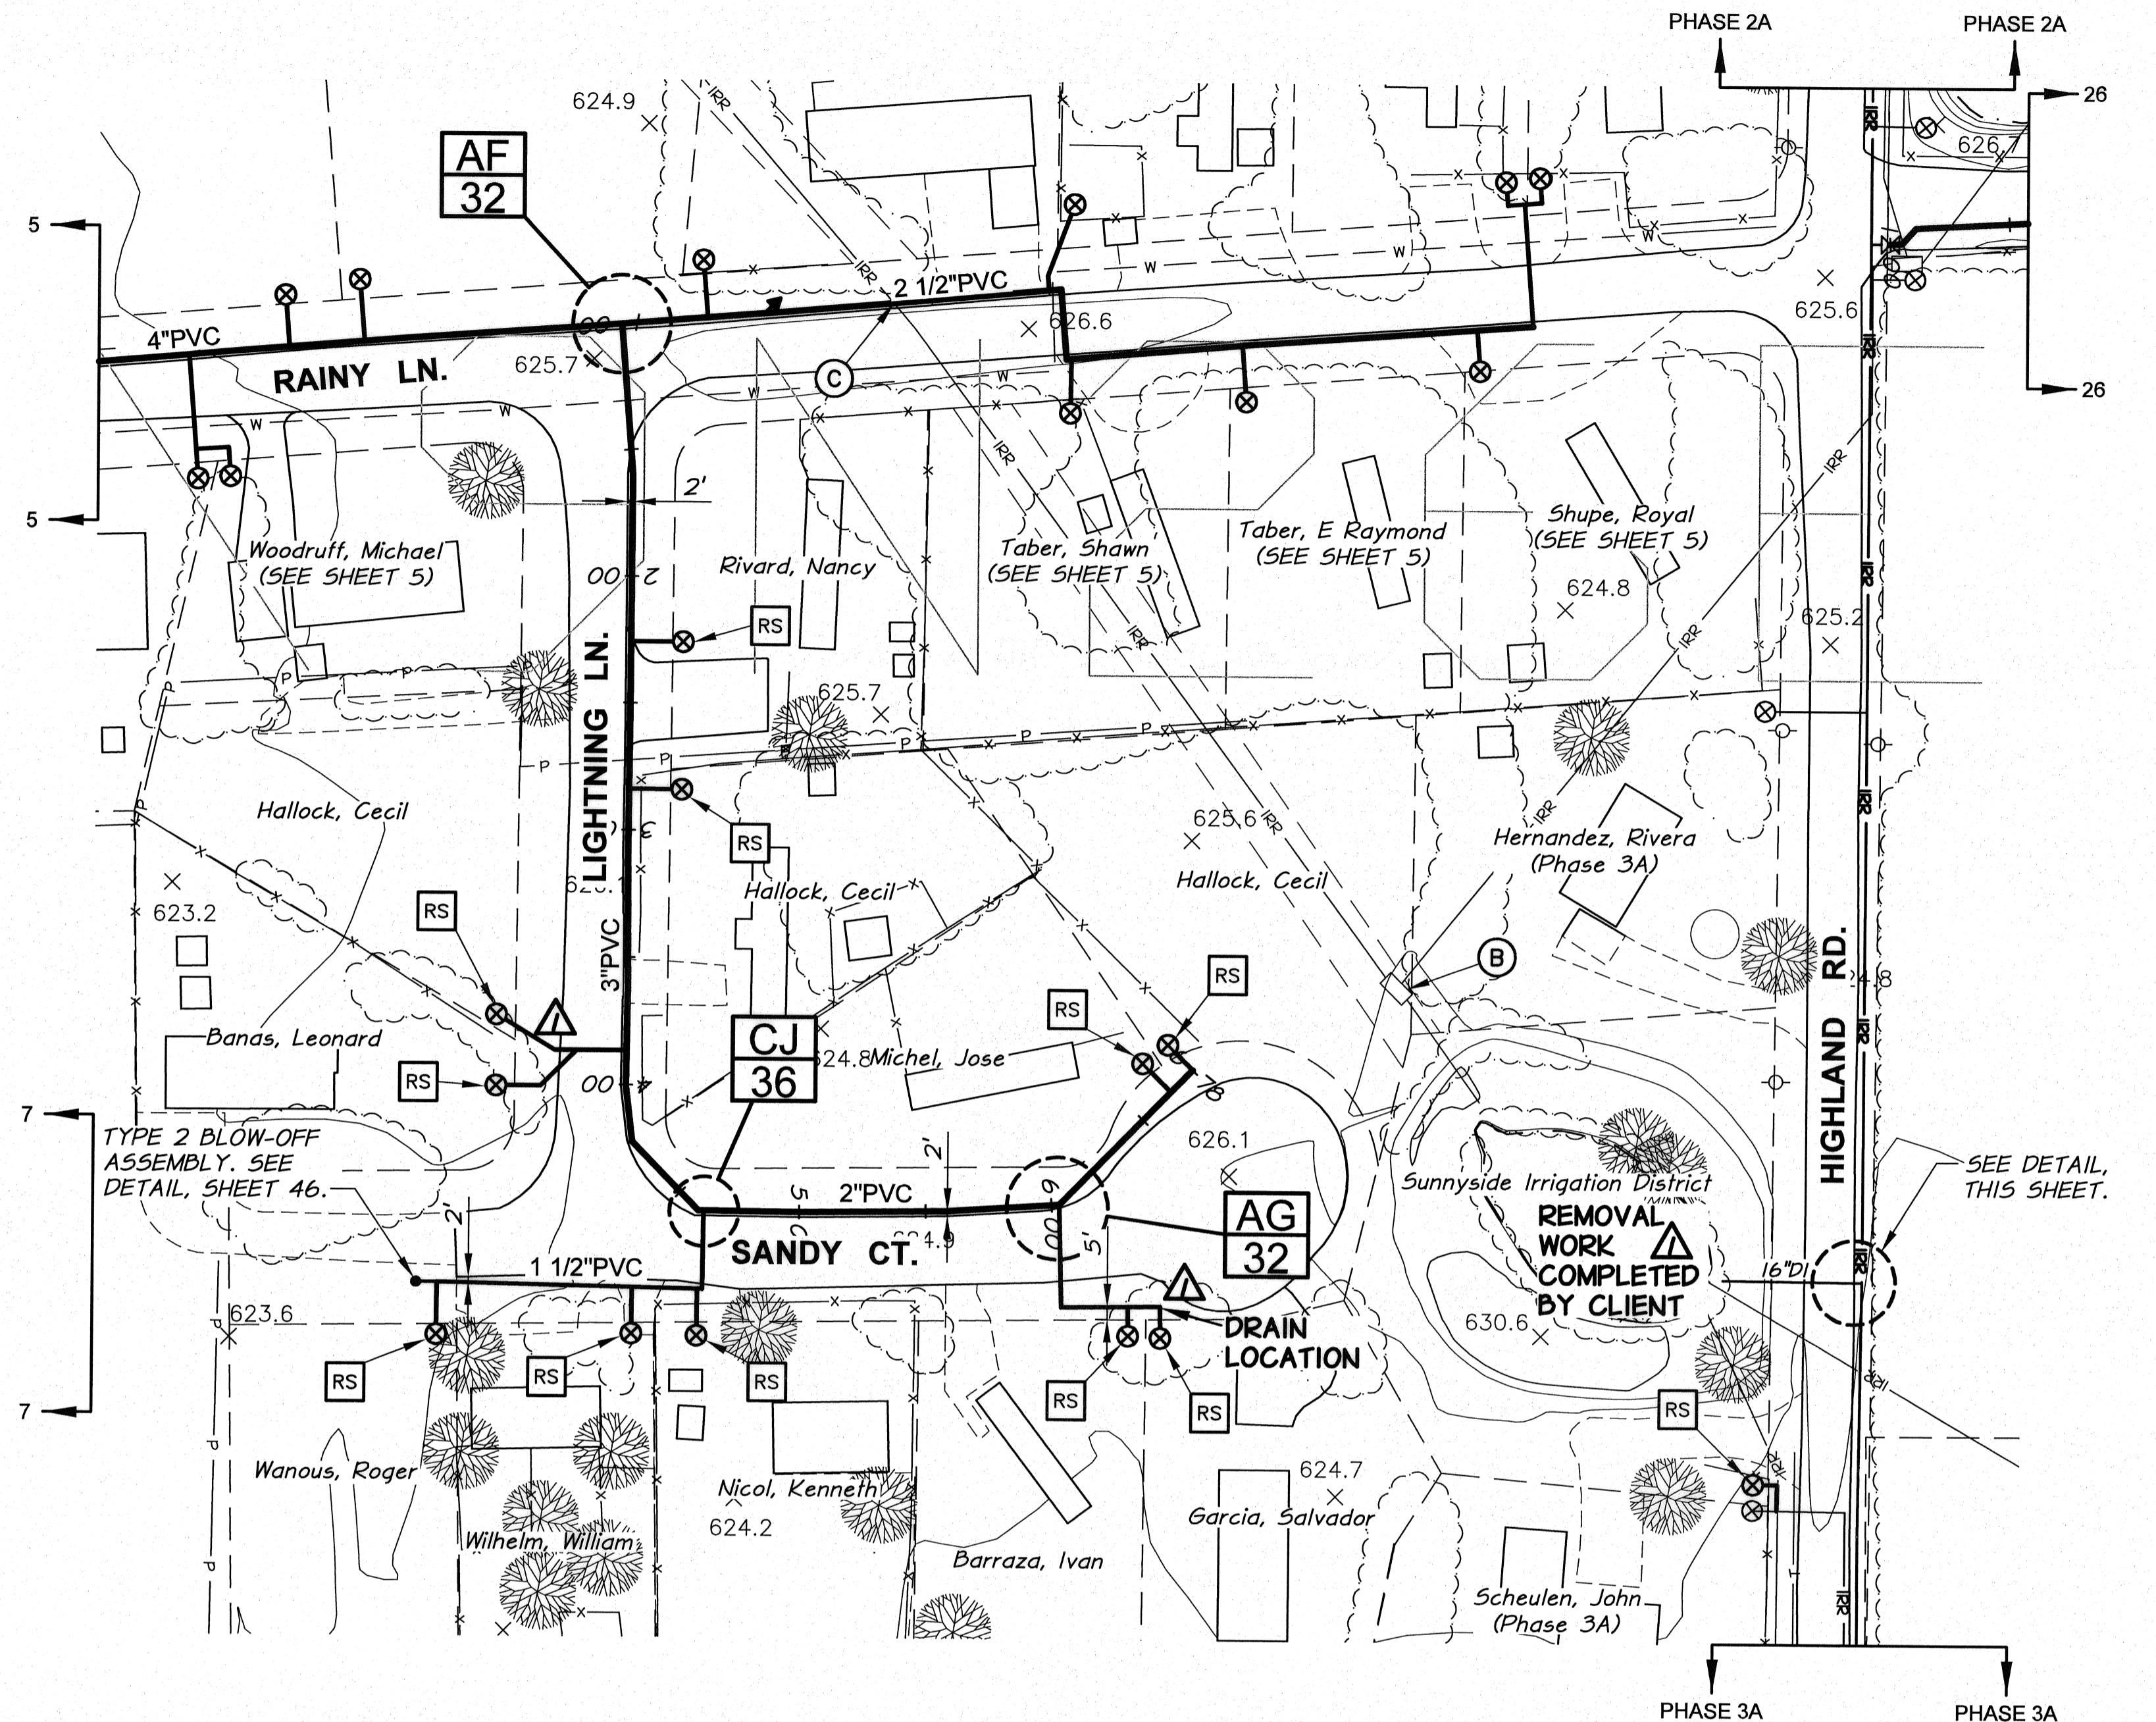


DETAIL
N.T.S.



| | | | | | |
|---|--------------|--------------|-------------------|-------------|------|
| RECORD DRAWING | | BY | B.M. | DATE | 4/13 |
| DESIGNED BY | M. OWENS | HORIZ. SCALE | 1" = 50' | VERT. SCALE | |
| DRAWN BY | D. CHRISTMAN | JOB NUMBER | 1199-336 | DATE | 2012 |
| REVIEWED BY | B. MOORE | ACAD FILE: | PNP-ThunderRd.dwg | | |
| COPYRIGHT 2012 BY ANDERSON-PERRY & ASSOC., INC. | | | | | |

RECORD DRAWINGS
JUNE 10, 2013

These record drawings have been prepared, in part, on the basis of information compiled and furnished by others. They may contain some discrepancies and omissions, and do not necessarily represent "exact" field conditions. The Owner and the Engineer accept no responsibility for their accuracy.

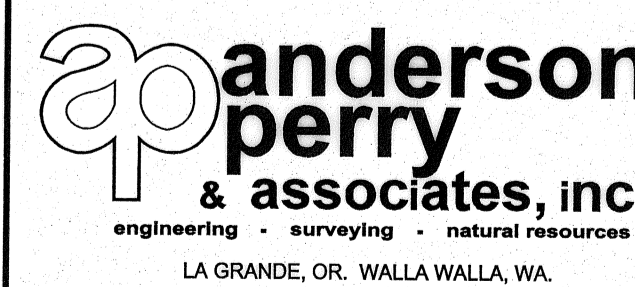

BENTON IRRIGATION DISTRICT
IRRIGATION SYSTEM IMPROVEMENTS
PHASE 3B

THUNDER ROAD PIPING
LIGHTNING LANE - SANDY CT.

SHEET

6