

**WORK ITEMS**


- (C) EXISTING IRRIGATION LINE ALONG ALIGNMENT TO BE ABANDONED. REMOVE AND PLUG AS REQUIRED FOR NEW LINE INSTALLATION.
- (F) REPLACE 10 FT. SECTION OF SIDEWALK MATCHING EXISTING SIDEWALK WIDTH WITH 4" THICK 3000 PSI CONCRETE WITH #3 AT 24" O.C., EACH WAY. PAID FOR UNDER PAY ITEM "SIDEWALK CROSSING".

SURFACE RESTORATION SCHEDULE		
LINE	LOCATION (STA.)	DESCRIPTION
13TH STREET	0+86 TO 2+19	LANDSCAPE
	2+19 TO 2+50	ASPHALT
	2+50 TO 3+00	LANDSCAPE
	3+00 TO 7+34	ASPHALT
	7+34 TO 14+80	HYDROSEED
	SERVICE AT 7+25	ASPHALT, GRAVEL, HYDROSEED
	SERVICE AT 9+58	LANDSCAPE

GRADE CONTROL SCHEDULE			
LINE	FROM STA.	TO STA.	CONTINUOUS SLOPE DIRECTION
13TH STREET	0+86	14+80	DOWNWARD

**NOTES:**


1. MINIMUM COVER FROM FINISH GRADE TO TOP OF PIPE SHALL BE 2.5 FEET.
2. MINIMUM SLOPE OF INSTALLED PIPING SHALL BE 0.003 FT/FT.
3. LOT LINES AND RIGHT-OF-WAYS SHOWN ARE APPROXIMATE ONLY.
4. IT IS ANTICIPATED THE TELEPHONE, POWER, CABLE T.V., WATER, AND SEWER THAT EXIST WITHIN THE STREET AND UTILITY CORRIDOR AND INDIVIDUALLY PROVIDE SERVICE TO EACH LOT WILL BE ENCOUNTERED DURING CONSTRUCTION. CONTRACTOR SHALL PLAN FOR CROSSING AND/OR EXCAVATING ALONG THESE UTILITIES AT EACH LOT AND/OR WITHIN THE STREET AND UTILITY CORRIDOR WITHOUT ADDITIONAL COMPENSATION.
5. SERVICES LOCATED DOWNHILL OF MAIN LINE ARE TO DRAIN BACK TO MAIN LINE, UNLESS DESIGNATED "WITH DRAIN".

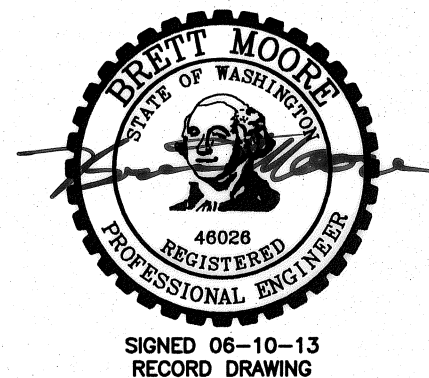

RECORD DRAWING		DATE	5/13
DESIGNED BY	M. OWENS	HORIZ. SCALE	1"=50'
DRAWN BY	D. CHRISTMAN	VERT. SCALE	
REVIEWED BY	B. MOORE	JOB NUMBER	1199-336
		ACAD FILE	PNP-OIE2Fay.dwg
		DATE	2012
		COPYRIGHT 2012 BY ANDERSON-PERRY & ASSOC., INC.	

**RECORD DRAWINGS**  
JUNE 10, 2013

These record drawings have been prepared, in part, on the basis of information compiled and furnished by others. They may contain some discrepancies and omissions, and do not necessarily represent "exact" field conditions. The Owner and the Engineer accept no responsibility for their accuracy.

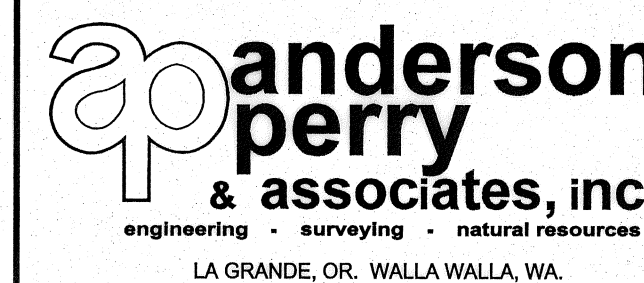

**BENTON IRRIGATION DISTRICT**  
IRRIGATION SYSTEM IMPROVEMENTS  
PHASE 3B

O.I.E. HWY. TO FAY AVENUE PIPING  
13TH ST. - 12TH ST.

SHEET

9

ARCHIVED