

WORK ITEMS


- (B) EXISTING IRRIGATION CONTROL STRUCTURE TO BE REMOVED.
- (C) EXISTING IRRIGATION LINE ALONG ALIGNMENT TO BE ABANDONED. REMOVE AND PLUG AS REQUIRED FOR NEW LINE INSTALLATION.

SURFACE RESTORATION SCHEDULE		
LINE	LOCATION (STA.)	DESCRIPTION
FAY AVENUE	1+00 TO 7+55	HYDROSEED
	7+55 TO 11+29	GRAVEL
	11+29 TO 11+51	ASPHALT
	11+51 TO 13+02	HYDROSEED AND GRAVEL
	13+02 TO 13+53	ASPHALT
	13+53 TO 15+30	HYDROSEED AND GRAVEL
BRANCH NORTH	1+00 TO 2+28	HYDROSEED
SERVICE AT 3+93 ASPHALT, GRAVEL, HYDROSEED		

GRADE CONTROL SCHEDULE			
LINE	FROM STA.	TO STA.	CONTINUOUS SLOPE DIRECTION
FAY AVENUE	1+00	13+60	DOWNWARD
	13+60	13+80	UPWARD
	13+80	15+30	DOWNWARD
BRANCH NORTH	1+00	2+28	UPWARD

NOTES:


1. MINIMUM COVER FROM FINISH GRADE TO TOP OF PIPE SHALL BE 2.5 FEET.
2. MINIMUM SLOPE OF INSTALLED PIPING SHALL BE 0.003 FT/FT.
3. LOT LINES AND RIGHT-OF-WAYS SHOWN ARE APPROXIMATE ONLY.
4. IT IS ANTICIPATED THE TELEPHONE, POWER, CABLE T.V., WATER, AND SEWER THAT EXIST WITHIN THE STREET AND UTILITY CORRIDOR AND INDIVIDUALLY PROVIDE SERVICE TO EACH LOT WILL BE ENCOUNTERED DURING CONSTRUCTION. CONTRACTOR SHALL PLAN FOR CROSSING AND/OR EXCAVATING ALONG THESE UTILITIES AT EACH LOT AND/OR WITHIN THE STREET AND UTILITY CORRIDOR WITHOUT ADDITIONAL COMPENSATION.
5. SERVICES LOCATED DOWNHILL OF MAIN LINE ARE TO DRAIN BACK TO MAIN LINE, UNLESS DESIGNATED "WITH DRAIN".

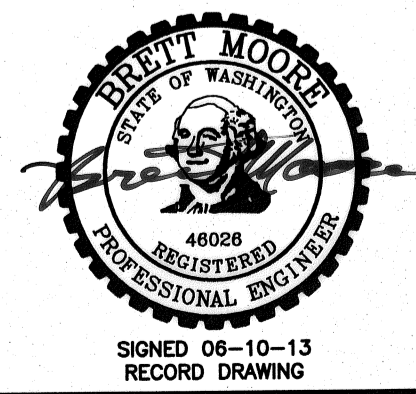

RECORD DRAWING		BY	B.M.	DATE	5/13
DESIGNED BY	M. OWENS	HORIZ. SCALE	1" = 50'		
DRAWN BY	D. CHRISTMAN	VERT. SCALE			
REVIEWED BY	B. MOORE	JOB NUMBER	1199-336		
		ACAD FILE	PNP-OIE2Fay.dwg		
		DATE	2012		
		COPYRIGHT 2012 BY ANDERSON-PERRY & ASSOC., INC.			

RECORD DRAWINGS

JUNE 10, 2013
 These record drawings have been prepared, in part, on the basis of information compiled and furnished by others. They may contain some discrepancies and omissions, and do not necessarily represent "exact" field conditions. The Owner and the Engineer accept no responsibility for their accuracy.

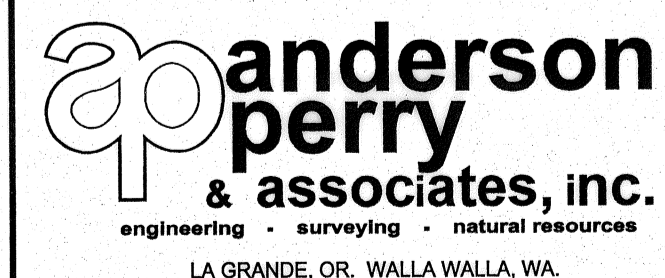

BENTON IRRIGATION DISTRICT
 IRRIGATION SYSTEM IMPROVEMENTS
 PHASE 3B

O.I.E. HWY. TO FAY AVENUE PIPING
 FAY AVENUE

SHEET

10

ARCHIVED