

WORK ITEMS


- (A) EXISTING IRRIGATION LINE ALONG OR CROSSING ALIGNMENT. EXACT LOCATION UNKNOWN. REMOVE AND PLUG AS REQUIRED FOR NEW LINE INSTALLATION.
- (C) EXISTING IRRIGATION LINE ALONG ALIGNMENT TO BE ABANDONED. REMOVE AND PLUG AS REQUIRED FOR NEW LINE INSTALLATION.

| SURFACE RESTORATION SCHEDULE | | |
|------------------------------|-----------------|----------------------|
| LINE | LOCATION (STA.) | DESCRIPTION |
| 8TH STREET NORTH | 1+00 TO 4+45 | GRAVEL |
| | 4+45 TO 6+00 | HYDROSEED AND GRAVEL |
| | 6+00 TO 7+89 | GRAVEL |
| DELLA AVENUE | 1+08 TO 2+00 | HYDROSEED |
| | 2+00 TO 2+33 | ASPHALT |
| | 2+33 TO 2+75 | GRAVEL |
| | 2+75 TO 3+03 | ASPHALT |
| | 3+03 TO 5+14 | HYDROSEED AND GRAVEL |
| | 5+14 TO 5+21 | ASPHALT |
| | 5+21 TO 6+28 | HYDROSEED AND GRAVEL |
| | 6+28 TO 8+30 | ASPHALT |
| 8+30 TO 8+39 | GRAVEL | |
| 8+39 TO 10+15 | HYDROSEED | |

| SURFACE RESTORATION SCHEDULE (CONT.) | | |
|--------------------------------------|-----------------|--------------------|
| LINE | LOCATION (STA.) | DESCRIPTION |
| 8TH STREET SOUTH | 1+00 TO 1+50 | ASPHALT AND GRAVEL |
| | 1+50 TO 3+27 | GRAVEL |
| | 3+27 TO 4+95 | ASPHALT |


| GRADE CONTROL SCHEDULE | | | |
|------------------------|-----------|---------|----------------------------|
| LINE | FROM STA. | TO STA. | CONTINUOUS SLOPE DIRECTION |
| 8TH STREET NORTH | 1+00 | 7+89 | DOWNWARD |
| DELLA AVENUE | 1+08 | 5+20 | UPWARD |
| 8TH STREET SOUTH | 5+20 | 10+15 | DOWNWARD |
| 8TH STREET SOUTH | 1+00 | 4+95 | DOWNWARD |

- NOTES:**
- MINIMUM COVER FROM FINISH GRADE TO TOP OF PIPE SHALL BE 2.5 FEET.
 - MINIMUM SLOPE OF INSTALLED PIPING SHALL BE 0.003 FT/FT.
 - LOT LINES AND RIGHT-OF-WAYS SHOWN ARE APPROXIMATE ONLY.
 - IT IS ANTICIPATED THE TELEPHONE, POWER, CABLE T.V., WATER, AND SEWER THAT EXIST WITHIN THE STREET AND UTILITY CORRIDOR AND INDIVIDUALLY PROVIDE SERVICE TO EACH LOT WILL BE ENCOUNTERED DURING CONSTRUCTION. CONTRACTOR SHALL PLAN FOR CROSSING AND/OR EXCAVATING ALONG THESE UTILITIES AT EACH LOT AND/OR WITHIN THE STREET AND UTILITY CORRIDOR WITHOUT ADDITIONAL COMPENSATION.
 - SERVICES LOCATED DOWNHILL OF MAIN LINE ARE TO DRAIN BACK TO MAIN LINE, UNLESS DESIGNATED "WITH DRAIN".

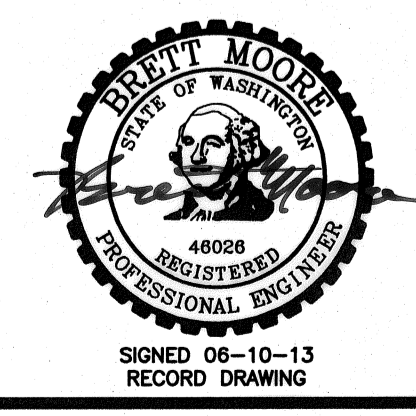

| | | | | | |
|---|--------------|--------------|------------------|---------------|------|
| RECORD DRAWING | | B.M. 5/13 | | SCALE IN FEET | |
| DESIGNED BY | M. OWENS | HORIZ. SCALE | 1" = 50' | VERT. SCALE | |
| DRAWN BY | D. CHRISTMAN | JOB NUMBER | 1199-336 | DATE | 2012 |
| REVIEWED BY | B. MOORE | ACAD FILE | PNP-Downtown.dwg | | |
| COPYRIGHT 2012 BY ANDERSON-PERRY & ASSOC., INC. | | | | | |

RECORD DRAWINGS
 JUNE 10, 2013
 These record drawings have been prepared, in part, on the basis of information compiled and furnished by others. They may contain some discrepancies and omissions, and do not necessarily represent "exact" field conditions. The Owner and the Engineer accept no responsibility for their accuracy.

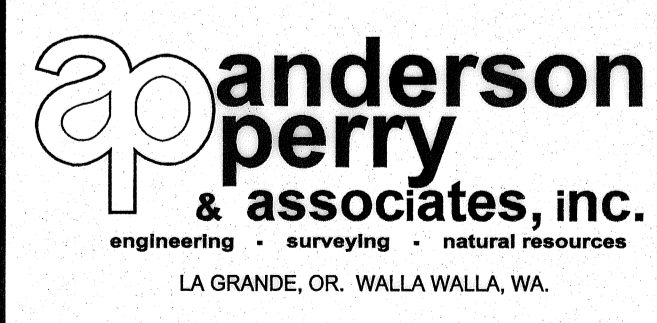

BENTON IRRIGATION DISTRICT
 IRRIGATION SYSTEM IMPROVEMENTS
 PHASE 3B
 DOWNTOWN PIPING
 8TH ST., DELLA AVE.