

SURFACE RESTORATION SCHEDULE		
LINE	LOCATION (STA.)	DESCRIPTION
DELLA AVENUE	1+00 TO 3+32	HYDROSEED
	3+32 TO 4+22	ASPHALT
	4+22 TO 7+55	HYDROSEED
	7+55 TO 8+10	LANDSCAPE
	8+10 TO 8+22	CONCRETE
	8+22 TO 8+42	LANDSCAPE
	8+42 TO 8+64	CONCRETE
	8+64 TO 9+66	LANDSCAPE
	9+66 TO 9+80	CONCRETE
	9+80 TO 10+00	LANDSCAPE
	SERVICE AT 3+25	HYDROSEED
SERVICE AT 5+04	ASPHALT AND HYDROSEED	
SERVICE AT 9+99	ASPHALT AND LANDSCAPE	
BRANCH NORTH-EAST	1+00 TO 1+50	ASPHALT
	1+50 TO 2+30	HYDROSEED
	2+30 TO 2+68	ASPHALT
	SERVICE AT 2+68	ASPHALT


GRADE CONTROL SCHEDULE			
LINE	FROM STA.	TO STA.	CONTINUOUS SLOPE DIRECTION
DELLA AVENUE	1+00	10+00	DOWNWARD
BRANCH NORTH-EAST	1+00	2+68	UPWARD

NOTES:

- MINIMUM COVER FROM FINISH GRADE TO TOP OF PIPE SHALL BE 2.5 FEET.
- MINIMUM SLOPE OF INSTALLED PIPING SHALL BE 0.003 FT/FT.
- LOT LINES AND RIGHT-OF-WAYS SHOWN ARE APPROXIMATE ONLY.
- IT IS ANTICIPATED THE TELEPHONE, POWER, CABLE T.V., WATER, AND SEWER THAT EXIST WITHIN THE STREET AND UTILITY CORRIDOR AND INDIVIDUALLY PROVIDE SERVICE TO EACH LOT WILL BE ENCOUNTERED DURING CONSTRUCTION. CONTRACTOR SHALL PLAN FOR CROSSING AND/OR EXCAVATING ALONG THESE UTILITIES AT EACH LOT AND/OR WITHIN THE STREET AND UTILITY CORRIDOR WITHOUT ADDITIONAL COMPENSATION.
- SERVICES LOCATED DOWNHILL OF MAIN LINE ARE TO DRAIN BACK TO MAIN LINE, UNLESS DESIGNATED "WITH DRAIN".


WORK ITEMS

- (C) EXISTING IRRIGATION LINE ALONG ALIGNMENT TO BE ABANDONED. REMOVE AND PLUG AS REQUIRED FOR NEW LINE INSTALLATION.

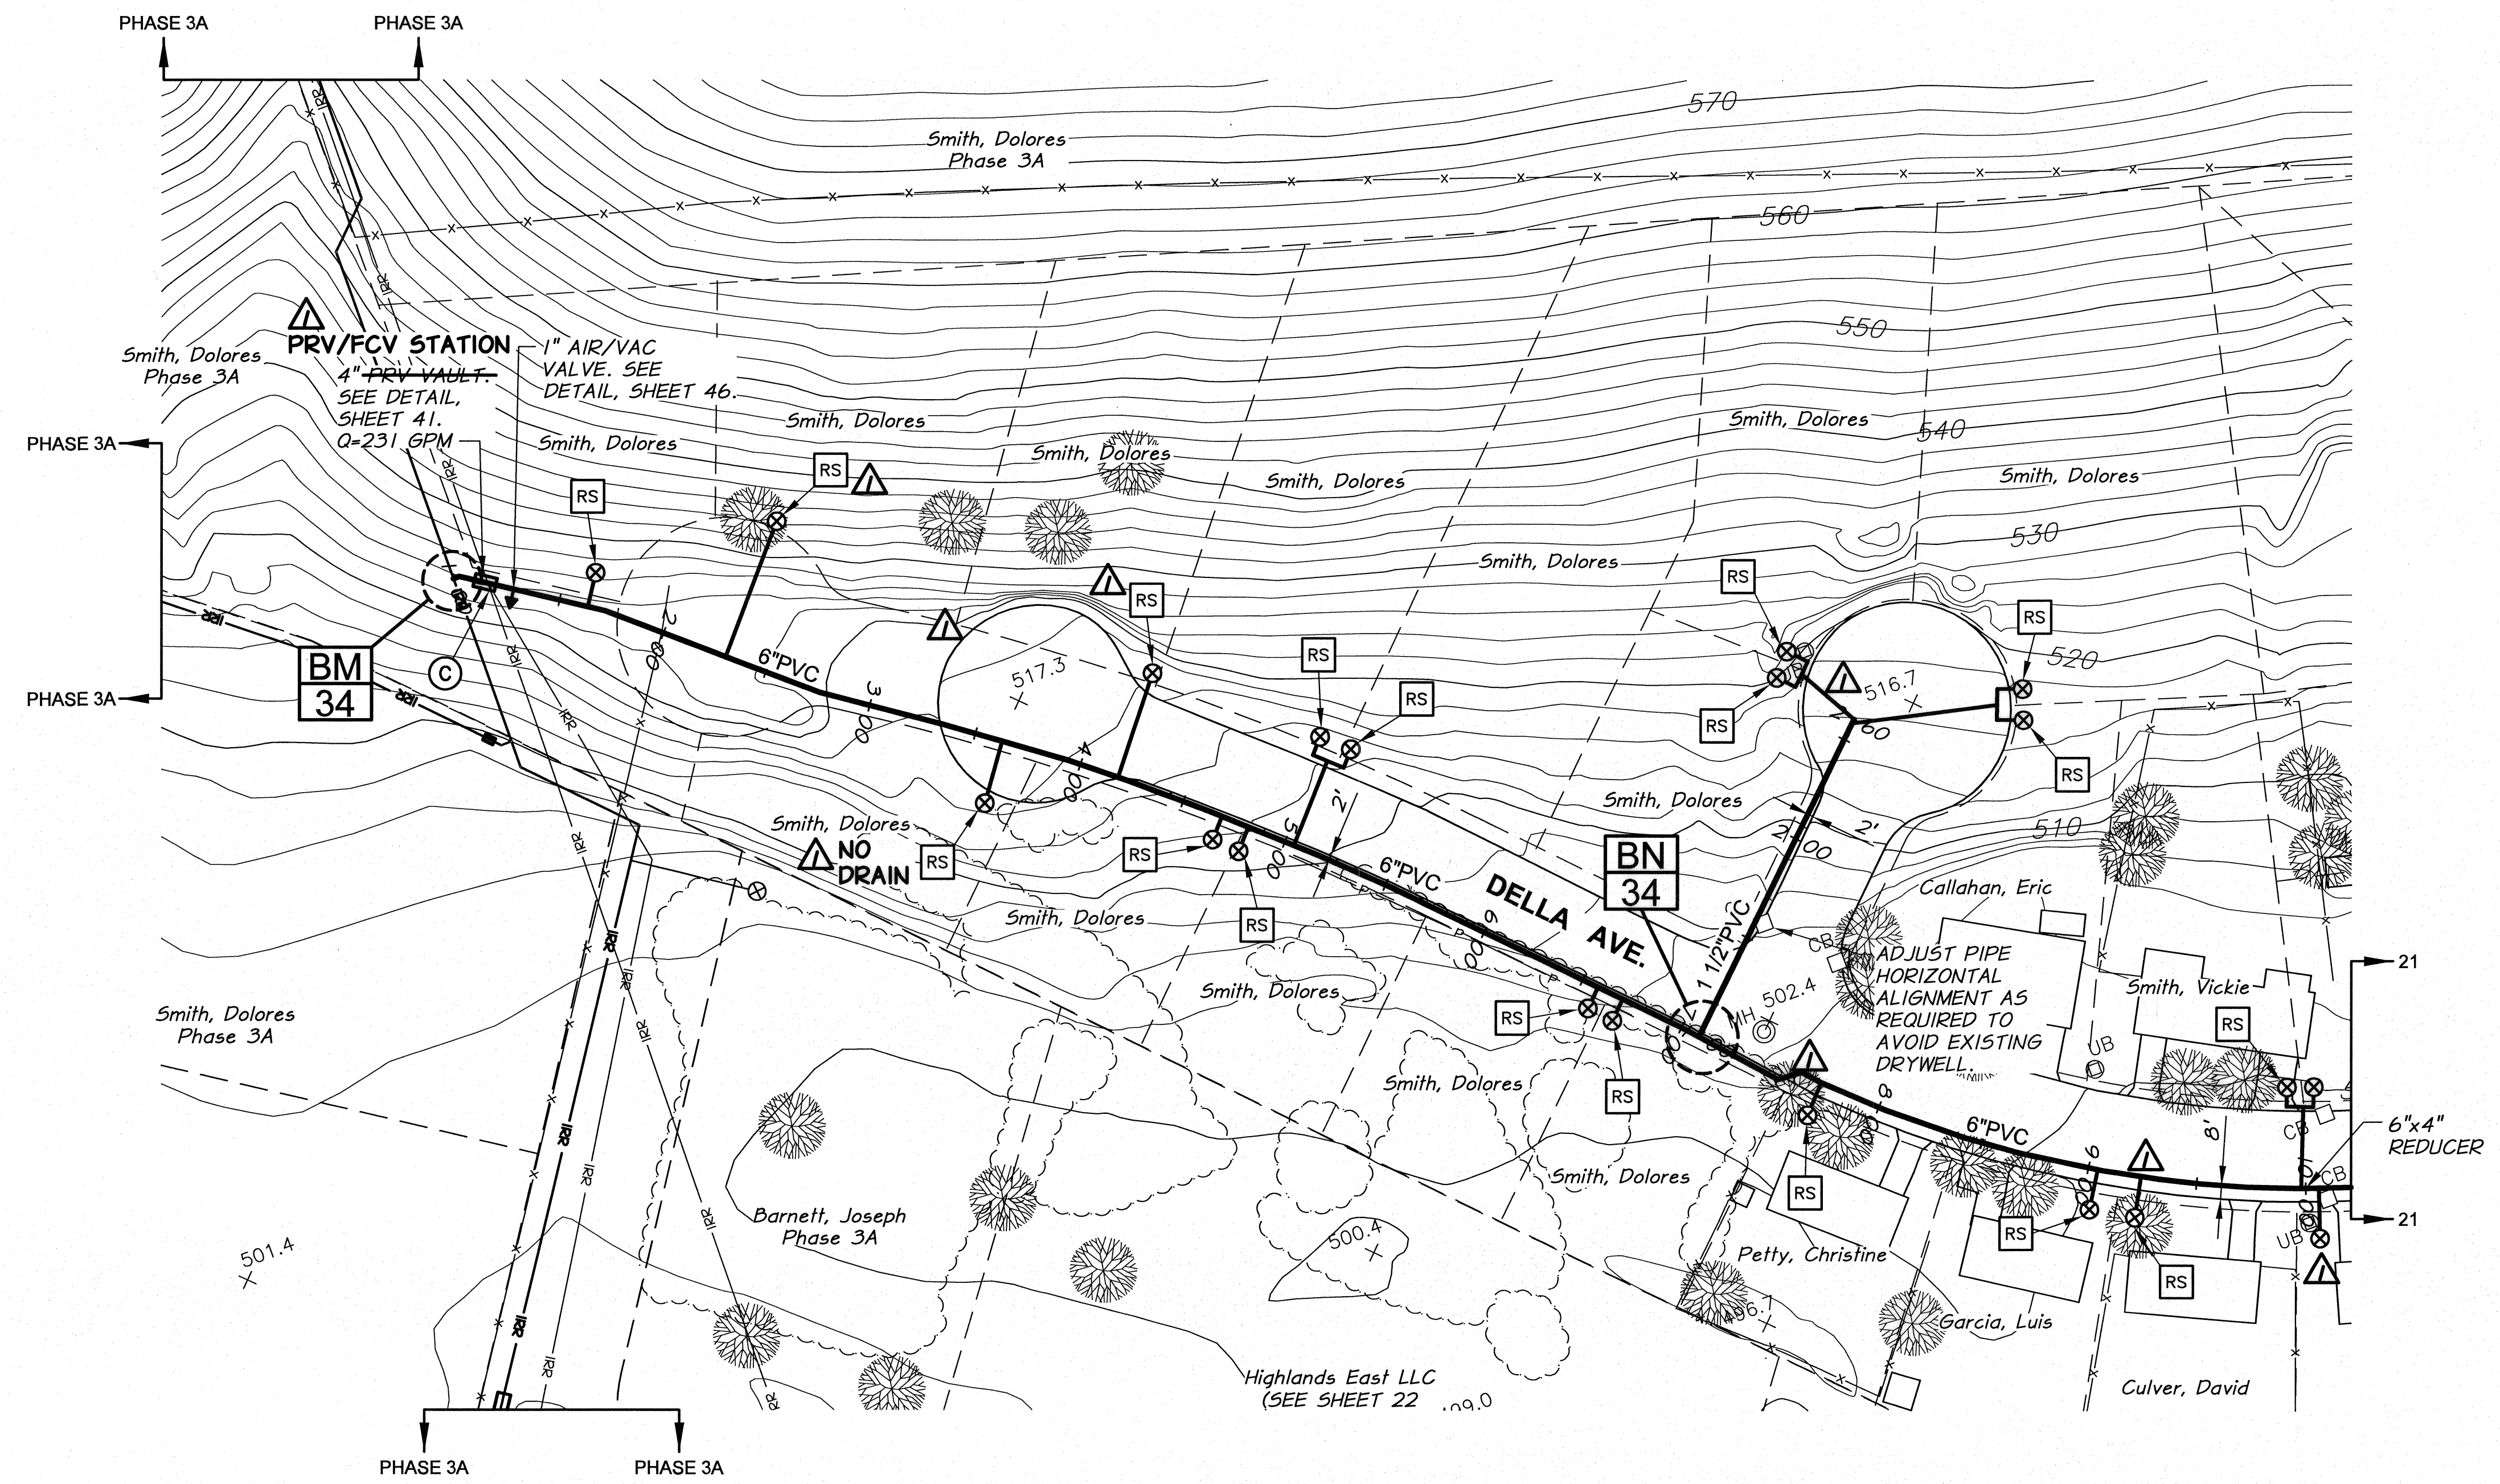

RECORD DRAWING		BY	B.M.	DATE	5/13
DESIGNED BY	M. OWENS	HORIZ. SCALE	1" = 50'	VERT. SCALE	
DRAWN BY	D. CHRISTMAN	JOB NUMBER	1199-336	DATE	2012
REVIEWED BY	B. MOORE	ACAD FILE	PNP-Della.dwg	COPYRIGHT 2012 BY ANDERSON-PERRY & ASSOC., INC.	

RECORD DRAWINGS
 JUNE 10, 2013
 These record drawings have been prepared, in part, on the basis of information compiled and furnished by others. They may contain some discrepancies and omissions, and do not necessarily represent "exact" field conditions. The Owner and the Engineer accept no responsibility for their accuracy.

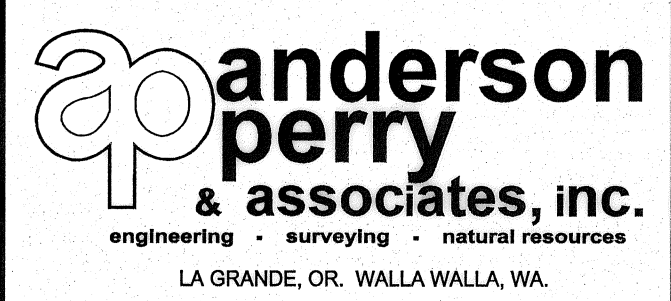

BENTON IRRIGATION DISTRICT
 IRRIGATION SYSTEM IMPROVEMENTS
 PHASE 3B
 DELLA AVENUE PIPING
 DELLA AVE.