

**WORK ITEMS**


- Ⓒ EXISTING IRRIGATION LINE ALONG ALIGNMENT TO BE ABANDONED. REMOVE AND PLUG AS REQUIRED FOR NEW LINE INSTALLATION.

SURFACE RESTORATION SCHEDULE		
LINE	LOCATION (STA.)	DESCRIPTION
DALE AVENUE	1+20 TO 1+40	HYDROSEED
	1+40 TO 10+60	GRAVEL
	10+60 TO 12+75	ASPHALT
	12+75 TO 13+79	LANDSCAPE
	13+79 TO 14+90	ASPHALT
	14+90 TO 15+50	LANDSCAPE
	SERVICE AT 5+43	HYDROSEED AND ASPHALT
SERVICE AT 8+48	HYDROSEED AND ASPHALT	

GRADE CONTROL SCHEDULE			
LINE	FROM STA.	TO STA.	CONTINUOUS SLOPE DIRECTION
DALE AVENUE	1+20	11+50	DOWNWARD
	11+50	15+50	UPWARD


**NOTES:**

- MINIMUM COVER FROM FINISH GRADE TO TOP OF PIPE SHALL BE 2.5 FEET.
- MINIMUM SLOPE OF INSTALLED PIPING SHALL BE 0.003 FT/FT.
- LOT LINES AND RIGHT-OF-WAYS SHOWN ARE APPROXIMATE ONLY.
- IT IS ANTICIPATED THE TELEPHONE, POWER, CABLE T.V., WATER, AND SEWER THAT EXIST WITHIN THE STREET AND UTILITY CORRIDOR AND INDIVIDUALLY PROVIDE SERVICE TO EACH LOT WILL BE ENCOUNTERED DURING CONSTRUCTION. CONTRACTOR SHALL PLAN FOR CROSSING AND/OR EXCAVATING ALONG THESE UTILITIES AT EACH LOT AND/OR WITHIN THE STREET AND UTILITY CORRIDOR WITHOUT ADDITIONAL COMPENSATION.
- SERVICES LOCATED DOWNHILL OF MAIN LINE ARE TO DRAIN BACK TO MAIN LINE, UNLESS DESIGNATED "WITH DRAIN".

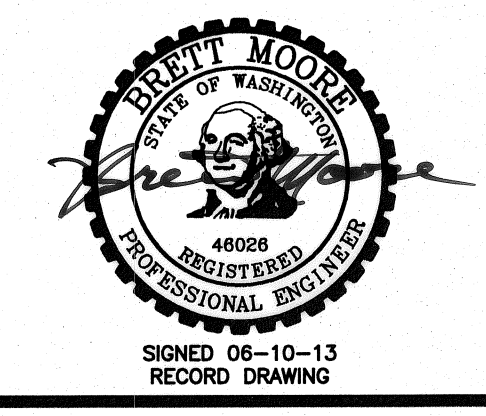

REVISION		BY	DATE	HORIZ. SCALE	VERT. SCALE
RECORD DRAWING		B.M.	5/13	1"=50'	
DESIGNED BY	M. OWENS		JOB NUMBER	1199-336	
DRAWN BY	D. CHRISTMAN		DATE	2012	
REVIEWED BY	B. MOORE		ACAD FILE	PNP-DaleChris.dwg	
COPYRIGHT 2012 BY ANDERSON-PERRY & ASSOC., INC.					

**RECORD DRAWINGS**  
 JUNE 10, 2013  
 These record drawings have been prepared, in part, on the basis of information compiled and furnished by others. They may contain some discrepancies and omissions, and do not necessarily represent "exact" field conditions. The Owner and the Engineer accept no responsibility for their accuracy.

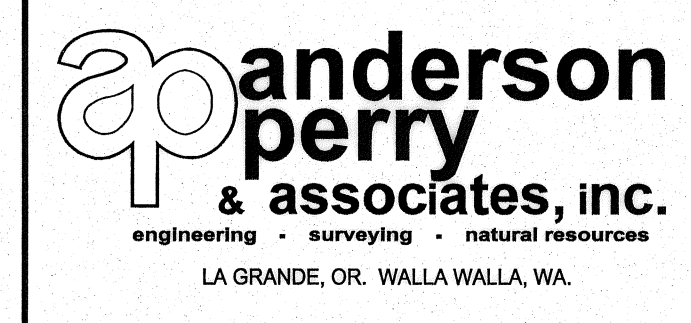

**BENTON IRRIGATION DISTRICT**  
 IRRIGATION SYSTEM IMPROVEMENTS  
 PHASE 3B  
 DALE AVE. TO CHRIS AVE. PIPING  
 DALE AVENUE