

▲ SURFACE RESTORATION SCHEDULE

LINE	LOCATION (STA.)	DESCRIPTION
CHRIS AVENUE	15+00 TO 21+50	HYDROSEED AND GRAVEL
	21+50 TO 22+23	GRAVEL
	22+23 TO 22+80	HYDROSEED
	22+80 TO 24+13	HYDROSEED AND GRAVEL
	24+13 TO 24+50	ASPHALT
	24+50 TO 26+50	GRAVEL
	26+50 TO 29+57	HYDROSEED AND GRAVEL
	SERVICE AT 24+52	GRAVEL


▲ GRADE CONTROL SCHEDULE

LINE	FROM STA.	TO STA.	CONTINUOUS SLOPE DIRECTION
CHRIS AVENUE	15+00	15+50	DOWNWARD
	15+50	27+50	UPWARD
	27+50	29+57	DOWNWARD
	SERVICE AT 24+52		DRAIN AWAY FROM MAIN

WORK ITEMS


- (A) EXISTING IRRIGATION LINE ALONG OR CROSSING ALIGNMENT. EXACT LOCATION UNKNOWN. REMOVE AND PLUG AS REQUIRED FOR NEW LINE INSTALLATION.

- NOTES:**
1. MINIMUM COVER FROM FINISH GRADE TO TOP OF PIPE SHALL BE 2.5 FEET.
 2. MINIMUM SLOPE OF INSTALLED PIPING SHALL BE 0.003 FT/FT.
 3. LOT LINES AND RIGHT-OF-WAYS SHOWN ARE APPROXIMATE ONLY.
 4. IT IS ANTICIPATED THE TELEPHONE, POWER, CABLE T.V., WATER, AND SEWER THAT EXIST WITHIN THE STREET AND UTILITY CORRIDOR AND INDIVIDUALLY PROVIDE SERVICE TO EACH LOT WILL BE ENCOUNTERED DURING CONSTRUCTION. CONTRACTOR SHALL PLAN FOR CROSSING AND/OR EXCAVATING ALONG THESE UTILITIES AT EACH LOT AND/OR WITHIN THE STREET AND UTILITY CORRIDOR WITHOUT ADDITIONAL COMPENSATION.
 5. SERVICES LOCATED DOWNHILL OF MAIN LINE ARE TO DRAIN BACK TO MAIN LINE, UNLESS DESIGNATED "WITH DRAIN".

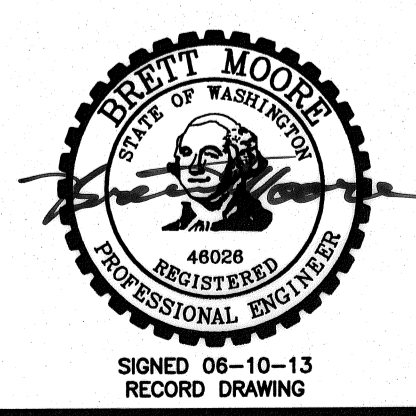

RECORD DRAWING		B.M.	5/13	SCALE IN FEET	
RE-ROUTE MAIN LINE ALIGNMENT		B.M.	8/12	0 50 100 150	
DESIGNED BY	M. OWENS	DATE	2012	HORIZ. SCALE	1" = 50'
DRAWN BY	D. CHRISTMAN	DATE	2012	VERT. SCALE	
REVIEWED BY	B. MOORE	JOB NUMBER	1199-336	ACAD FILE	PNP-DaleChris.dwg
COPYRIGHT 2012 BY ANDERSON-PERRY & ASSOC., INC.					

RECORD DRAWINGS
 JUNE 10, 2013
 These record drawings have been prepared, in part, on the basis of information compiled and furnished by others. They may contain some discrepancies and omissions, and do not necessarily represent "exact" field conditions. The Owner and the Engineer accept no responsibility for their accuracy.

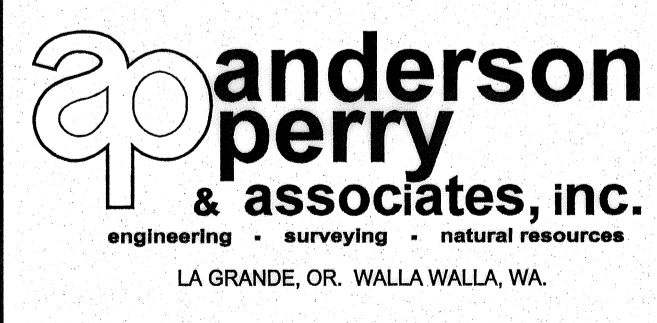

BENTON IRRIGATION DISTRICT
 IRRIGATION SYSTEM IMPROVEMENTS
 PHASE 3B
 DALE AVE. TO CHRIS AVE. PIPING
 CHRIS AVENUE

SHEET
24
 REVISED