


SURFACE RESTORATION SCHEDULE		
LINE	LOCATION (STA.)	DESCRIPTION
HIGHLAND TO HORNE	1+00 TO 7+40	GRAVEL
	7+40 TO 18+00	HYDROSEED

GRADE CONTROL SCHEDULE			
LINE	FROM STA.	TO STA.	CONTINUOUS SLOPE DIRECTION
HIGHLAND TO HORNE	1+00	18+00	DOWNWARD

- NOTES:**
- MINIMUM COVER FROM FINISH GRADE TO TOP OF PIPE SHALL BE 2.5 FEET.
  - MINIMUM SLOPE OF INSTALLED PIPING SHALL BE 0.003 FT/FT.
  - LOT LINES AND RIGHT-OF-WAYS SHOWN ARE APPROXIMATE ONLY.
  - IT IS ANTICIPATED THE TELEPHONE, POWER, CABLE T.V., WATER, AND SEWER THAT EXIST WITHIN THE STREET AND UTILITY CORRIDOR AND INDIVIDUALLY PROVIDE SERVICE TO EACH LOT WILL BE ENCOUNTERED DURING CONSTRUCTION. CONTRACTOR SHALL PLAN FOR CROSSING AND/OR EXCAVATING ALONG THESE UTILITIES AT EACH LOT AND/OR WITHIN THE STREET AND UTILITY CORRIDOR WITHOUT ADDITIONAL COMPENSATION.
  - SERVICES LOCATED DOWNHILL OF MAIN LINE ARE TO DRAIN BACK TO MAIN LINE, UNLESS DESIGNATED "WITH DRAIN".

**WORK ITEMS**


Ⓢ EXISTING IRRIGATION LINE ALONG ALIGNMENT TO BE ABANDONED. REMOVE AND PLUG AS REQUIRED FOR NEW LINE INSTALLATION.

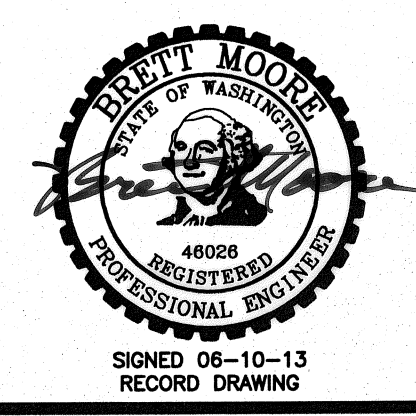

REVISION		BY		DATE		HORIZ. SCALE 1"=50'		VERT. SCALE	
RECORD DRAWING		B.M.		5/13		SCALE IN FEET			
DESIGNED BY	M. OWENS	JOB NUMBER	1199-336	DATE	2012				
DRAWN BY	D. CHRISTMAN	ACAD FILE	PNP-Highland2Horne.dwg						
REVIEWED BY	B. MOORE	COPYRIGHT 2012 BY ANDERSON-PERRY & ASSOC., INC.							

**RECORD DRAWINGS**  
JUNE 10, 2013

These record drawings have been prepared, in part, on the basis of information compiled and furnished by others. They may contain some discrepancies and omissions, and do not necessarily represent "exact" field conditions. The Owner and the Engineer accept no responsibility for their accuracy.

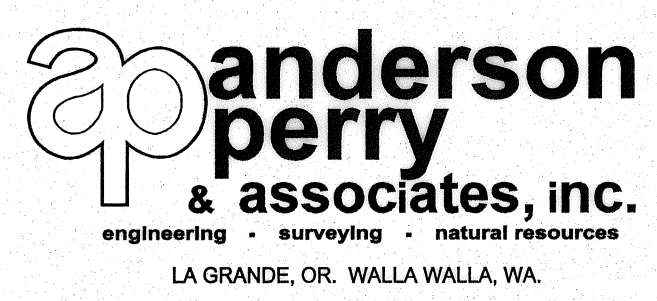

**BENTON IRRIGATION DISTRICT**  
IRRIGATION SYSTEM IMPROVEMENTS  
PHASE 3B

HIGHLAND RD. TO HORNE RD. PIPING I

SHEET  
**26**