


# BENTON IRRIGATION DISTRICT

## IRRIGATION SYSTEM IMPROVEMENTS


### PHASE 3C

#### 2013

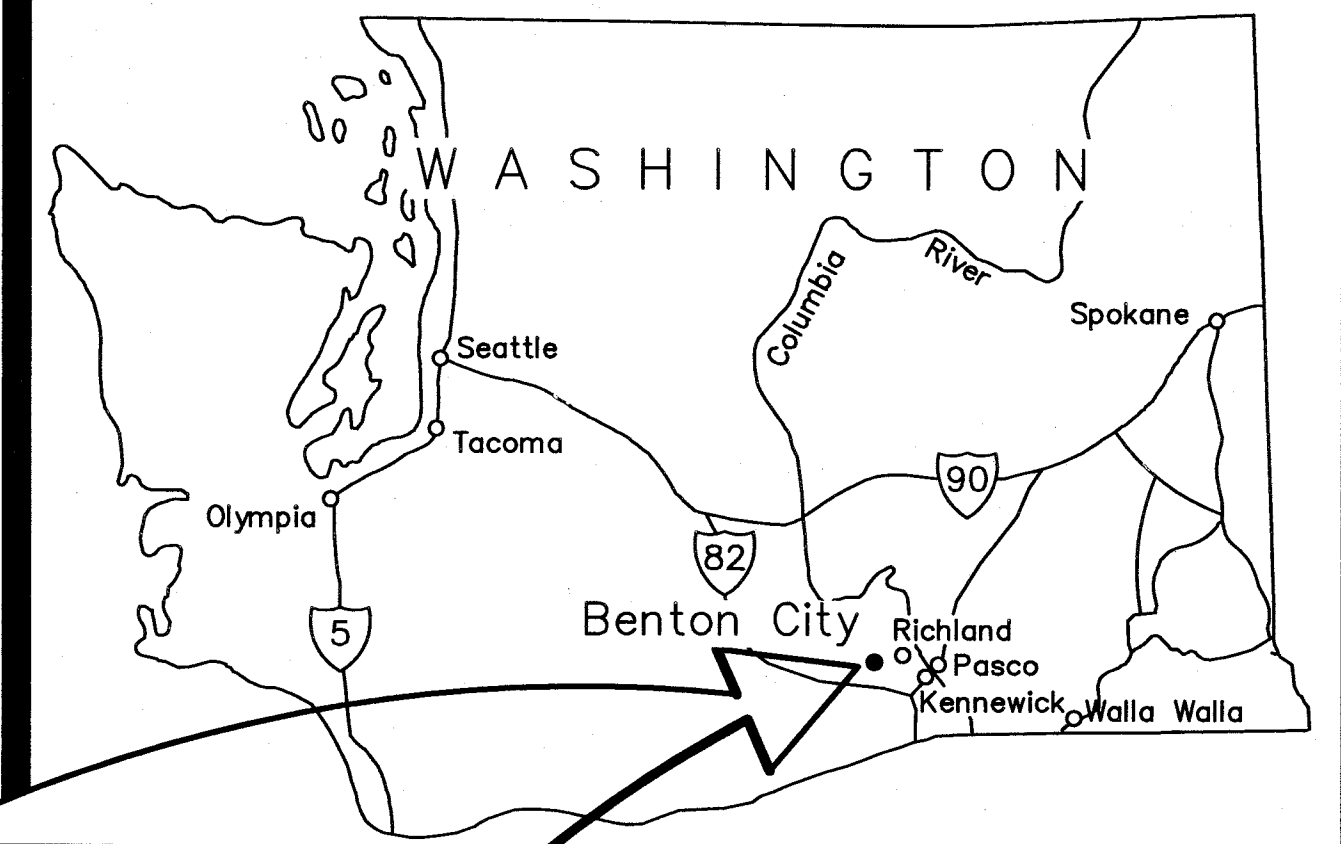

### INDEX

- COVER
- 1 LEGEND, NOTES, AND QUANTITIES
- 2 SHEET INDEX
- PIPING PLANS
- 3 HORNE ROAD AND ANGELINE BOULEVARD
- 4 IDA AVENUE AND IRMA LANE
- 5 IONE DRIVE, HORNE ROAD, 13TH STREET AND CEDAR AVE.
- 6 JANE AVENUE, 12TH STREET, AND FIG STREET
- 7 11TH STREET AND JANE-IRENE ALLEY
- 8 11TH ST., KITTY AND KAREN AVE., LESLIE AND CHRISTOPHER LN.
- 9 JANE AVENUE, JONAH LANE, AND 9TH STREET
- 10 KIBE AND HORNE ROAD, IONE DRIVE AND IRENE AVENUE
- 11 13TH STREET, JILL AVE. AND KAREN AVE.
- 12 WRANGLER ADDITION
- △ 12A ADDED SERVICE AND CHANGE ORDER 1.2
- 13 PIPE CONNECTION DETAILS I
- 14 PIPE CONNECTION DETAILS II
- 15 PIPE CONNECTION DETAILS III
- 16 SERVICE DETAILS I
- 17 SERVICE DETAILS II
- 18 SERVICE DETAILS III
- 19 CONTROL VALVE DETAILS I
- △ 19A CONTROL VALVE DETAILS 1A
- 20 CONTROL VALVE DETAILS II
- 21 M.P. 2.14 HIGHWAY CROSSING AND CASING DETAILS
- 22 M.P. 2.43 HIGHWAY CROSSING DETAIL
- 23 MISCELLANEOUS DETAILS I
- 24 MISCELLANEOUS DETAILS II
- 25 MISCELLANEOUS DETAILS III
- 26 TRENCH DETAILS
- 27 THRUST BLOCK DETAILS

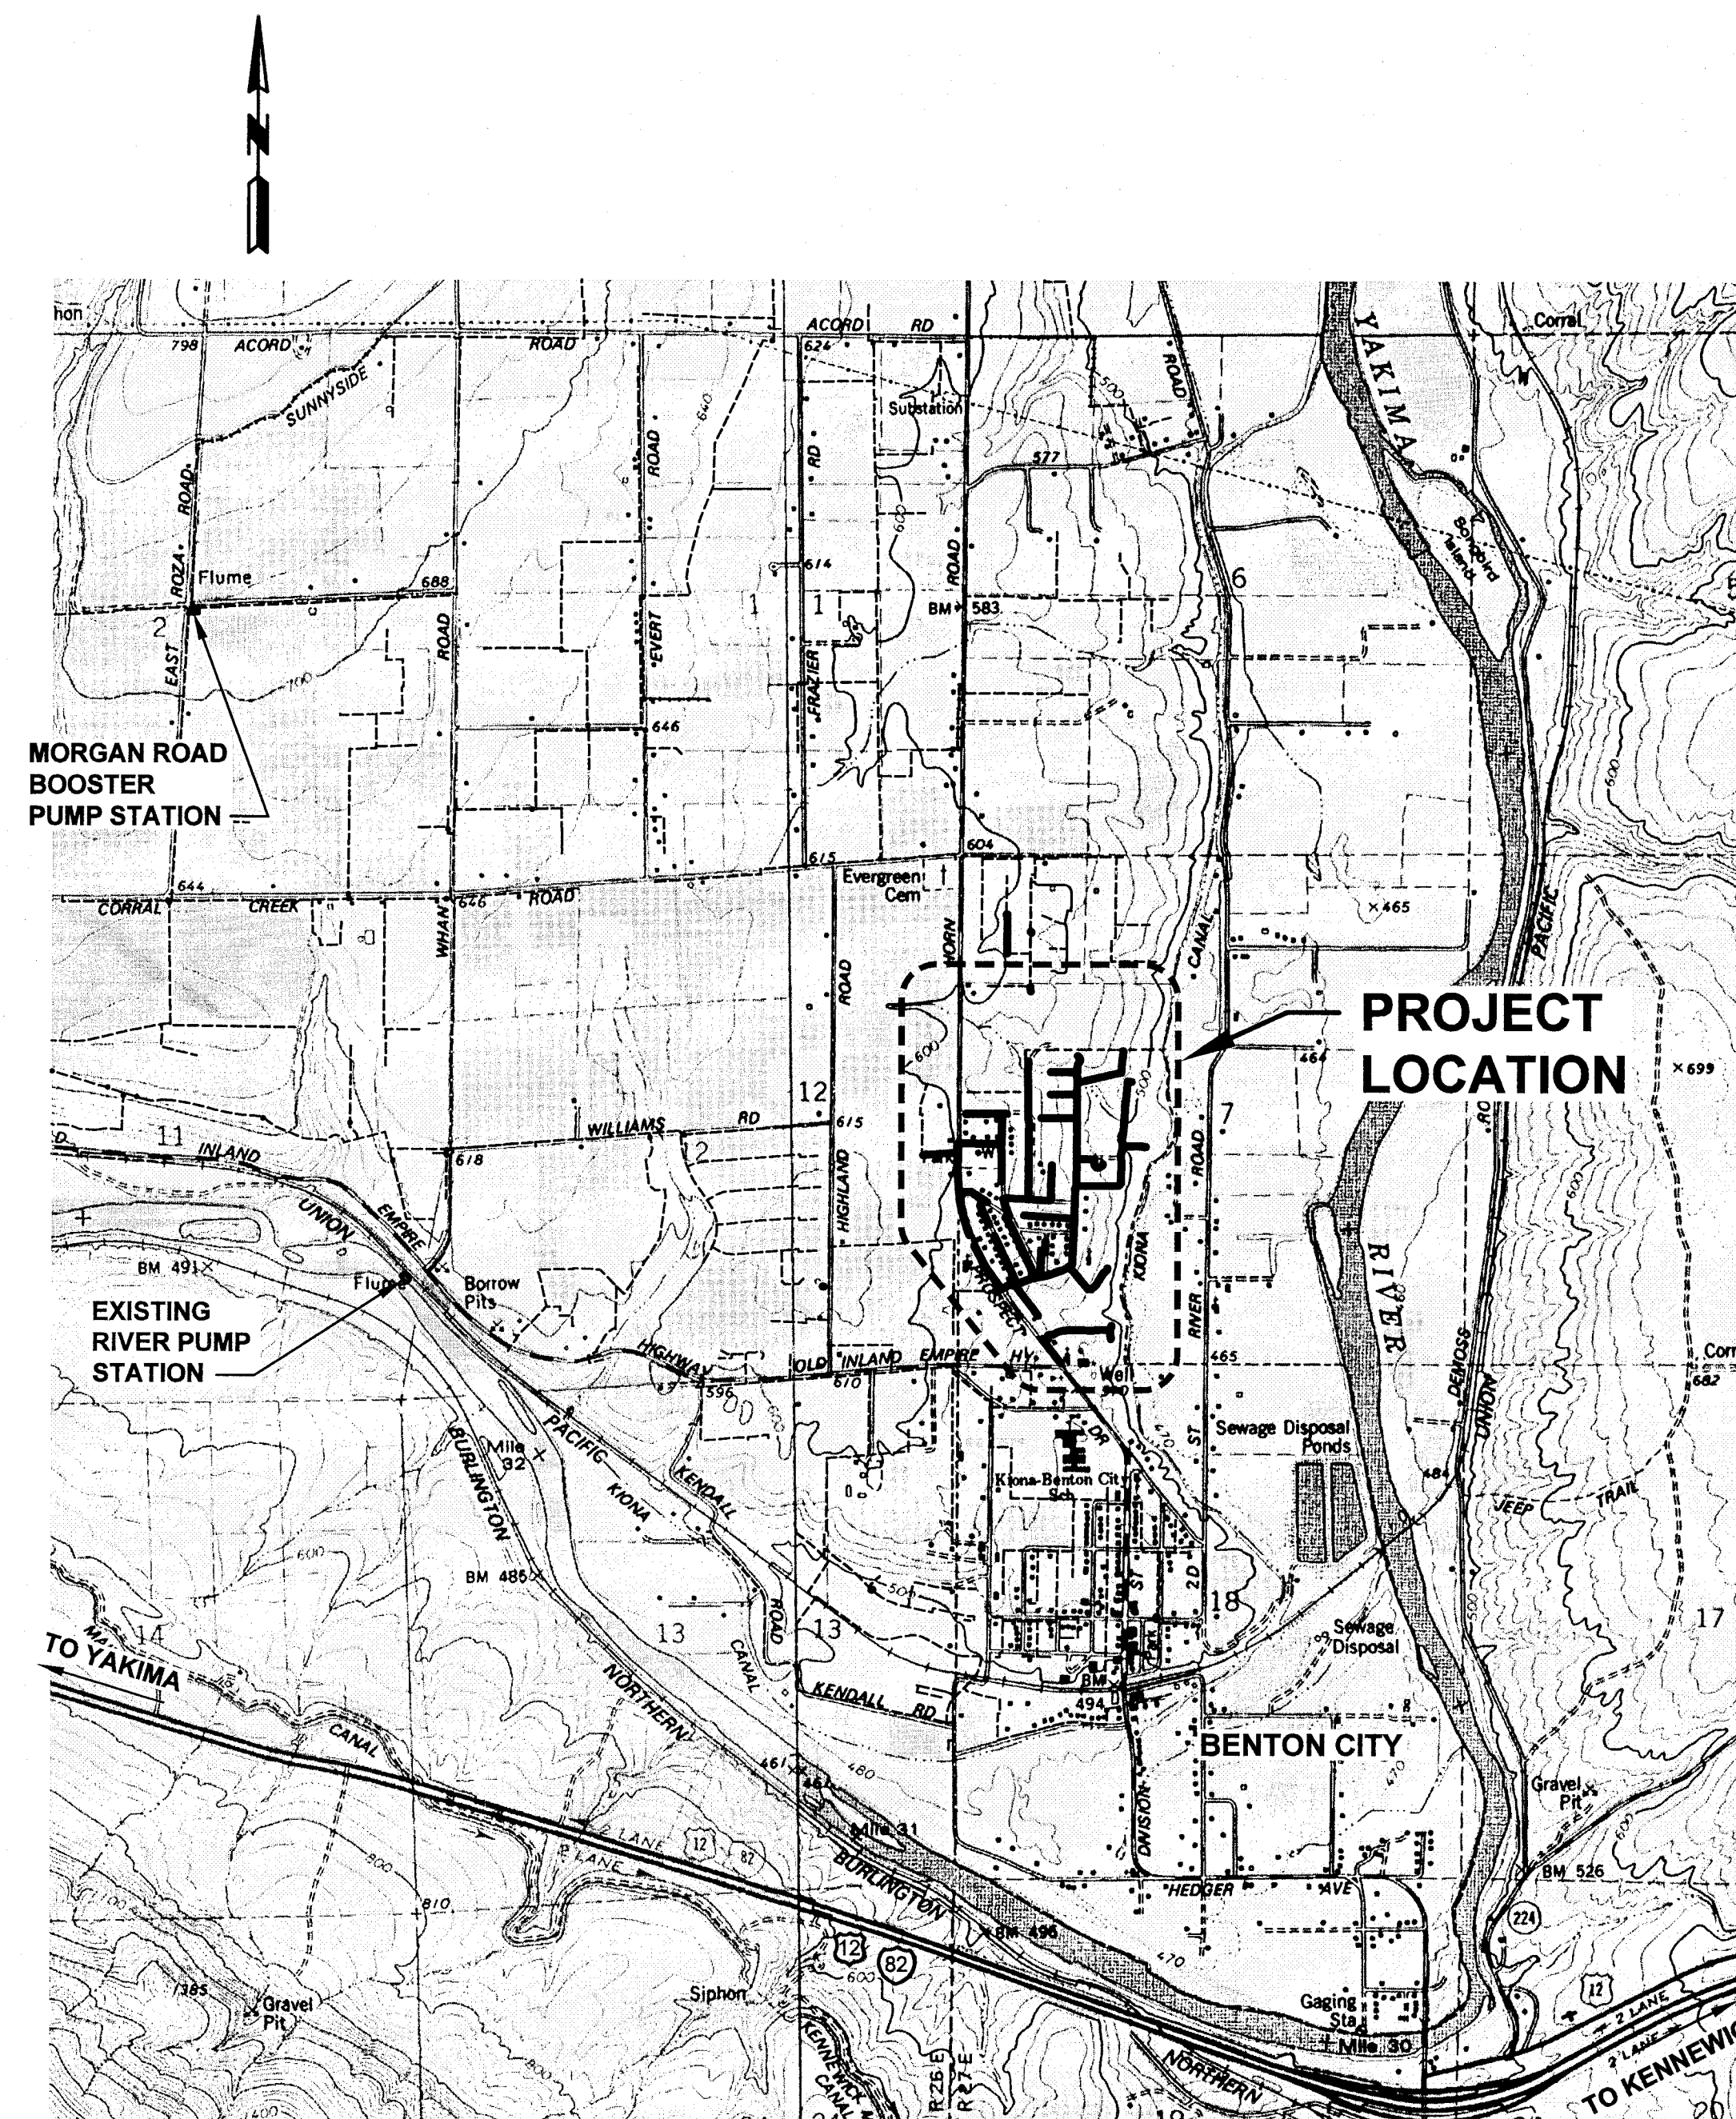

VICINITY MAP  
NTS

**RECORD DRAWINGS**  
APRIL 18, 2014


These record drawings have been prepared, in part, on the basis of information compiled and furnished by others. They may contain some discrepancies and omissions, and do not necessarily represent "exact" field conditions. The Owner and the Engineer accept no responsibility for their accuracy.

△ RECORD DRAWING B.M. 4/14



### DISTRICT BOARD OF DIRECTORS

ROBERT BUOY  
DIRK MARTIN  
ED SCHAB

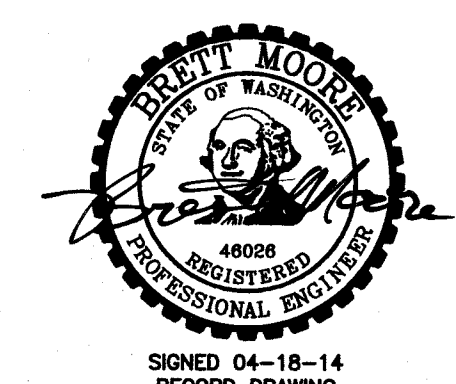

**ap anderson perry & associates, inc.**  
engineering • surveying • natural resources

1901 N. Fir Street - La Grande, OR 97850 Ph: (541)963-8309 Fax: (541)963-5456  
LA GRANDE, OR. WALLA WALLA, WA.


COPYRIGHT 2013 BY ANDERSON-PERRY & ASSOC., INC.

ARCHIVED

**PLAN LEGEND**

| IRRIGATION                   |                   |
|------------------------------|-------------------|
| EXISTING                     | PROPOSED          |
| IRRIGATION LINE — IRR —      | 6" PVC —          |
| VALVE                        | ⊠                 |
| CAP                          | ⌈                 |
| COUPLING                     | ⊕                 |
| REDUCER                      | ▷                 |
| AIR/VAC VALVE                | ↑                 |
| BLOW OFF ASSEMBLY            | ⊙                 |
| SERVICE                      | ⊗                 |
| IRRIGATION CONTROL STRUCTURE | — IRR — □ — IRR — |

| SITE SURVEY  |            |
|--|------------|
| EXISTING   |            |
| INDEX CONTOUR                                      | — 750 —    |
| INTERMEDIATE CONTOUR                               | — 749 —    |
| CENTERLINE   | — — — —    |
| PROPERTY LINE/EASEMENT                             | - - - - -  |
| SECTION LINE                                       | — — — —    |
| CULVERT  | — — — —    |
| BENCH MARK   | ⊕          |
| MONUMENT   | △          |
| CONTROL POINT                                      | ⊙          |
| TEST PIT (SEE CONTRACT DOCUMENT APPENDIX FOR LOGS) | ⊗ TP-14    |
| SPOT ELEVATION                                     | 592.3<br>X |

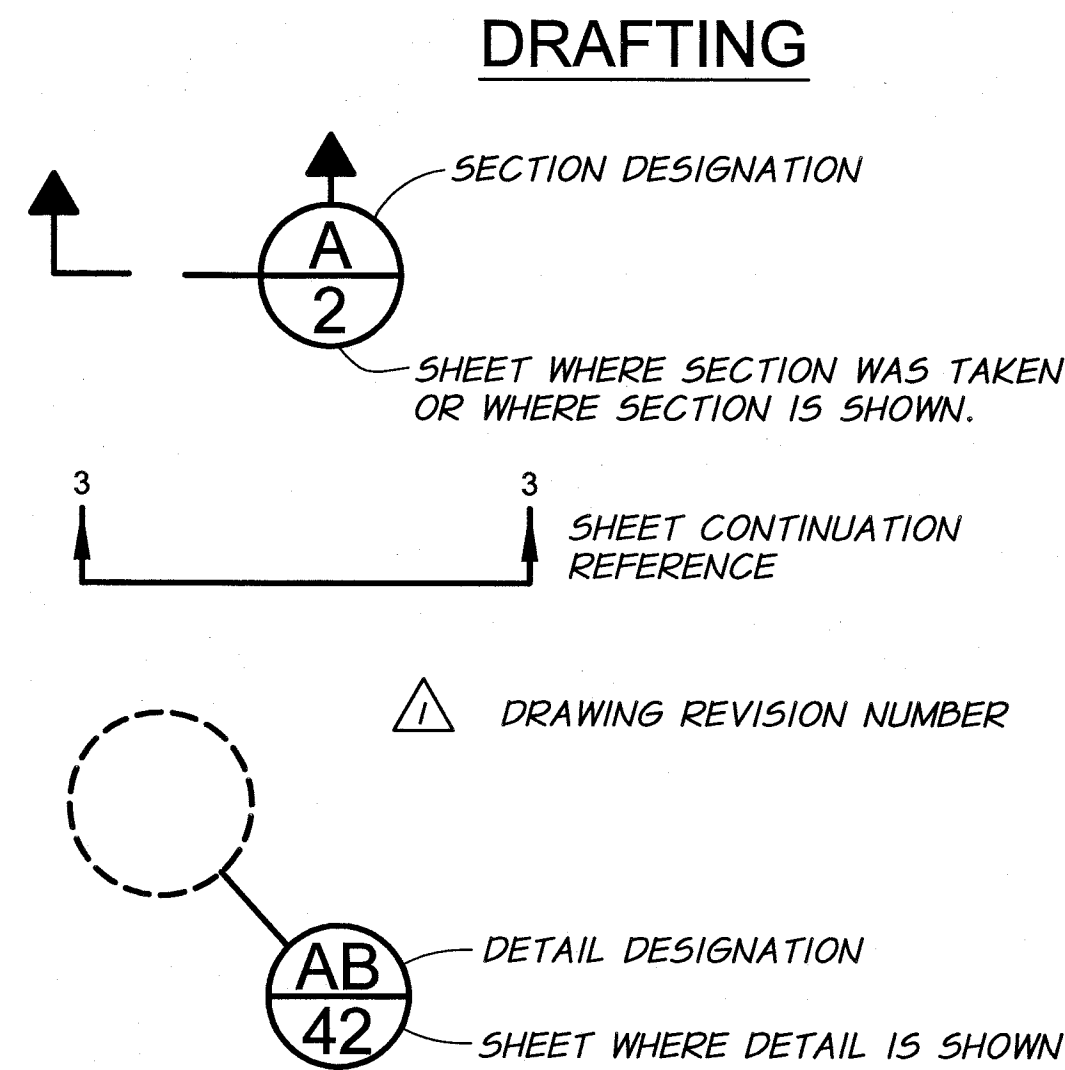


**MISCELLANEOUS UTILITIES**

| EXISTING                |                   |
|-------------------------|-------------------|
| WATER LINE              | - - - W - - - W - |
| BURIED POWER            | — P — P — P —     |
| OVERHEAD POWER          | — OHP — OHP —     |
| BURIED TELEPHONE        | — UT —            |
| FIBER OPTIC             | — FO —            |
| GAS SERVICE             | — G — G —         |
| SIGNAL CABLE IN CONDUIT | — SC —            |
| UTILITY POLE            | ⊙                 |
| GUY WIRE                | ⌒                 |
| TELEPHONE RISER         | ◇                 |
| STREET LIGHT            | ☀                 |

**GENERAL**

| EXISTING               |               |
|------------------------|---------------|
| FENCE LINE/GATE        | — X — X — X — |
| CHAINLINK FENCE        | — □ — □ — □ — |
| CREEK/DITCH CENTERLINE | — — — —       |
| RIVERBANK/SHORELINE    | — — — —       |
| SIGN                   | ⊠             |
| CONIFER TREE           | ⊙             |
| DECIDUOUS TREE         | ⊙             |
| SHRUB                  | ⊙             |
| BUILDING               | ⊠             |

**STREET AND CURB**

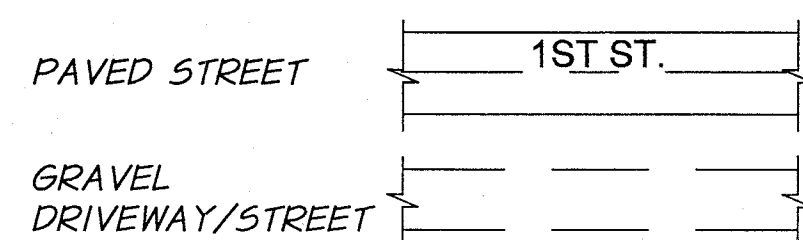

NORTH ARROW

| SERVICE LINE SIZE (INCHES) | DOLE CONTROL VALVE SIZE (INCHES) | DOLE CONTROL VALVE FLOW RATE (GPM) | CALCULATED REQUIRED FLOW (GPM) | PRV SIZE (INCHES) OR CONTROL TYPE FOR LARGER SERVICES:                         |
|----------------------------|----------------------------------|------------------------------------|--------------------------------|--|
| 1.5                        | 1                                | 5.82                               | 6.75                           | FCV = FLOW CONTROL VALVE<br>PRV/FCV = PRESSURE REDUCING AND FLOW CONTROL VALVE |


NOTE: A BLANK DOLE CONTROL VALVE SIZE AND FLOW FIELD INDICATES A FLOWMETER USED. A BLANK PRV SIZE FIELD INDICATES NO PRV VALVE REQUIRED.

- RS STANDARD RESIDENTIAL SERVICE. LINE SIZE IS 1.0 INCH, DOLE CONTROL VALVE SIZE IS 1.0 INCH WITH 6 GPM FLOW RATE. CALCULATED REQUIRED FLOW IS 5.82 GPM.
- RST STANDARD RESIDENTIAL SERVICE AS DESCRIBED ABOVE WITH TRAFFIC RATED BOX AND LID.
- RS 12 STANDARD RESIDENTIAL SERVICE AS DESCRIBED ABOVE WITH FLOW RATE GREATER THAN 6 GPM.
- DOLE CONTROL VALVE FLOW RATE

**CONSTRUCTION NOTES**

- ALL ASPHALT RESTORATION REQUIRED WITHIN AREAS NOT SPECIFIED FOR ASPHALT RESTORATION SHALL BE COMPLETED AT THE CONTRACTOR'S EXPENSE AND AT NO COST TO THE OWNER.
- REMOVE EXISTING DRAINAGE CULVERTS TO CONSTRUCT IRRIGATION LINE. EXISTING CULVERTS TO BE REINSTALLED AFTER PIPELINE INSTALLATION IS COMPLETED. CULVERTS DAMAGED BY CONSTRUCTION TO BE REPLACED WITH NEW SAME TYPE AND SIZE AT CONTRACTOR'S EXPENSE AND AT NO COST TO THE OWNER UNLESS THE CULVERT AGE AND CONDITION ENSUED THE DAMAGE AS DETERMINED BY THE ENGINEER. THE ENGINEER MAY REQUIRE REPLACEMENT OF CULVERTS DUE TO AGE OF CULVERT AND EXISTING CONDITION. REPLACEMENT REQUIRED BY THE ENGINEER SHALL BE PAID UNDER THE "CULVERT REPLACEMENT" BID ITEM AND MUST HAVE PRIOR APPROVAL BEFORE REPLACEMENT.
- MAILBOXES, SIGNS, ETC., IN CONFLICT WITH WORK SHALL BE TEMPORARILY RELOCATED, AS REQUIRED BY THE ENGINEER, AND REINSTALLED TO THE ORIGINAL LOCATION AFTER THE IRRIGATION LINE IS CONSTRUCTED, UNLESS OTHERWISE DIRECTED BY THE ENGINEER. DAMAGED MAILBOXES, SIGNS, POSTS, ETC., CAUSED BY THE CONSTRUCTION SHALL BE REPLACED WITH NEW LIKE KIND AS REQUIRED BY THE ENGINEER AT THE CONTRACTOR'S EXPENSE AND AT NO COST TO THE OWNER UNLESS THE AGE AND CONDITION ENSUED THE DAMAGE AS DETERMINED BY THE ENGINEER. THE ENGINEER MAY REQUIRE REPLACEMENT OF POST DUE TO AGE OF POST AND EXISTING CONDITION. REPLACEMENT REQUIRED BY THE ENGINEER SHALL BE PAID UNDER THE "POST REPLACEMENT" BID ITEM.
- REMOVE EXISTING FENCING TO CONSTRUCT IRRIGATION LINES AS REQUIRED. EXISTING FENCING TO BE REINSTALLED TO THE SATISFACTION OF THE PROPERTY OWNERS AFTER PIPELINE INSTALLATION IS COMPLETED. FENCING DAMAGED BY CONSTRUCTION TO BE REPLACED WITH NEW SAME TYPE AND SIZE TO THE SATISFACTION OF THE PROPERTY OWNERS AT CONTRACTOR'S EXPENSE AND AT NO COST TO THE OWNER.
- LOCATION FOR ALL SERVICES, AIR/VAC VALVES AND BLOW OFF ASSEMBLIES TO BE FIELD VERIFIED WITH THE ENGINEER PRIOR TO CONSTRUCTION. LOW POINTS ON MAIN LINES AND HIGH POINTS ON MAIN LINES SHOWN ON THE DRAWINGS ARE APPROXIMATE. CONSTRUCT BLOW OFFS AND AIR/VAC VALVES AT CONSTRUCTED LOW POINTS AND HIGH POINTS, RESPECTIVELY.
- FOR IRRIGATION LINE CONSTRUCTION DIRECTLY ADJACENT TO TREES, THE CONTRACTOR SHALL PROTECT LIMBS FROM DAMAGE AS REQUIRED DURING CONSTRUCTION. COMPENSATION FOR DAMAGED TREES AND/OR LIMBS CAUSED BY THE CONTRACTOR SHALL BE AT THE CONTRACTOR'S EXPENSE AND AT NO COST TO THE OWNER. SEE TECHNICAL SPECIFICATION FOR DETAIL.
- FRONTIER UNDERGROUND FIBER OPTIC LINES ARE LOCATED WITHIN THE PROJECT. THE CONTRACTOR SHALL COORDINATE HIS WORK WITH FRONTIER PRIOR TO CONSTRUCTION. FOR NEW IRRIGATION LINES THAT WILL CROSS FIBER OPTIC LINES, THE NEW IRRIGATION LINES SHALL BE INSTALLED UNDERNEATH THE FIBER OPTIC LINES, MAINTAINING A MINIMUM OF 12 INCHES CLEARANCE. ADJUSTMENTS TO THE IRRIGATION LINE VERTICAL GRADE MAY BE REQUIRED, INCLUDING FITTINGS AS REQUIRED. THIS ADJUSTMENT SHALL BE INCIDENTAL TO THE WORK.
- EXISTING GROUND ELEVATIONS SHOWN ON THE PROFILES ARE APPROXIMATE AND MAY VARY FROM ACTUAL EXISTING GROUND ELEVATIONS ENCOUNTERED DURING CONSTRUCTION. THERE SHALL BE NO ADDITIONAL PAYMENT MADE TO THE CONTRACTOR FOR EXCAVATION AND BACKFILL VARIATIONS CAUSED BY ELEVATION OF EXISTING GROUND DIFFERENCES FROM WHAT IS SHOWN ON THE DRAWINGS.
- BOTH HORIZONTAL DEFLECTIONS AND CHANGES OF VERTICAL GRADE ARE SHOWN ON THE DRAWINGS. IN SOME LOCATIONS FITTINGS ARE CALLED FOR ON THE DRAWINGS AT HORIZONTAL DEFLECTIONS AND CHANGES IN VERTICAL GRADE, BUT NOT AT ALL LOCATIONS THAT MAY REQUIRE FITTINGS. IF PIPE JOINT DEFLECTION OR BENDING THE PIPE AS DESCRIBED AND ALLOWED IN THE TECHNICAL SPECIFICATIONS DOES NOT MAINTAIN ALIGNMENT OR GRADE, FITTINGS SHALL BE USED WITH APPROPRIATE THRUST BLOCKING AND SHALL BE INCIDENTAL TO THE PIPELINE WORK. ADDITIONALLY, THE CONTRACTOR SHALL MAINTAIN THE 2.5-FOOT MINIMUM COVER OVER THE TOP OF PIPE DURING CONSTRUCTION FOR ALL AREAS EXCEPT DITCH LINES AND ROAD CROSSINGS. MINIMUM COVER FOR DITCH LINES AND ROAD CROSSINGS SHALL BE 3 FEET, UNLESS NOTED OTHERWISE.
- THE CONTRACTOR SHALL PERFORM EXPLORATORY WORK PRIOR TO CONSTRUCTION INCLUDING POTHOLES OF UTILITIES SUCH AS TELEPHONE, FIBER OPTIC, ELECTRICAL, WATER, ETC., AND IRRIGATION MAINS AND SERVICE LINES THAT LAY ADJACENT TO OR CROSS THE IMPROVEMENTS TO BE CONSTRUCTED. THIS WORK SHALL BE PERFORMED IN ORDER TO ACCURATELY LOCATE AND DETERMINE SIZES OF THE LINES AND TO DETERMINE ANY CONFLICTS THAT MAY EXIST THAT WILL REQUIRE ADJUSTMENT OF UTILITIES, COORDINATION WITH UTILITIES, OR ADJUSTMENT OF IMPROVEMENTS. SEE THE TECHNICAL SPECIFICATIONS FOR ADDITIONAL DETAILS. PAYMENT FOR EXPLORATORY WORK SHALL BE PAID UNDER THE BID ITEM "POTHOLES."
- THRUST BLOCKING REQUIRED FOR ALL TEES AND ELBOWS 11-1/4 DEGREES OR GREATER FOR PIPE SIZES 3-INCH OR GREATER.
- THE CONTRACTOR'S WORK SHALL BE LIMITED TO THE WIDTH OF THE IRRIGATION EASEMENT PLUS ANY ADDITIONAL TEMPORARY EASEMENT PROVIDED AND ROAD RIGHT-OF-WAY AS SPECIFIED IN THE TECHNICAL SPECIFICATIONS. SEE THE TECHNICAL SPECIFICATIONS FOR DETAILS.
- CONNECTIONS TO EXISTING IRRIGATION LINES DURING THE IRRIGATION SEASON WILL NEED TO BE COORDINATED WITH B.I.D. AS EXISTING LINES WILL BE FULL OF WATER.
- ALL GALVANIZED BURIED PIPE SHALL BE TAPE WRAPPED PER TECHNICAL SPECIFICATIONS.


- ALL REDUCERS WITH A LARGE PIPE END 3-INCHES OR GREATER IN DIAMETER SHALL BE INSTALLED WITH A COLLAR THRUST BLOCK.

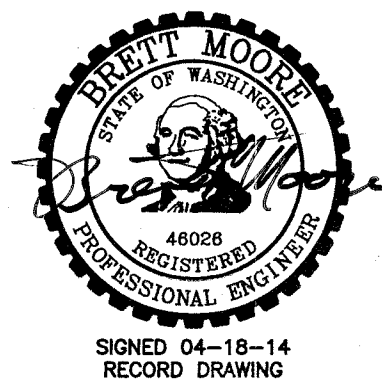

|                |              |   |                 |
|----------------|--------------|---|-----------------|
| RECORD DRAWING |              | B.M.  | 4/14            |
| DESIGNED BY    | H. MORRISON  | DATE  | 2013            |
| DRAWN BY       | D. CHRISTMAN | ACAD FILE                                       | LEGEND-Ph3C.dwg |
| REVIEWED BY    | B. MOORE     | COPYRIGHT 2013 BY ANDERSON-PERRY & ASSOC., INC. |                 |

**RECORD DRAWINGS**

APRIL 18, 2014  
These record drawings have been prepared, in part, on the basis of information compiled and furnished by others. They may contain some discrepancies and omissions, and do not necessarily represent "exact" field conditions. The Owner and the Engineer accept no responsibility for their accuracy.


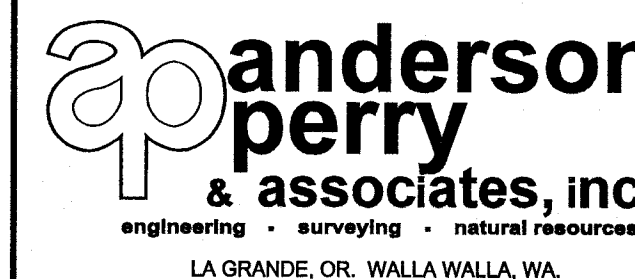


**BENTON IRRIGATION DISTRICT**  
IRRIGATION SYSTEM IMPROVEMENTS  
PHASE 3C


LEGEND, NOTES, AND QUANTITIES

SHEET


1

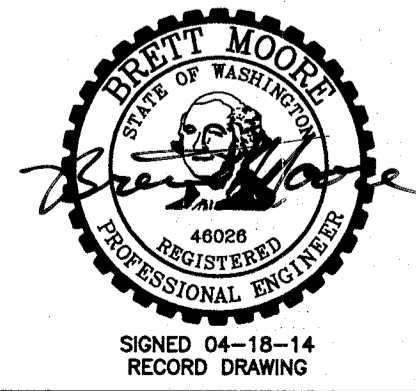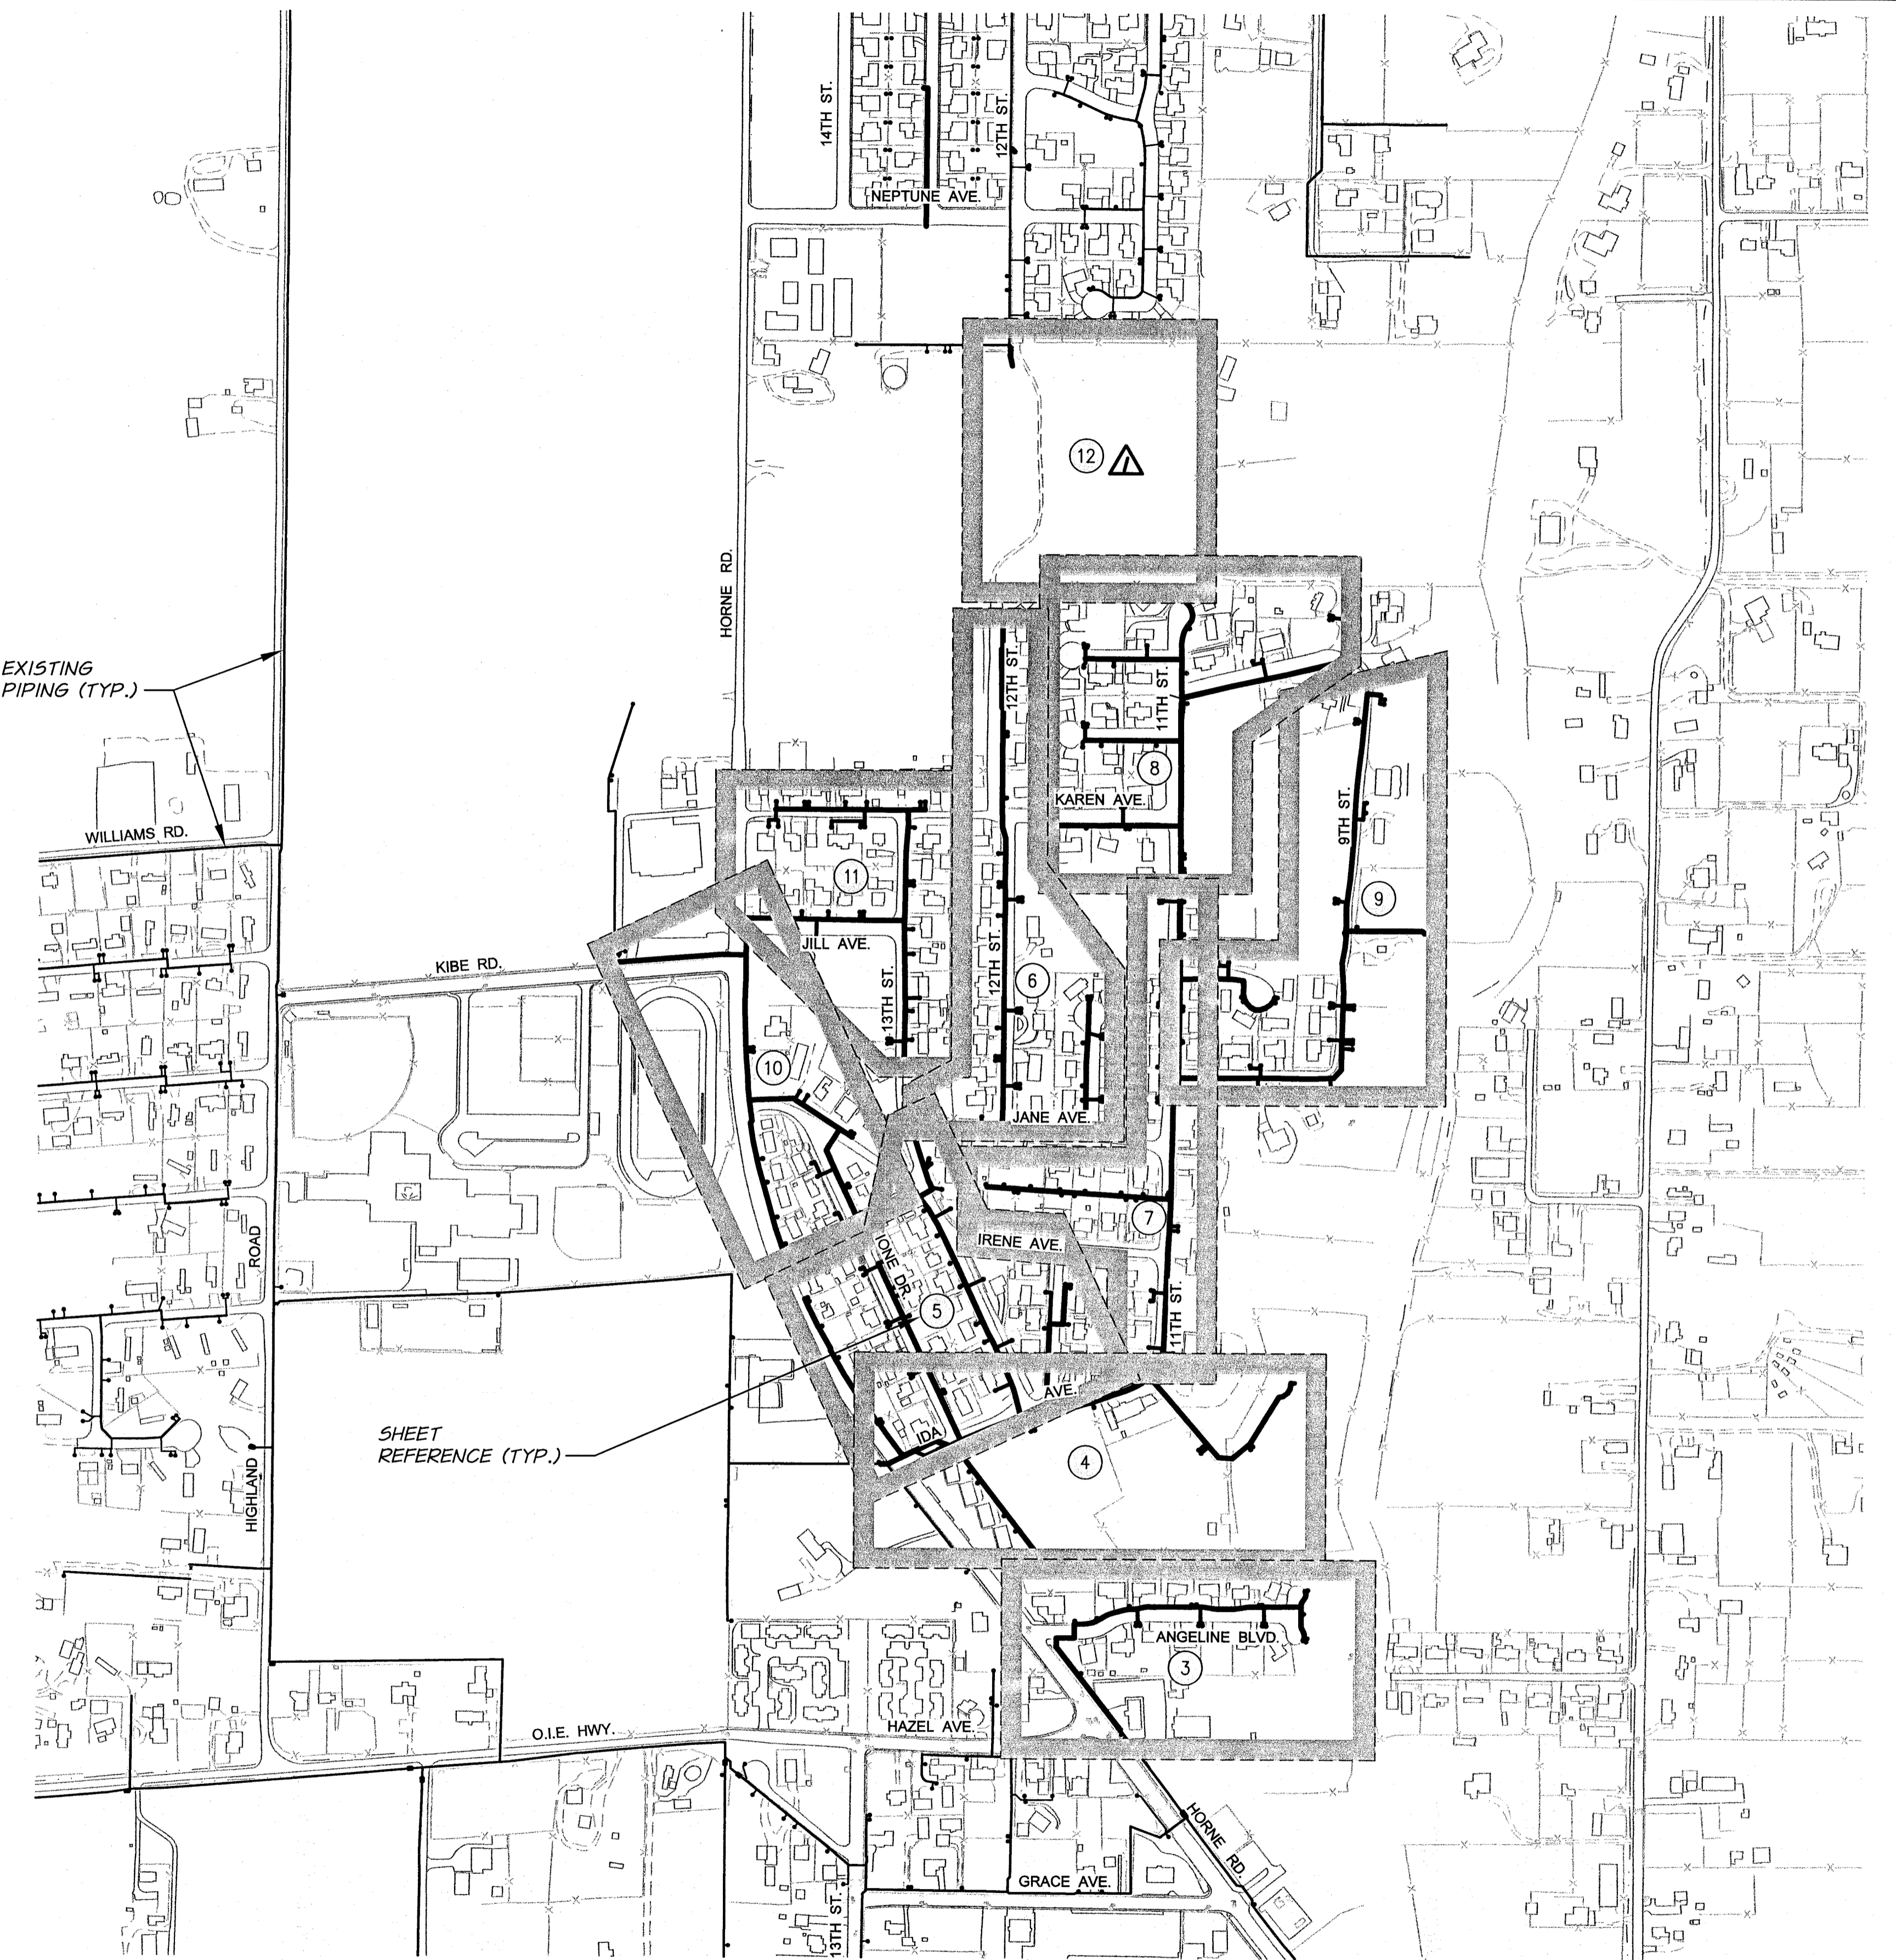

|                |  |              |  |            |  |                                       |  |             |  |
|----------------|--|--------------|--|------------|--|---------------------------------------|--|-------------|--|
| REVISION       |  | BY           |  | DATE       |  | HORIZ. SCALE                          |  | VERT. SCALE |  |
| RECORD DRAWING |  | B.M.         |  | 4/14       |  | 1" = 300'                             |  |             |  |
| DESIGNED BY    |  | H. MORRISON  |  | JOB NUMBER |  | 1199-336                              |  | DATE        |  |
| DRAWN BY       |  | D. CHRISTMAN |  | ACAD FILE: |  | SheetIndexPH3C.dwg                    |  | 2013        |  |
| REVIEWED BY    |  | D. MOORE     |  | COPYRIGHT  |  | 2013 BY ANDERSON-PERRY & ASSOC., INC. |  |             |  |

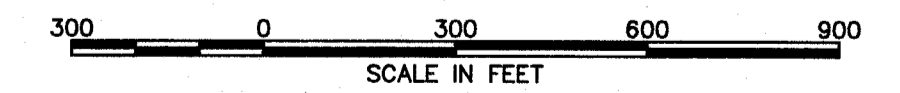


**RECORD DRAWINGS**  
 APRIL 18, 2014  
 These record drawings have been prepared, in part, on the basis of information compiled and furnished by others. They may contain some discrepancies and omissions, and do not necessarily represent "exact" field conditions. The Owner and the Engineer accept no responsibility for their accuracy.

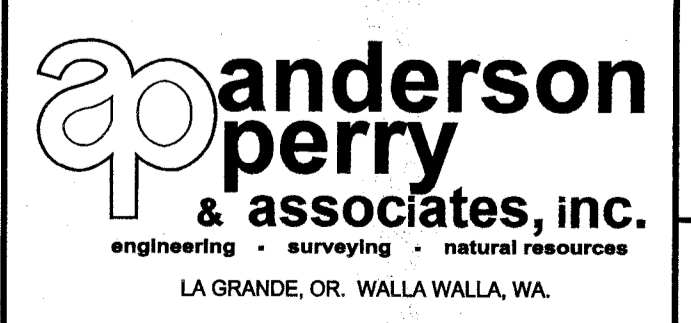


**BENTON IRRIGATION DISTRICT**  
 IRRIGATION SYSTEM IMPROVEMENTS  
 PHASE 3C

SHEET INDEX


SHEET  
**2**

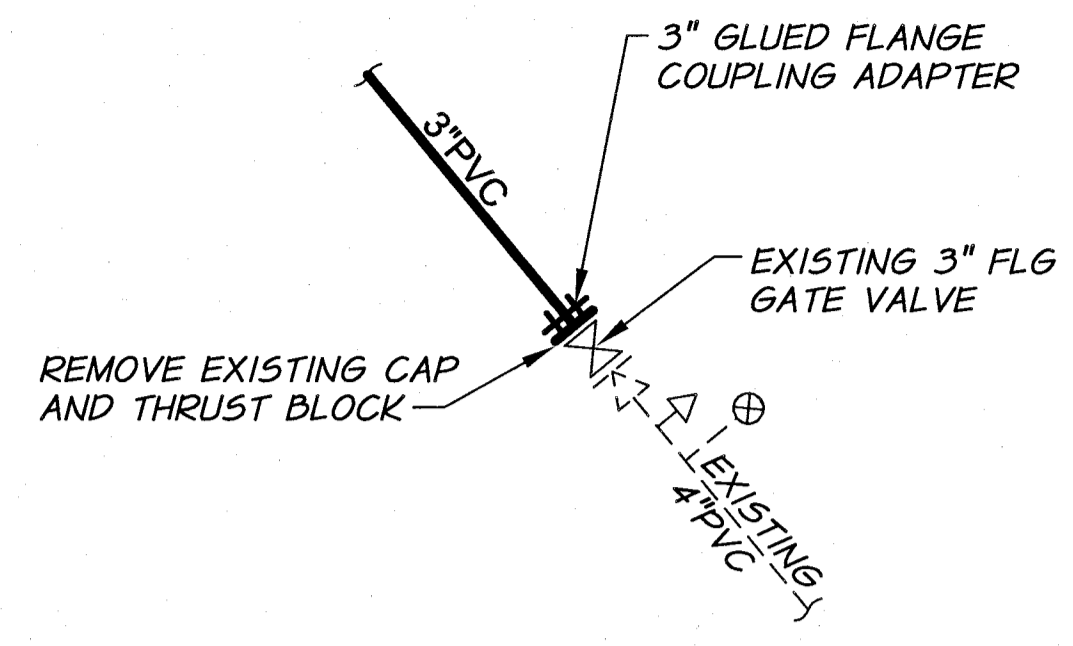


**DETAIL AA**  
REFERENCE SHEET: 3

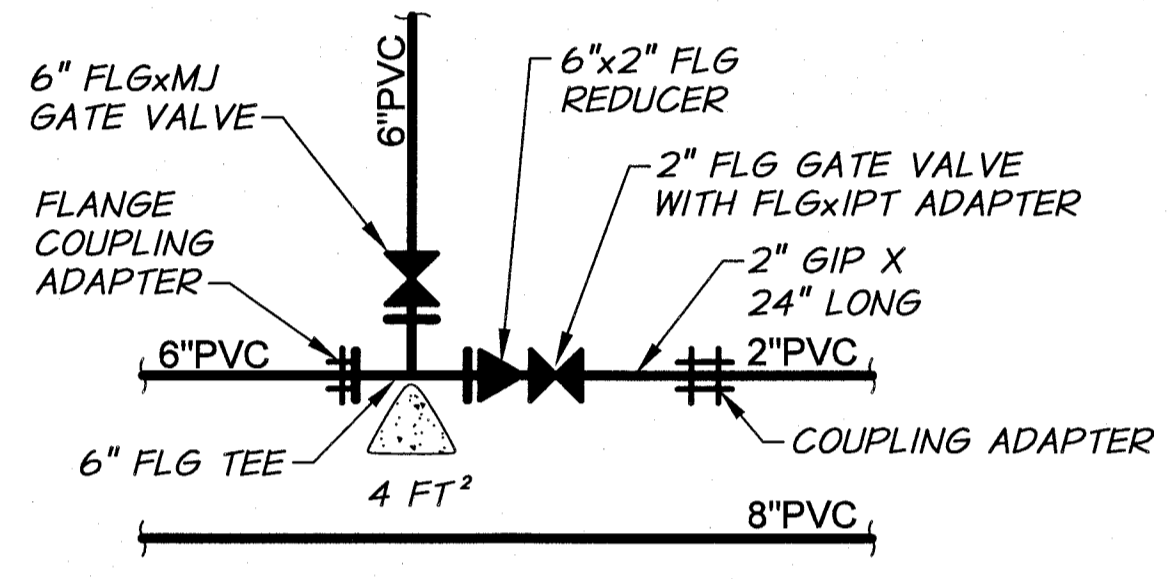


**DETAIL AE**  
REFERENCE SHEET: 4, 5

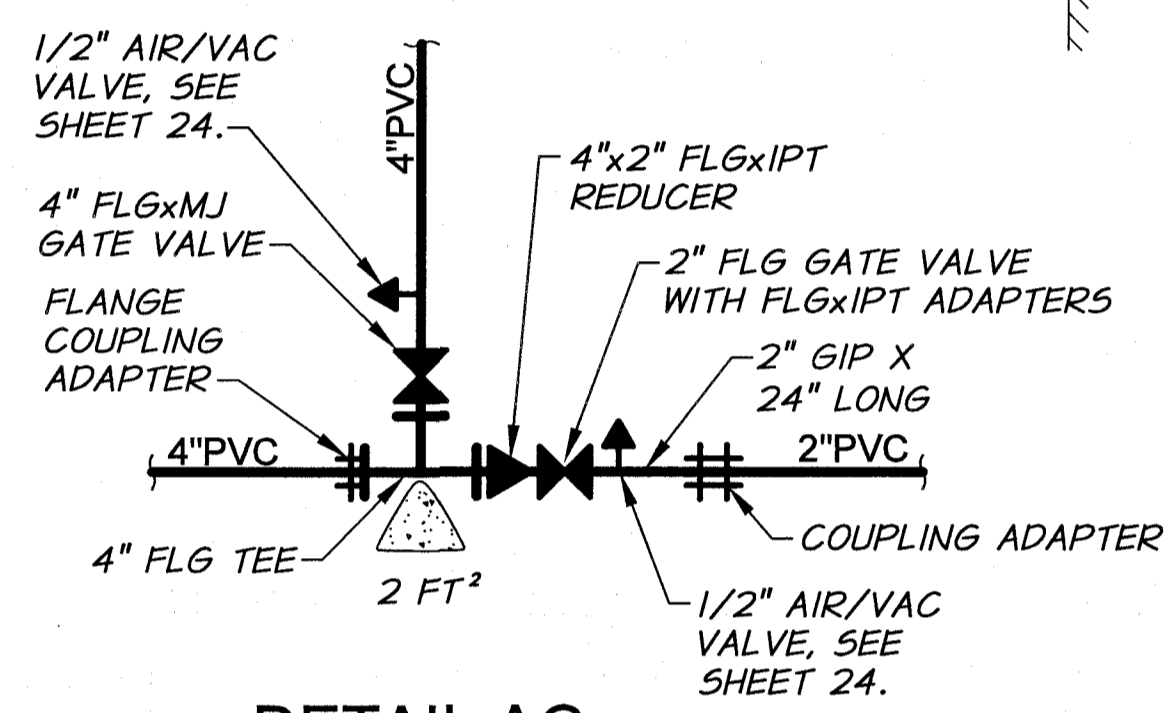


**DETAIL AG**  
REFERENCE SHEET: 6

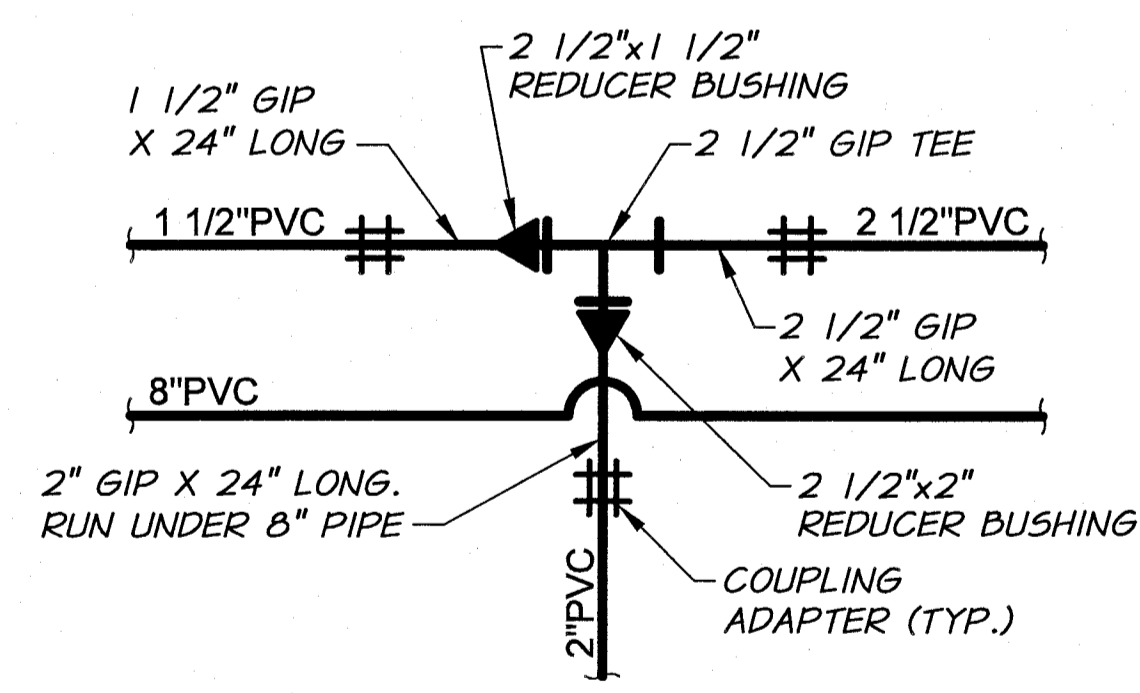


**DETAIL AF**  
REFERENCE SHEET: 4

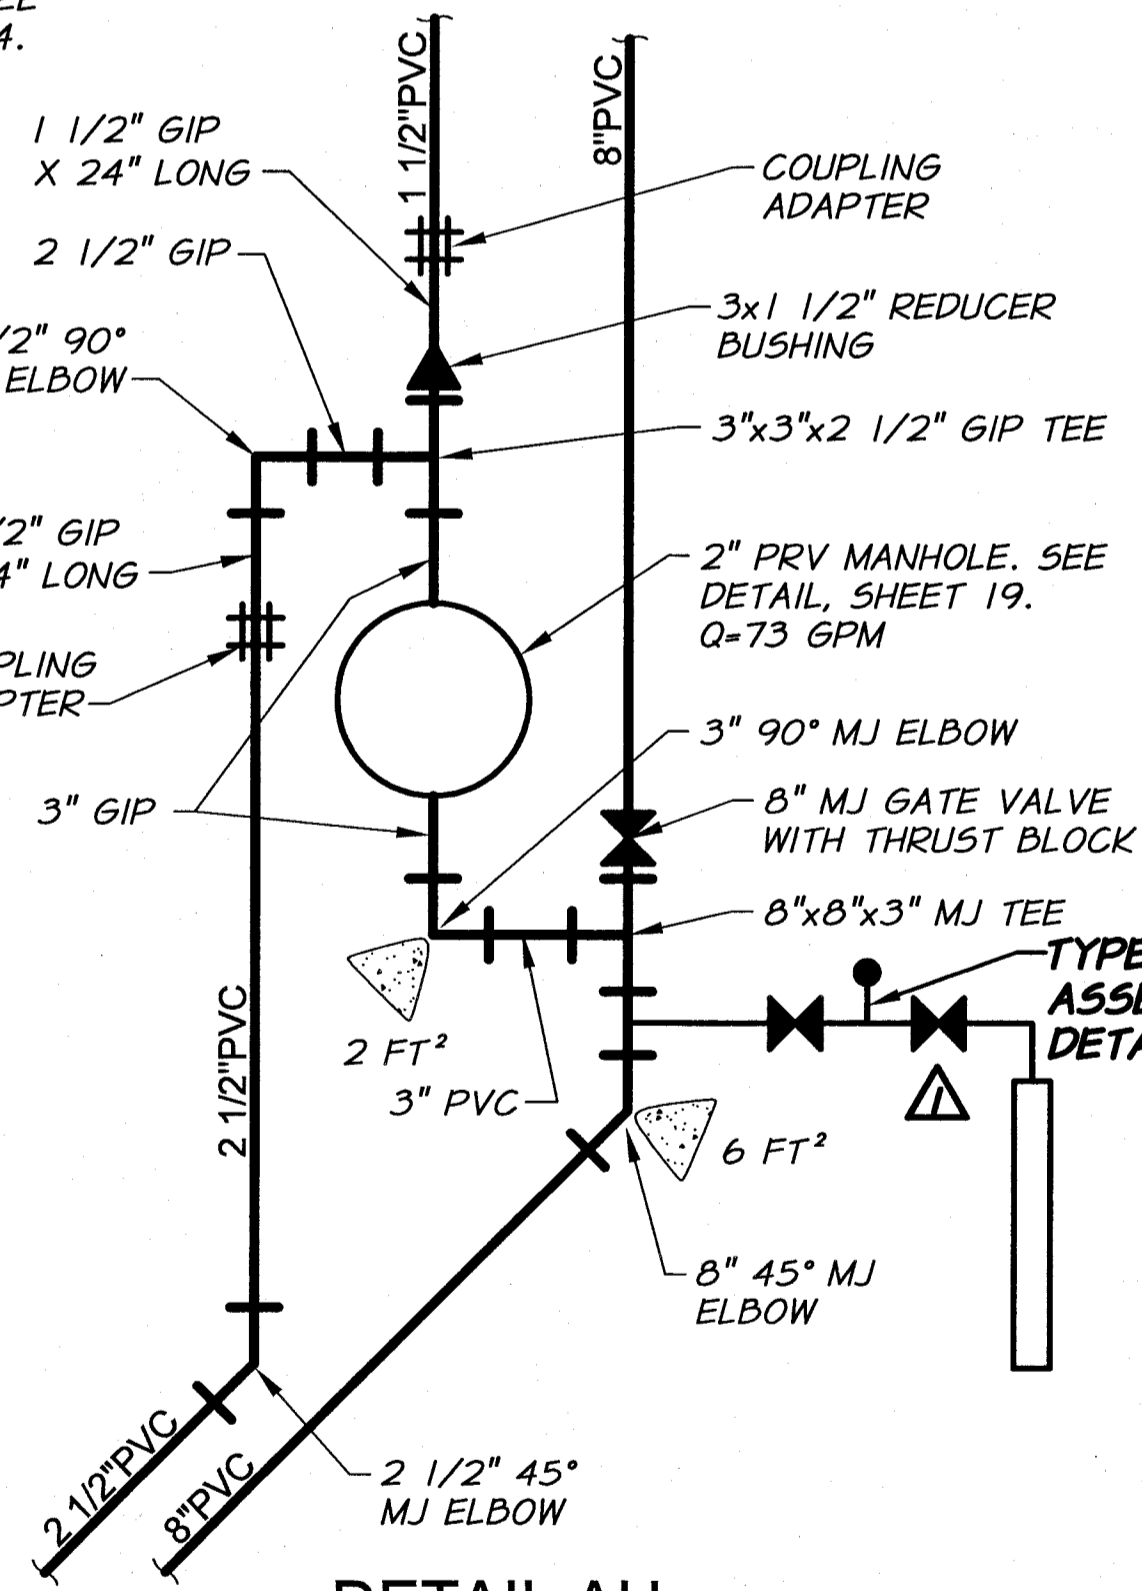


**DETAIL AH**  
REFERENCE SHEET: 4, 7

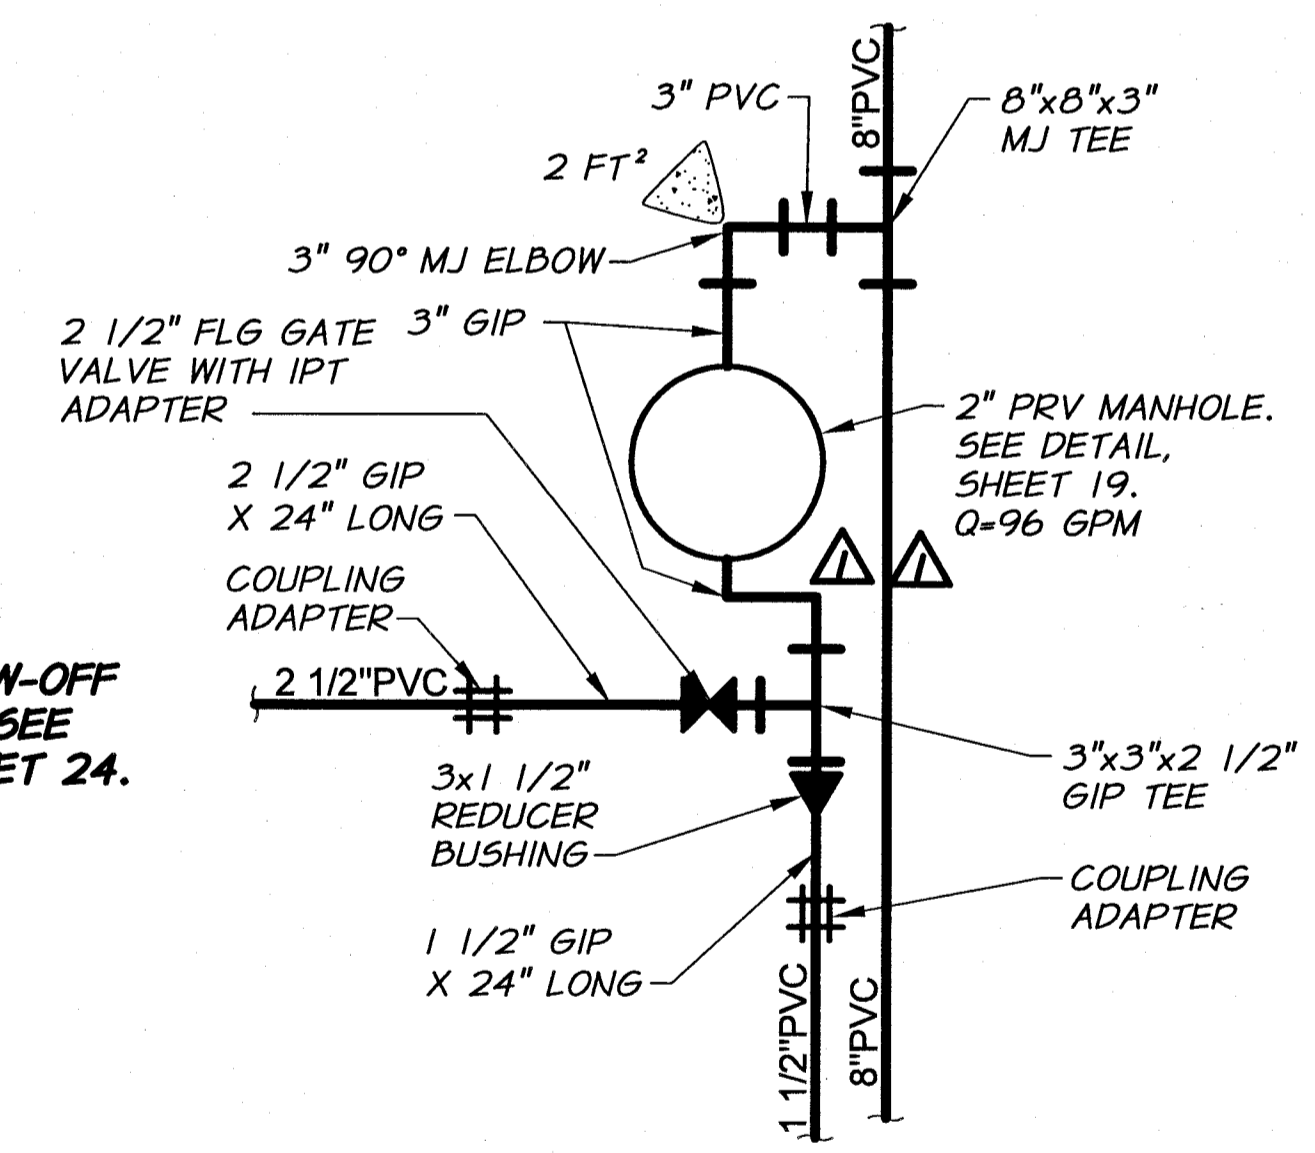

**DETAIL AJ**  
REFERENCE SHEET: 7

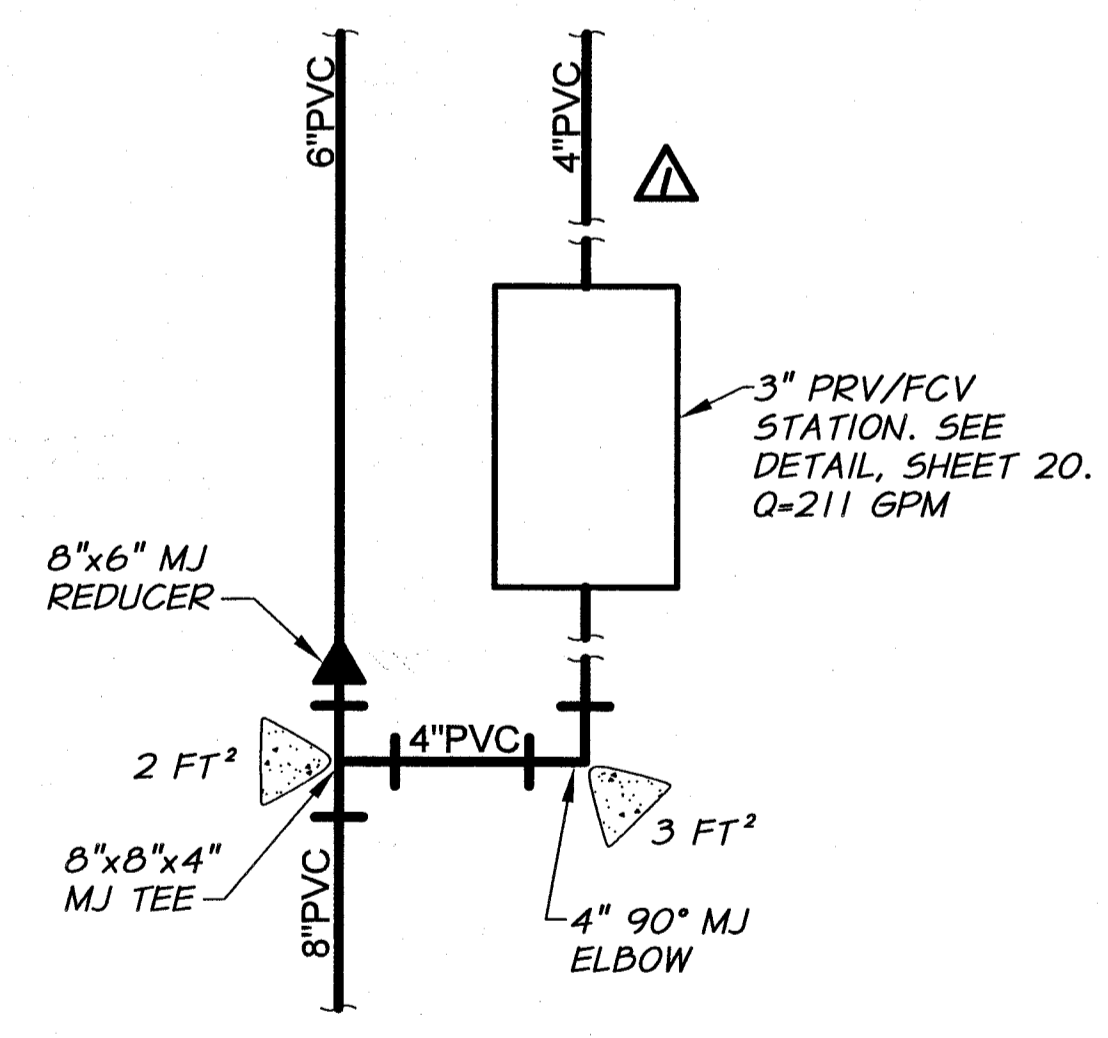


**DETAIL AK**  
REFERENCE SHEET: 7

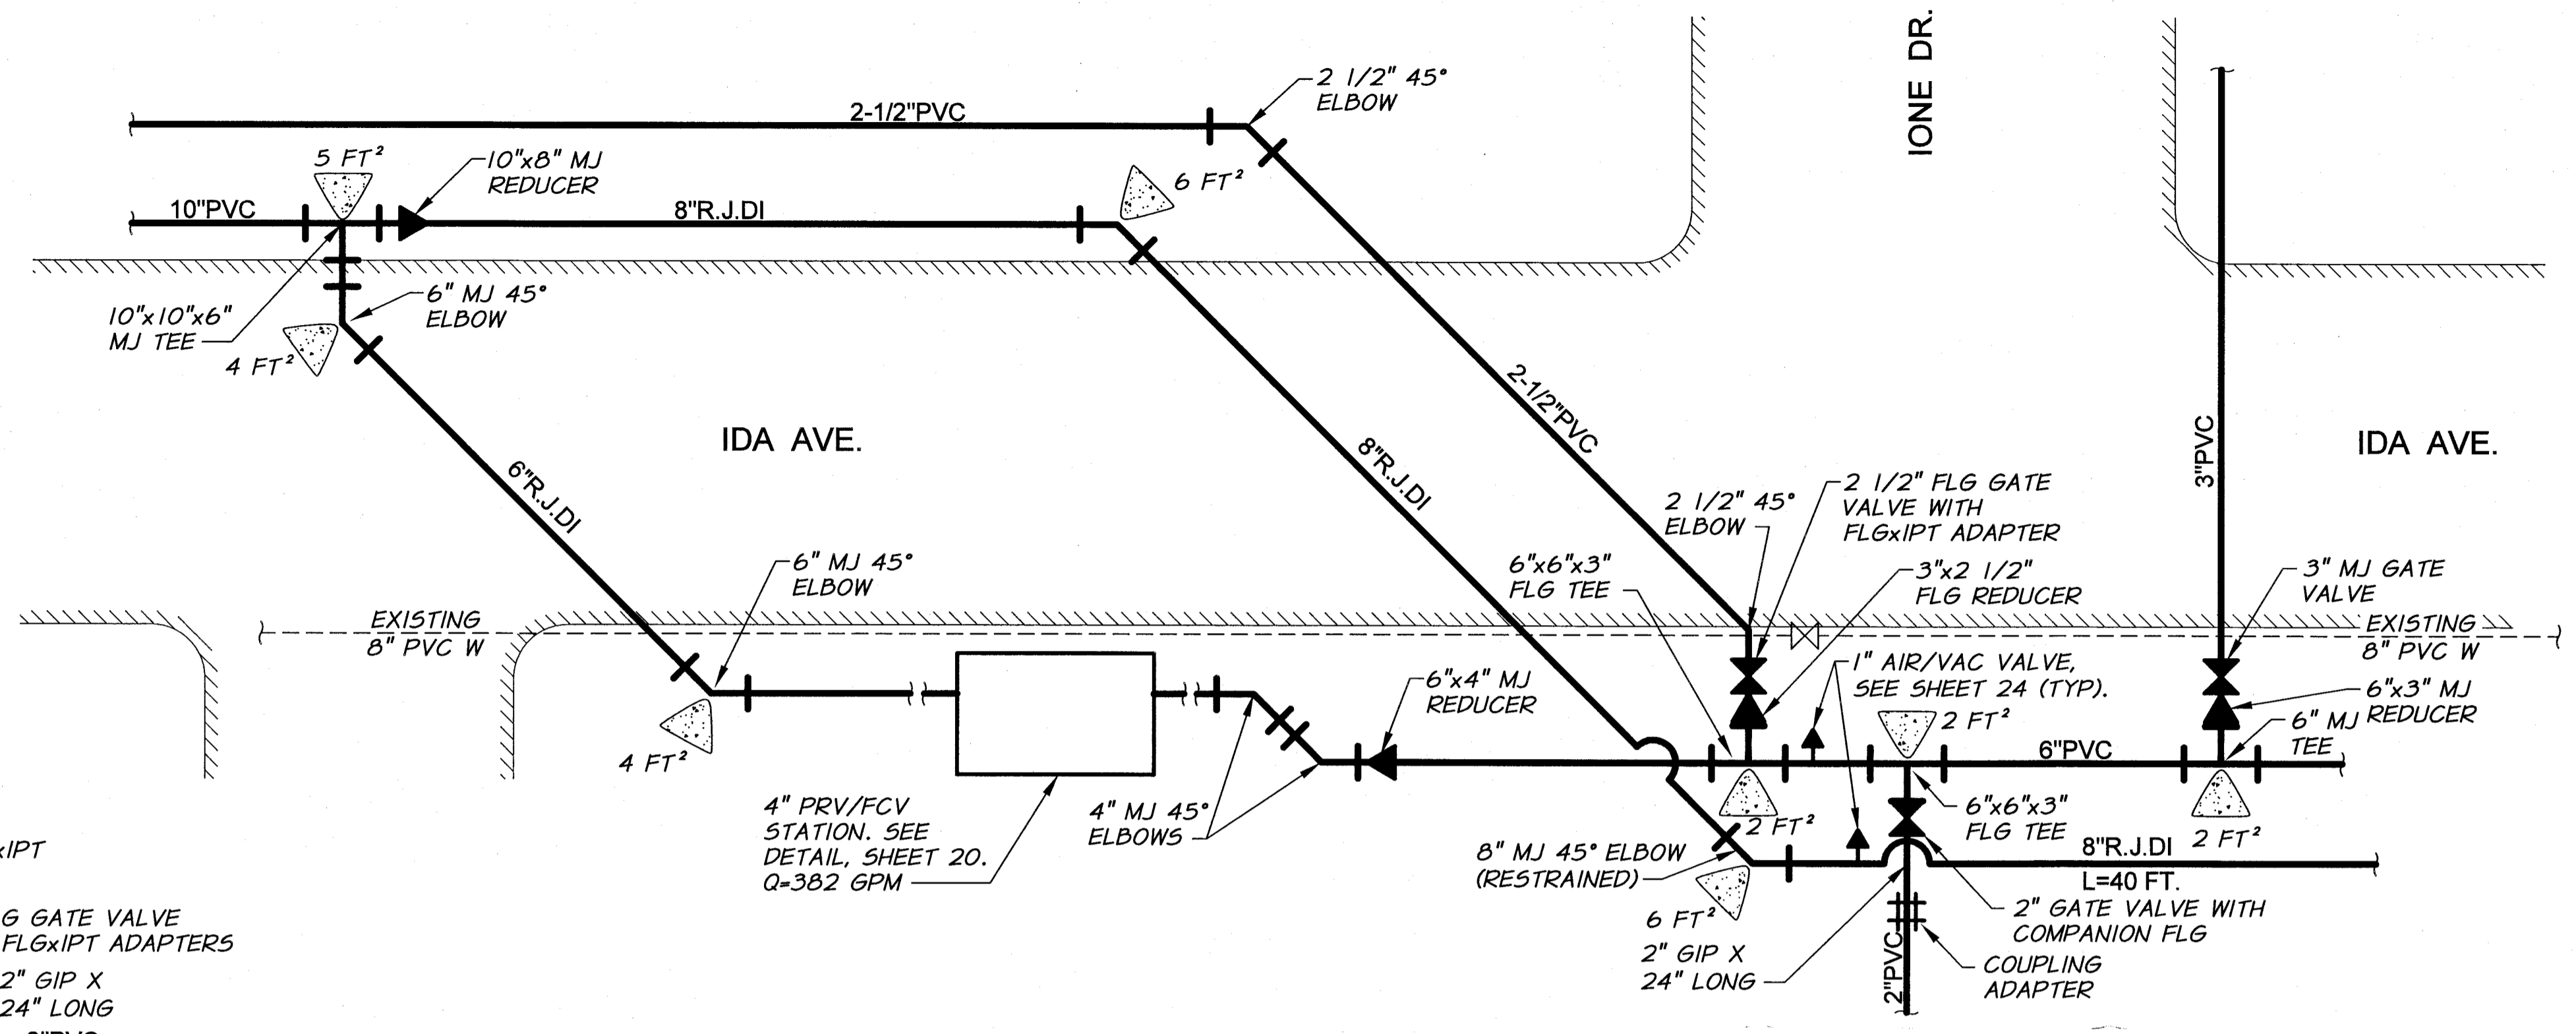


**DETAIL AC**  
REFERENCE SHEET: 4

**DELETED**  
**DETAIL AD**  
REFERENCE SHEET: 4

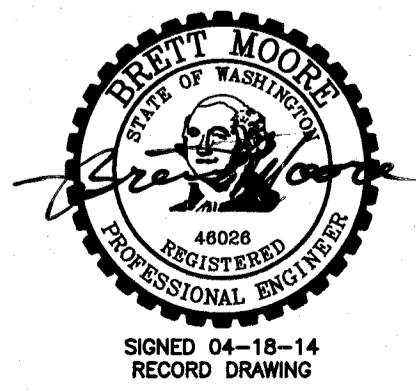


|   |              |              |                       |             |      |
|---|--------------|--------------|-----------------------|-------------|------|
| RECORD DRAWING                                  |              | BY           | B.M.                  | DATE        | 4/14 |
| DESIGNED BY                                     | H. MORRISON  | HORIZ. SCALE | NONE                  | VERT. SCALE |      |
| DRAWN BY  | D. CHRISTMAN | JOB NUMBER   | 1199-336              | DATE        | 2013 |
| REVIEWED BY                                     | B. MOORE     | ACAD FILE    | PipeConnDets-Ph3C.dwg |             |      |
| COPYRIGHT 2013 BY ANDERSON-PERRY & ASSOC., INC. |              |              |                       |             |      |

**RECORD DRAWINGS**  
APRIL 18, 2014  
These record drawings have been prepared, in part, on the basis of information compiled and furnished by others. They may contain some discrepancies and omissions, and do not necessarily represent "exact" field conditions. The Owner and the Engineer accept no responsibility for their accuracy.

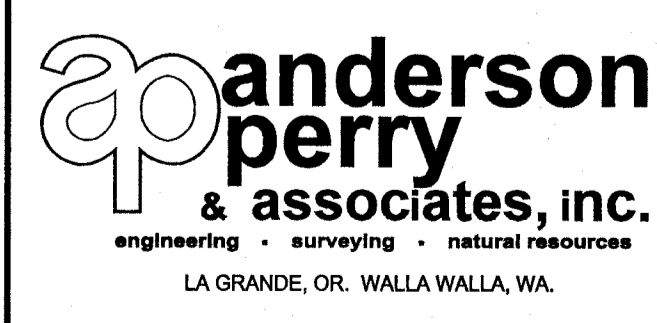


**BENTON IRRIGATION DISTRICT**  
IRRIGATION SYSTEM IMPROVEMENTS  
PHASE 3C  
PIPE CONNECTION DETAILS I




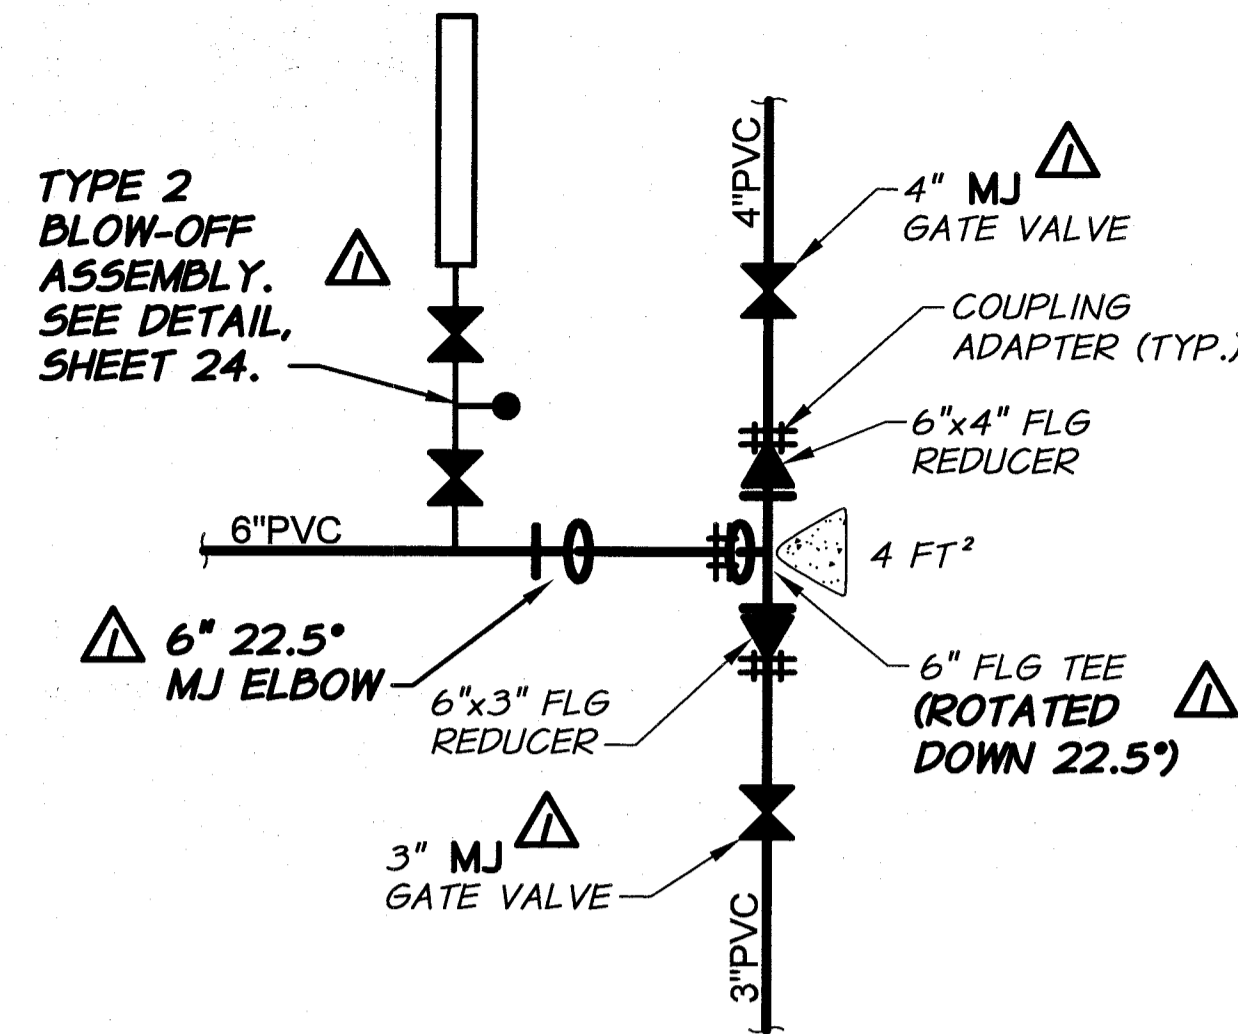


**DETAIL AU**  
REFERENCE SHEET: 10

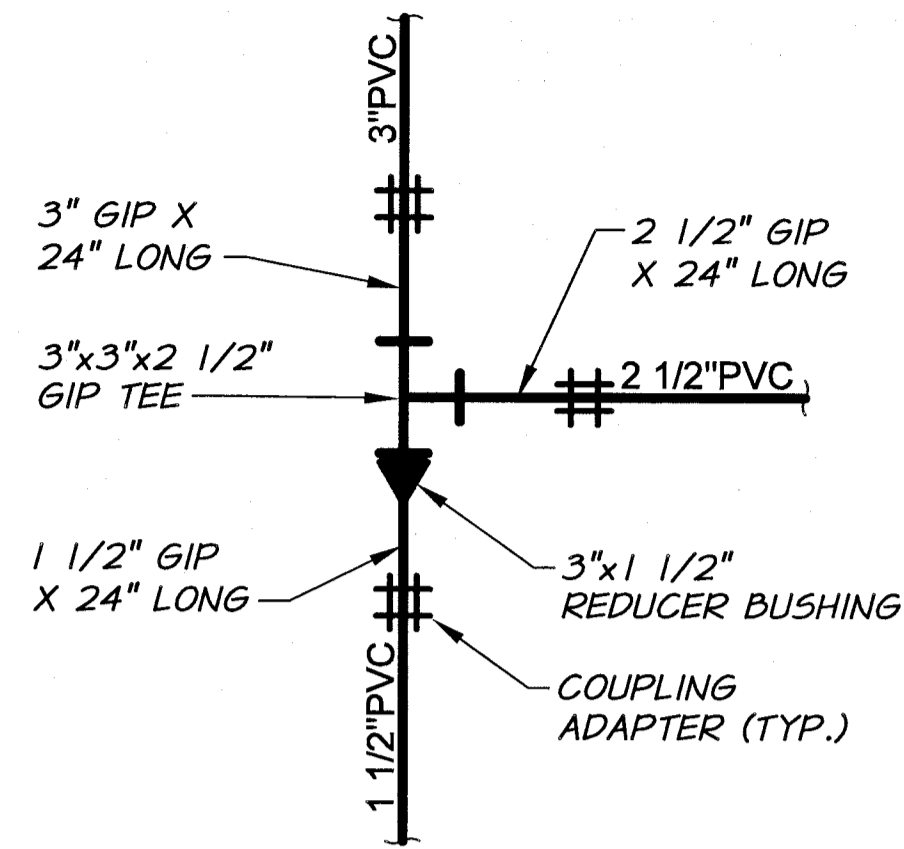


**DETAIL AV**  
REFERENCE SHEET: 10

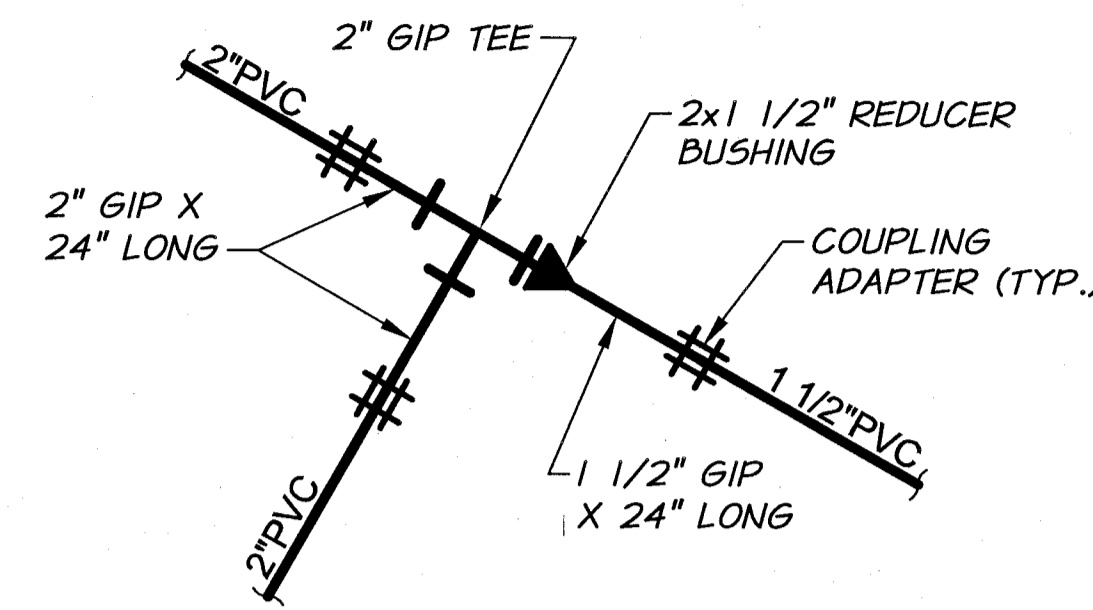

**DETAIL AW**  
REFERENCE SHEET: 10

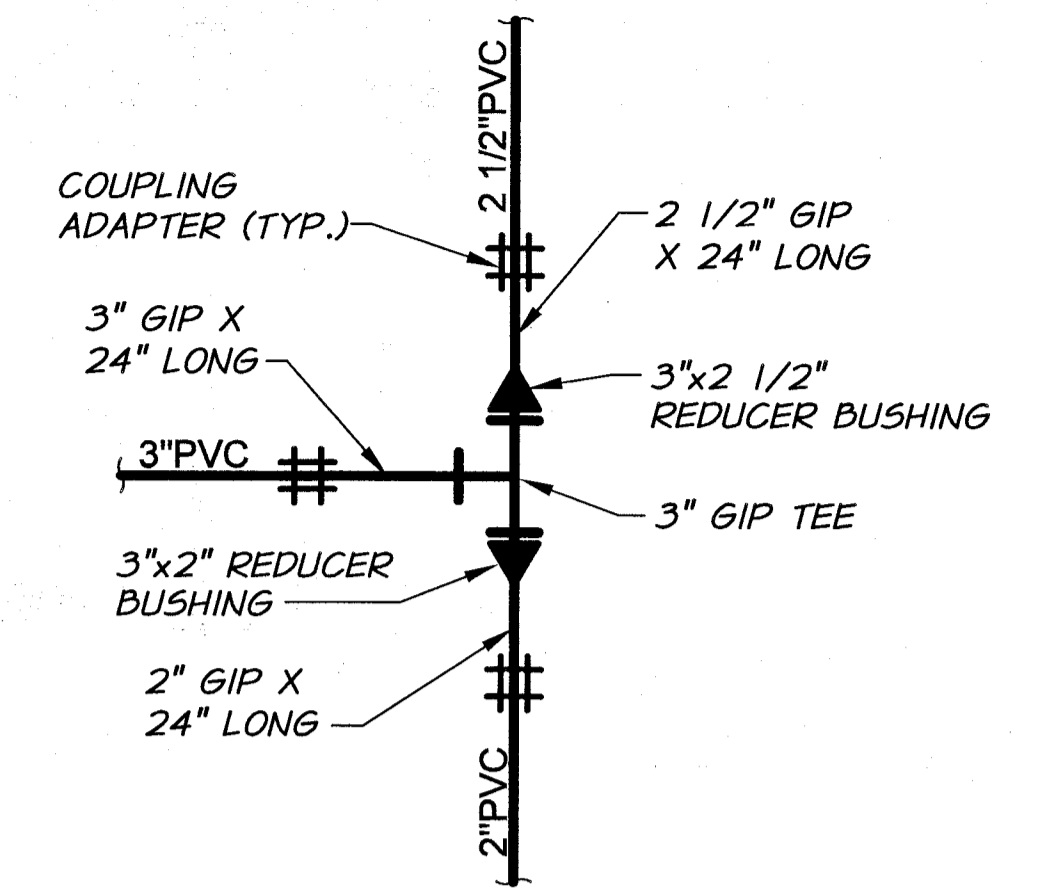

**DETAIL AX**  
REFERENCE SHEET: 11

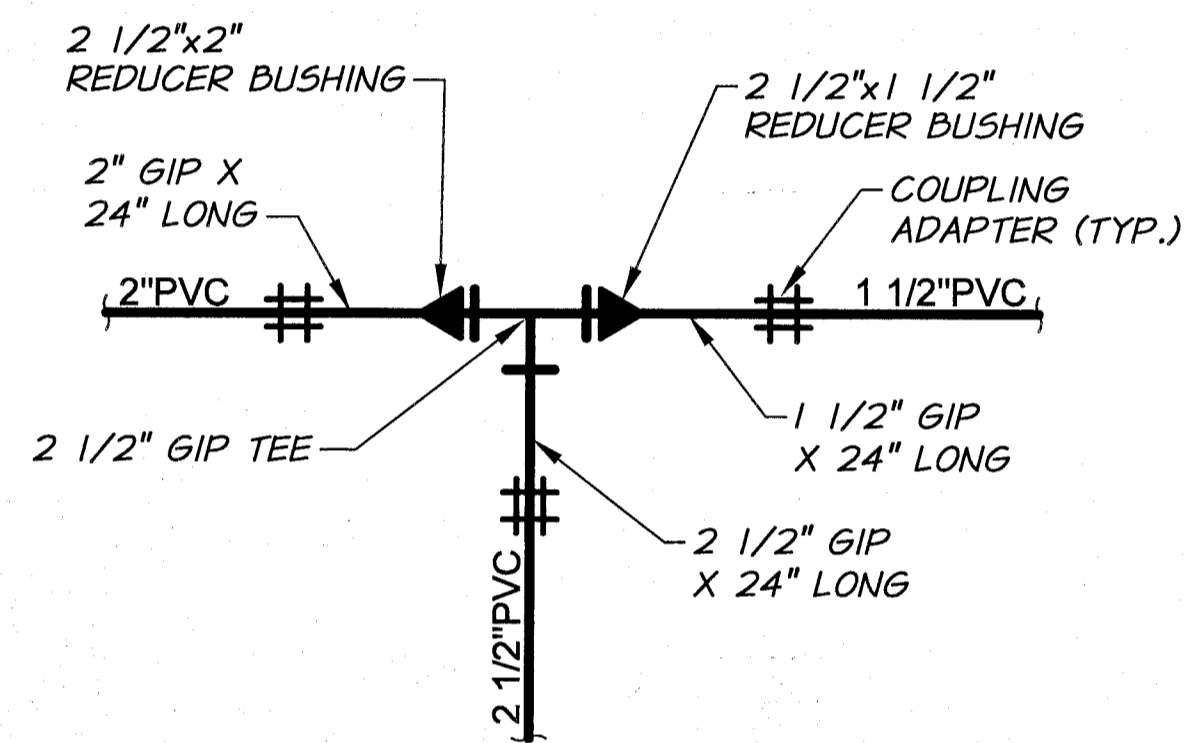

**DETAIL AY**  
REFERENCE SHEET: 11

DELETED


**DETAIL AZ**  
REFERENCE SHEET: 12

DELETED

**DETAIL BA**  
REFERENCE SHEET: 12

DELETED


**DETAIL BB**  
REFERENCE SHEET: 12

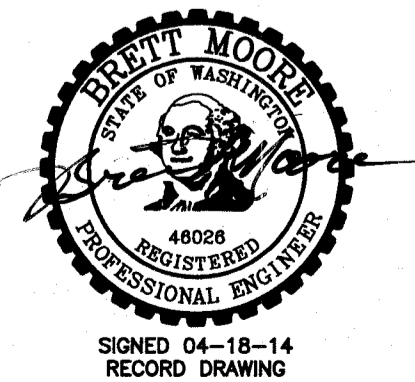

|                |              |   |          |      |      |              |                       |             |  |
|----------------|--------------|---|----------|------|------|--------------|-----------------------|-------------|--|
| RECORD DRAWING |              | BY  | B.M.     | DATE | 4/14 | HORIZ. SCALE | NONE                  | VERT. SCALE |  |
| DESIGNED BY    | H. MORRISON  | JOB NUMBER                                      | 1199-336 | DATE | 2013 | ACAD FILE    | PipeConnDets-Ph3C.dwg |             |  |
| DRAWN BY       | D. CHRISTMAN | COPYRIGHT 2013 BY ANDERSON-PERRY & ASSOC., INC. |          |      |      |              |                       |             |  |
| REVIEWED BY    | B. MOORE     |   |          |      |      |              |                       |             |  |

**RECORD DRAWINGS**  
APRIL 18, 2014

These record drawings have been prepared, in part, on the basis of information compiled and furnished by others. They may contain some discrepancies and omissions, and do not necessarily represent "exact" field conditions. The Owner and the Engineer accept no responsibility for their accuracy.

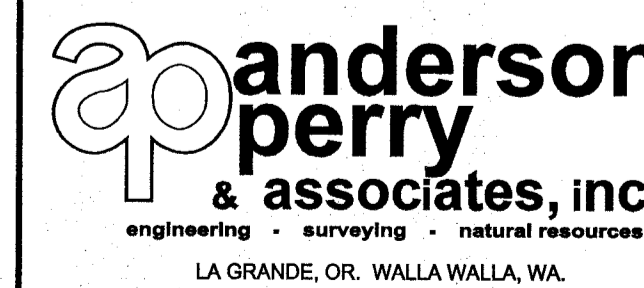


**BENTON IRRIGATION DISTRICT**  
IRRIGATION SYSTEM IMPROVEMENTS  
PHASE 3C


PIPE CONNECTION DETAILS III

SHEET



15

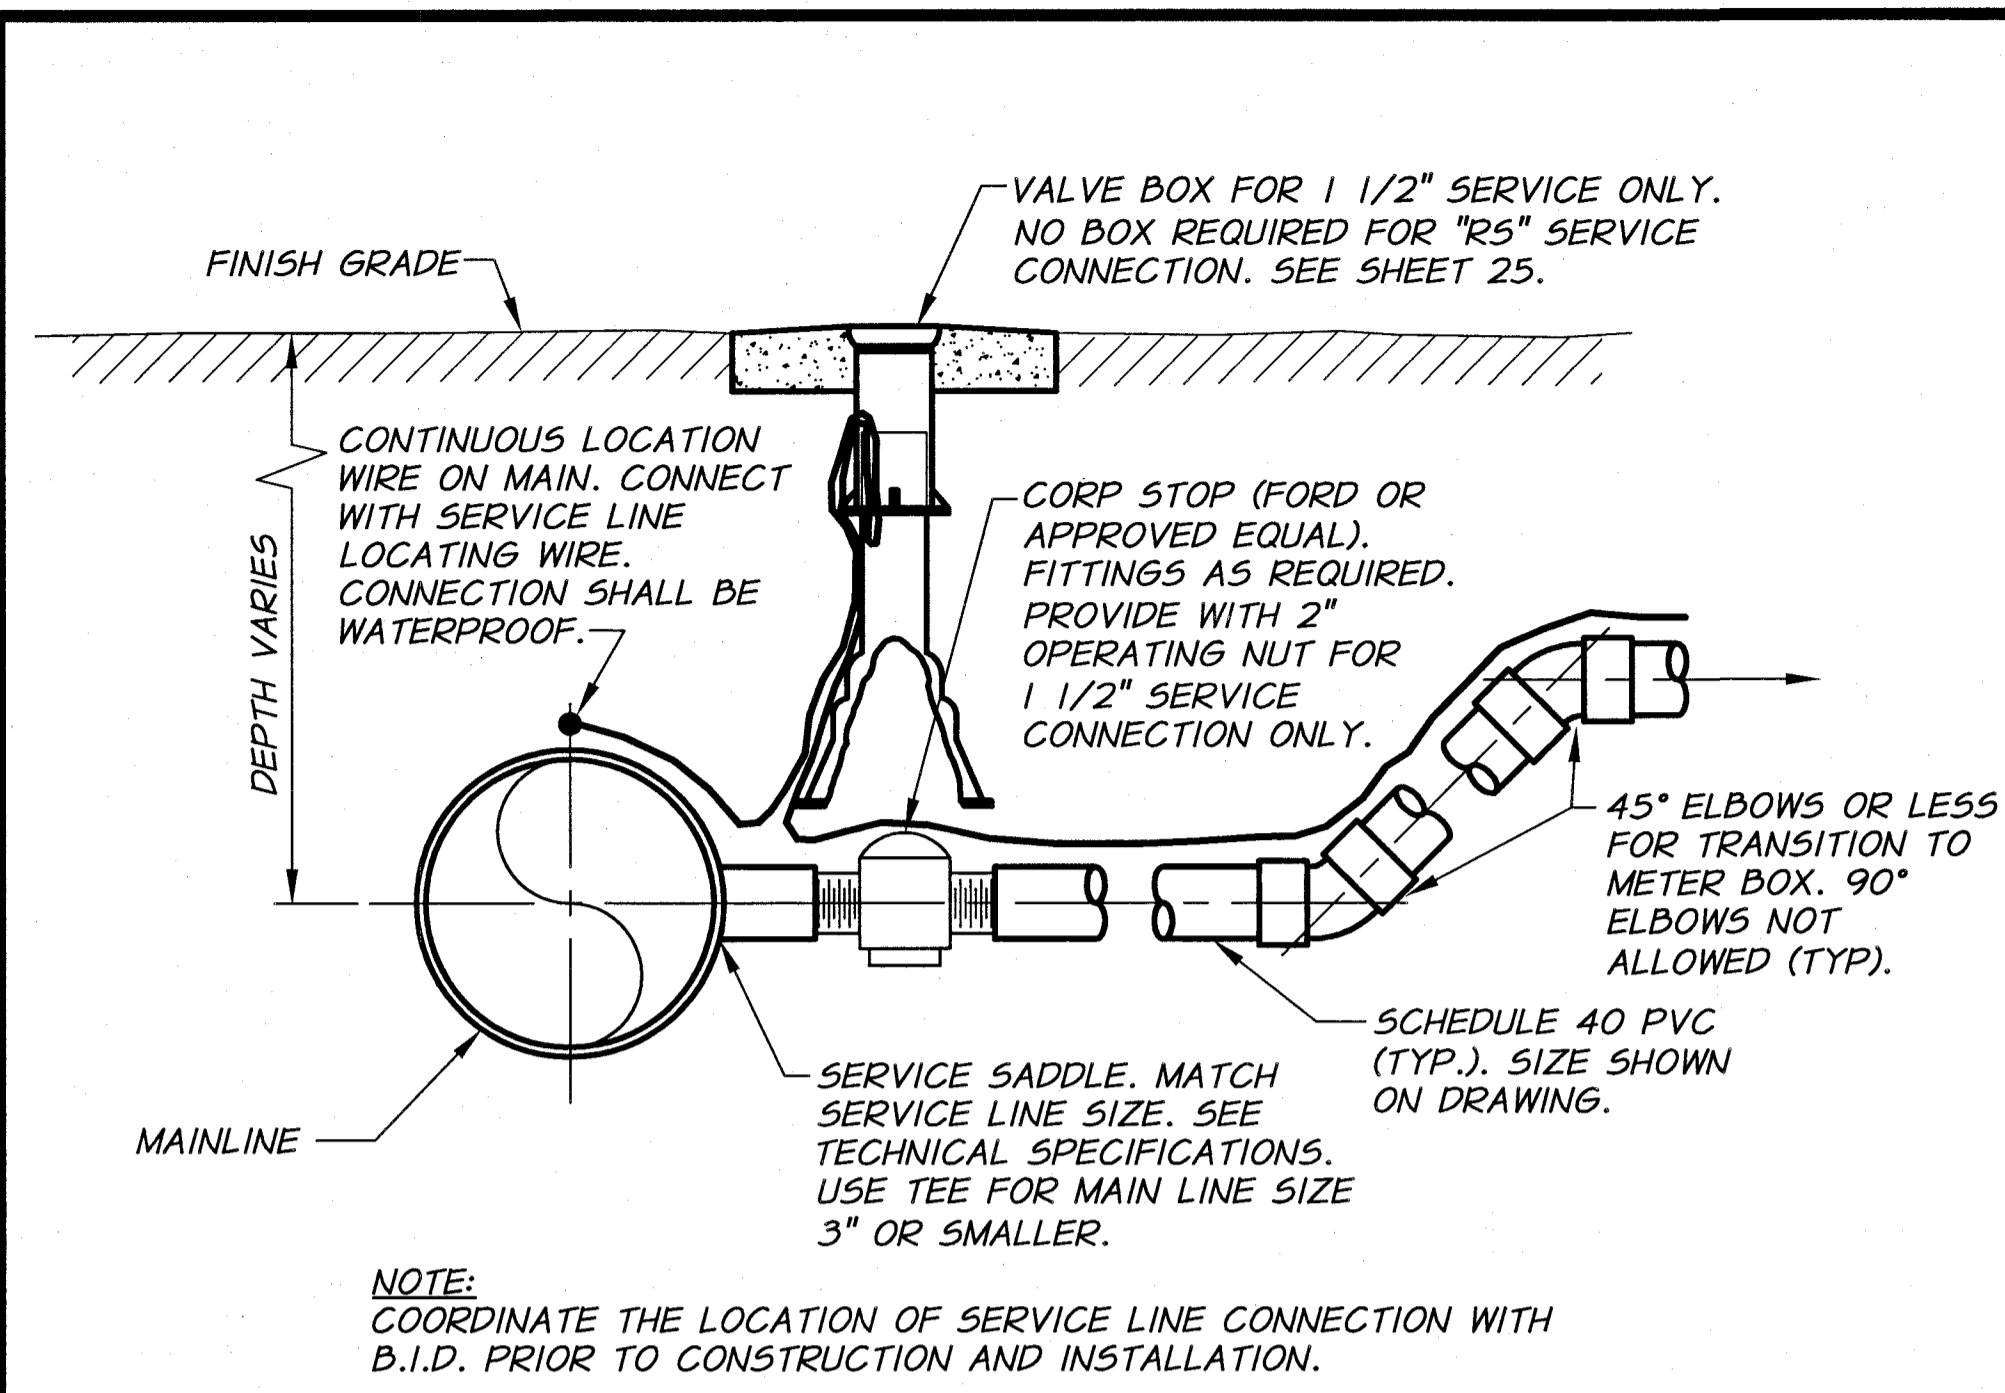


**MAIN LINE SERVICE CONNECTION**  
FOR "RS" AND 1 1/2" SERVICE  
N.T.S.

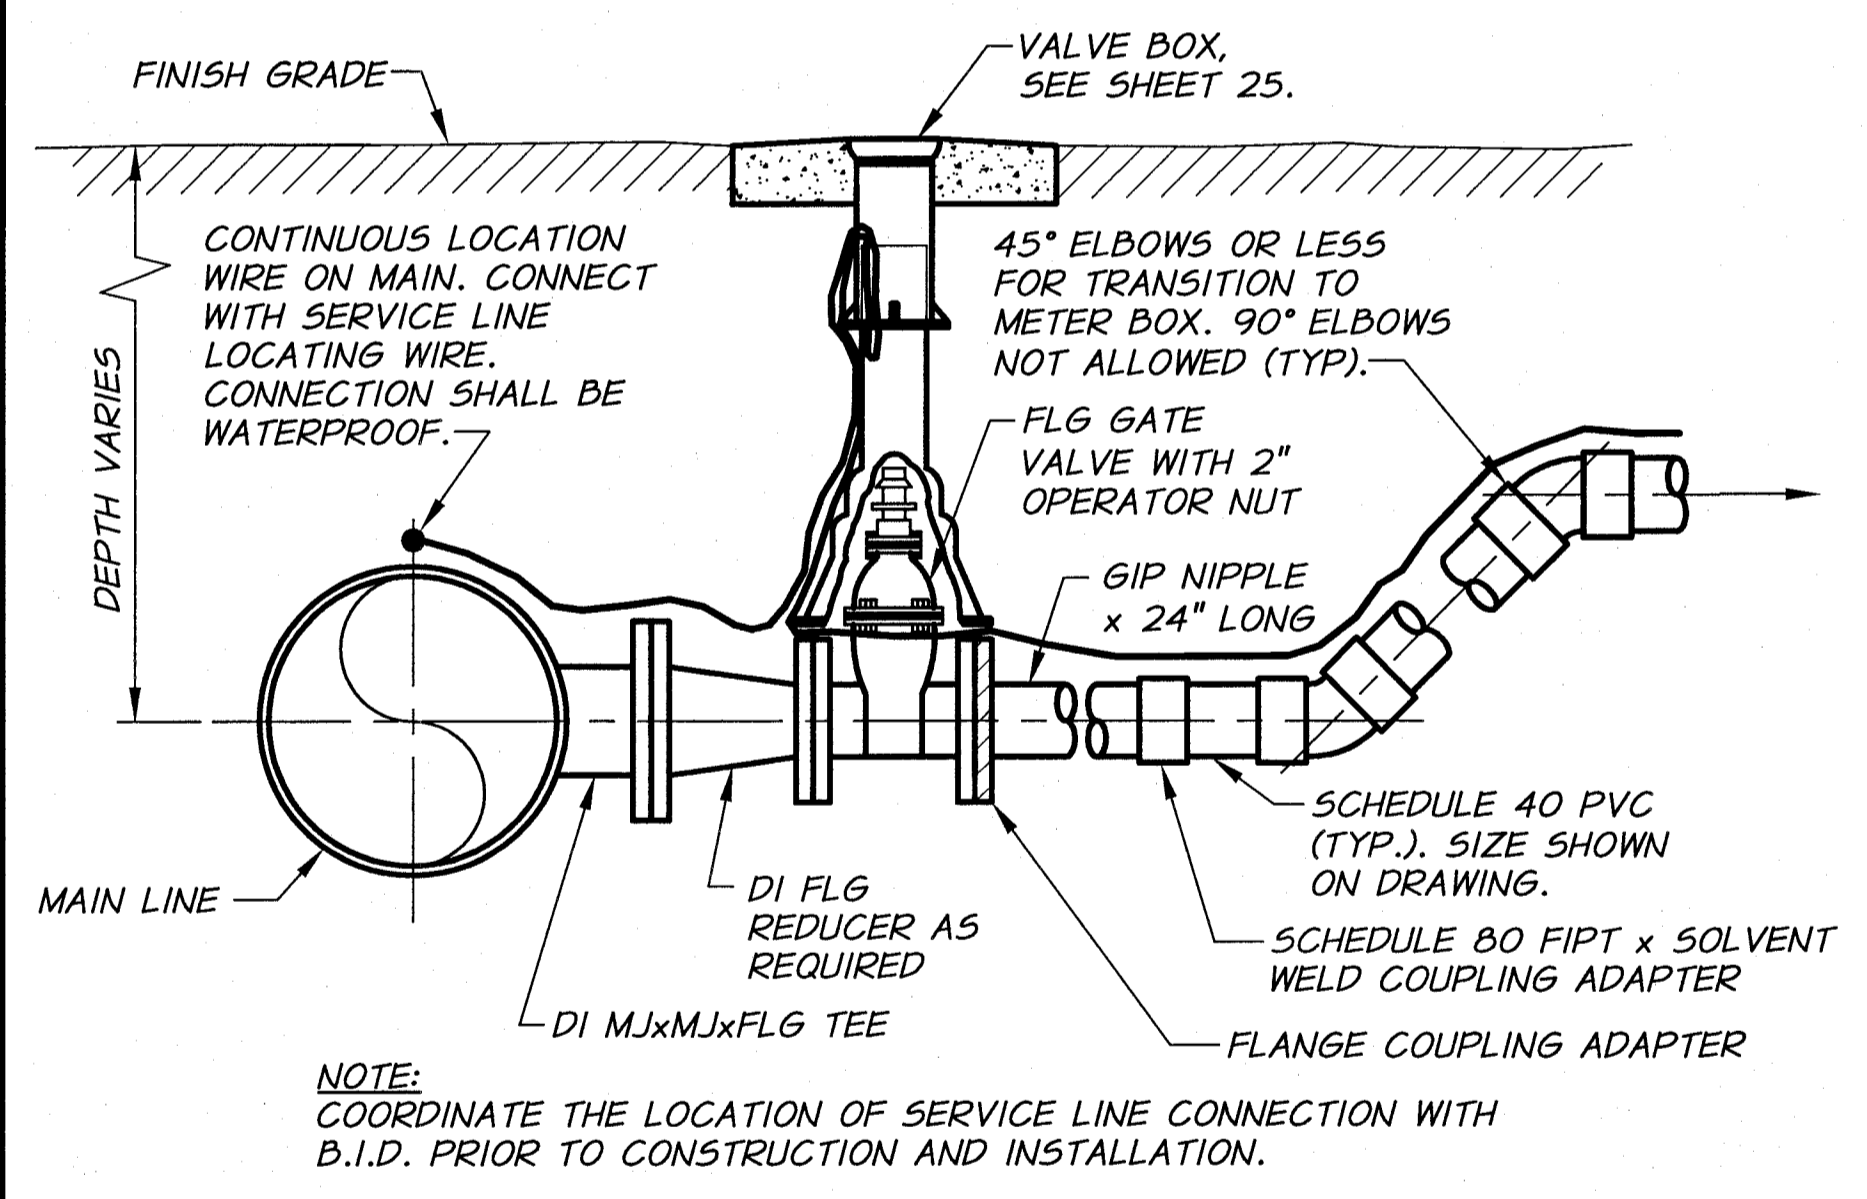

**MAIN LINE SERVICE CONNECTION**  
FOR 2" AND 3" SERVICE  
N.T.S.

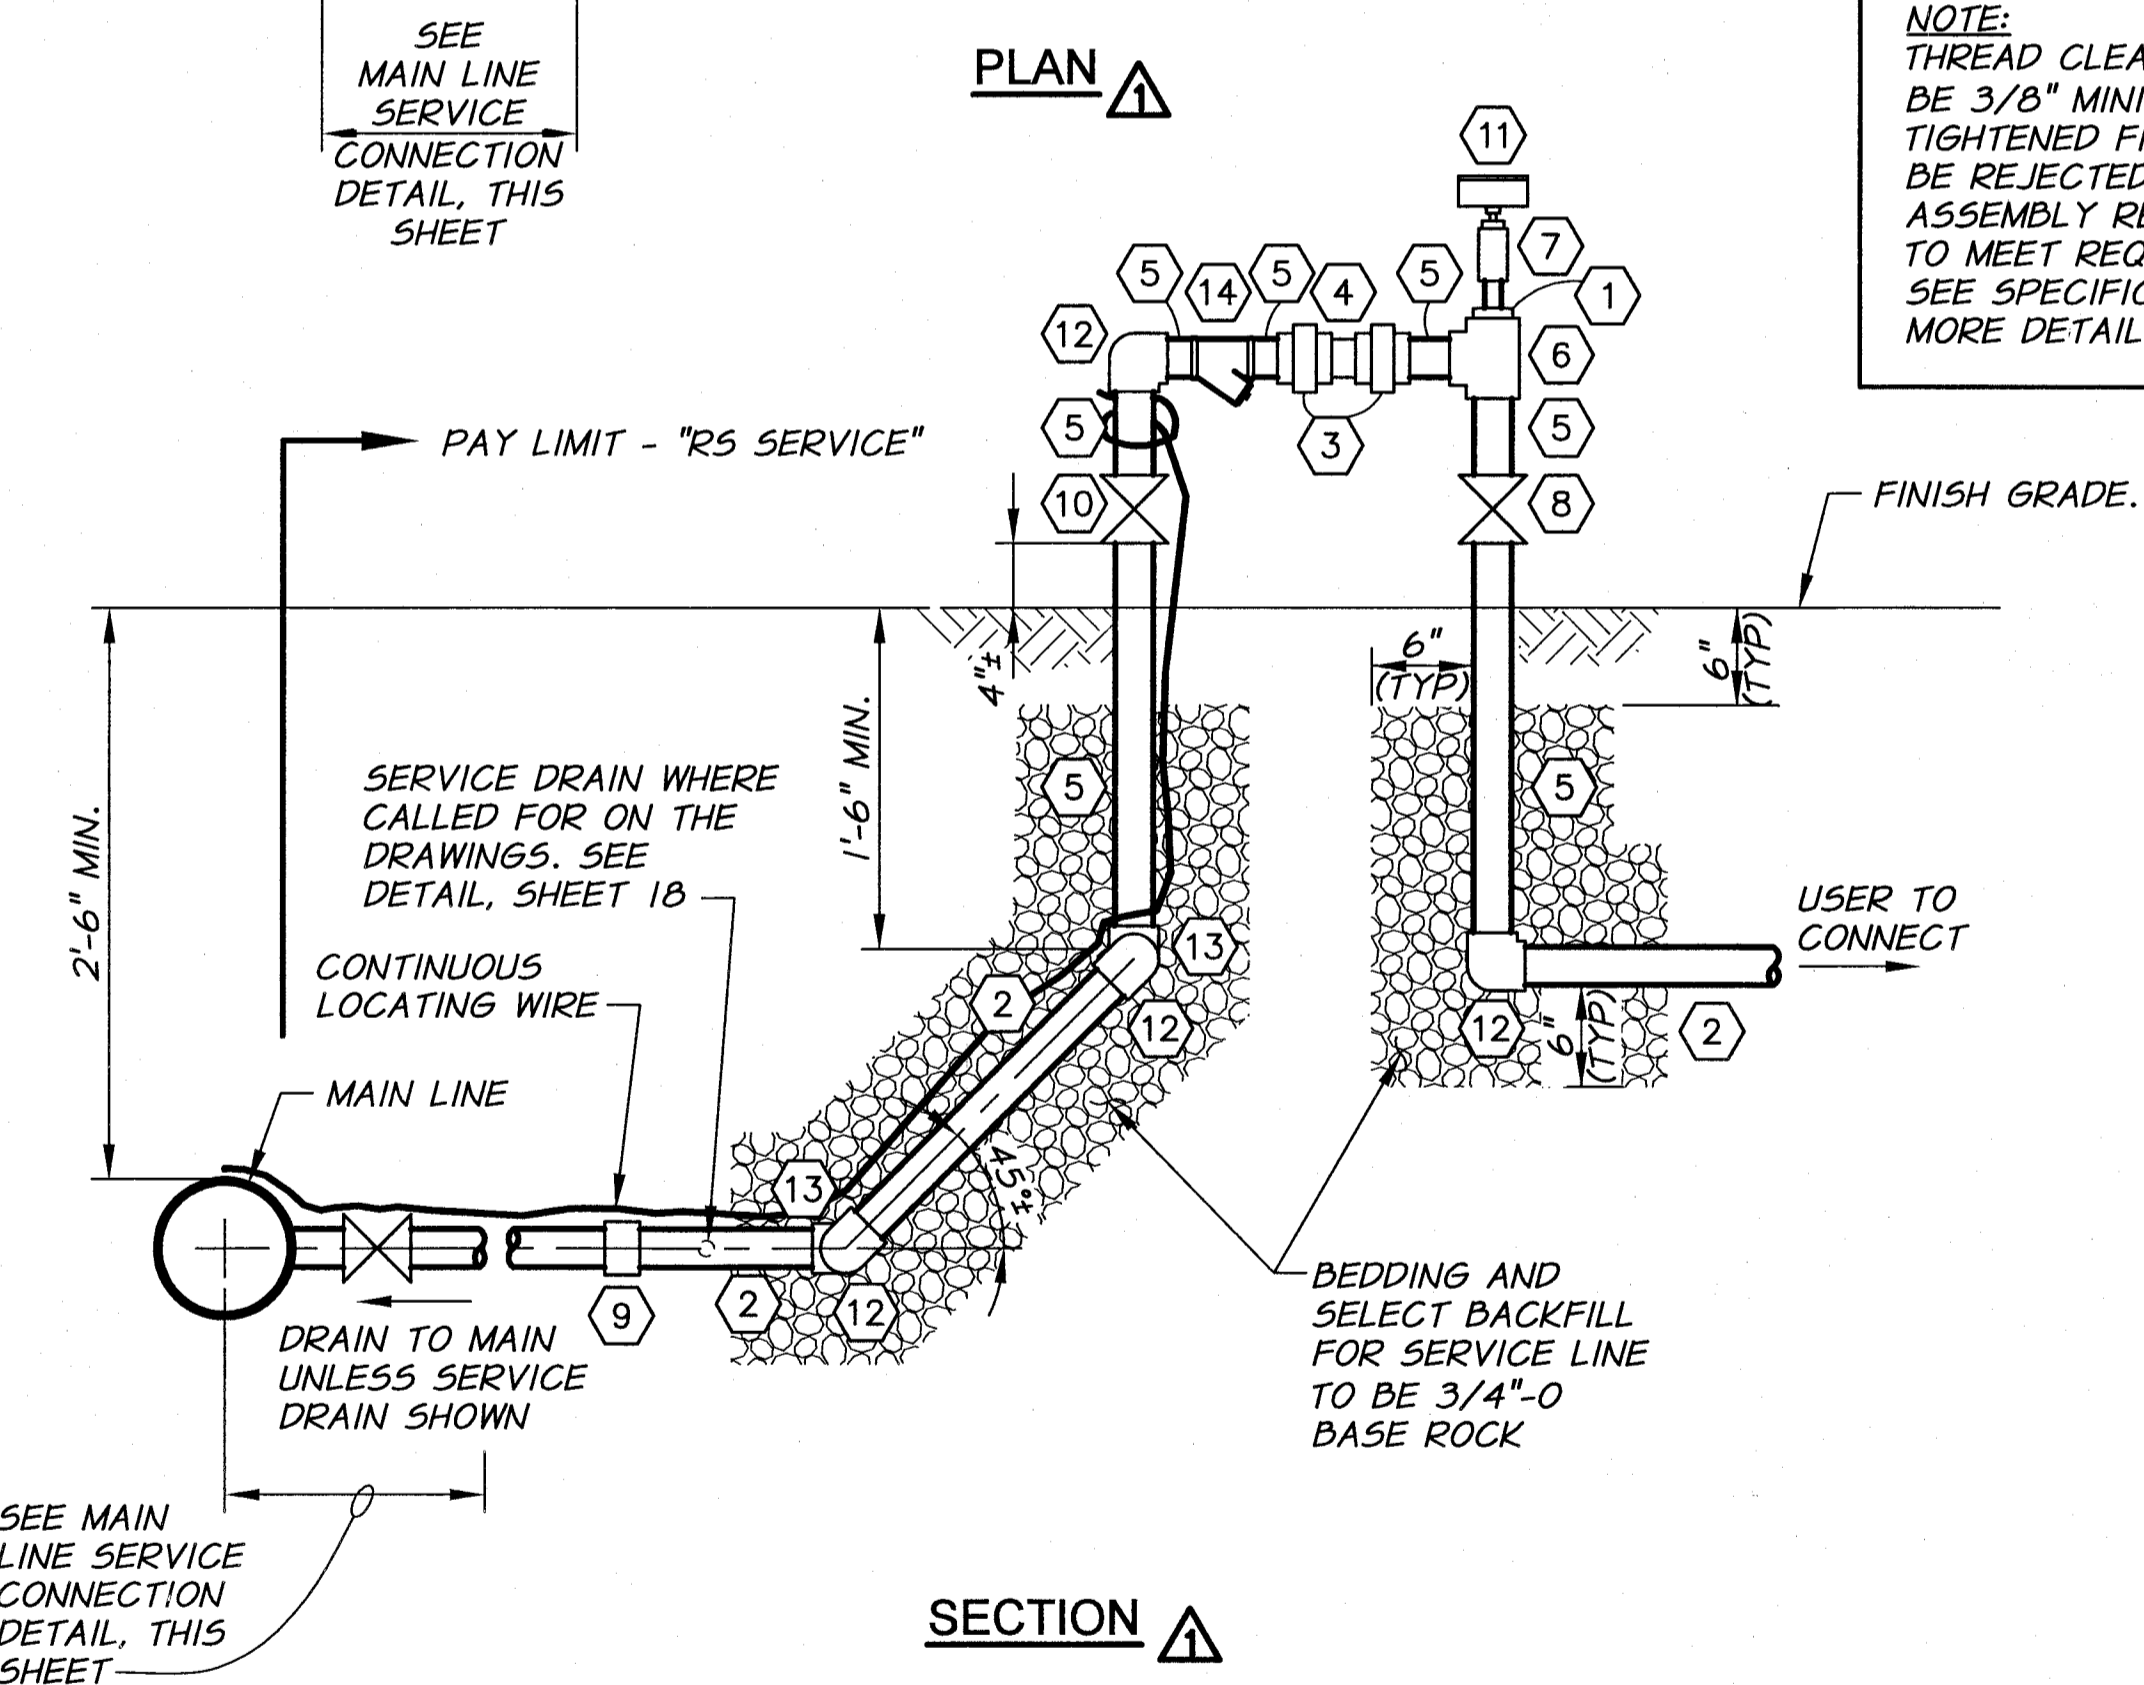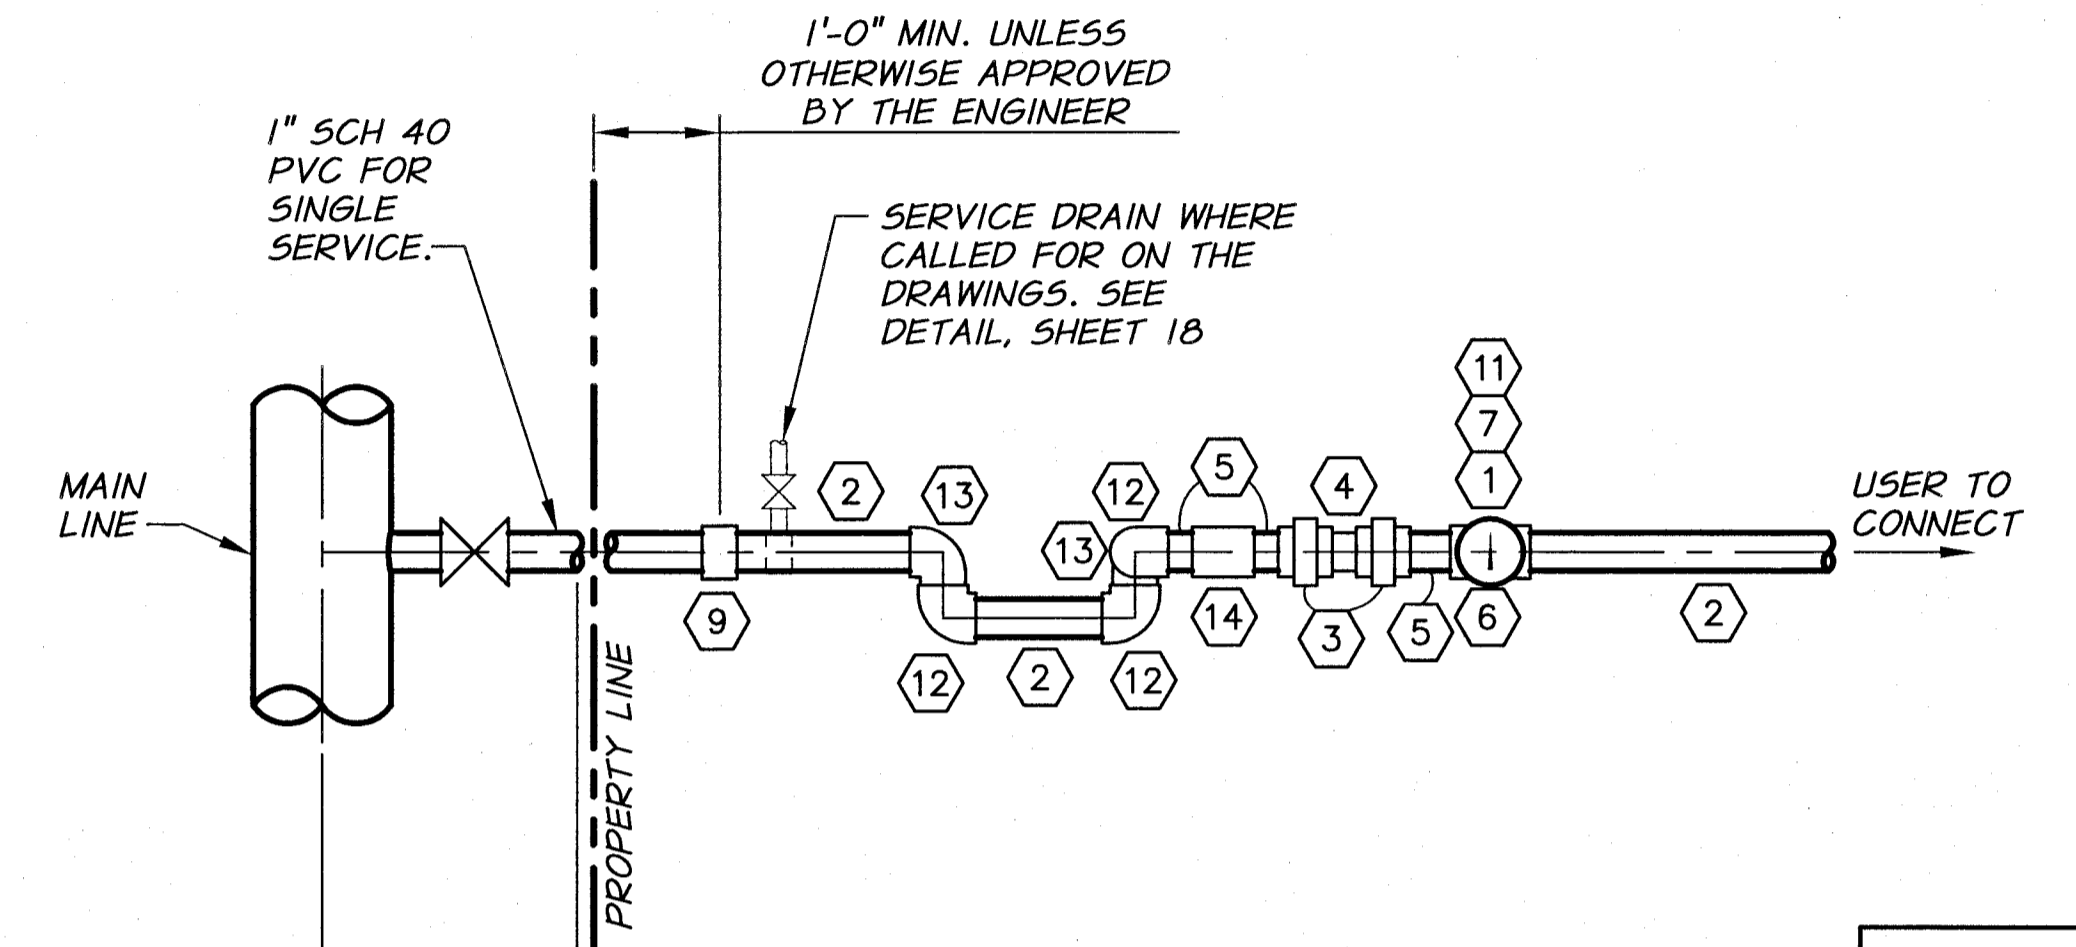

**TYPICAL "RS" SERVICE DETAIL**  
N.T.S.

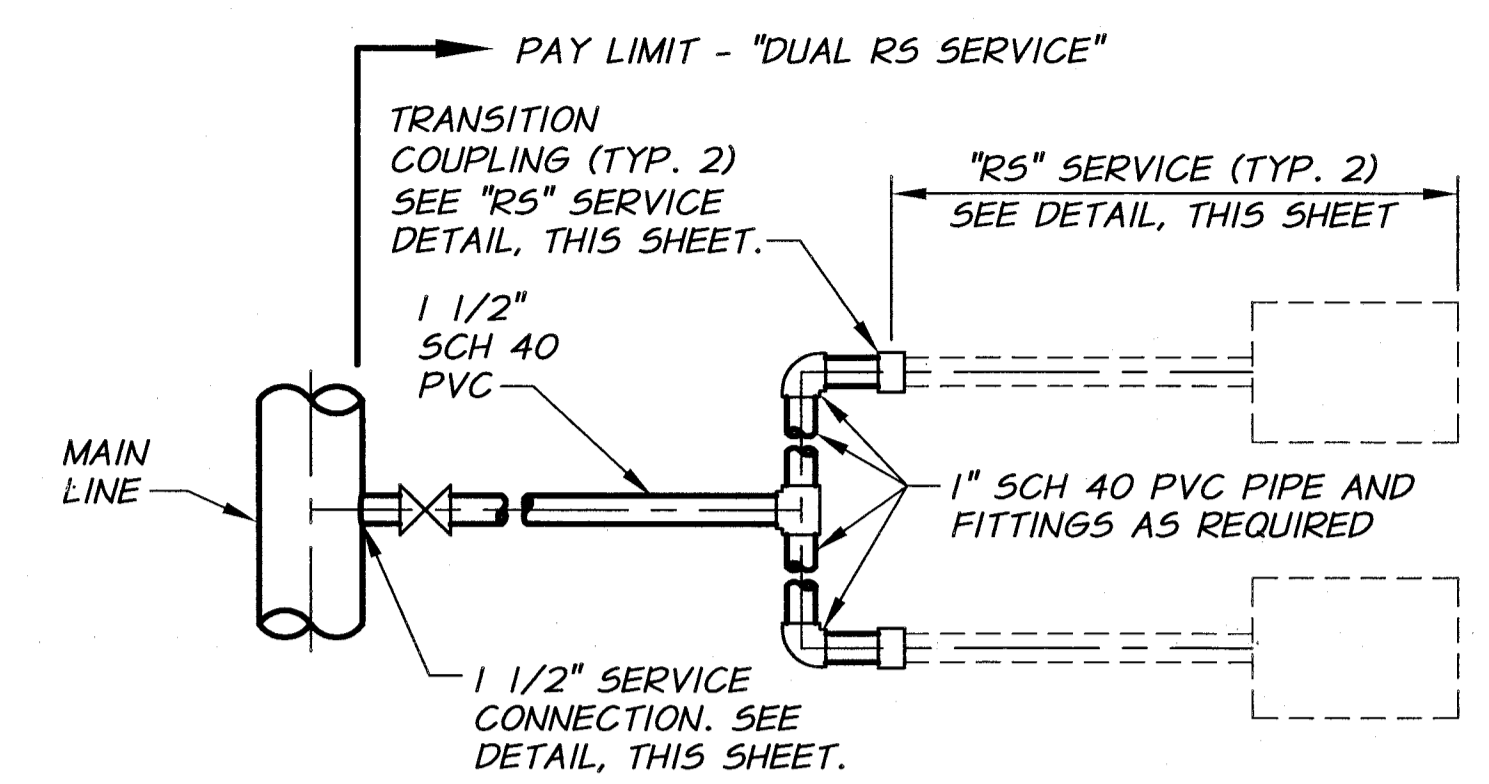

**DUAL "RS" SERVICE DETAIL**  
N.T.S.

**SERVICE FITTING SCHEDULE**


- ① 1" X 3/4" BUSHING
- ② 1" SCH. 40 G.I.P. PIPE, 12" MIN. LENGTH
- ③ 1" G.I.P. UNION
- ④ 1" DOLE FLOW CONTROL VALVE. SIZE AS SHOWN ON PLANS. INSTALL WITH FLOW RATE LABEL FACING UPWARDS AND NO WRENCH MARKS ON VALVE.
- ⑤ 1" THREADED SCH. 40 G.I.P. SPOOL, LENGTH AS REQUIRED.
- ⑥ 1" G.I.P. TEE
- ⑦ 3/4" THREADED BRASS BALL VALVE WITH 3/4"x1/4" BUSHING AND BRASS QUICK COUPLING PLUG (UNVALVED)
- ⑧ BRASS GATE VALVE
- ⑨ SCH 80 PVC TRANSITION COUPLING AND FITTINGS AS REQ'D. FEMALE CONNECTION TO GIP.
- ⑩ CORP STOP WITH PADLOCK WING
- ⑪ OWNER SUPPLIED GAUGE
- ⑫ 1" 90° GIP ELBOW
- ⑬ 1" 90° GIP STREET ELBOW
- ⑭ Y-STRAINER WITH TAPPED CAP AND BLOW-OFF PLUG

- NOTES:**
1. COORDINATE THE LOCATION OF SERVICE WITH B.I.D. PRIOR TO CONSTRUCTION AND INSTALLATION.
  2. ALL BURIED GALVANIZED PIPE SHALL BE TAPE WRAPPED PER TECHNICAL SPECIFICATIONS.




|   |              |      |              |                      |
|---|--------------|------|--------------|----------------------|
| REVISION  | BY           | DATE | HORIZ. SCALE | VERT. SCALE          |
| RECORD DRAWING                                  | B.M.         | 4/14 | NONE         |                      |
| CHANGE ORDER                                    | E.H.         | 8-13 |              |                      |
| DESIGNED BY                                     | H. MORRISON  |      | JOB NUMBER   | 1199-336             |
| DRAWN BY  | D. CHRISTMAN |      | DATE         | 2013                 |
| REVIEWED BY                                     | B. MOORE     |      | ACAD FILE    | ServiceDets-Ph3C.dwg |
| COPYRIGHT 2013 BY ANDERSON-PERRY & ASSOC., INC. |              |      |              |                      |

**RECORD DRAWINGS**  
APRIL 18, 2014  
These record drawings have been prepared, in part, on the basis of information compiled and furnished by others. They may contain some discrepancies and omissions, and do not necessarily represent "exact" field conditions. The Owner and the Engineer accept no responsibility for their accuracy.

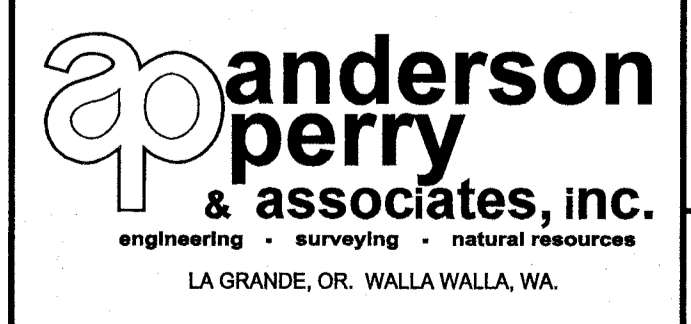

**BENTON IRRIGATION DISTRICT**  
IRRIGATION SYSTEM IMPROVEMENTS  
PHASE 3C  
SERVICE DETAILS I

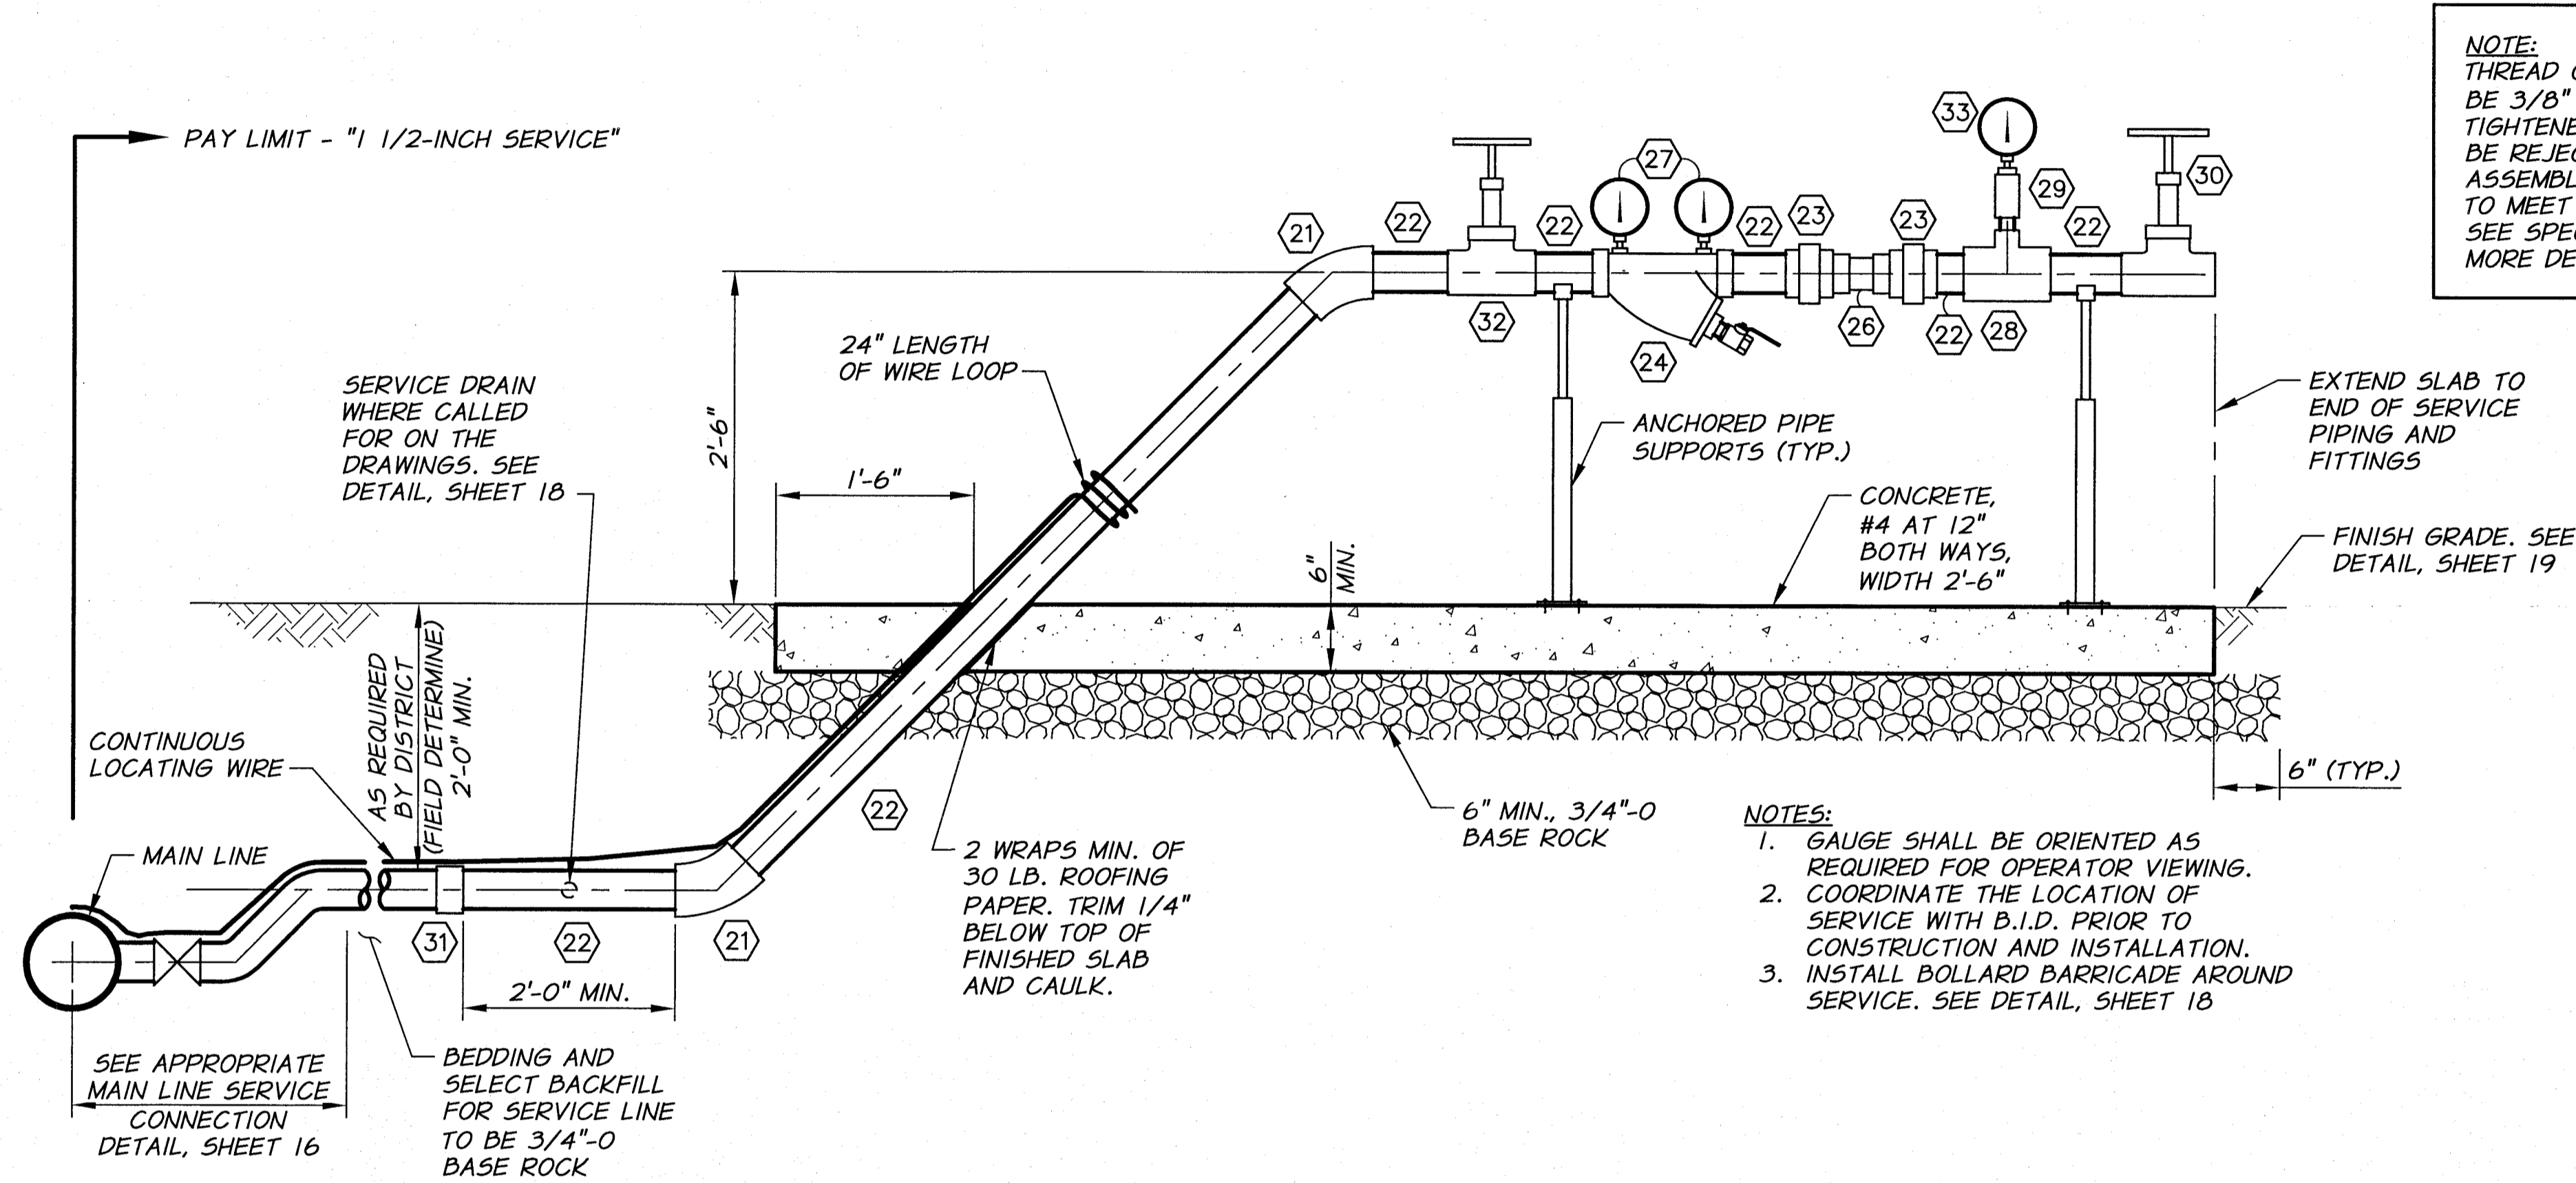


NOTE:  
 THREAD CLEARANCE SHALL BE 3/8" MINIMUM. OVER TIGHTENED FITTINGS WILL BE REJECTED AND PIPING ASSEMBLY REASSEMBLED TO MEET REQUIREMENTS. SEE SPECIFICATIONS FOR MORE DETAILS.

**SERVICE FITTING SCHEDULE**

- (21) G.I.P. 45° ELBOW
- (22) SCH. 40 G.I.P. PIPE
- (23) G.I.P. UNION OR G.I.P. REDUCING UNION AS REQUIRED
- (24) 1 1/4" SONNITAG ALUMINUM Y-FILTER WITH 10 MESH FILTER SCREEN (UNLESS OTHERWISE SPECIFIED), WITH FITTINGS AS REQUIRED. PROVIDE NIPPLE AND BALL VALVE AT FLUSH PORT. SIZE TO MATCH PORT.
- (25) RESERVED
- (26) DOLE FLOW CONTROL VALVE. SIZE AS SHOWN ON PLANS. INSTALL WITH FLOW RATE LABEL FACING UPWARDS AND NO WRENCH MARKS ON VALVE.
- (27) 4" 55 GLYCERIN FILLED PRESSURE GAUGE, FITTINGS AS REQUIRED
- (28) SIZE x 3/4" G.I.P. TEE
- (29) 3/4" THREADED BRASS BALL VALVE WITH 3/4"x1/4" BUSHING AND BRASS QUICK COUPLING PLUG (UNVALVED)
- (30) BRASS THREADED GATE VALVE
- (31) SCH 80 PVC TRANSITION COUPLING AND FITTINGS AS REQ'D. FEMALE CONNECTION TO GIP.
- (32) LOCKING THREADED BRASS 1 1/2" GATE VALVE WITH BUSHINGS AS REQ'D.
- (33) GAUGE BY OWNER


- NOTES:
1. GAUGE SHALL BE ORIENTED AS REQUIRED FOR OPERATOR VIEWING.
  2. COORDINATE THE LOCATION OF SERVICE WITH B.I.D. PRIOR TO CONSTRUCTION AND INSTALLATION.
  3. INSTALL BOLLARD BARRICADE AROUND SERVICE. SEE DETAIL, SHEET 18

**TYPICAL 1 1/2" SERVICE DETAIL  
 WITHOUT PRESSURE REDUCING VALVE  
 N.T.S.**

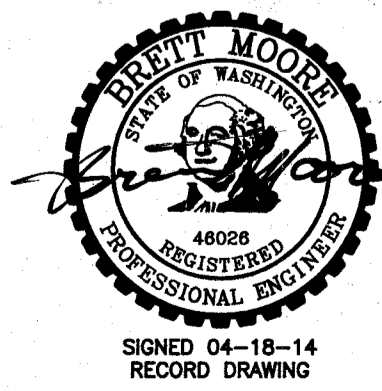


|                |              |   |                      |      |      |
|----------------|--------------|---|----------------------|------|------|
| RECORD DRAWING |              | BY  | B.M.                 | DATE | 4/14 |
| DESIGNED BY    | H. MORRISON  | JOB NUMBER                                      | 1199-336             | DATE | 2013 |
| DRAWN BY       | D. CHRISTMAN | ACAD FILE                                       | ServiceDets-Ph3C.dwg |      |      |
| REVIEWED BY    | B. MOORE     | COPYRIGHT 2013 BY ANDERSON-PERRY & ASSOC., INC. |                      |      |      |

**RECORD DRAWINGS**  
 APRIL 18, 2014  
 These record drawings have been prepared, in part, on the basis of information compiled and furnished by others. They may contain some discrepancies and omissions, and do not necessarily represent "exact" field conditions. The Owner and the Engineer accept no responsibility for their accuracy.

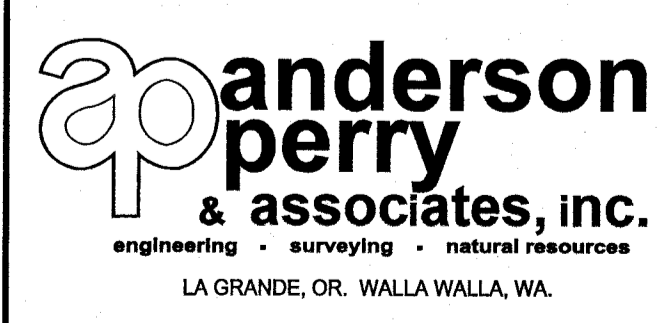





**BENTON IRRIGATION DISTRICT**  
 IRRIGATION SYSTEM IMPROVEMENTS  
 PHASE 3C  
 SERVICE DETAILS II

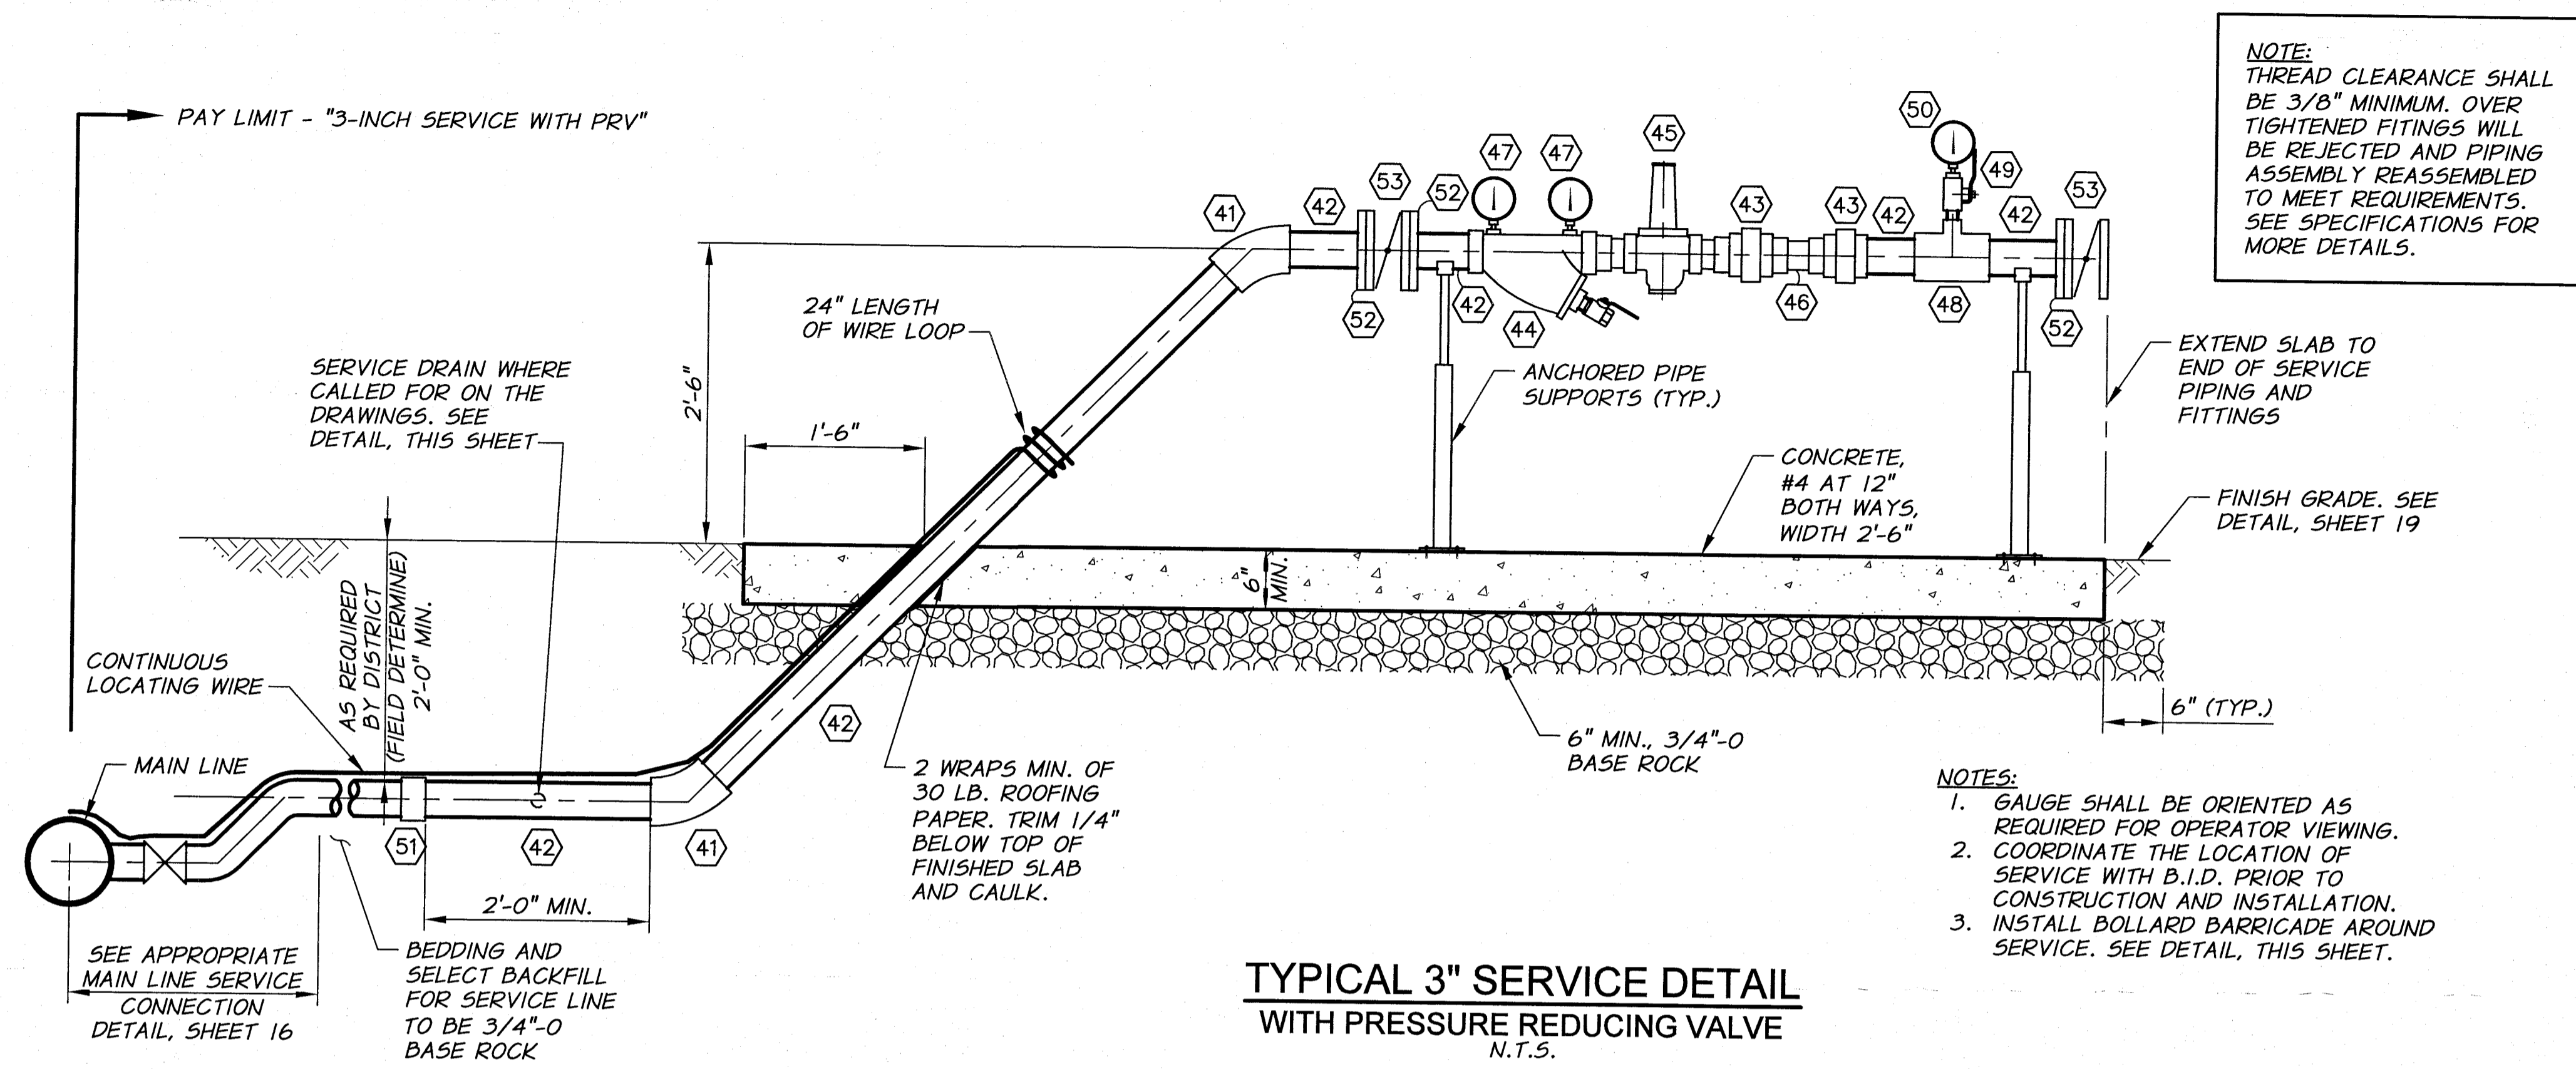

**SERVICE FITTING SCHEDULE**


- 41 G.I.P. 45° ELBOW
- 42 SCH. 40 G.I.P. PIPE
- 43 G.I.P. UNION OR G.I.P. REDUCING UNION AS REQUIRED
- 44 3" SONNITAG ALUMINUM Y-FILTER WITH 40 MESH FILTER SCREEN, UNLESS OTHERWISE SPECIFIED. PROVIDE NIPPLE AND BALL VALVE AT FLUSH PORT, SIZE TO MATCH PORT.
- 45 CLA-VAL 990 PRESSURE REDUCING VALVE WITH BUSHINGS AS REQUIRED. SIZE AS SHOWN ON PLANS. SEE TECHNICAL SPECIFICATIONS FOR DETAILS.
- 46 DOLE FLOW CONTROL VALVE. SIZE AS SHOWN ON PLANS. INSTALL WITH FLOW RATE LABEL FACING UPWARDS AND NO WRENCH MARKS ON VALVE.
- 47 4" 55 GLYCERIN FILLED PRESSURE GAUGE. FITTINGS AS REQUIRED.
- 48 3"x3/4" G.I.P. TEE
- 49 3/4" THREADED BRASS BALL VALVE WITH 3/4"x1/4" BUSHING AND BRASS QUICK COUPLING PLUG (UNVALVED)
- 50 GAUGE BY OWNER
- 51 SCH 80 PVC TRANSITION COUPLING AND FITTINGS AS REQ'D. FEMALE CONNECTION TO GIP.
- 52 FLANGE ADAPTER
- 53 3" FLG BUTTERFLY VALVE WITH WHEEL OPERATOR AND POSITION INDICATOR

- NOTES:**
1. GAUGE SHALL BE ORIENTED AS REQUIRED FOR OPERATOR VIEWING.
  2. COORDINATE THE LOCATION OF SERVICE WITH B.I.D. PRIOR TO CONSTRUCTION AND INSTALLATION.
  3. INSTALL BOLLARD BARRICADE AROUND SERVICE. SEE DETAIL, THIS SHEET.

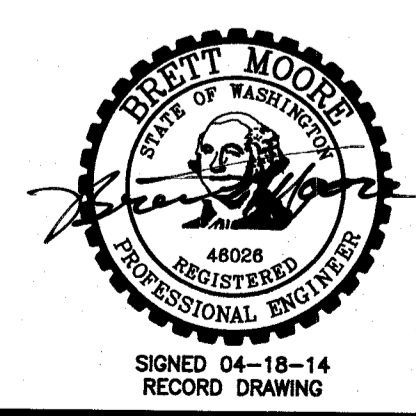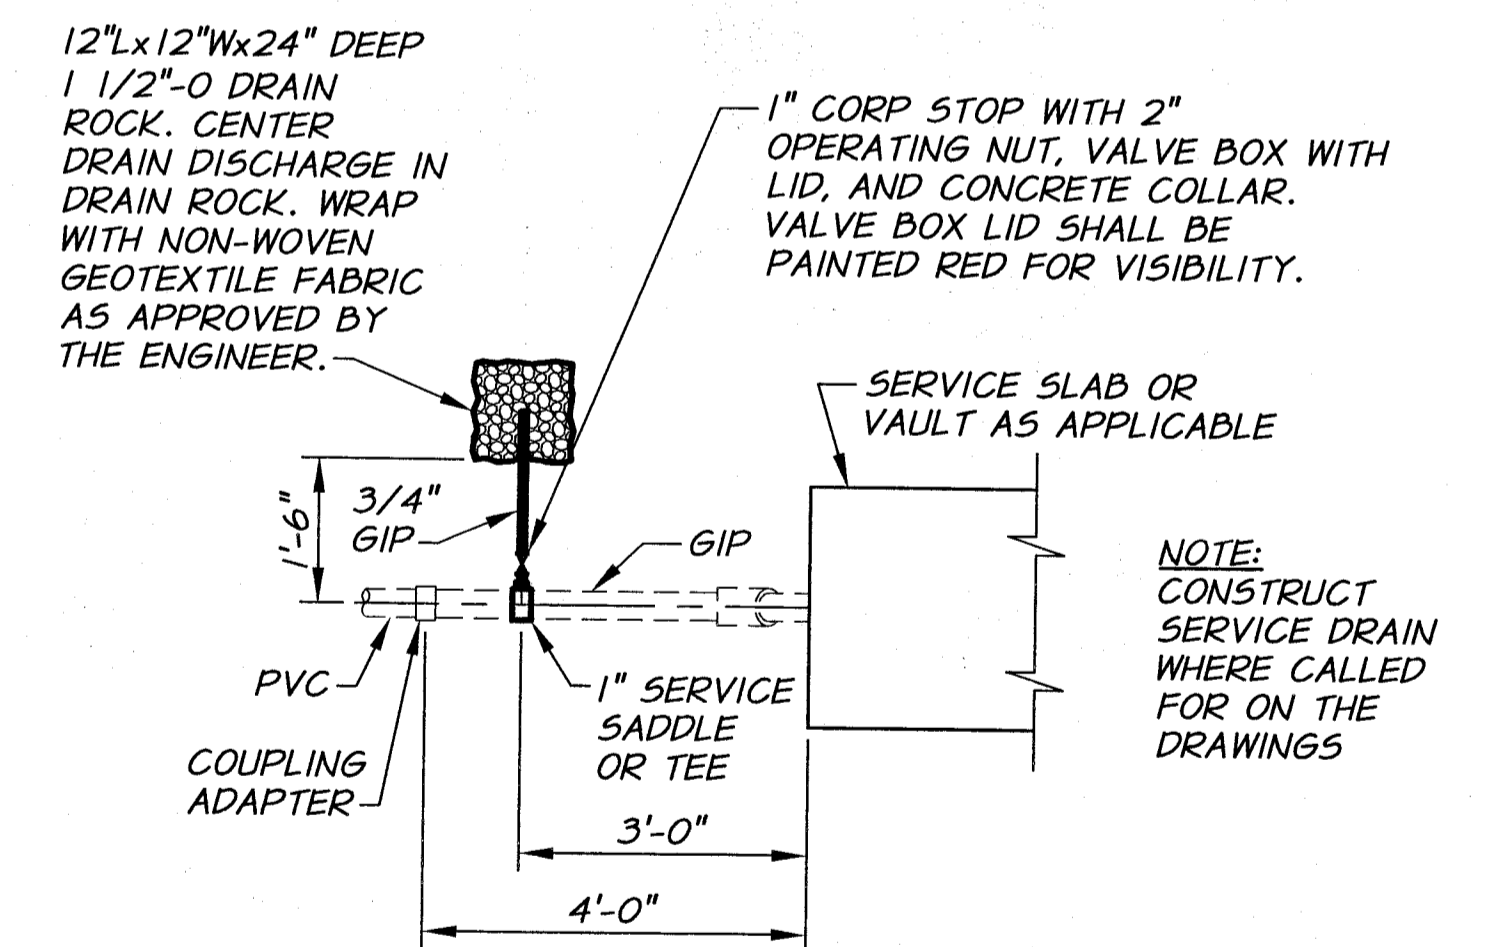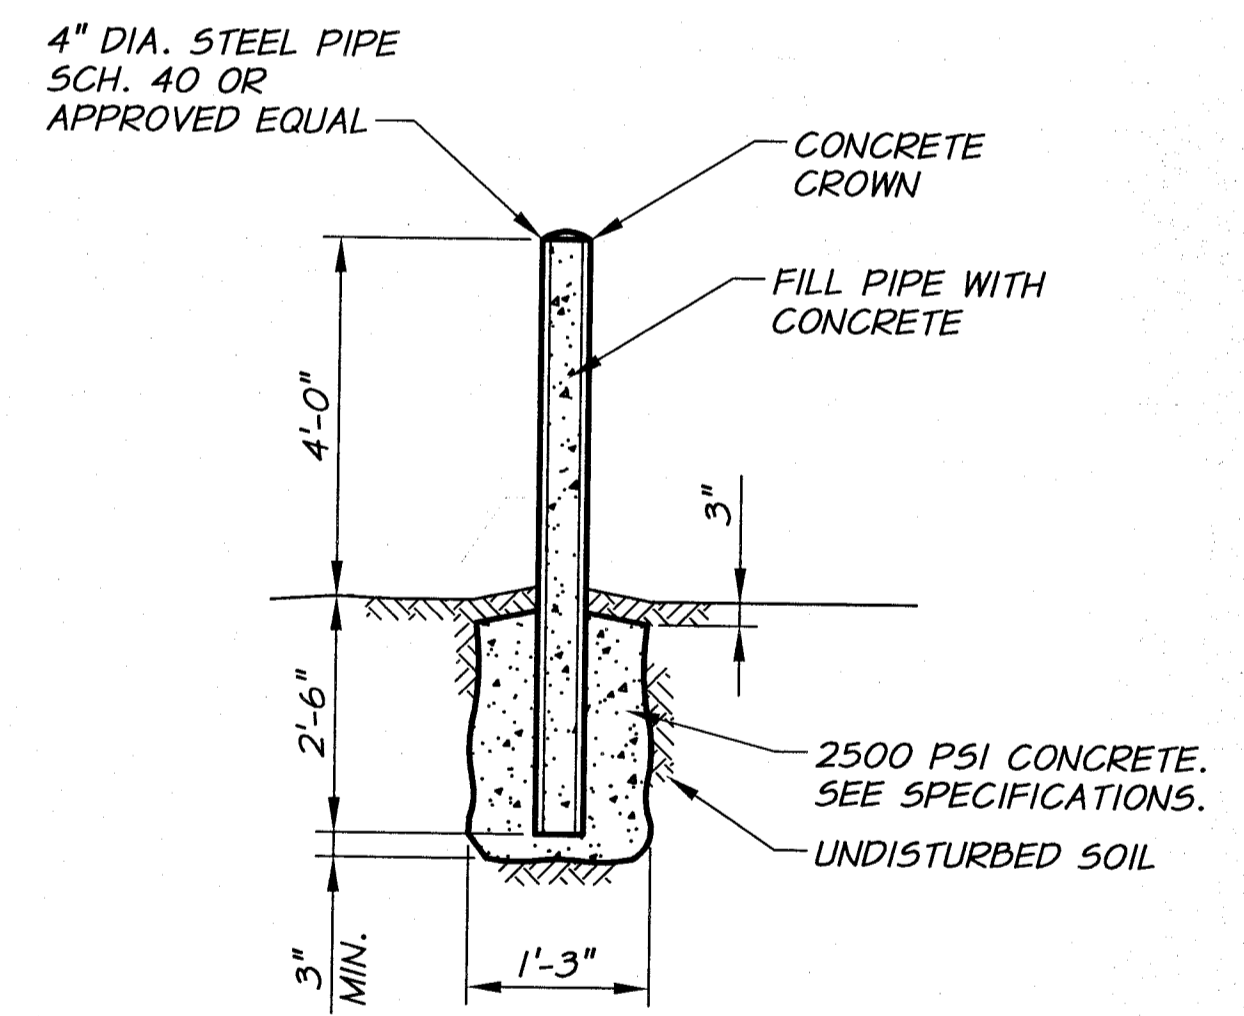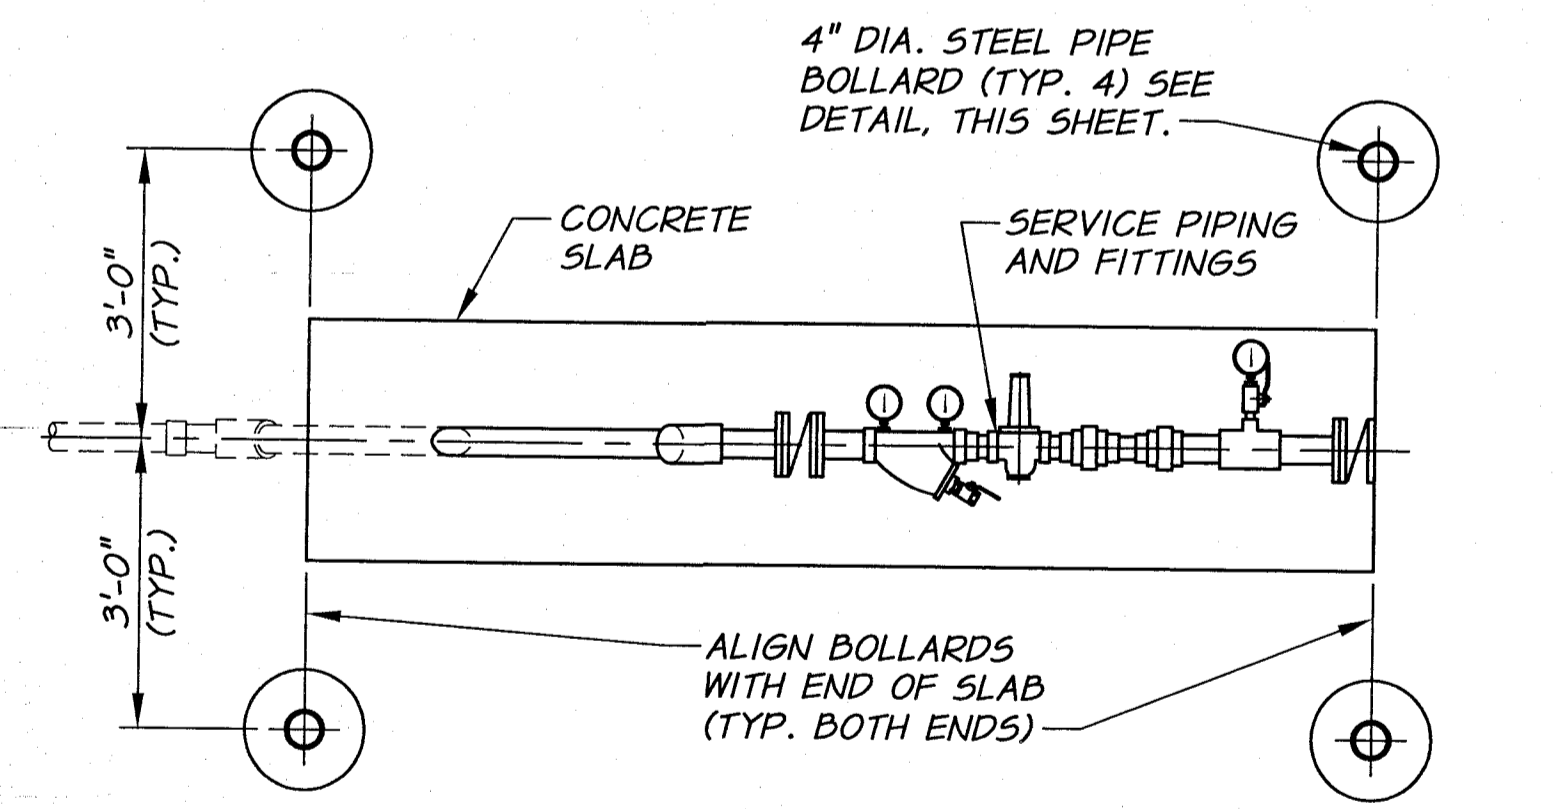


|                |              |   |                      |      |      |
|----------------|--------------|---|----------------------|------|------|
| RECORD DRAWING |              | B.M.  | 4/14                 | DATE |      |
| DESIGNED BY    | H. MORRISON  | JOB NUMBER                                      | 1199-336             | DATE | 2013 |
| DRAWN BY       | D. CHRISTMAN | ACAD FILE:                                      | ServiceDets-Ph3C.dwg |      |      |
| REVIEWED BY    | B. MOORE     | COPYRIGHT 2013 BY ANDERSON-PERRY & ASSOC., INC. |                      |      |      |

**RECORD DRAWINGS**  
 APRIL 18, 2014  
 These record drawings have been prepared, in part, on the basis of information compiled and furnished by others. They may contain some discrepancies and omissions, and do not necessarily represent "exact" field conditions. The Owner and the Engineer accept no responsibility for their accuracy.

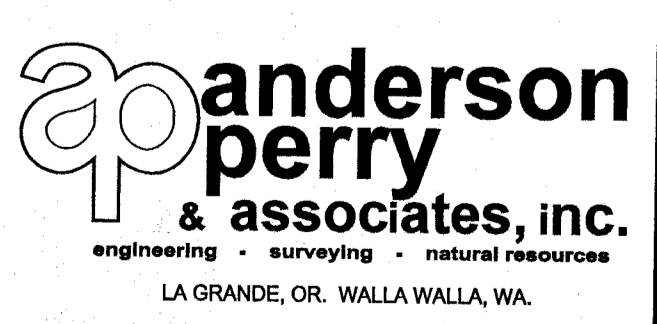


**BENTON IRRIGATION DISTRICT**  
 IRRIGATION SYSTEM IMPROVEMENTS  
 PHASE 3C  
 SERVICE DETAILS III


SHEET  
**18**

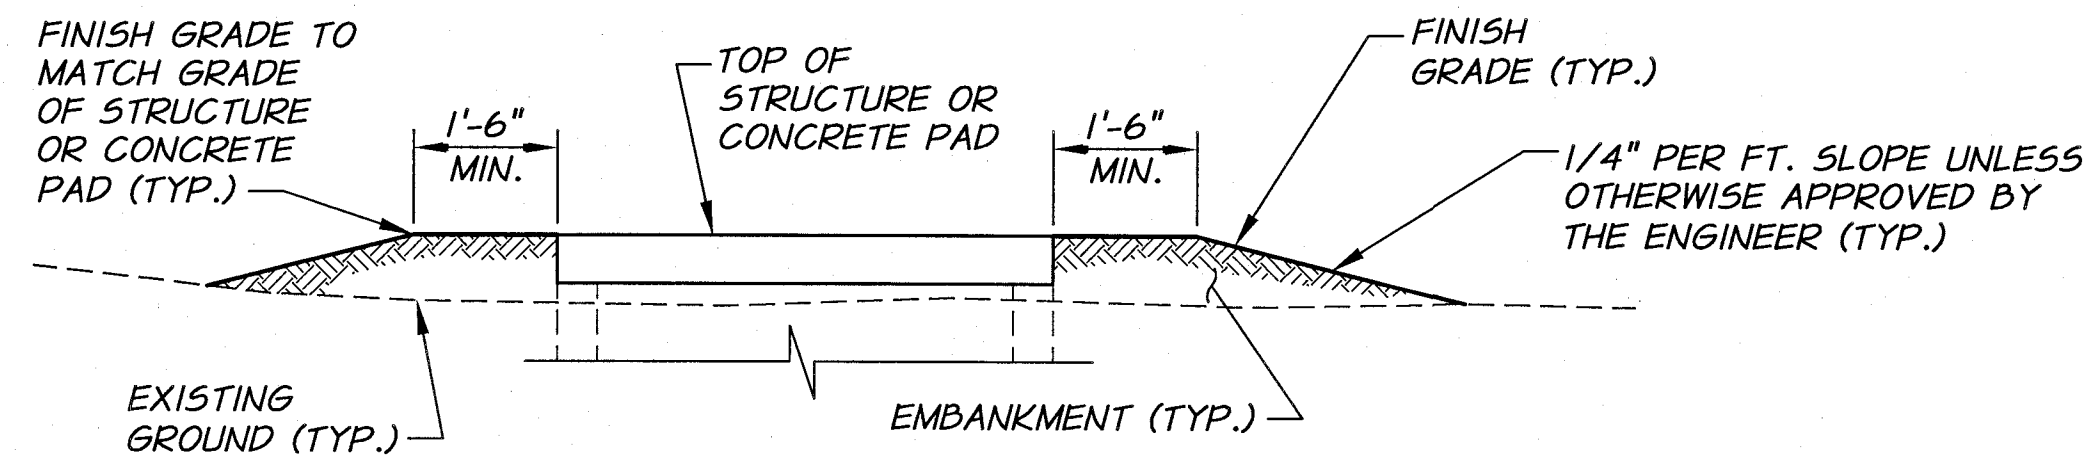

SECTION B

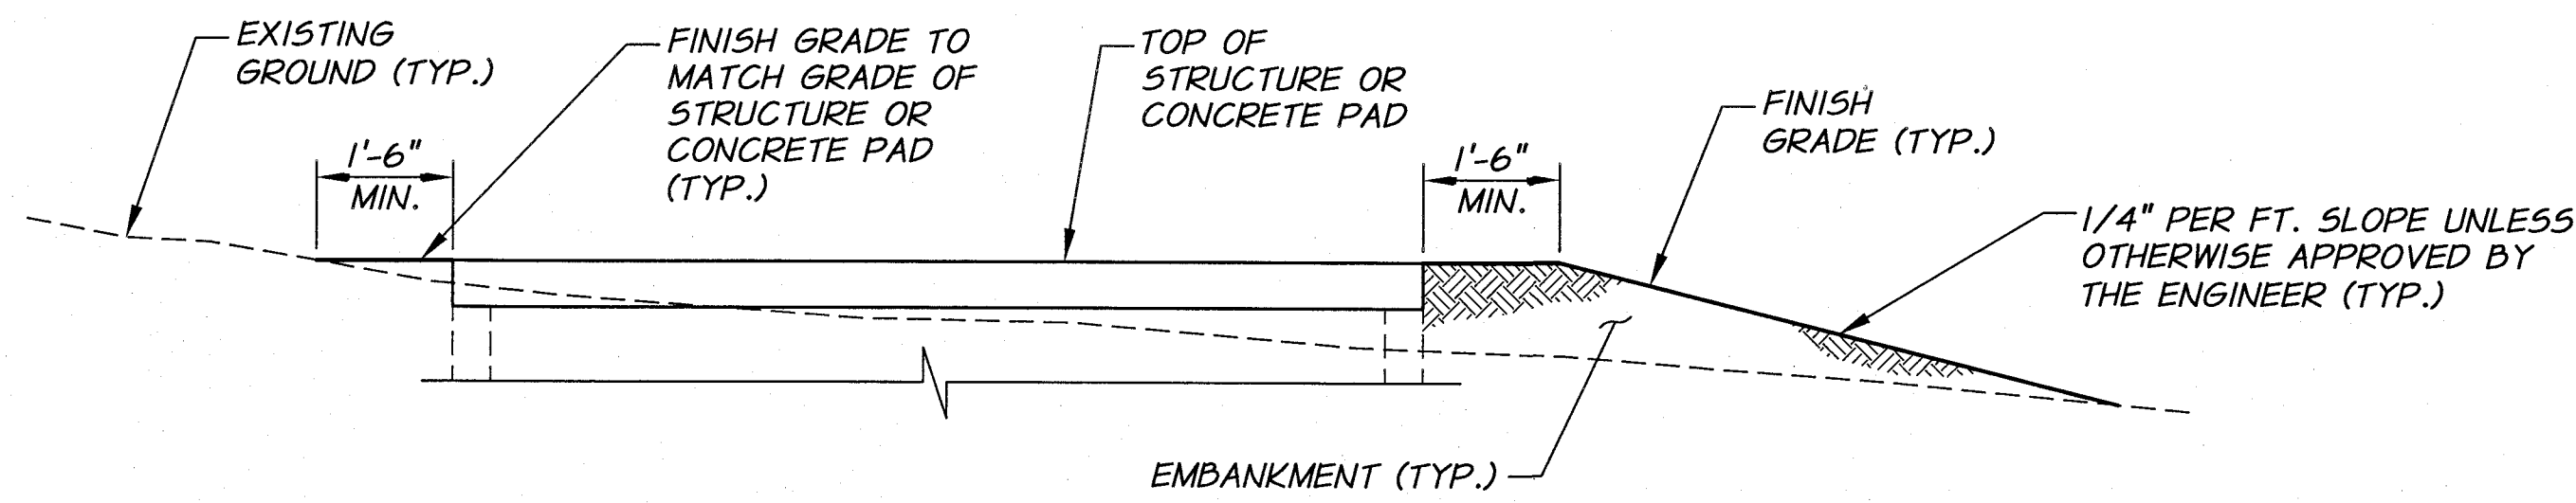

SECTION A

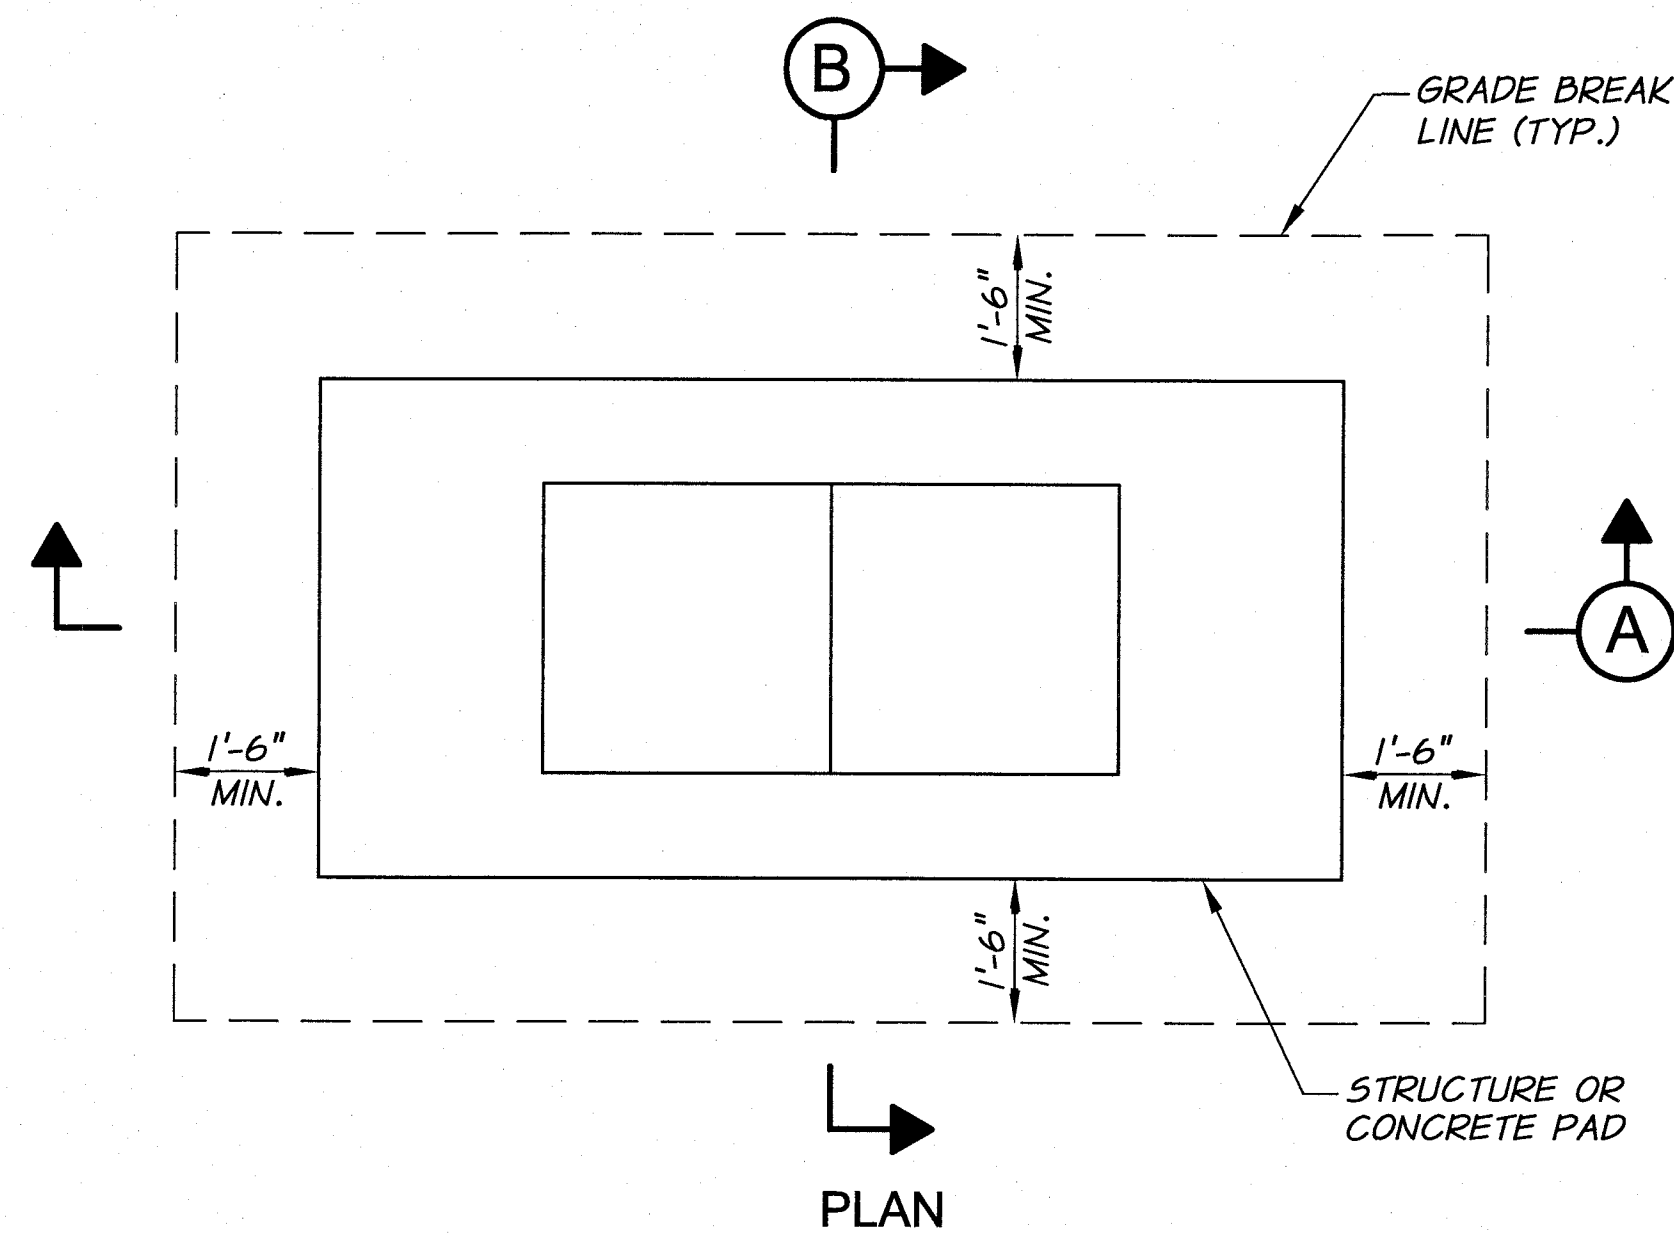

PLAN


GRADING DETAIL  
N.T.S.

FITTING SCHEDULE


- ① TRANSITION COUPLING
- ② GIP, SIZE AS SHOWN ON PLANS
- ③ THREADED GIP REDUCER WHERE REQUIRED
- ④ 2" THREADED GIP
- ⑤ 2" FLG GATE VALVE WITH FLGxFIPT ADAPTOR FLANGES
- ⑥ SONNTAG ALUMINUM Y FILTER WITH 3/32 SCREEN. PROVIDE NIPPLE AND BALL VALVE AT FLUSH PORT, SIZE TO MATCH PORT.
- ⑦ 2" THREADED PRESSURE REDUCING VALVE, CLA-VAL 990
- ⑧ 2"x3/4" THREADED GIP TEE
- ⑨ 3/4" THREADED BRASS BALL VALVE WITH 3/4"x1/4" NPT BUSHING AND BRASS QUICK COUPLING PLUG (UNVALVED)
- ⑩ 4" 55 GLYCERIN FILLED PRESSURE GAUGE WITH FITTINGS AS REQUIRED. ORIENT GAUGE SO THAT FACE IS CLEARLY VISIBLE FROM VAULT ACCESS OPENING.
- ⑪ PIPE SUPPORT. SEE DETAIL, SHEET 23.
- ⑫ SEAL PIPE PENETRATIONS WATERTIGHT WITH NON-SHRINK GROUT
- ⑬ OWNER SUPPLIED GAUGE

NOTE:  
THREAD CLEARANCE SHALL BE 3/8" MINIMUM. OVER TIGHTENED FITTINGS WILL BE REJECTED AND PIPING ASSEMBLY REASSEMBLED TO MEET REQUIREMENTS. SEE SPECIFICATIONS FOR MORE DETAILS.

72" PRE-CAST MANHOLE WITH H-20 TRAFFIC RATED FLAT TOP AND 24" UNLABELED MANHOLE COVER WITH FRAME CAST INTO SLAB

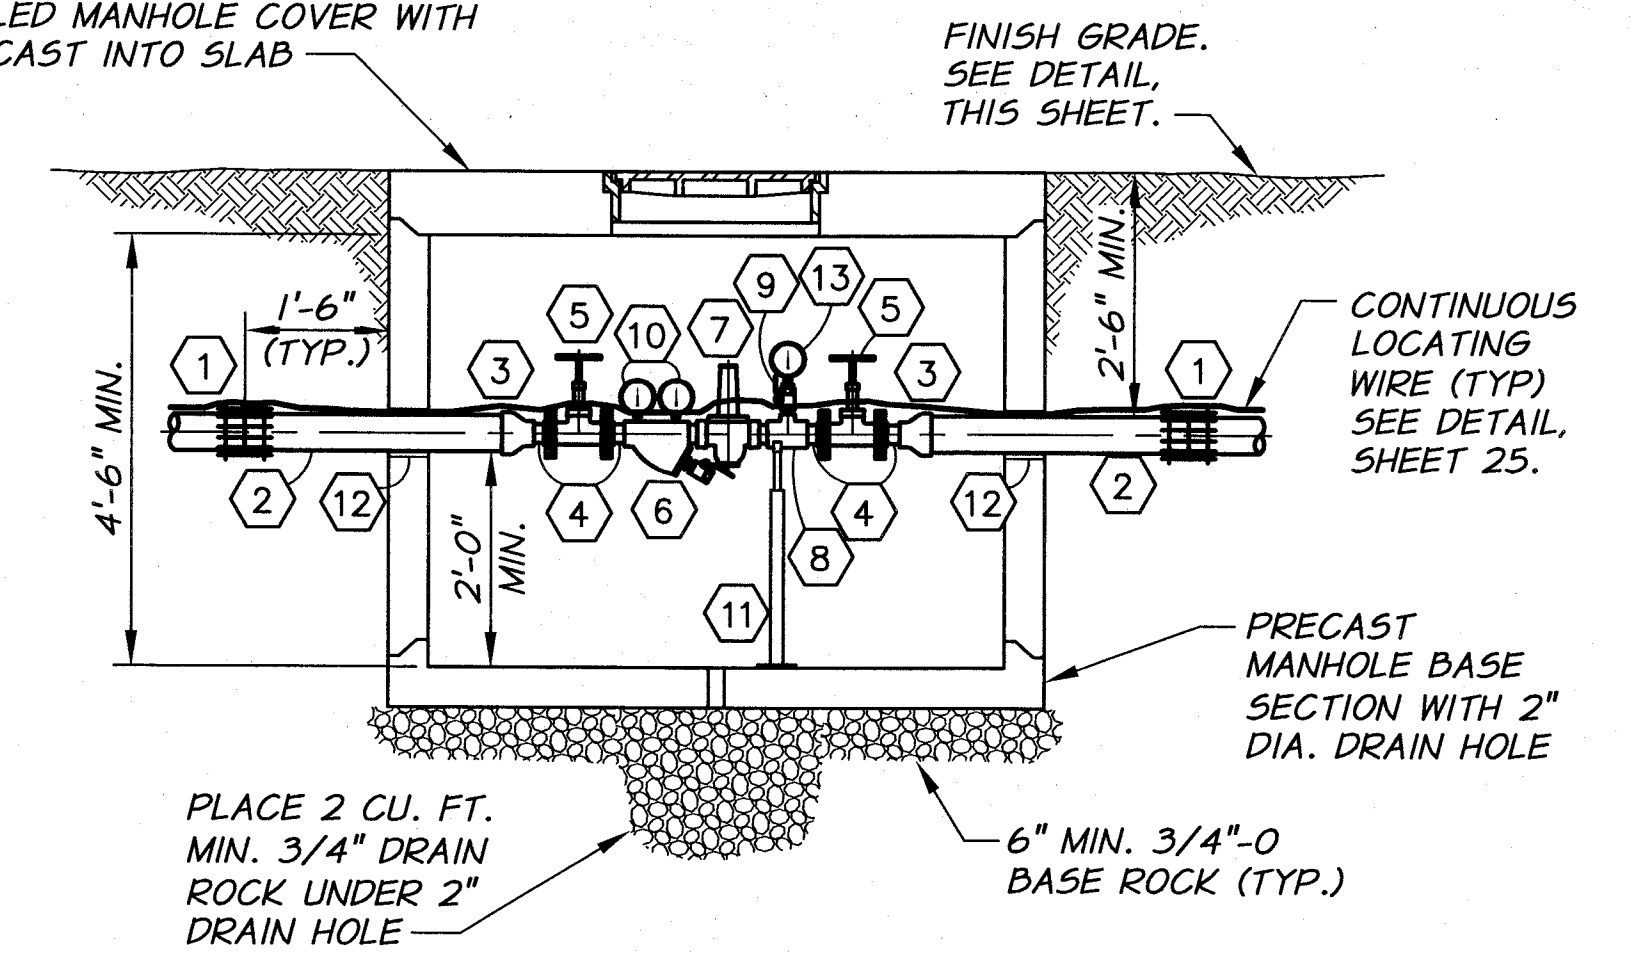

SECTION B

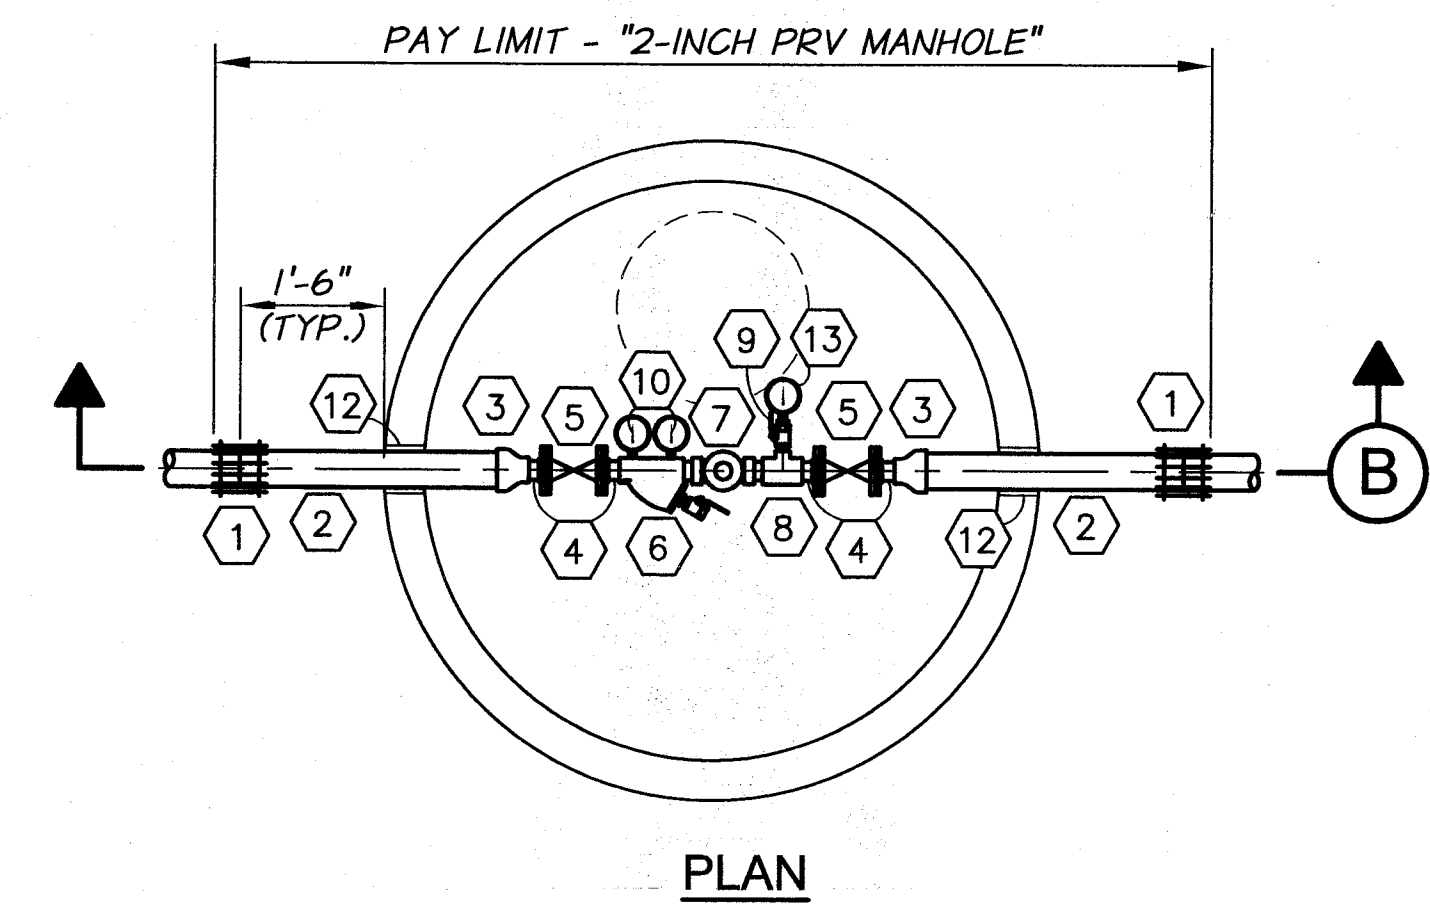

PLAN

NOTES:

- 1. SET FRAME AND COVER TO GRADE AND PROVIDE GRADE RINGS AS REQUIRED.
- 2. PIPE SUPPORTS TO BE SIZED APPROPRIATELY FOR PIPE AND INSTALLED PER MANUFACTURER'S RECOMMENDATIONS.
- 3. ALL WORK SHOWN IN THIS DETAIL, INCLUDING ANY REQUIRED SURFACE RESTORATION, SHALL BE INCLUDED IN THE "2-INCH PRV MANHOLE" PAY ITEM.


2" PRESSURE REDUCING VALVE MANHOLE DETAIL  
N.T.S.



|   |              |              |                    |             |      |
|---|--------------|--------------|--------------------|-------------|------|
| RECORD DRAWING                                  |              | BY           | B.M.               | DATE        | 4/14 |
| DESIGNED BY                                     | H. MORRISON  | HORIZ. SCALE | NONE               | VERT. SCALE |      |
| DRAWN BY  | D. CHRISTMAN | JOB NUMBER   | 1199-336           | DATE        | 2013 |
| REVIEWED BY                                     | B. MOORE     | ACAD FILE    | VaultDets-PH3C.dwg |             |      |
| COPYRIGHT 2013 BY ANDERSON-PERRY & ASSOC., INC. |              |              |                    |             |      |

RECORD DRAWINGS  
APRIL 18, 2014

These record drawings have been prepared, in part, on the basis of information compiled and furnished by others. They may contain some discrepancies and omissions, and do not necessarily represent "exact" field conditions. The Owner and the Engineer accept no responsibility for their accuracy.

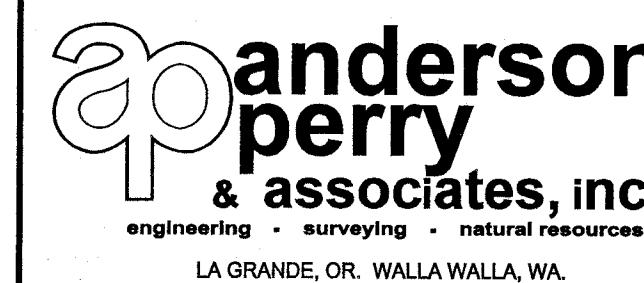

BENTON IRRIGATION DISTRICT  
IRRIGATION SYSTEM IMPROVEMENTS  
PHASE 3C

CONTROL VALVE DETAILS I


SHEET

19


**FITTING SCHEDULE**

- 1 SERVICE LINE PVC PIPING
- 2 MJ ECCENTRIC REDUCER
- 3 CLASS 200 PVC PIPING (SAME SIZE AS CONTROL VALVE)
- 4 MJ GATE VALVE WITH VALVE BOX. SEE DETAIL, SHEET 51.
- 5 COUPLING
- 6 FLG X PE D.I. SPOOL, LENGTH AS REQUIRED (SAME SIZE AS CONTROL VALVE)
- 7 FOR 4" SERVICE: 3" FLG DI SPOOL X 1'-8" LG. FOR 6" SERVICE: 4" FLG GIP SPOOL X 4'-0" LG. FOR 8" SERVICE: 6" FLG DI SPOOL X 4'-0" LG.
- 8 FOR 4" SERVICE: 3" MICROMETER FLOWMETER MODEL MW500 FOR 6" SERVICE: 4" MICROMETER FLOWMETER MODEL LP22 FOR 8" SERVICE: 6" MICROMETER FLOWMETER MODEL LP32
- 9 FOR PRV/FCV SERVICE ONLY: 3/4" TAPPING SADDLE WITH 3/4" THREADED BRASS BALL VALVE, 3/4"x1/4" BUSHING, AND BRASS QUICK COUPLING PLUG (UNVALVED)
- 10 CLA-VAL 40-01 FLOW CONTROL OR 49-01 COMBINATION FLOW CONTROL AND PRESSURE REDUCING VALVE, TYPE AS SHOWN ON PLANS. SEE TABLE 1, THIS SHEET, AND SPECIFICATIONS FOR DETAILS.
- 11 RESTRAINED FLANGE COUPLING ADAPTER
- 12 BRASS QUICK COUPLING PLUG (UNVALVED) AND FITTINGS AS REQUIRED ON ORIFICE PILOT PIPING. PROVIDE ADDITIONAL ISOLATION VALVE.
- 13 PE DI SPOOL LENGTH AS REQUIRED (SAME SIZE AS CONTROL VALVE)
- 14 FLANGE COUPLING ADAPTER AND FITTINGS AS REQUIRED
- 15 FLG SIZExSIZExSIZE TEE, BRANCH NOT TO EXCEED 6"
- 16 FLGxMJ GATE VALVE WITH VALVE BOX. SEE DETAIL, SHEET 51.
- 17 ORIFICE PLATE
- 18 FLGxPE SPOOL, LENGTH AS REQUIRED, FITTINGS AS REQUIRED
- 19 MAINGUARD BLOW-OFF #7600 (SEE TABLE 1, THIS SHEET). ENCLOSURE TO BE CARSON INDUSTRIES MODEL H2436 TRAFFIC BEARING VAULT AND LID WITH EXTENSIONS AS REQUIRED.
- 20 OSHA APPROVED GALVANIZED STEEL LADDER WITH 4 FOOT REMOVABLE EXTENSION
- 21 PIPE SUPPORT. SEE TYPICAL PIPE SUPPORT DETAIL SHEET 49.
- 22 SEAL PIPE PENETRATIONS WATERTIGHT WITH NON-SHRINK GROUT
- 23 BRASS GRATED DRAIN WITH KNOCKOUT HOLE FOR DRAIN PIPE. DO NOT PROVIDE DRAIN IN HIGH GROUND WATER AREA.
- 24 FLG x PE DI SPOOL x 2 FT. LONG (SAME SIZE AS CONTROL VALVE)

| SERVICE SIZE | CONTROL VALVE SIZE | BLOW-OFF INLET | BLOW-OFF OUTLET | GATE VALVE SIZE |
|--------------|--------------------|----------------|-----------------|-----------------|
| 4-INCH       | 3"                 | 4"             | 4"              | 3"              |
| 6-INCH       | 4"                 | 4"             | 4"              | 4"              |
| 8-INCH       | 6"                 | 6"             | 4"              | 6"              |

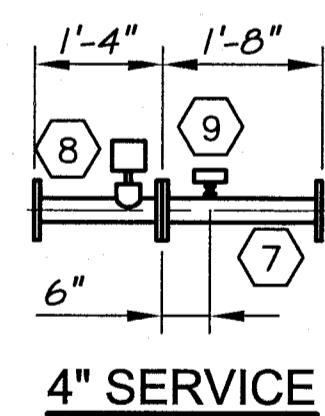


4" SERVICE

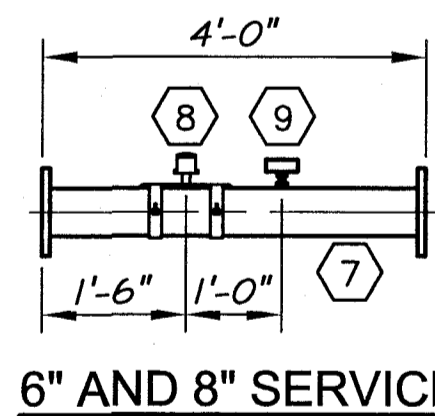


6" AND 8" SERVICE

**FLOWMETER PIPING DETAIL**

N.T.S.

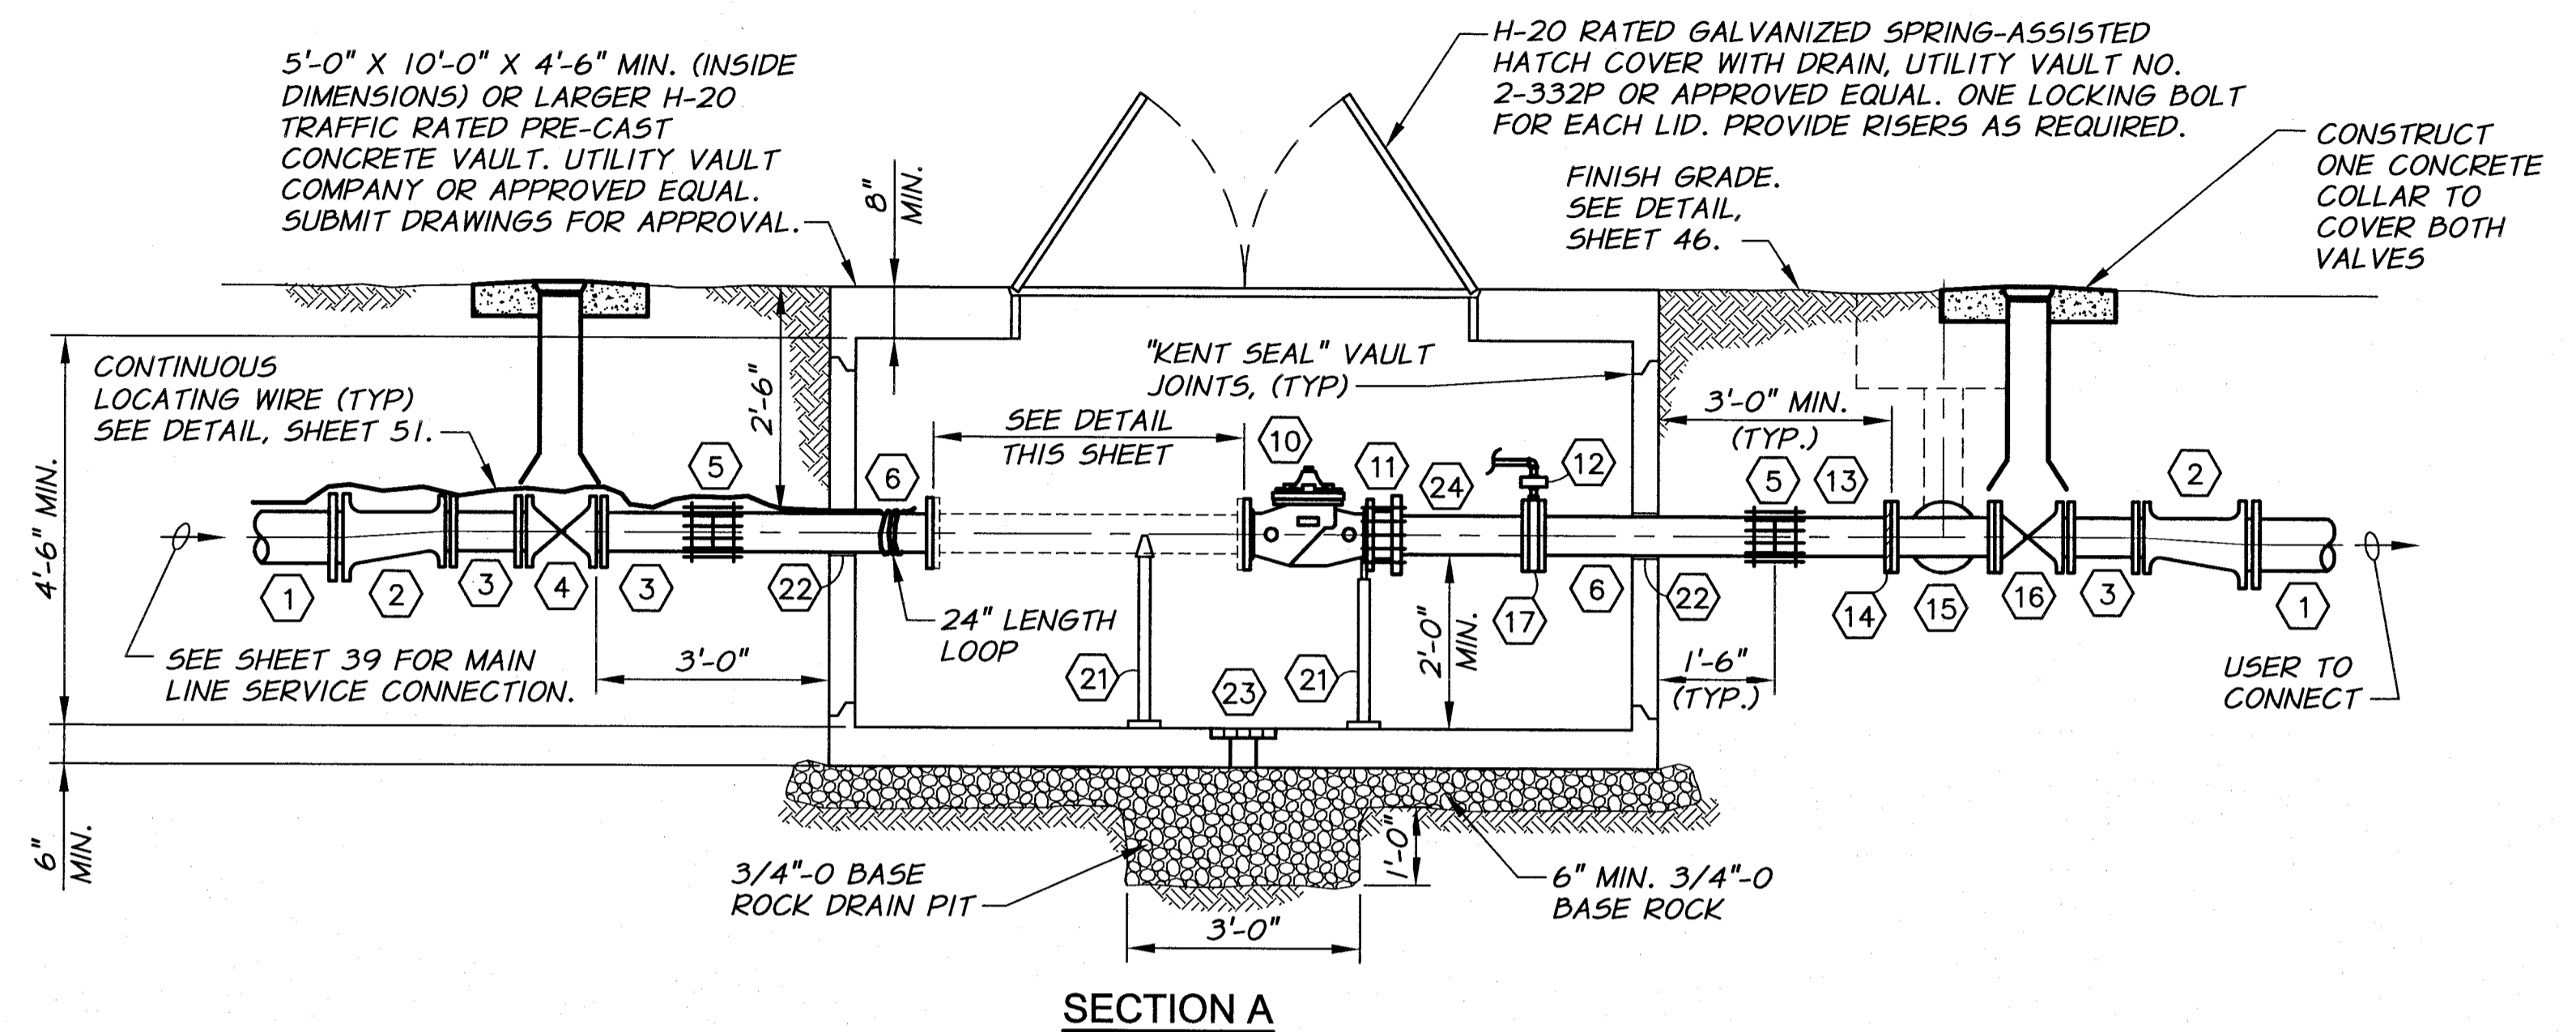

SECTION A

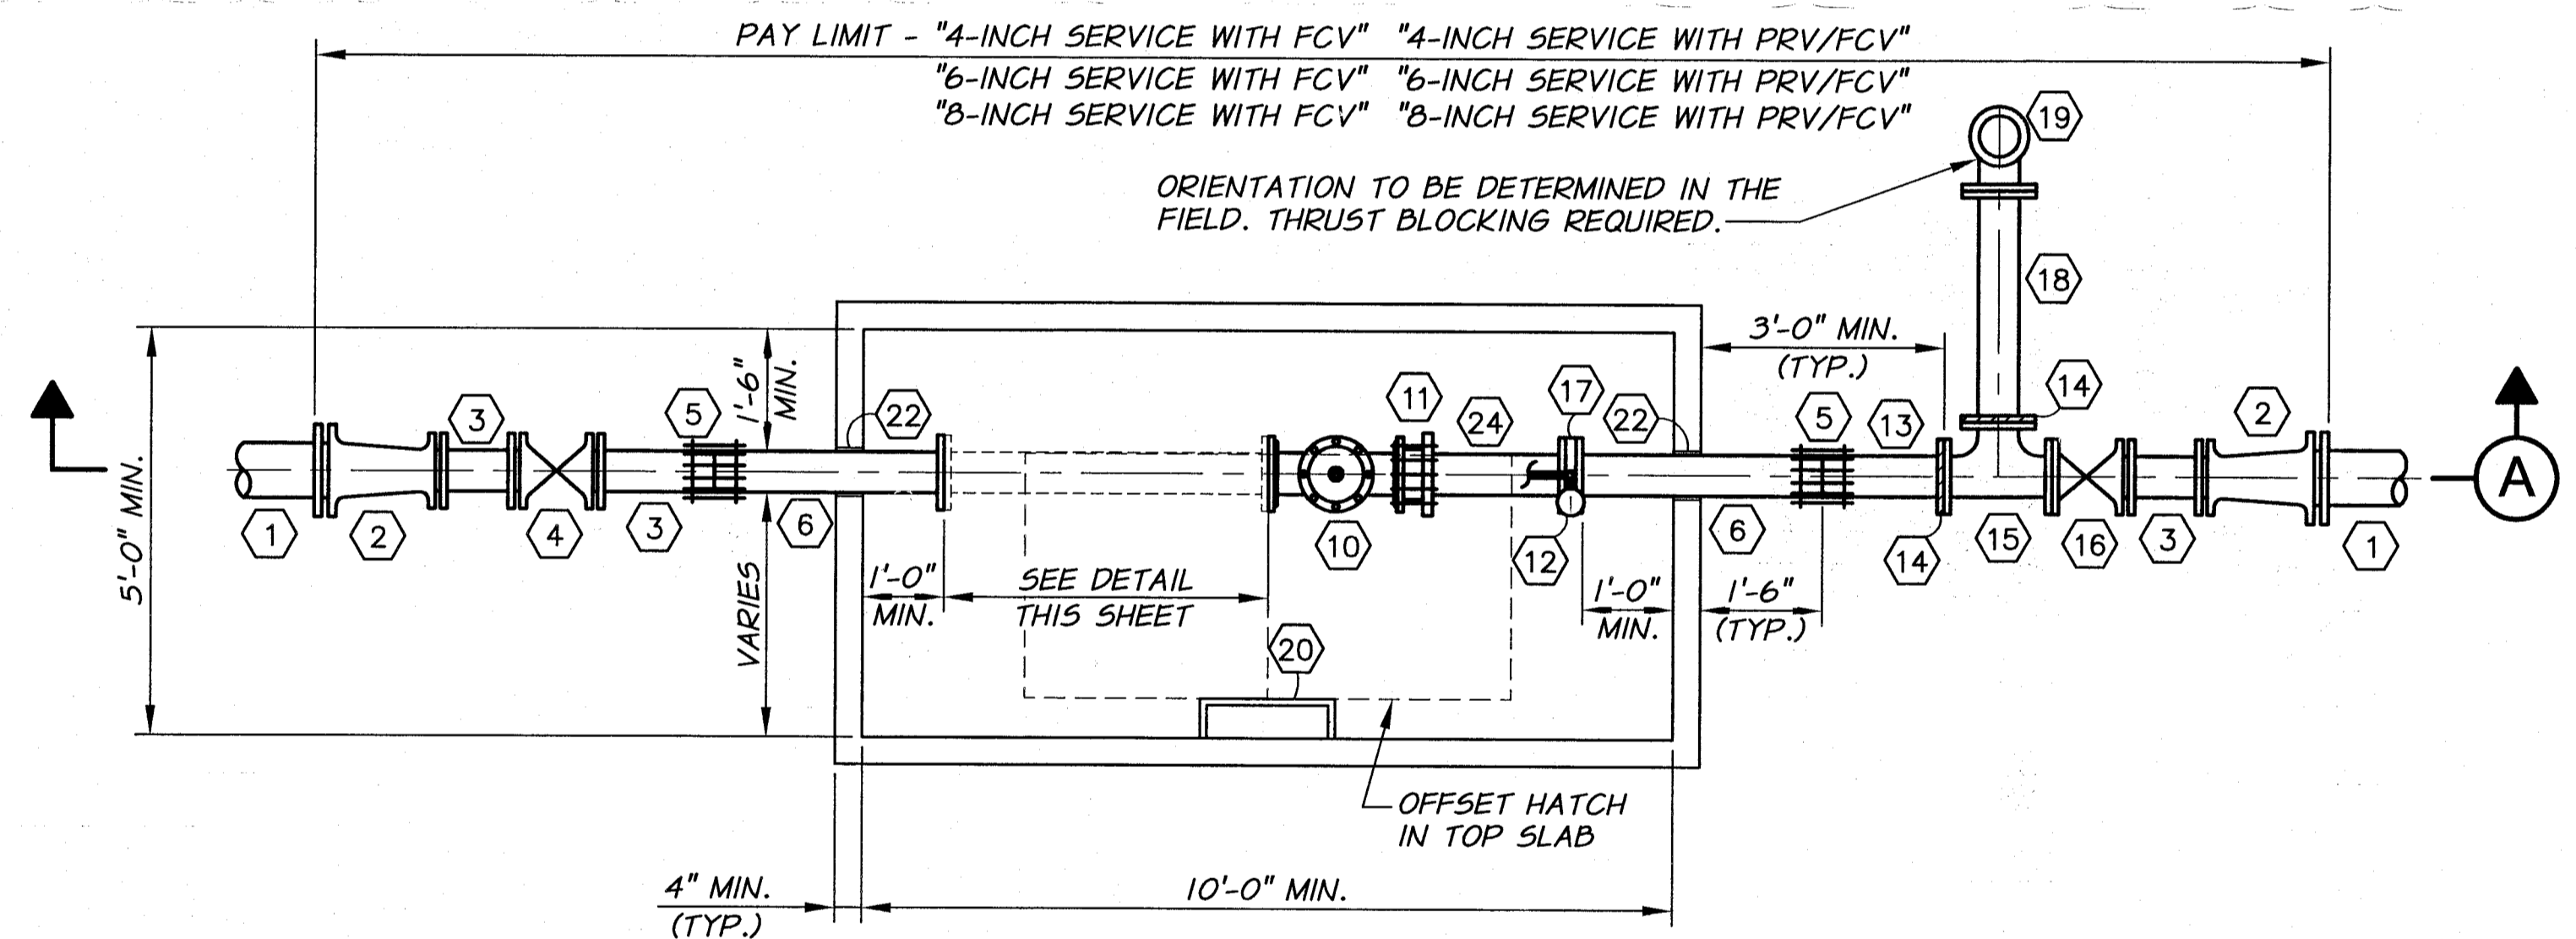


PLAN

**NOTES:**

1. PIPING SIZE TO MATCH CONTROL VALVE SIZE UNLESS OTHERWISE NOTED.
2. SET FRAME AND COVER TO GRADE AND PROVIDE GRADE RINGS AS REQUIRED.
3. PIPE SUPPORTS TO BE SIZED APPROPRIATELY FOR PIPE AND INSTALLED PER MANUFACTURER'S RECOMMENDATIONS.
4. ALL WORK SHOWN IN THIS DETAIL, INCLUDING ANY REQUIRED SURFACE RESTORATION, SHALL BE INCLUDED IN THE "-INCH SERVICE FCV" OR THE "-INCH SERVICE PRV/FCV" PAY ITEM.

**4", 6", AND 8" SERVICE WITH PRV/FCV OR FCV DETAIL**


N.T.S.

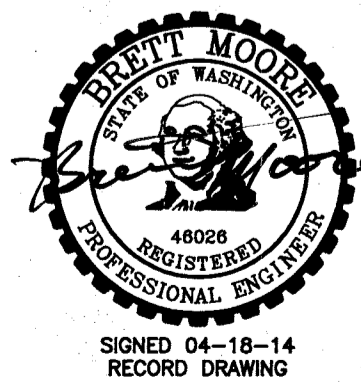

|   |      |      |                                 |             |
|---|------|------|---------------------------------|-------------|
| RECORD DRAWING                                  | B.M. | 4/14 | SCALE IN FEET                   |             |
| CHANGE ORDER 1.2                                | B.M. | 1/14 |                                 |             |
| DESIGNED BY H. MORRISON                         | DATE | 4/14 | HORIZ. SCALE 1/2" = 1'-0"       | VERT. SCALE |
| DRAWN BY D. CHRISTMAN                           |      |      | JOB NUMBER 1199-336             | DATE 2013   |
| REVIEWED BY B. MOORE                            |      |      | ACAD FILE Ph3C VaultDets-CO.dwg |             |
| COPYRIGHT 2013 BY ANDERSON-PERRY & ASSOC., INC. |      |      |                                 |             |

**RECORD DRAWINGS**  
APRIL 18, 2014

These record drawings have been prepared, in part, on the basis of information compiled and furnished by others. They may contain some discrepancies and omissions, and do not necessarily represent "exact" field conditions. The Owner and the Engineer accept no responsibility for their accuracy.

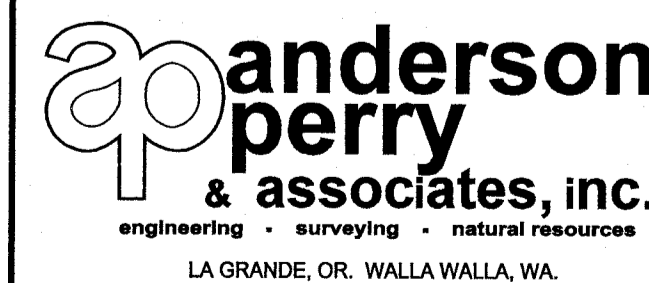

**BENTON IRRIGATION DISTRICT**  
IRRIGATION SYSTEM IMPROVEMENTS  
PHASE 3C

CONTROL VALVE DETAILS 1A  
SEITZ DELIVERY - CHANGE ORDER 1.2

SHEET



19A

CHANGE ORDER 1.2

**FITTING SCHEDULE**

- ① MAIN OR SERVICE LINE PIPING
- ② MJ REDUCER
- ③ CLASS 200 PVC PIPING (SAME SIZE AS CONTROL VALVE)
- ④ MJ GATE VALVE WITH VALVE BOX. SEE DETAIL, SHEET 25.
- ⑤ COUPLING
- ⑥ FLG X PE D.I. SPOOL, LENGTH AS REQUIRED (SAME SIZE AS CONTROL VALVE)
- ⑦ FLG DI SPOOL X 12" LG.
- ⑧ MCGROMETER FLOWMETER MODEL MW500 (SIZE SAME AS CONTROL VALVE)
- ⑨ RESERVED
- ⑩ CLA-VAL 49-01 COMBINATION FLOW CONTROL AND PRESSURE REDUCING VALVE, TYPE AS SHOWN ON PLANS. SEE TABLE 1, THIS SHEET, AND SPECIFICATIONS FOR DETAILS.
- ⑪ RESTRAINED FLANGE COUPLING ADAPTER
- ⑫ 1/4" THREADED BRASS BALL VALVE, 4" 55 GLYCERIN FILLED PRESSURE GAUGE, AND FITTINGS AS REQUIRED ON ORIFICE PILOT PIPING. ORIENT GAUGE SO THAT THE FACE IS CLEARLY VISIBLE FROM VAULT ACCESS OPENING.
- ⑬ PE DI SPOOL LENGTH AS REQUIRED (SAME SIZE AS CONTROL VALVE)
- ⑭ FLANGE COUPLING ADAPTER AND FITTINGS AS REQUIRED
- ⑮ FLG SIZExSIZExSIZE TEE, BRANCH NOT TO EXCEED 6"
- ⑯ FLGxMJ GATE VALVE WITH VALVE BOX. SEE DETAIL, SHEET 25.
- ⑰ ORIFICE PLATE. ORIENT SENSING PORT TO THE SIDE OF THE PIPE LINE.
- ⑱ FLGxPE SPOOL, LENGTH AS REQUIRED, FITTINGS AS REQUIRED
- ⑲ MAINGUARD BLOW-OFF #7600 (SEE TABLE 1, THIS SHEET). ENCLOSURE TO BE CARSON INDUSTRIES MODEL H2436 TRAFFIC BEARING VAULT AND LID WITH EXTENSIONS AS REQUIRED.
- ⑳ OSHA APPROVED GALVANIZED STEEL LADDER WITH 4 FOOT REMOVABLE EXTENSION
- ㉑ PIPE SUPPORT. SEE TYPICAL PIPE SUPPORT DETAIL SHEET 23.
- ㉒ SEAL PIPE PENETRATIONS WATERTIGHT WITH NON-SHRINK GROUT
- ㉓ BRASS GRATED DRAIN WITH KNOCKOUT HOLE FOR DRAIN PIPE. DO NOT PROVIDE DRAIN IN HIGH GROUND WATER AREA.
- ㉔ FLG x PE DI SPOOL x 15" LONG (SAME SIZE AS CONTROL VALVE)
- ㉕ CLA-VAL H-STYLE STRAINER MODEL X43H STANDARD 10 MESH SCREEN WITH 1/4" BALL VALVE ON DRAIN. DRILL AND TAP UPSTREAM AND DOWNSTREAM BOSSES 1/4" FIPT. INSTALL 2 EA. 4" 55 GLYCERIN FILLED PRESSURE GAUGE. ORIENT GAUGE SO THAT THE FACE IS CLEARLY VISIBLE FROM VAULT ACCESS OPENING.

| STATION SIZE | CONTROL VALVE SIZE | BLOW-OFF INLET | BLOW-OFF OUTLET | GATE VALVE SIZE |
|--------------|--------------------|----------------|-----------------|-----------------|
| 3-INCH       | 3"                 | 4"             | 4"              | 3"              |
| 4-INCH       | 4"                 | 4"             | 4"              | 4"              |

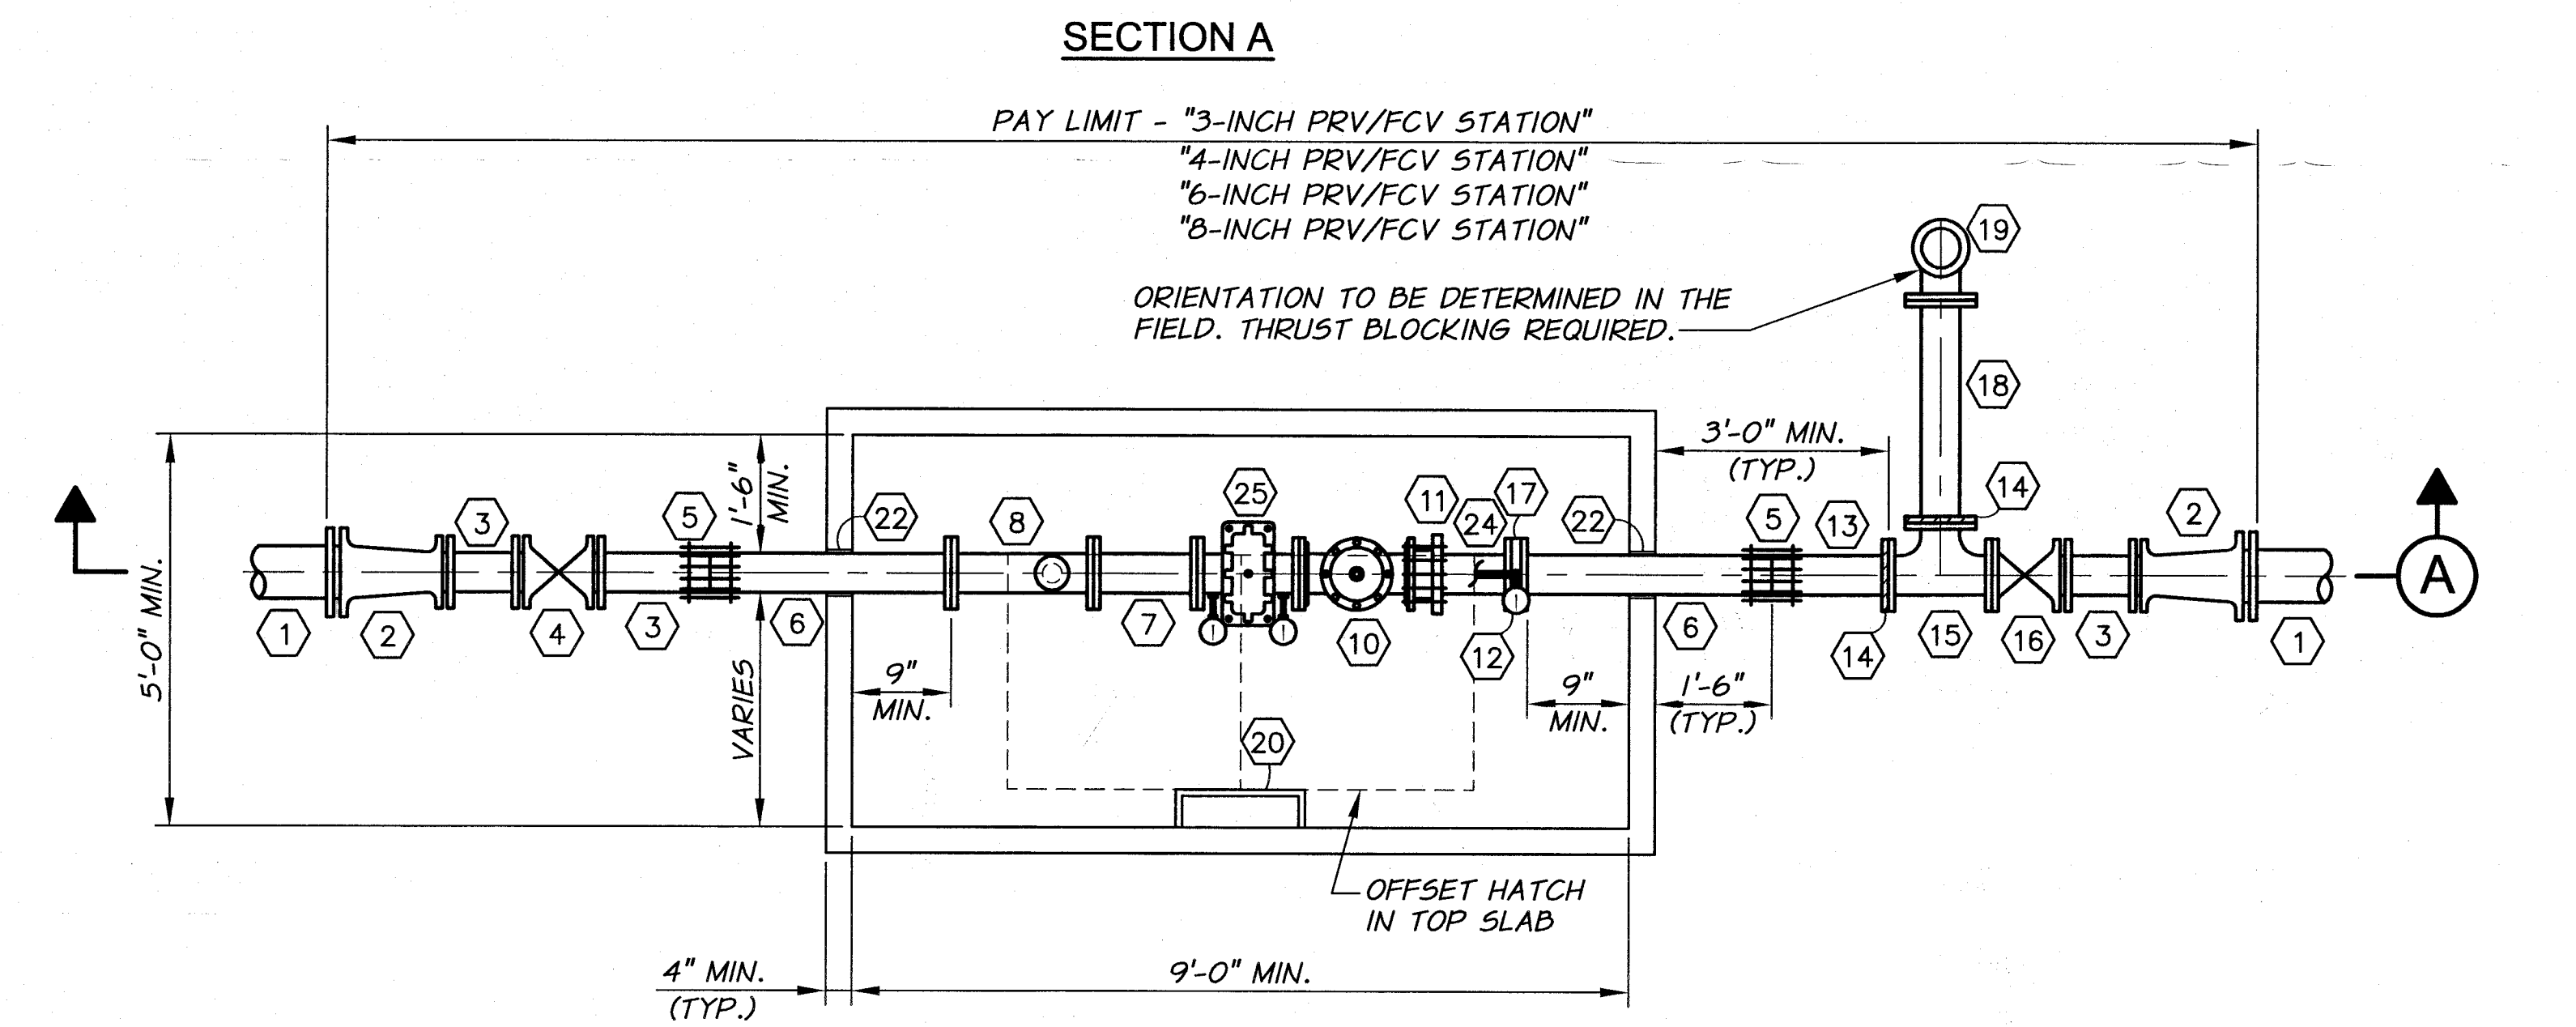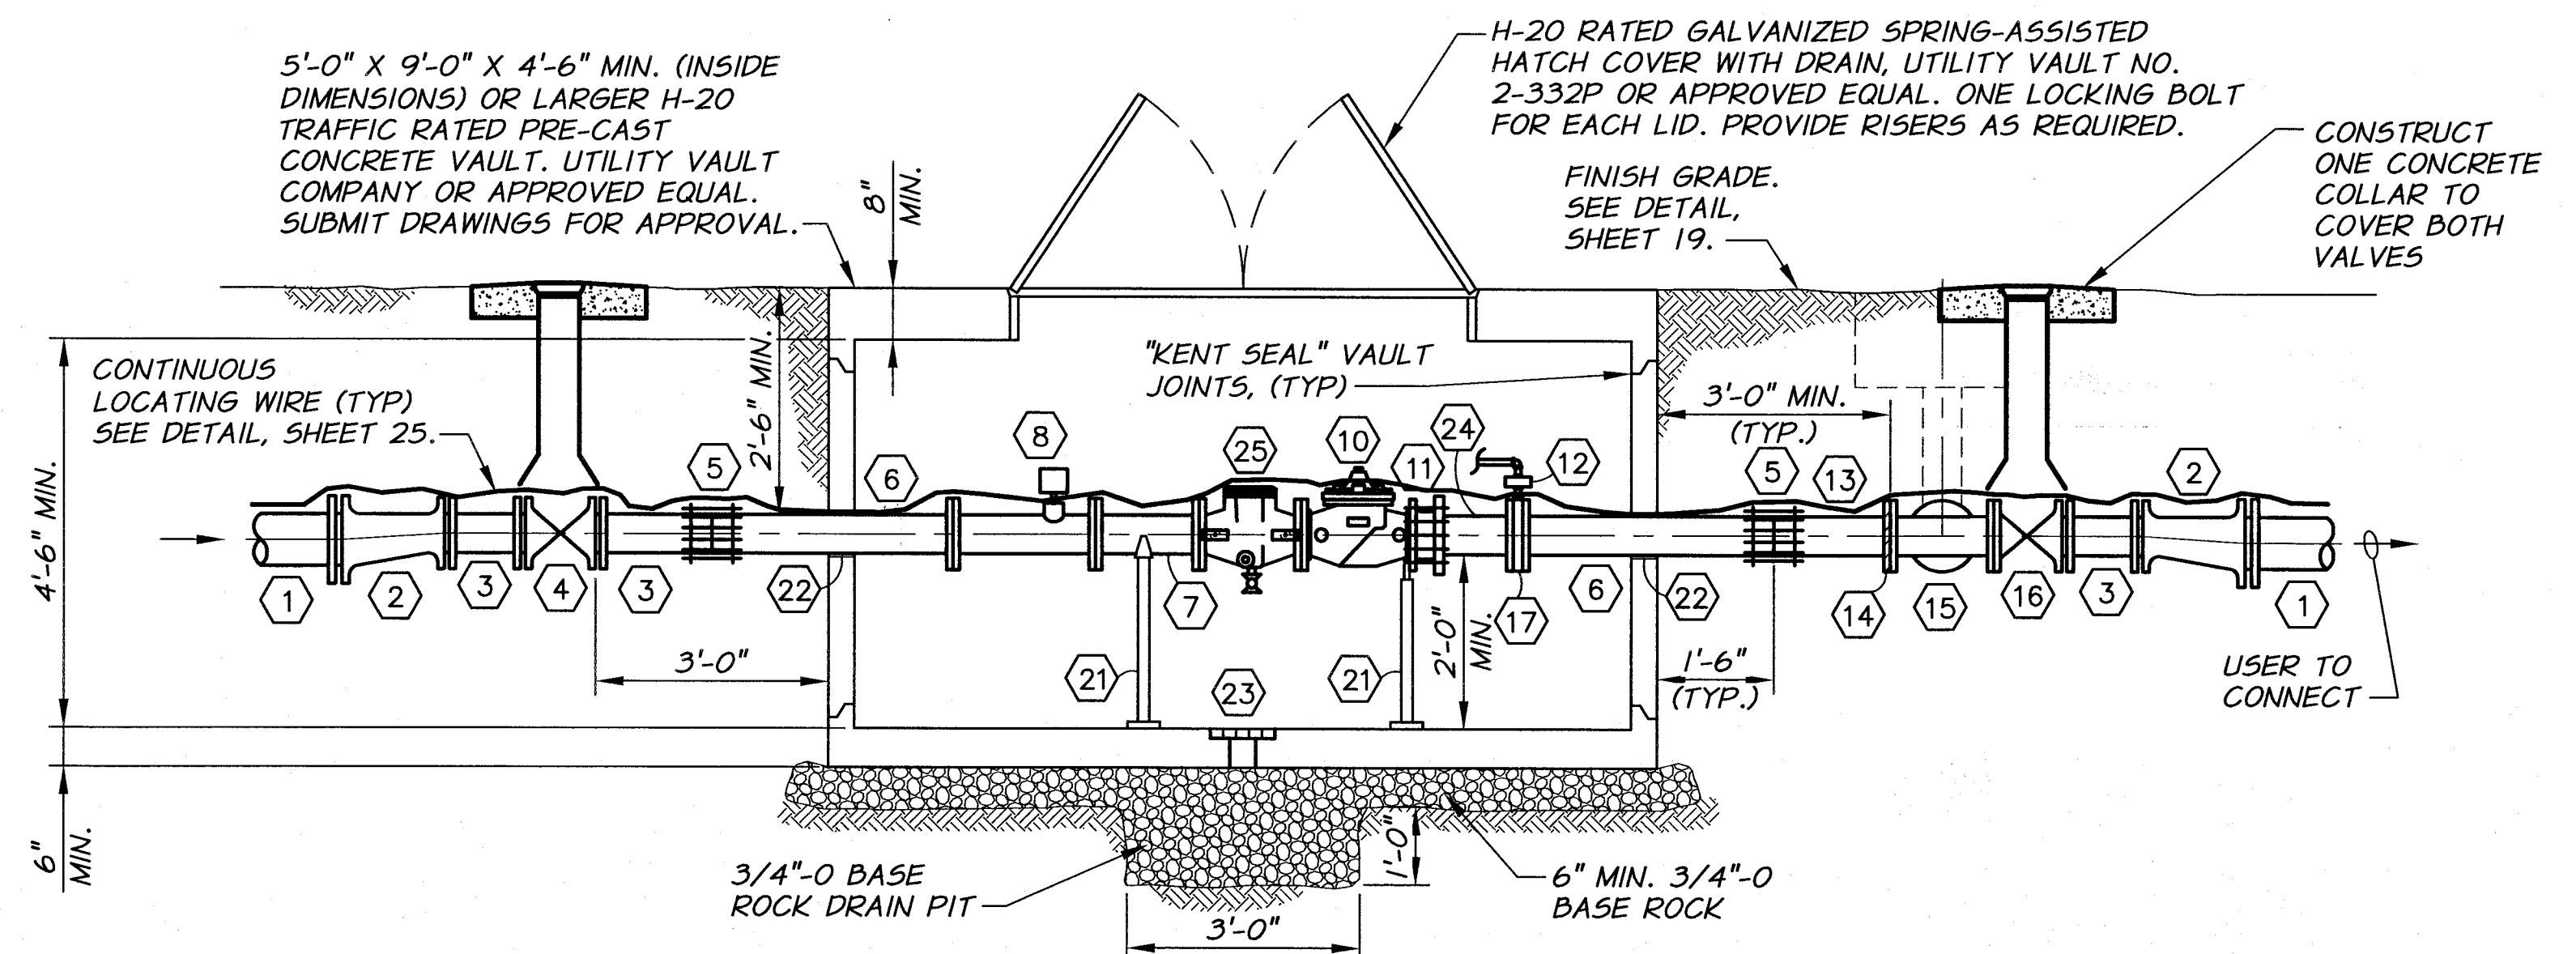


- NOTES:**
1. PIPING SIZE TO MATCH CONTROL VALVE SIZE UNLESS OTHERWISE NOTED.
  2. SET FRAME AND COVER TO GRADE AND PROVIDE GRADE RINGS AS REQUIRED.
  3. PIPE SUPPORTS TO BE SIZED APPROPRIATELY FOR PIPE AND INSTALLED PER MANUFACTURER'S RECOMMENDATIONS.
  4. ALL WORK SHOWN IN THIS DETAIL, INCLUDING ANY REQUIRED SURFACE RESTORATION, SHALL BE INCLUDED IN THE "-INCH PRV/FCV STATION" PAY ITEM.

**3" AND 4" PRV/FCV STATION DETAIL**  
N.T.S.




|   |              |      |              |                    |
|---|--------------|------|--------------|--------------------|
| REVISION  | BY           | DATE | HORIZ. SCALE | VERT. SCALE        |
| RECORD DRAWING                                  | B.M.         | 4/14 | NONE         |                    |
| DESIGNED BY                                     | H. MORRISON  |      | JOB NUMBER   | 1199-336           |
| DRAWN BY  | D. CHRISTMAN |      | DATE         | 2013               |
| REVIEWED BY                                     | B. MOORE     |      | ACAD FILE    | VaultDets-PH3C.dwg |
| COPYRIGHT 2013 BY ANDERSON-PERRY & ASSOC., INC. |              |      |              |                    |


**RECORD DRAWINGS**  
APRIL 18, 2014  
These record drawings have been prepared in part, on the basis of information compiled and furnished by others. They may contain some discrepancies and omissions, and do not necessarily represent "exact" field conditions. The Owner and the Engineer accept no responsibility for their accuracy.

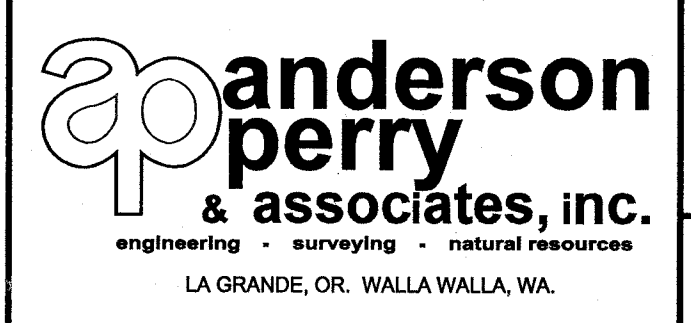

**BENTON IRRIGATION DISTRICT**  
IRRIGATION SYSTEM IMPROVEMENTS  
PHASE 3C  
CONTROL VALVE DETAILS II

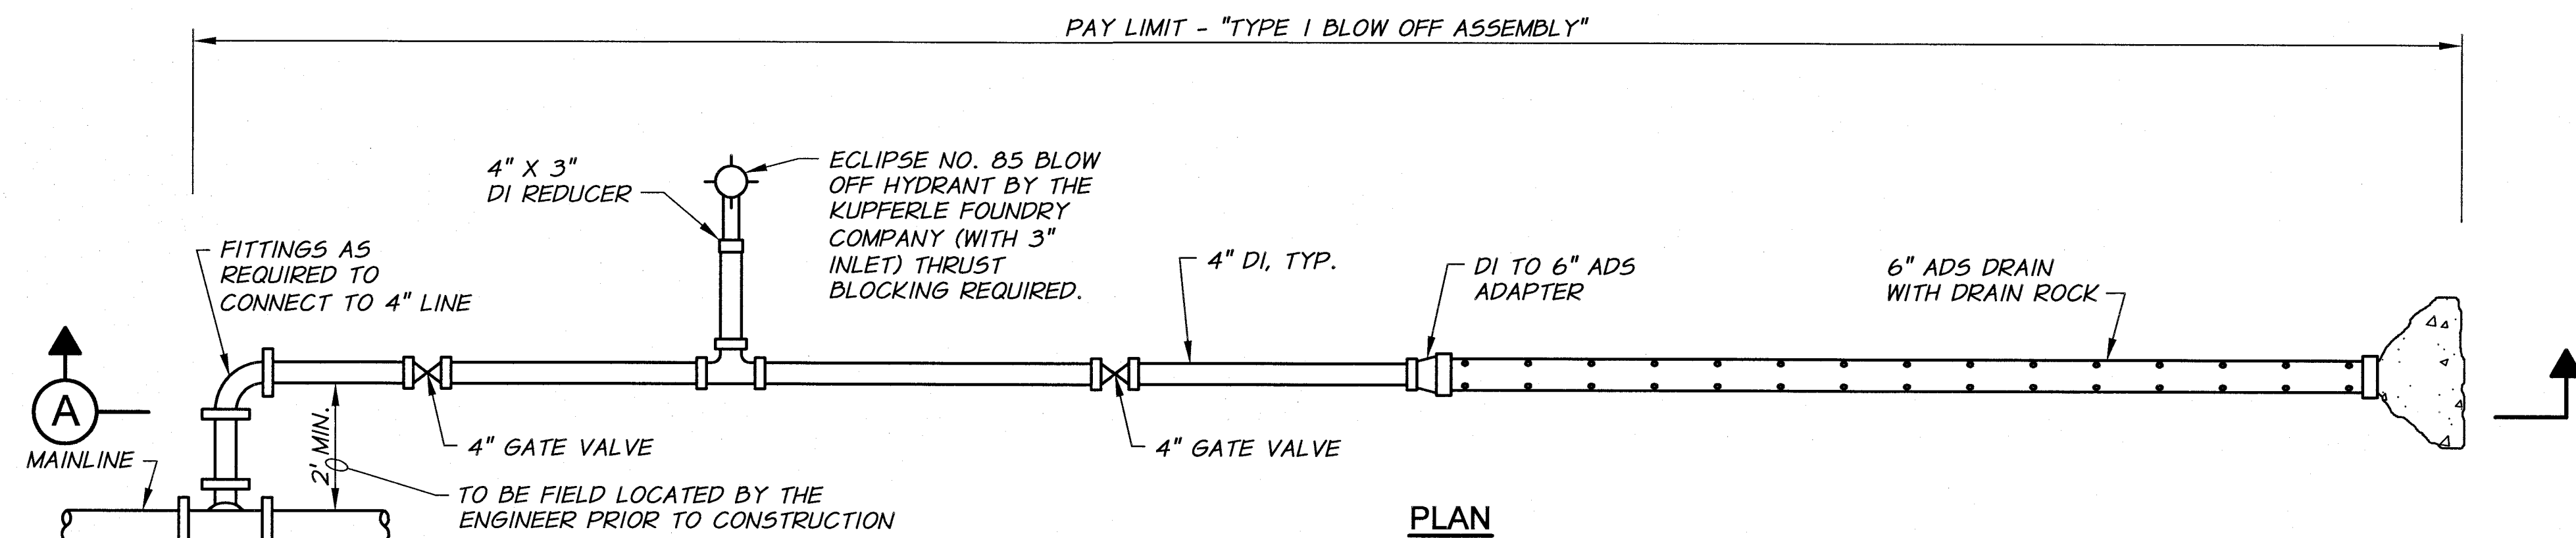

PLAN

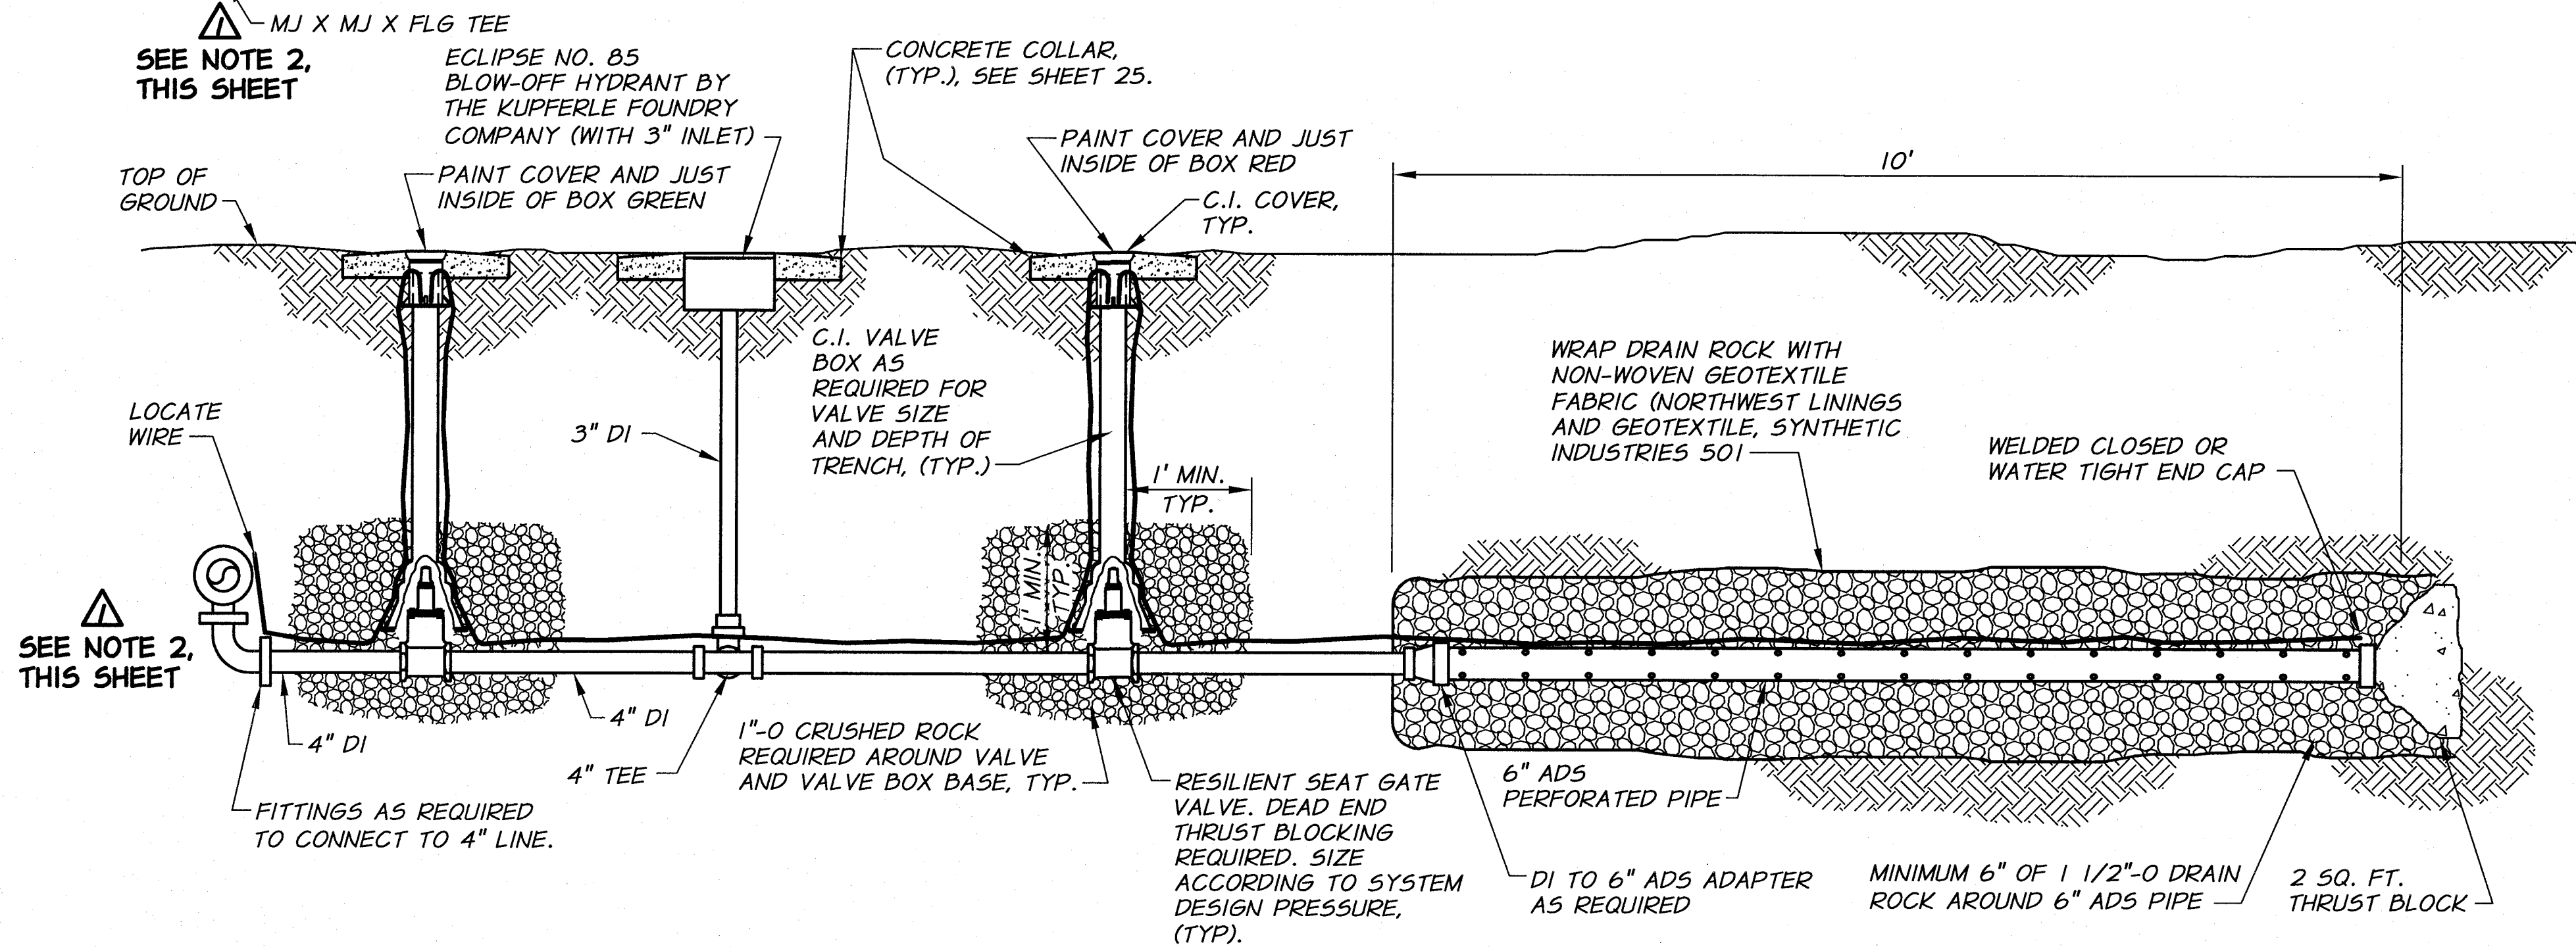


SECTION A

**TYPE 1 BLOW-OFF ASSEMBLY DETAIL**

N.T.S.


**NOTES:**

1. BLOW-OFF TO BE FIELD LOCATED BY THE ENGINEER PRIOR TO CONSTRUCTION (INCLUDING ORIENTATION).
2. FOR 6" AND LARGER MAIN LINE, PROVIDE 90° ELBOW WITH TEE ROTATED 90° AS SHOWN
3. PROVIDE THRUST RESTRAINT ON ALL FITTINGS AND VALVES.

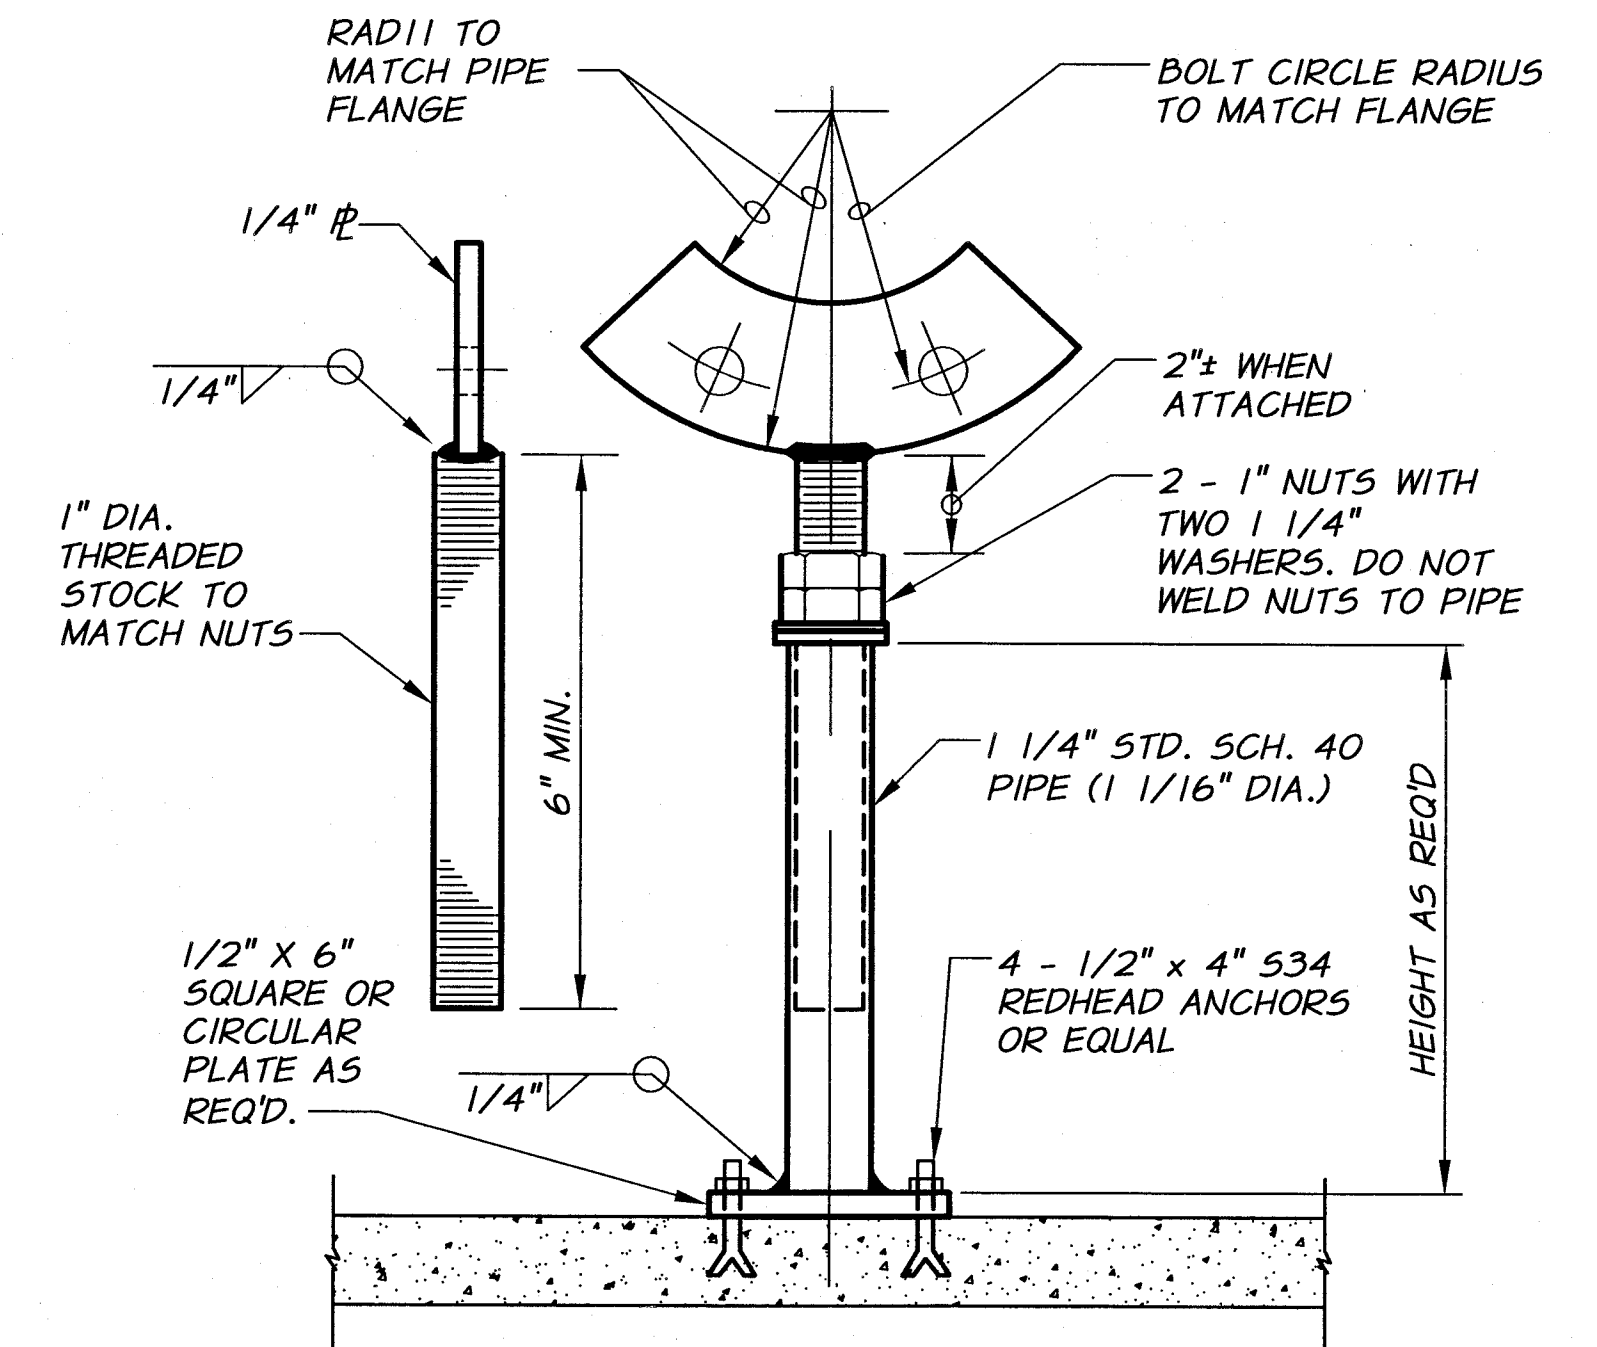


**PIPE SUPPORT DETAIL**

N.T.S.

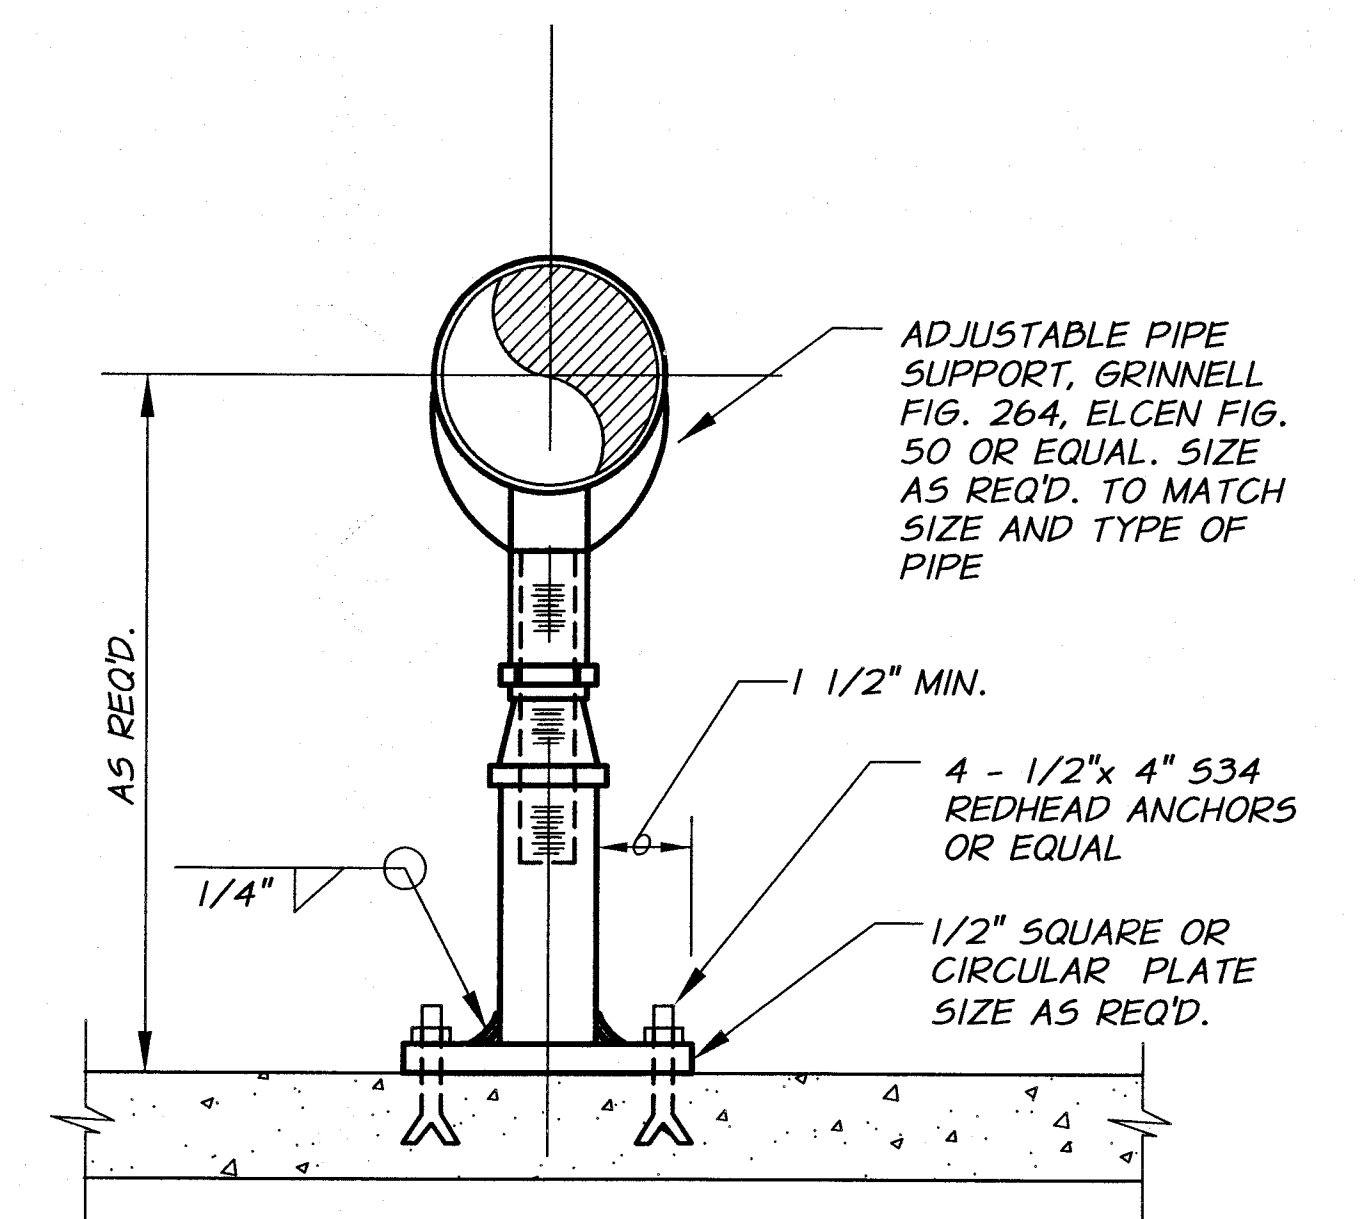

**PIPE SUPPORT DETAIL**


N.T.S.

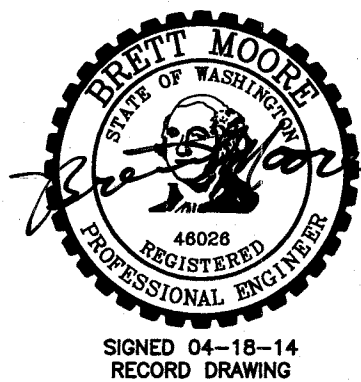

|   |              |             |                   |             |      |
|---|--------------|-------------|-------------------|-------------|------|
| RECORD DRAWING                                  |              | BY          | B.M.              | DATE        | 4/14 |
| DESIGNED BY                                     | H. MORRISON  | HORZ. SCALE | NONE              | VERT. SCALE |      |
| DRAWN BY  | D. CHRISTMAN | JOB NUMBER  | 1199-336          | DATE        | 2013 |
| REVIEWED BY                                     | B. MOORE     | ACAD FILE   | IrrgDets-PH3C.dwg |             |      |
| COPYRIGHT 2013 BY ANDERSON-PERRY & ASSOC., INC. |              |             |                   |             |      |

**RECORD DRAWINGS**  
APRIL 18, 2014

These record drawings have been prepared, in part, on the basis of information compiled and furnished by others. They may contain some discrepancies and omissions, and do not necessarily represent "exact" field conditions. The Owner and the Engineer accept no responsibility for their accuracy.


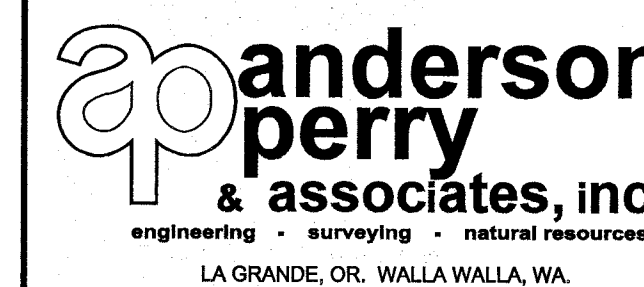


**BENTON IRRIGATION DISTRICT**  
IRRIGATION SYSTEM IMPROVEMENTS  
PHASE 3C

MISCELLANEOUS DETAILS I


SHEET

**23**

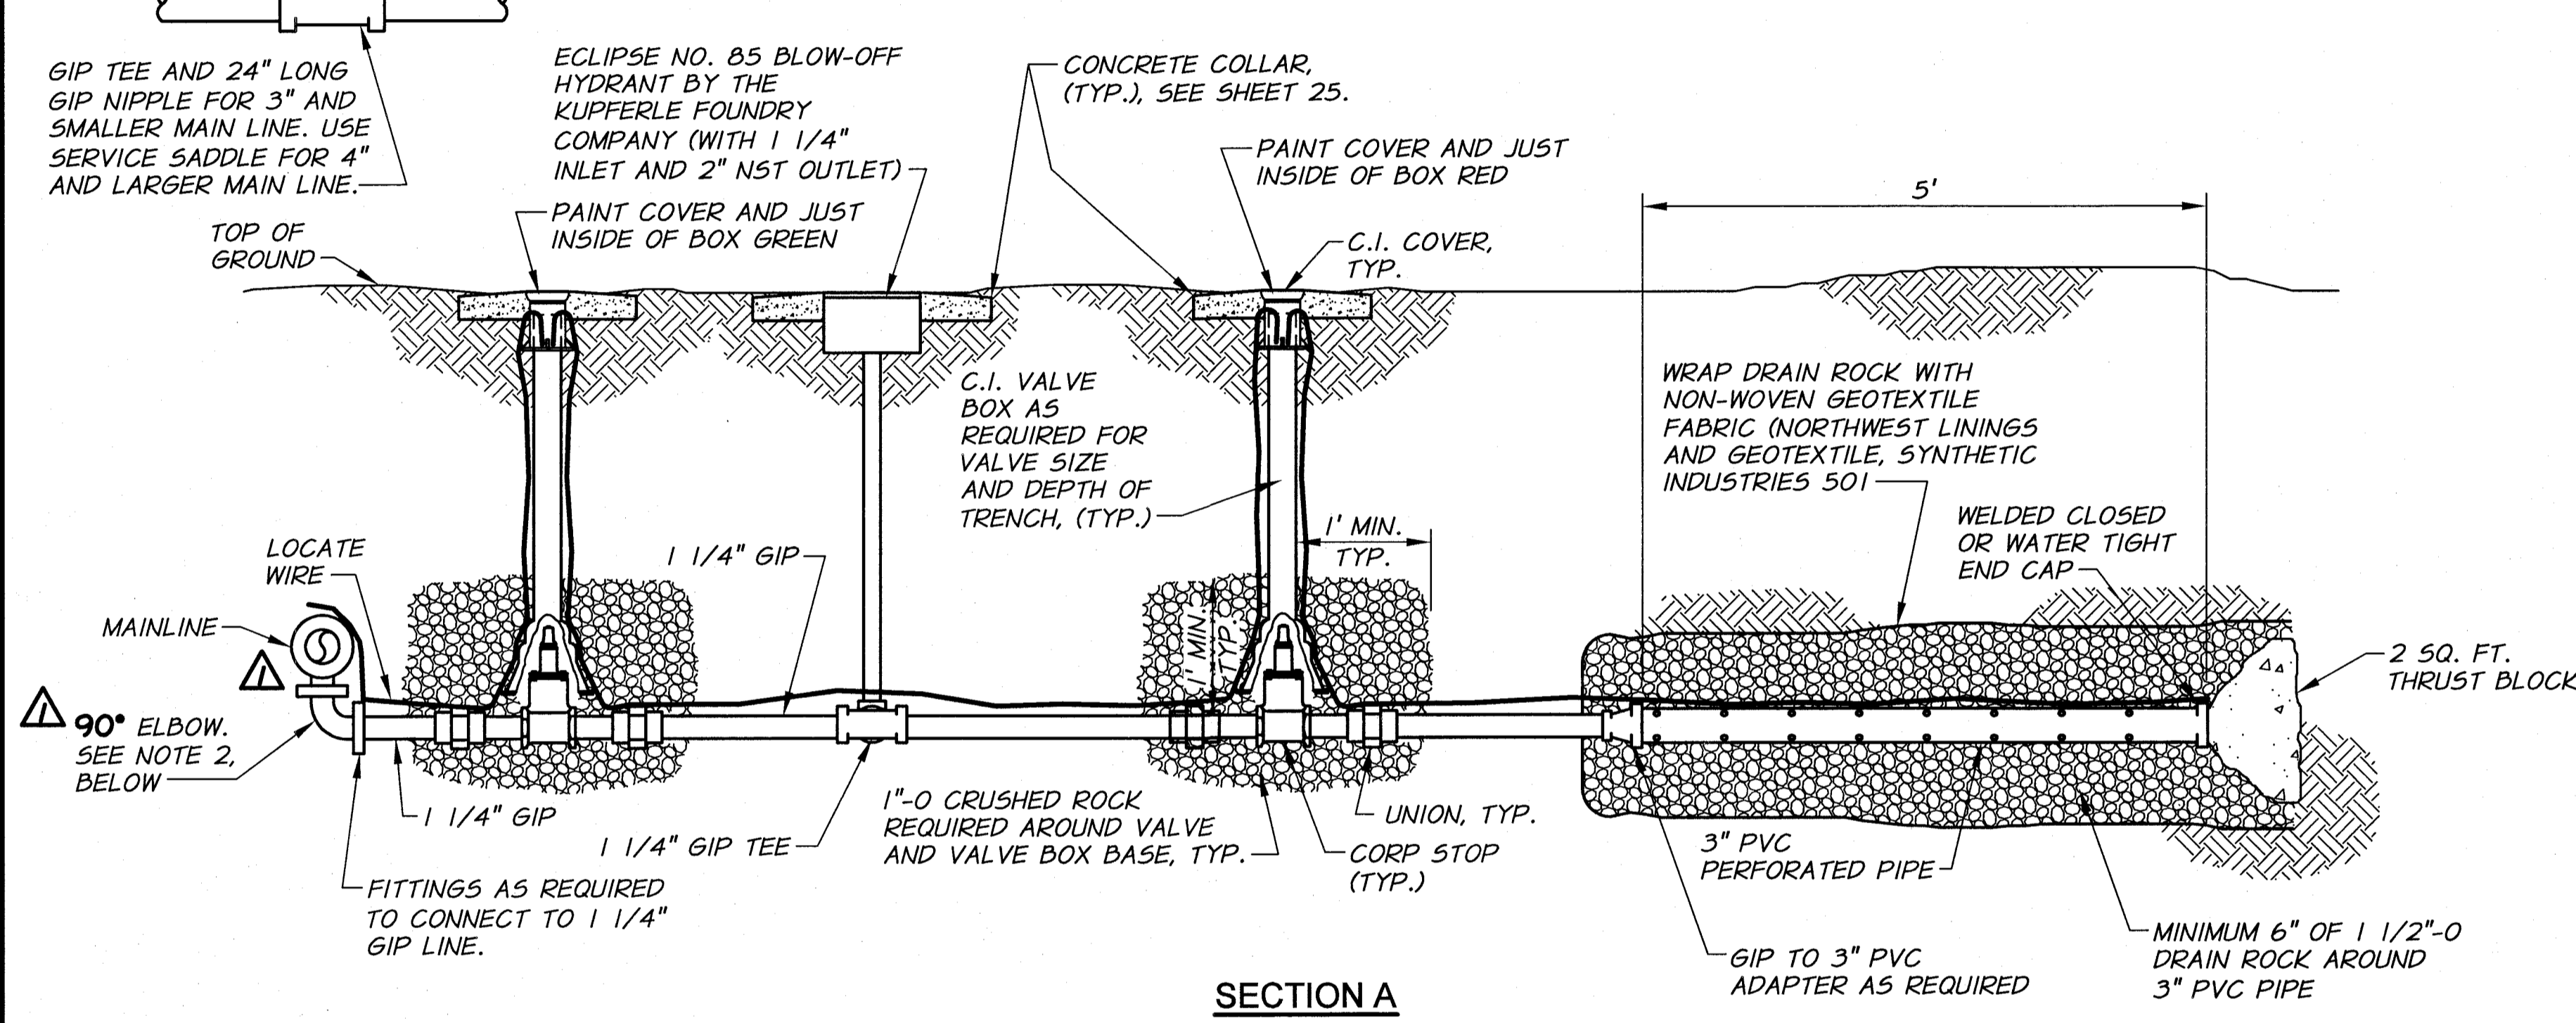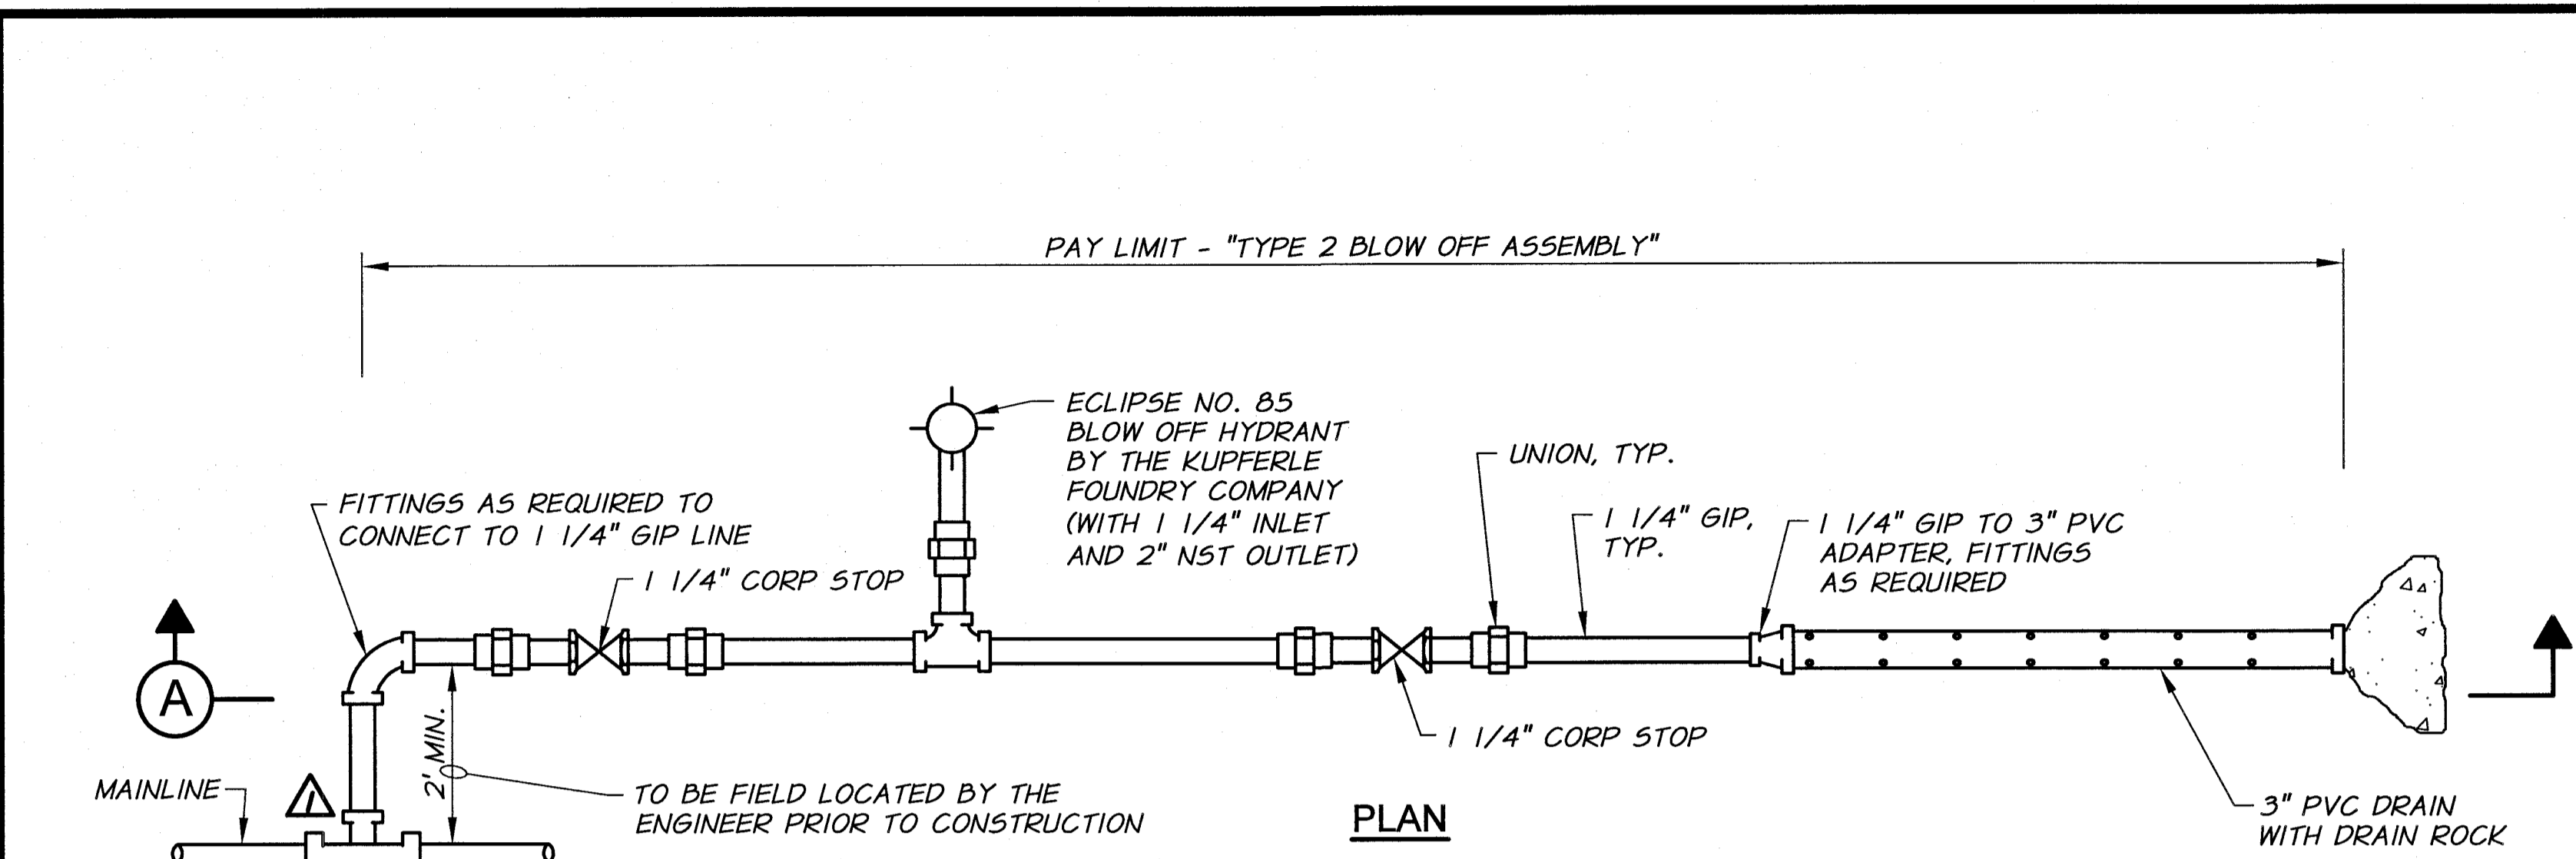

- NOTES:**
1. BLOW-OFF TO BE FIELD LOCATED BY THE ENGINEER PRIOR TO CONSTRUCTION (INCLUDING ORIENTATION).
  2. FOR 3" AND LARGER MAIN LINE, PROVIDE 90° ELBOW WITH TEE ROTATED 90° AS SHOWN. THIS FEATURE NOT REQUIRED FOR MAIN LINE SIZE SMALLER THAN 3".
  3. CORP STOP SHALL BE 1/4 TURN WITH STOPS AND 2" DRIVE NUTS.

**TYPE 2 BLOW-OFF ASSEMBLY DETAIL**  
N.T.S.

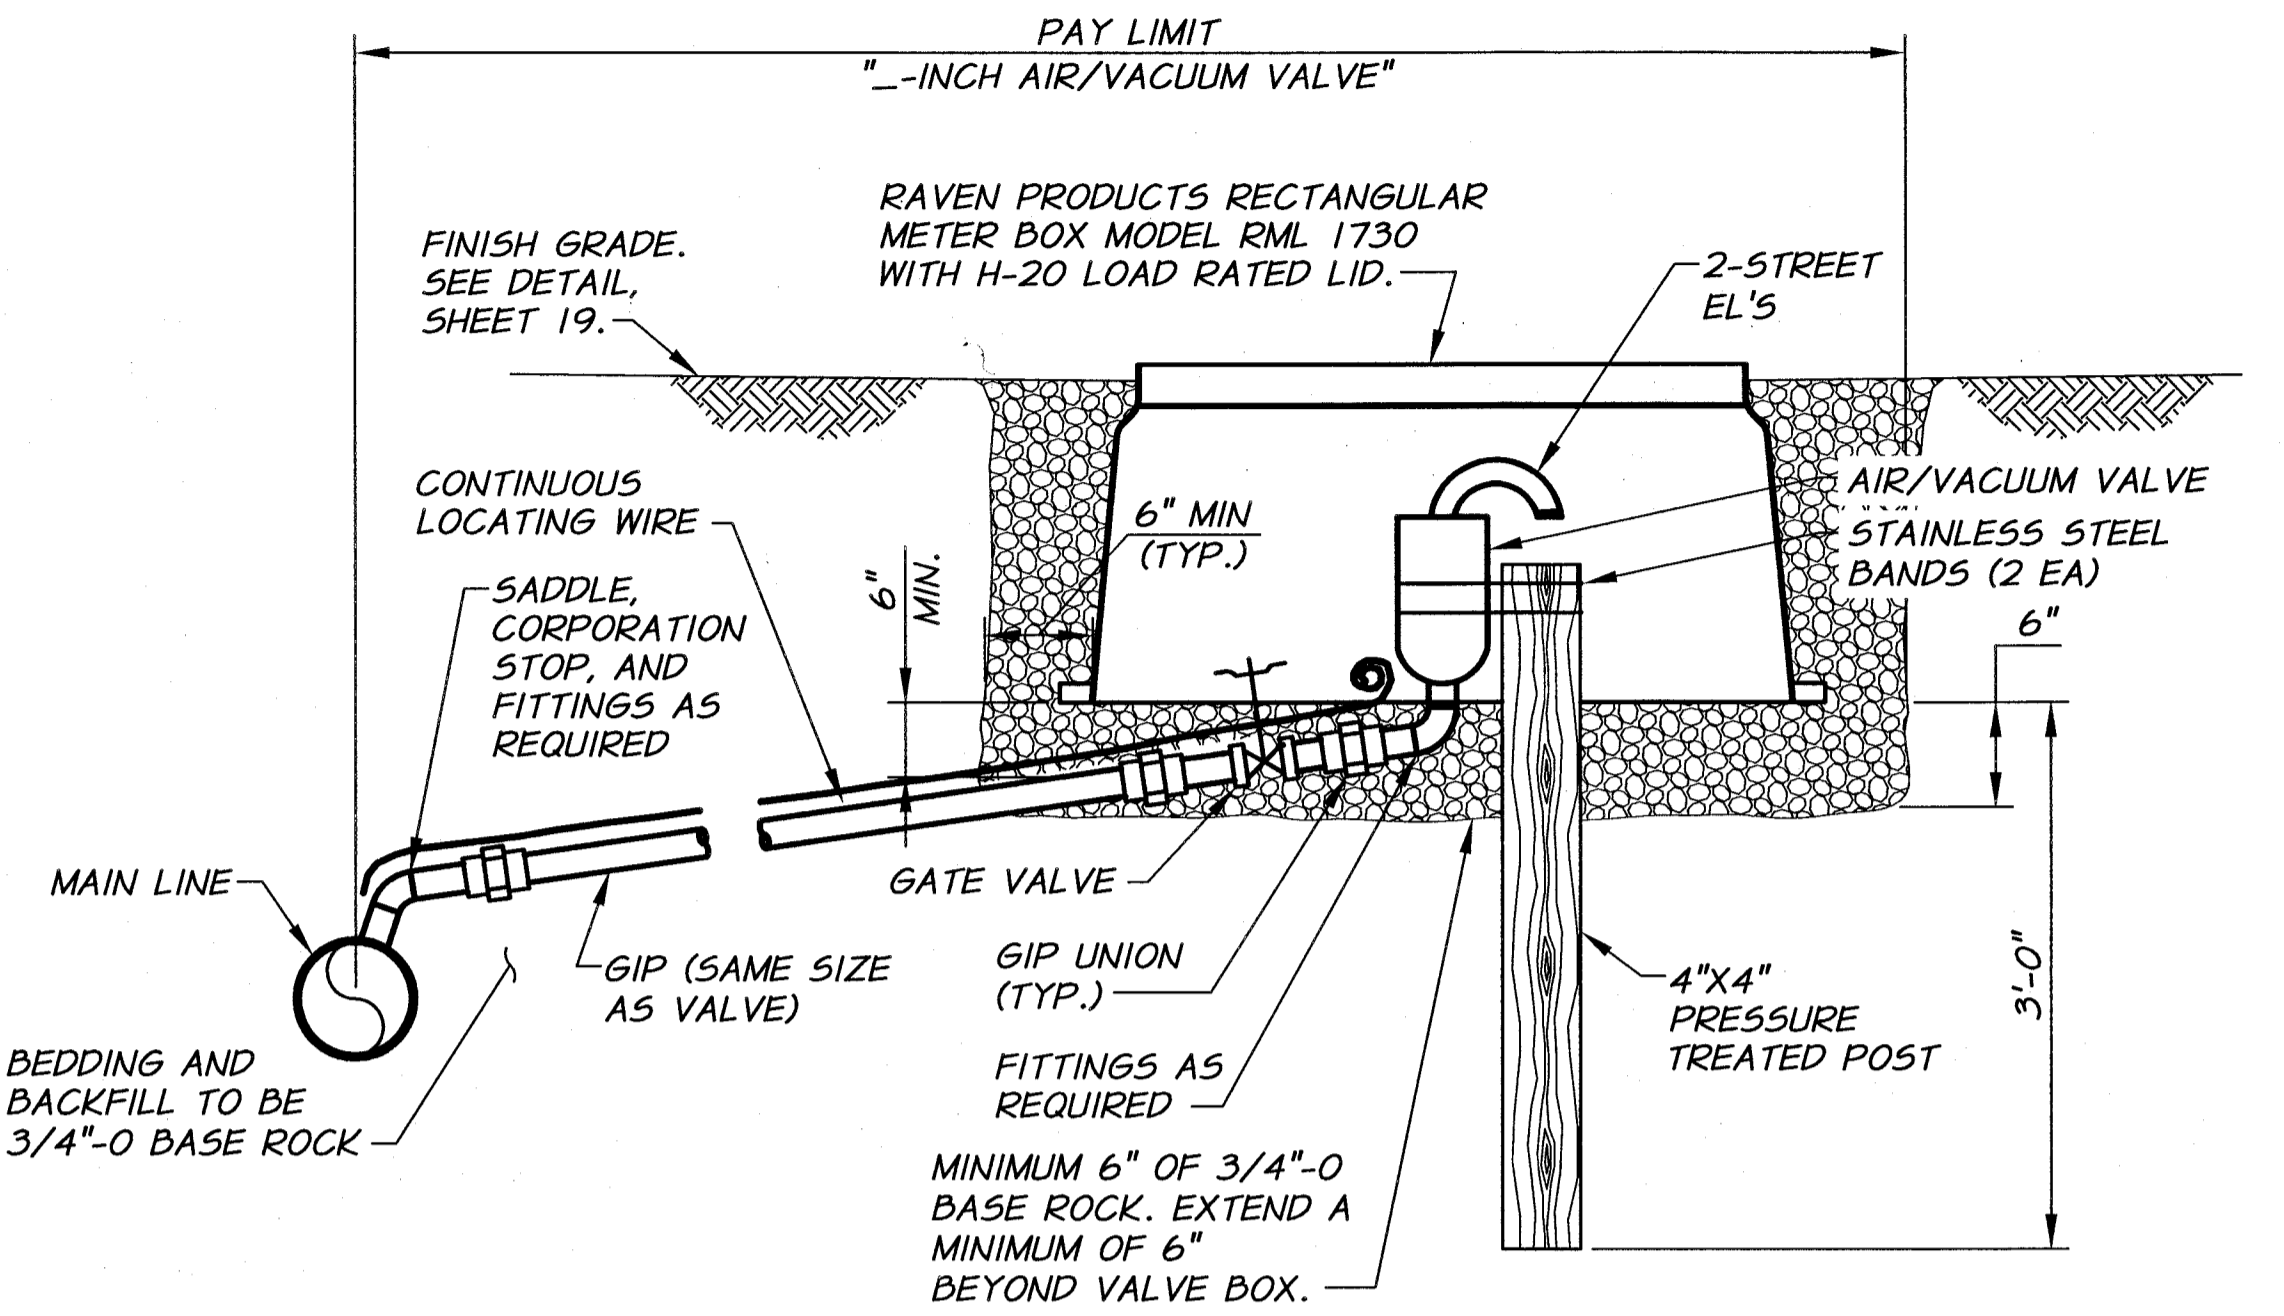


**TABLE 1**

| AIR/VAC SIZE | NO. OF HOLES | HOLE DIAMETER |
|--------------|--------------|---------------|
| 2"           | 5            | 1"            |
| 1"           | 2            | 1"            |
| 1/2"         | 1            | 1"            |


- NOTES:**
1. BOX TO BE FIELD LOCATED BY THE ENGINEER PRIOR TO CONSTRUCTION.
  2. CONTRACTOR SHALL DRILL HOLES INTO THE BOX LID ACCORDING TO TABLE 1, THIS SHEET. LOCATION OF DRILL HOLES SHALL BE AS DESIGNATED BY THE ENGINEER.

**AIR / VACUUM VALVE**  
N.T.S.

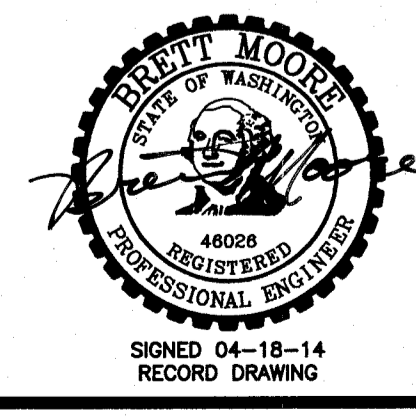

|   |              |             |                   |
|---|--------------|-------------|-------------------|
| RECORD DRAWING                                  |              | B.M.        | 4/14              |
| DESIGNED BY                                     | H. MORRISON  | HORZ. SCALE | NONE              |
| DRAWN BY  | D. CHRISTMAN | VERT. SCALE |                   |
| REVIEWED BY                                     | B. MOORE     | JOB NUMBER  | 1199-336          |
|   |              | DATE        | 2013              |
|   |              | ACAD FILE:  | lrrgDets-PH3C.dwg |
| COPYRIGHT 2013 BY ANDERSON-PERRY & ASSOC., INC. |              |             |                   |


**RECORD DRAWINGS**  
APRIL 18, 2014  
These record drawings have been prepared, in part, on the basis of information compiled and furnished by others. They may contain some discrepancies and omissions, and do not necessarily represent "exact" field conditions. The Owner and the Engineer accept no responsibility for their accuracy.

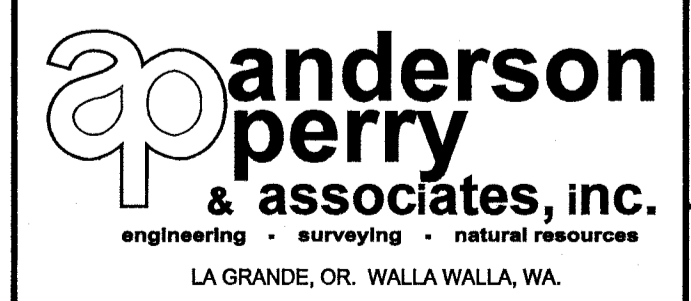

**BENTON IRRIGATION DISTRICT**  
IRRIGATION SYSTEM IMPROVEMENTS  
PHASE 3C  
MISCELLANEOUS DETAILS II




THE TOP 18" OF TOPSOIL IN THE EXCAVATION AREA SHALL BE REMOVED AND STOCKPILED AT A SEPARATE LOCATION FROM GENERAL TRENCH EXCAVATION. THIS TOPSOIL SHALL NOT BE MIXED OR CONTAMINATED WITH ANY OTHER MATERIAL. UPON COMPLETION OF THE TRENCH BACKFILL, AND AFTER ALL ROCKS AND UNSUITABLE MATERIAL HAVE BEEN REMOVED FROM WORK AREA, THE TOPSOIL SHALL BE REPLACED AND GRADED TO MATCH EXISTING GROUND. THE DISTURBED AREA SHALL THEN BE HYDROSEED ACCORDING TO HYDROSEED RESTORATION.

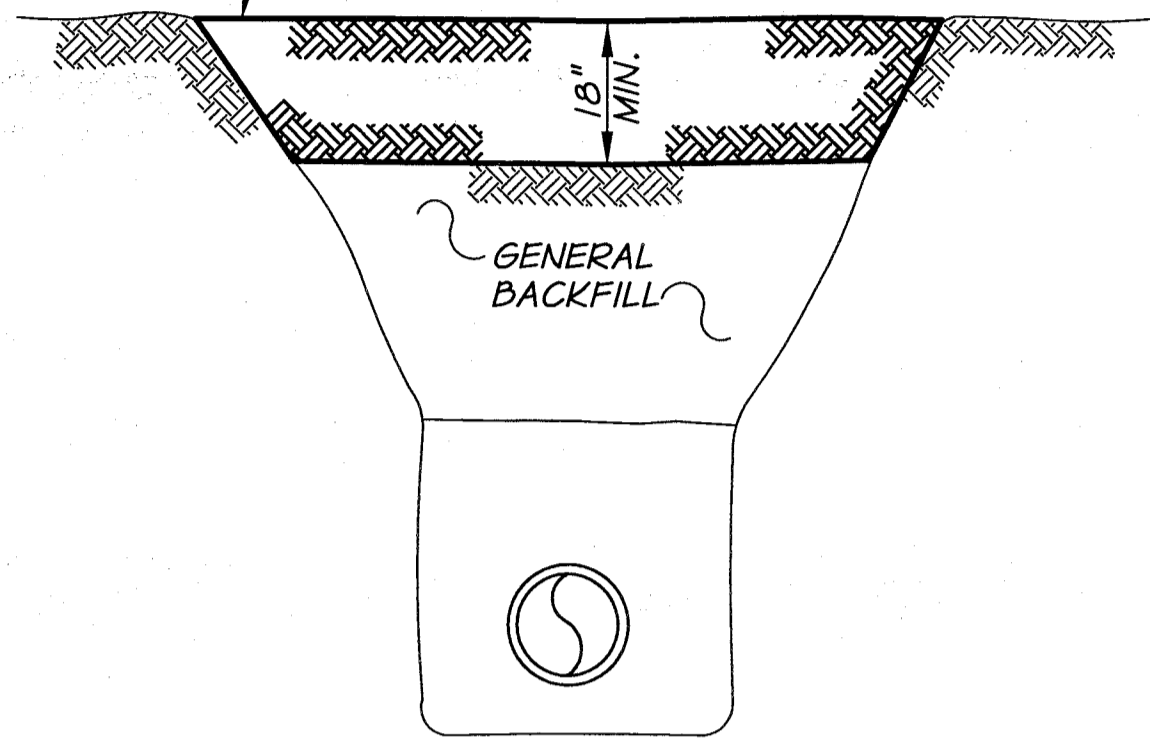


**TRENCH RESTORATION**  
AGRICULTURAL AREAS  
N.T.S.

REMOVE DEBRIS AND ROCK WHICH ARE NOT TYPICAL TO THE AREA. REPLACE TOPSOIL EQUAL TO EXISTING OR 6" WHICH EVER IS GREATER. RAKE AND SHAPE TO MATCH EXISTING. HYDROSEED PER HYDROSEED RESTORATION OR PLACE SOD AS REQUIRED FOR RESTORATION. REPLACE ALL SHRUBS AND SURFACE MATERIALS TO PRE-EXISTING CONDITIONS.

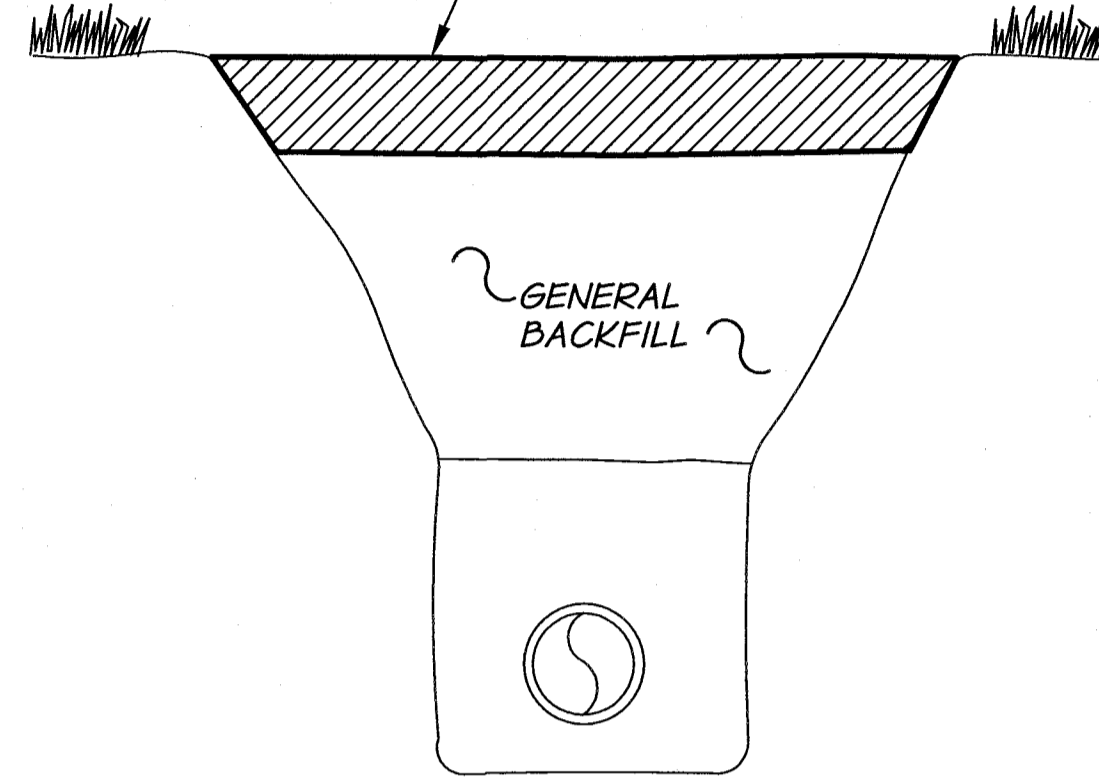


**TRENCH RESTORATION**  
LAWNS & LANDSCAPED AREAS  
N.T.S.

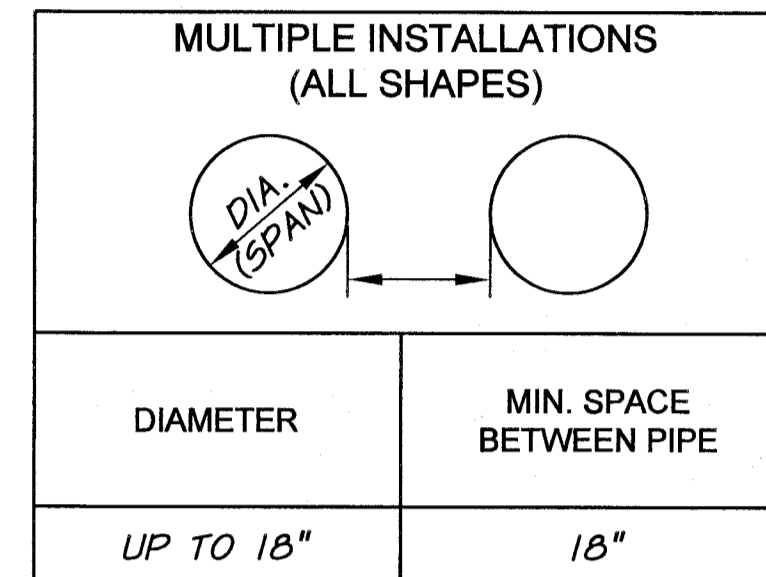


**NOTES**  
1. SURFACING OF PAVED AREAS SHALL COMPLY WITH STREET CUT STANDARD DRAWING.


| TRENCH BACKFILL AND BEDDING TABLE  |                             |   |                                       |
|------------------------------------|-----------------------------|---|---------------------------------------|
|                                    | ASPHALT SURFACE RESTORATION | GRAVEL STREETS, ROADWAYS, SHOULDERS AND PARKING AREAS         | GENERAL / HYDROSEED RESTORATION AREAS |
| <b>SURFACE</b>                     | SURFACING MATCHING EXISTING | 3/4"-0 GRAVEL AGGREGATE (FOR THICKNESS SEE DETAIL THIS SHEET) | TOPSOIL OR AS DIRECTED                |
| <b>BASE MATERIAL UNDER SURFACE</b> | 3/4"-0 BASE ROCK            | GENERAL BACKFILL  | TOPSOIL OR AS DIRECTED                |
| <b>GENERAL BACKFILL</b>            | 3/4"-0 BASE ROCK            | GENERAL BACKFILL  | GENERAL BACKFILL                      |
| <b>SELECT BACKFILL</b>             | 3/4"-0 BASE ROCK            | 3/4"-0 BASE ROCK  | 3/4"-0 BASE ROCK OR APPROVED NATIVE   |
| <b>BEDDING</b>                     | 3/4"-0 BASE ROCK            | 3/4"-0 BASE ROCK  | 3/4"-0 BASE ROCK OR APPROVED NATIVE   |

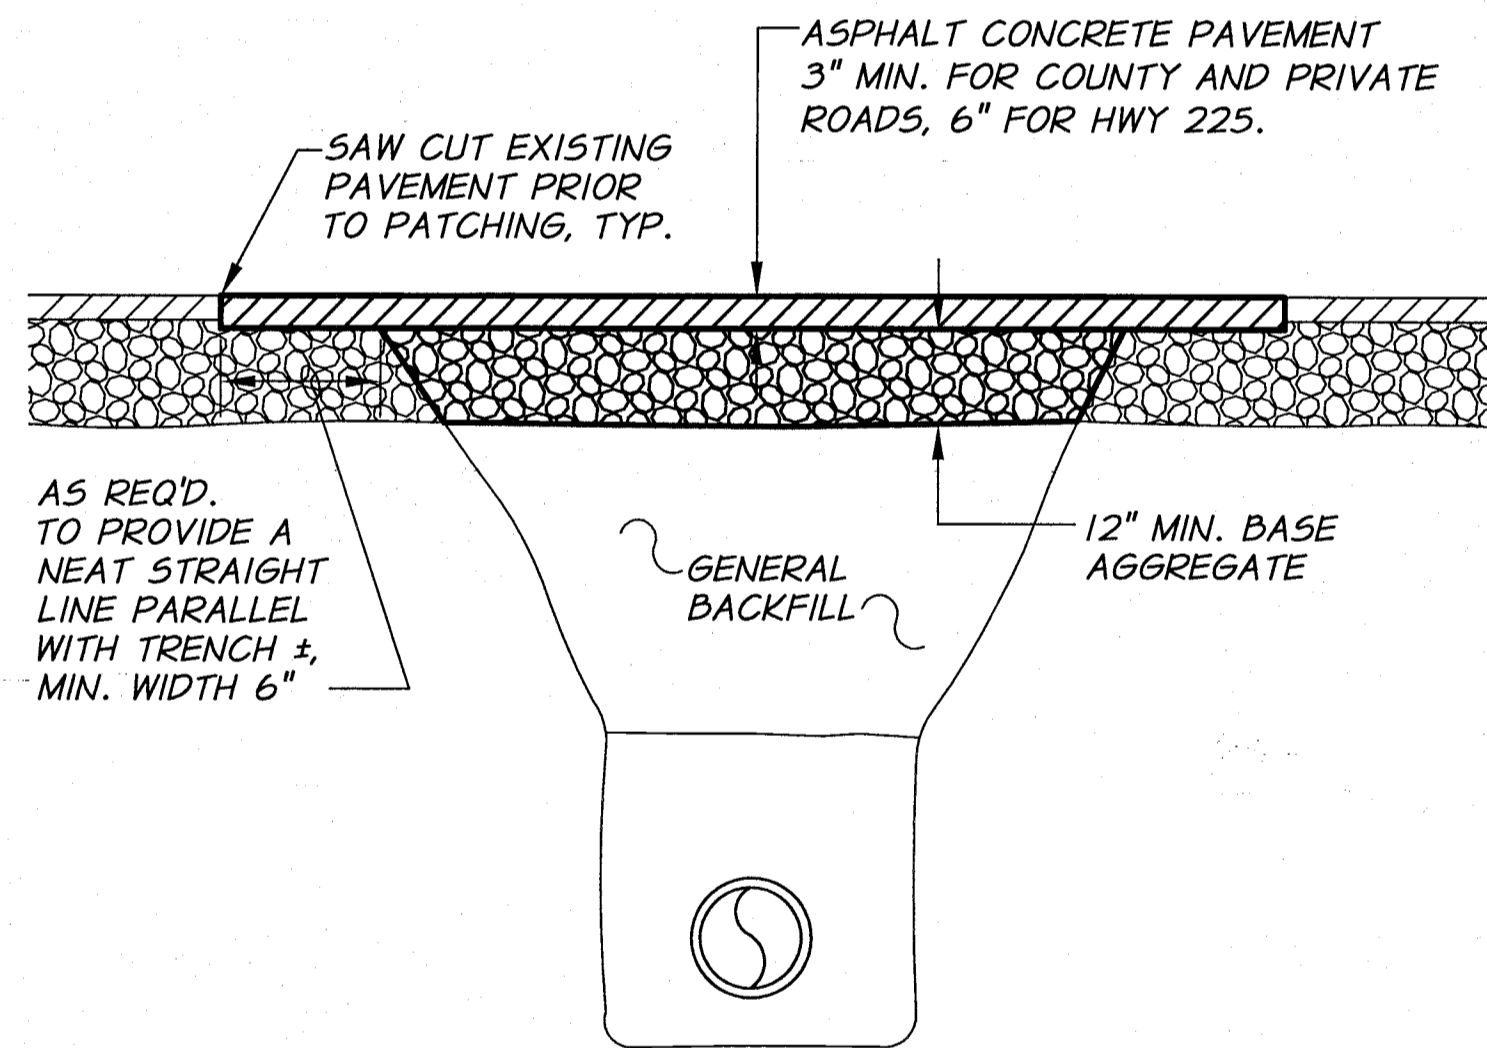


**TRENCH RESTORATION**  
PAVED STREETS AND ROADWAYS  
("ASPHALT SURFACE RESTORATION" PAY ITEM)  
("HWY. 225 ASPHALT RESTORATION" PAY ITEM)  
N.T.S.

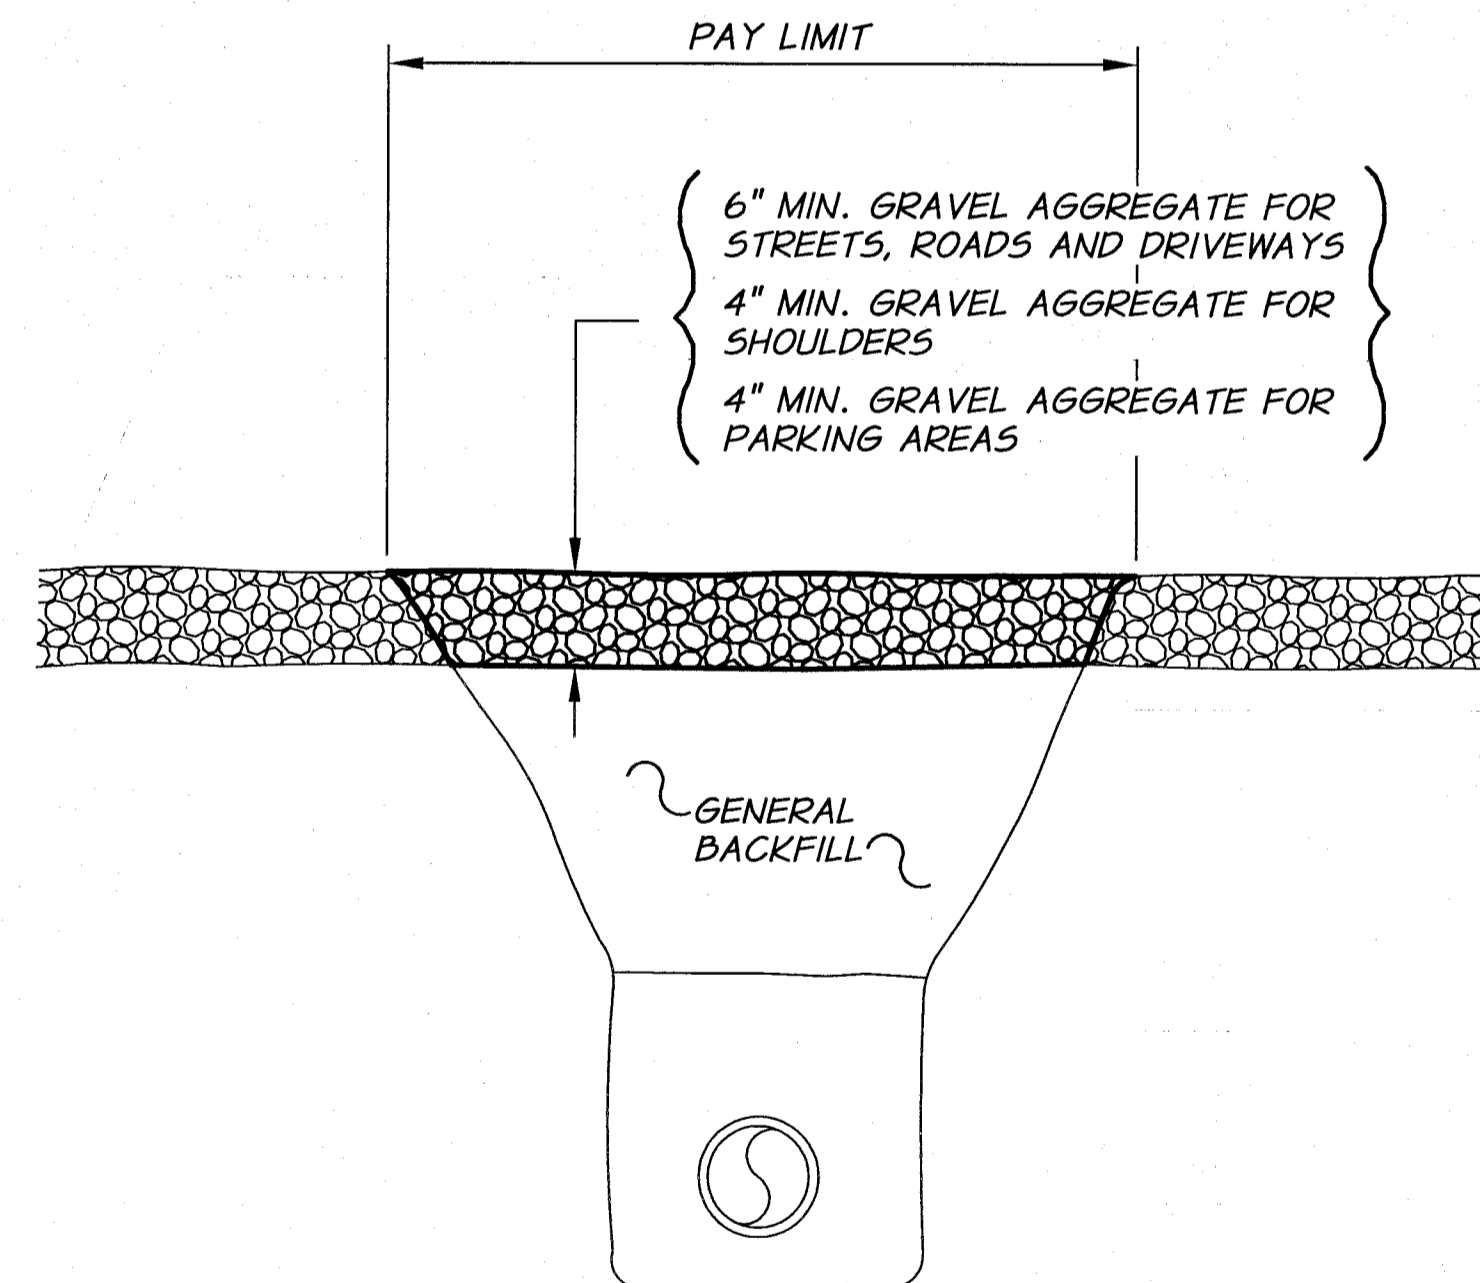


**TRENCH RESTORATION**  
GRAVEL STREETS, ROADWAYS, SHOULDERS, AND PARKING AREAS  
("GRAVEL SURFACE RESTORATION" PAY ITEM)  
N.T.S.

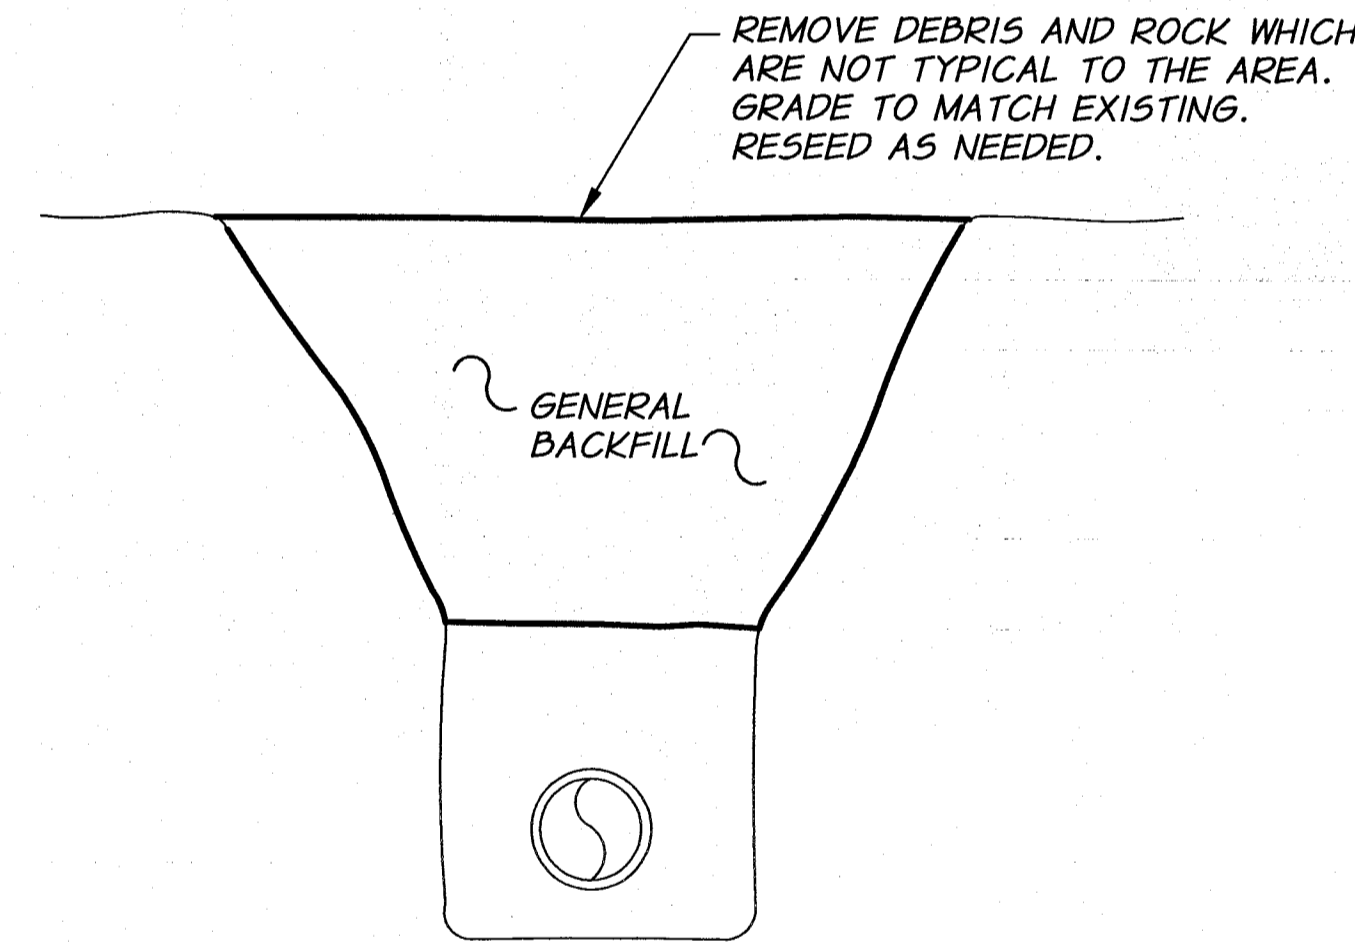

**TRENCH RESTORATION**  
GENERAL AREAS  
N.T.S.

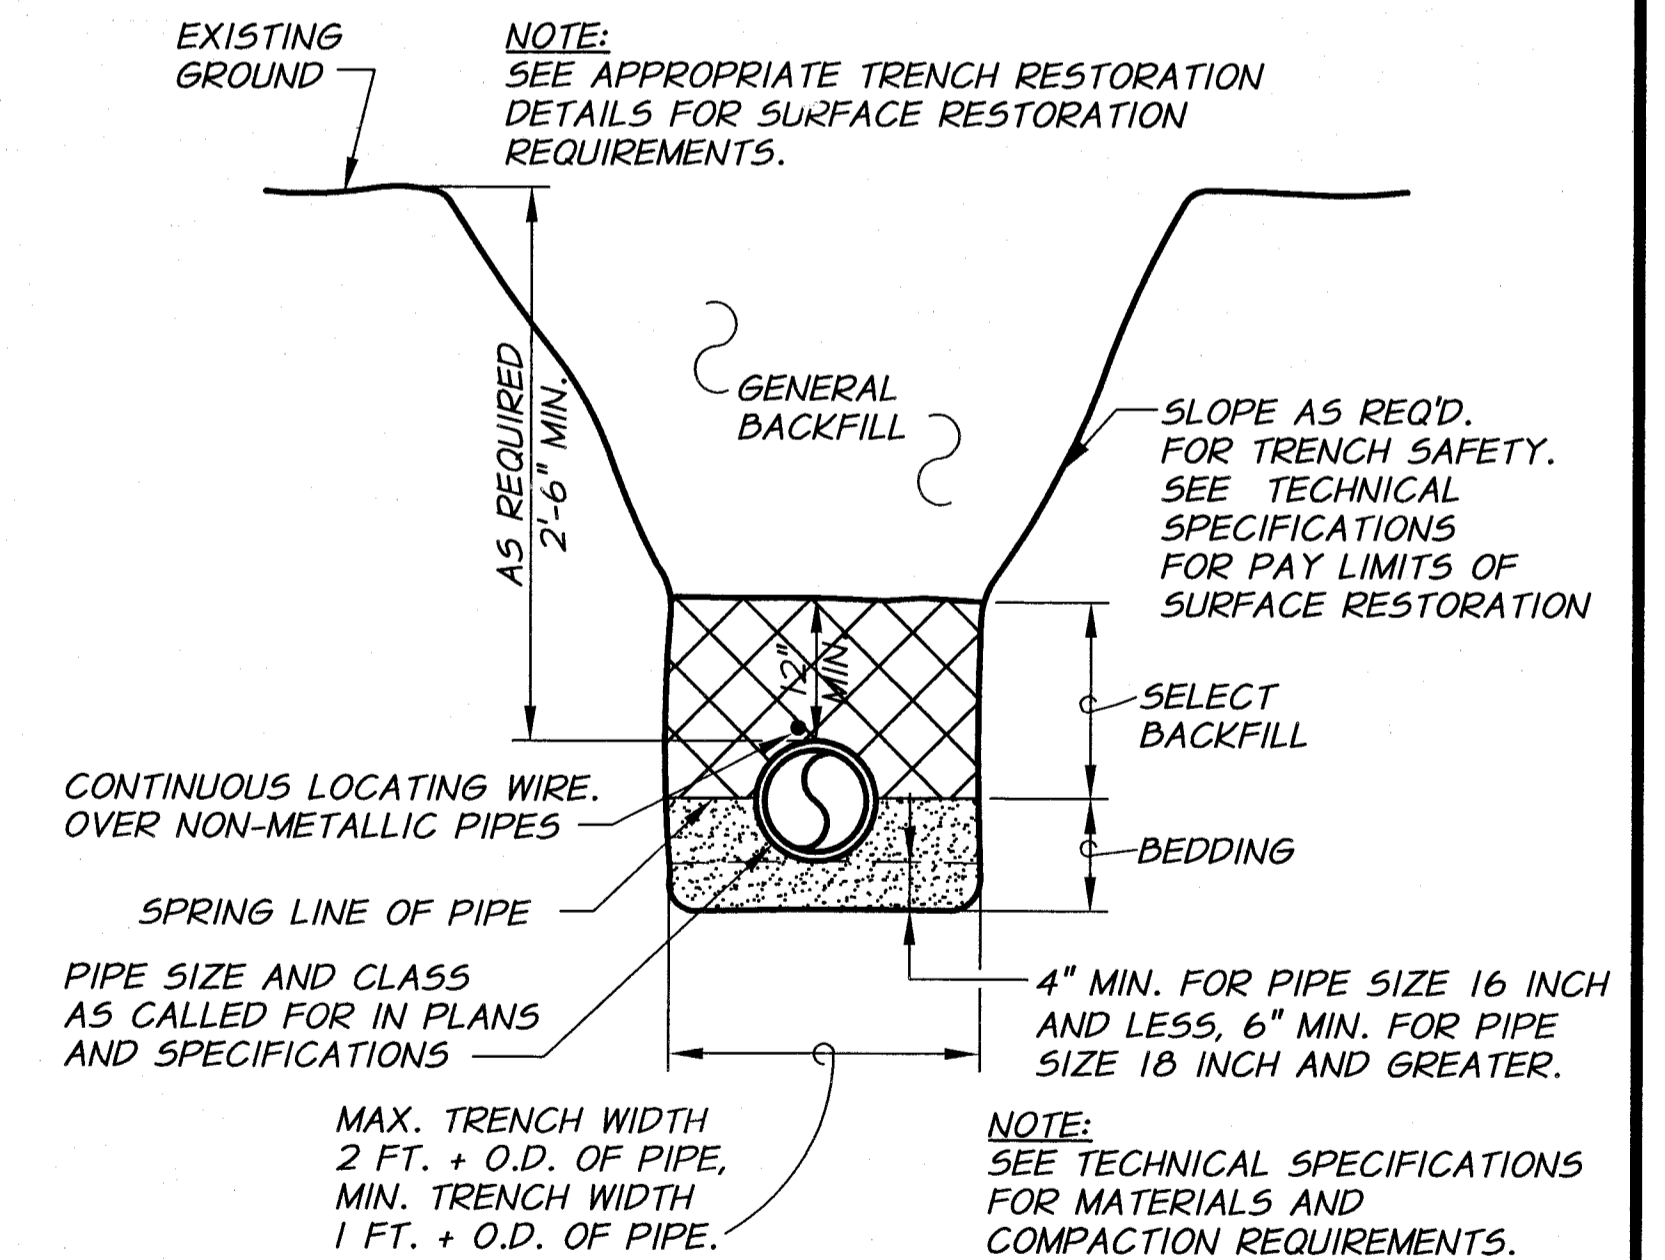


**TRENCH EXCAVATION AND BACKFILL**  
N.T.S.

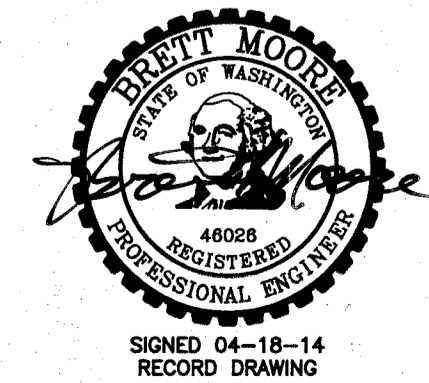

| REVISION  | BY           | DATE | HORIZ. SCALE | VERT. SCALE         |
|---|--------------|------|--------------|---------------------|
| DESIGNED BY                                     | H. MORRISON  |      | NONE         |                     |
| DRAWN BY  | D. CHRISTMAN |      | JOB NUMBER   | 1199-336            |
| REVIEWED BY                                     | B. MOORE     |      | DATE         | 2013                |
|   |              |      | ACAD FILE    | TrenchDets-PH3C.dwg |
| COPYRIGHT 2013 BY ANDERSON-PERRY & ASSOC., INC. |              |      |              |                     |

**RECORD DRAWINGS**  
APRIL 18, 2014

These record drawings have been prepared, in part, on the basis of information compiled and furnished by others. They may contain some discrepancies and omissions, and do not necessarily represent "exact" field conditions. The Owner and the Engineer accept no responsibility for their accuracy.

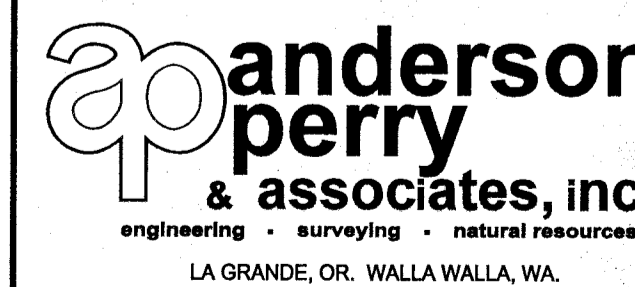

**BENTON IRRIGATION DISTRICT**  
IRRIGATION SYSTEM IMPROVEMENTS  
PHASE 3C

TRENCH DETAILS

SHEET

26

**THRUST BLOCK NOTES**

- THRUST BLOCKS SHALL BE REQUIRED AT THE FOLLOWING LOCATIONS:
  - ALL CHANGES IN DIRECTION.
  - ALL DEAD-ENDS.
  - ALL VALVES 8-INCHES AND LARGER SHALL BE SIZE FOR CLOSED CONDITION EXCEPTIONS:
    - WHEN RESTRAINED JOINT PIPE IS USED ON BOTH SIDES OF VALVE.
    - WHEN VALVE IS RESTRAINED JOINT CONNECTED TO A FITTING WHICH HAS APPROPRIATE THRUST BLOCKING.
  - AT LOCATIONS SPECIFICALLY CALLED OUT ON THE DRAWINGS.
  - AT TEMPORARY DEAD ENDS DURING PIPE INSTALLATIONS AS REQUIRED FOR TEMPORARY PRESSURE TESTING.
  - AT OTHER LOCATIONS REQUIRED BY THE ENGINEER.
- THRUST BLOCKS SHALL BE SIZED AS REQUIRED BY SOIL CONDITIONS AND DESIGN PRESSURE.
- PLACE CONCRETE AGAINST UNDISTURBED TRENCH WALL.
- CONCRETE SHALL BE 2,500 PSI MINIMUM.
- ALL CONCRETE SHALL BE PLACED SO THAT PIPE, FITTING JOINTS, BOLTS AND NUTS, ETC., WILL BE ACCESSIBLE FOR REPAIRS.
- PLACE ONE LAYER OF VISQUEEN BETWEEN FITTING AND CONCRETE TO FACILITATE FUTURE REMOVAL OF THRUST BLOCK IF REQUIRED.
- ANCHOR RODS SHALL BE 3/4" DIAMETER GALVANIZED STEEL RODS OR #6 EPOXY COATED REINFORCEMENT BAR, AASHTO M284, HAVING AN 18" MINIMUM EMBEDMENT IN CONCRETE.
- IF THE REQUIRED BEARING AREA IS LESS THAN 1 SQUARE FOOT, A THRUST BLOCK SHALL NOT BE REQUIRED.
- WHERE THRUST BLOCK IS NOT DESIGNATED, ALL THRUST BLOCKS SHALL BE SIZED PER THE PRESSURES SHOWN IN THE TECHNICAL SPECIFICATIONS, UNLESS OTHERWISE NOTED.

**DETERMINATION OF THRUST BLOCK BEARING AREA**

NOTE: WHEN THRUST BLOCK BEARING AREA IS NOT SPECIFIED ON THE PLANS OR DETERMINED BY THE ENGINEER, THE FOLLOWING PROCEDURE SHALL BE USED TO DETERMINE REQUIRED BEARING AREA.

- DETERMINE THRUST (T) FOR TYPE OF FITTING OR JOINT AND SIZE OF PIPE FROM TABLE NO. 1 OR TABLE NO. 3.
- DETERMINE BEARING CAPACITY (B) OF SOIL FROM TABLE NO. 2.
- DETERMINE REQUIRED BEARING AREA (A) AS FOLLOWS:

$A = T/B$

EXAMPLE: DESIGN PRESSURE = 175 PSI  
 PIPE = 12"  
 FITTING = TEE  
 SOIL - SANDY GRAVEL

FROM TABLE NO. 1: T = 15,050 LB.

FROM TABLE NO. 2: B = 3000 LB/SQ.FT.

A =  $15,050 \times 1.75 = 8.8$  SQ.FT. = 9 SQ.FT. (ROUND UP TO NEAREST 3,000 WHOLE SQ.FT.)

**TABLE NO. 1**  
 THRUST AT FITTINGS IN POUNDS AT 100 PSI OF PRESSURE

| PIPE SIZE | TEES AND DEAD ENDS | 90° BEND | 45° BEND | 22 1/2° BEND | 11 1/4° BEND |
|-----------|--------------------|----------|----------|--------------|--------------|
| 4"        | 1,680              | 2,310    | 1,290    | 660          | 340          |
| 6"        | 3,770              | 5,320    | 2,890    | 1,480        | 750          |
| 8"        | 6,690              | 9,460    | 5,120    | 2,620        | 1,320        |
| 10"       | 10,440             | 14,780   | 8,010    | 4,090        | 2,050        |
| 12"       | 15,050             | 21,280   | 11,520   | 5,880        | 2,960        |
| 14"       | 20,490             | 28,960   | 15,680   | 8,000        | 4,020        |
| 16"       | 26,750             | 37,830   | 20,470   | 10,440       | 5,260        |
| 18"       | 33,850             | 47,870   | 25,910   | 13,210       | 6,640        |
| 20"       | 41,790             | 59,090   | 31,980   | 16,310       | 8,190        |
| 24"       | 60,170             | 85,100   | 46,060   | 23,490       | 11,800       |

NOTE: FOR WATER PRESSURES DIFFERENT THAN 100 PSI, MULTIPLY THRUST FOUND IN TABLE NO. 1 BY REQUIRED PROPORTION.  
 EXAMPLE: DESIGN PRESSURE = 175 PSI.  
 MULTIPLY VALUE IN TABLE BY 1.75







**TABLE NO. 2**

| SOIL                               | SAFE BEARING LOAD LB/SQ.FT. |
|------------------------------------|-----------------------------|
| SOFT CLAY                          | 500                         |
| SILT                               | 1,000                       |
| SAND                               | 2,000                       |
| SAND AND GRAVEL                    | 3,000                       |
| SAND AND GRAVEL CEMENTED WITH CLAY | 4,000                       |
| HARD CLAY                          | 4,000                       |

**TABLE NO. 3**


| SIDE THRUST PER 100 LB./SQ.IN. PRESSURE PER DEGREE OF DEFLECTION |                |           |                |
|--|----------------|-----------|----------------|
| PIPE SIZE  | SIDE THRUST-LB | PIPE SIZE | SIDE THRUST-LB |
| 4"   | N/A            | 14"       | 360            |
| 6"   | N/A            | 16"       | 470            |
| 8"   | N/A            | 18"       | 600            |
| 10"  | 190            | 20"       | 730            |
| 12"  | 270            | 24"       | 1,050          |

MULTIPLY THRUST BY DEGREE OF DEFLECTION TO OBTAIN TOTAL THRUST

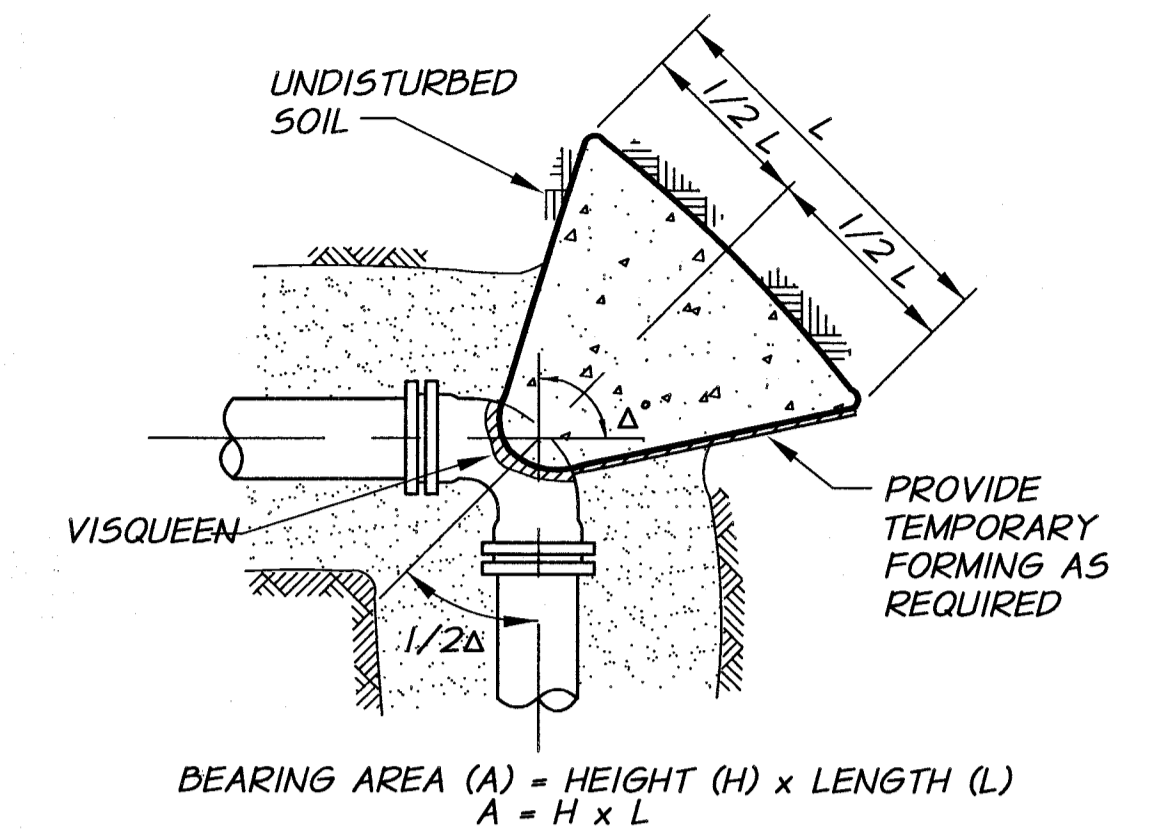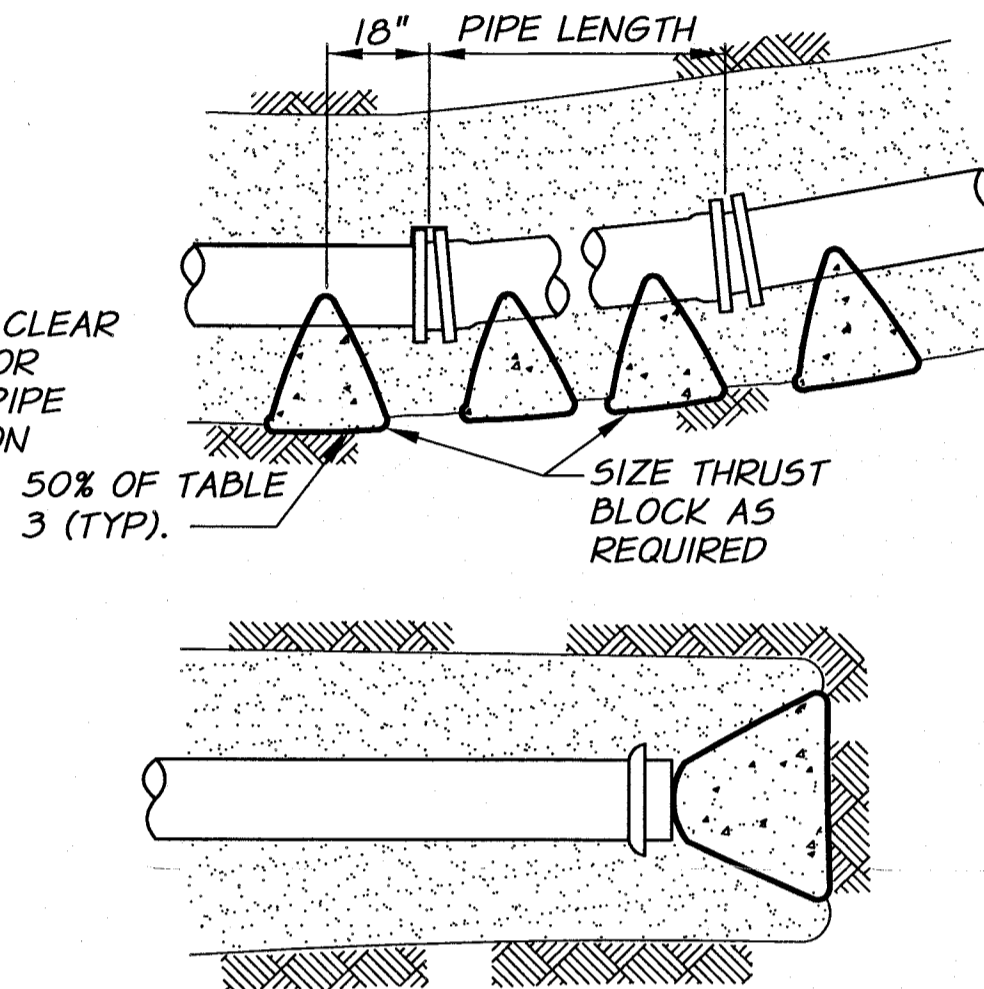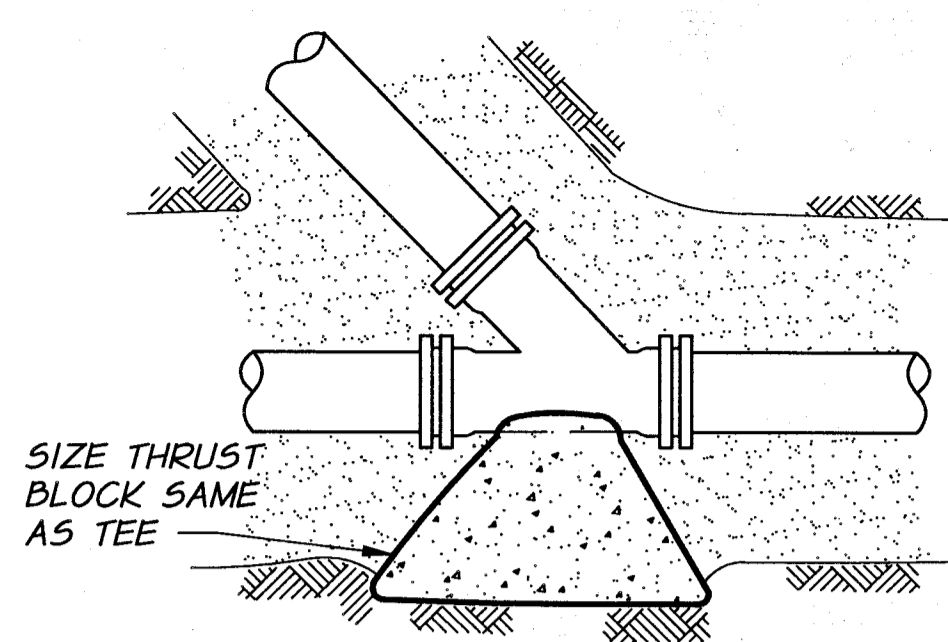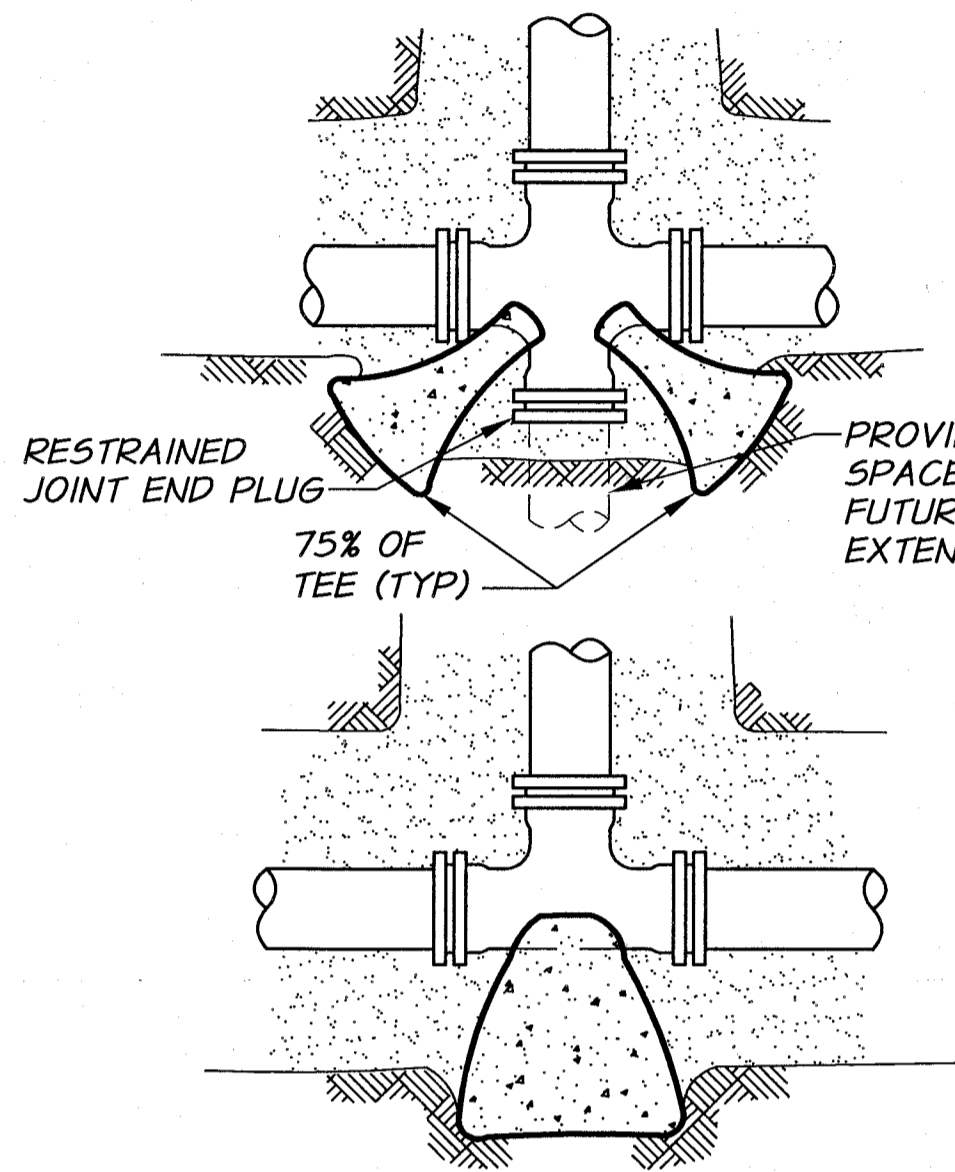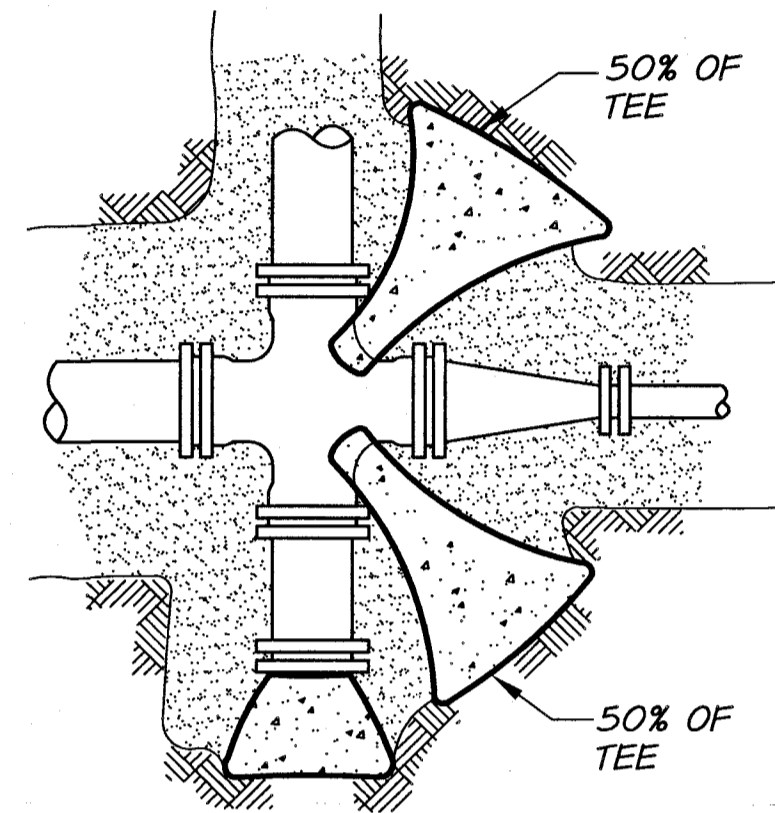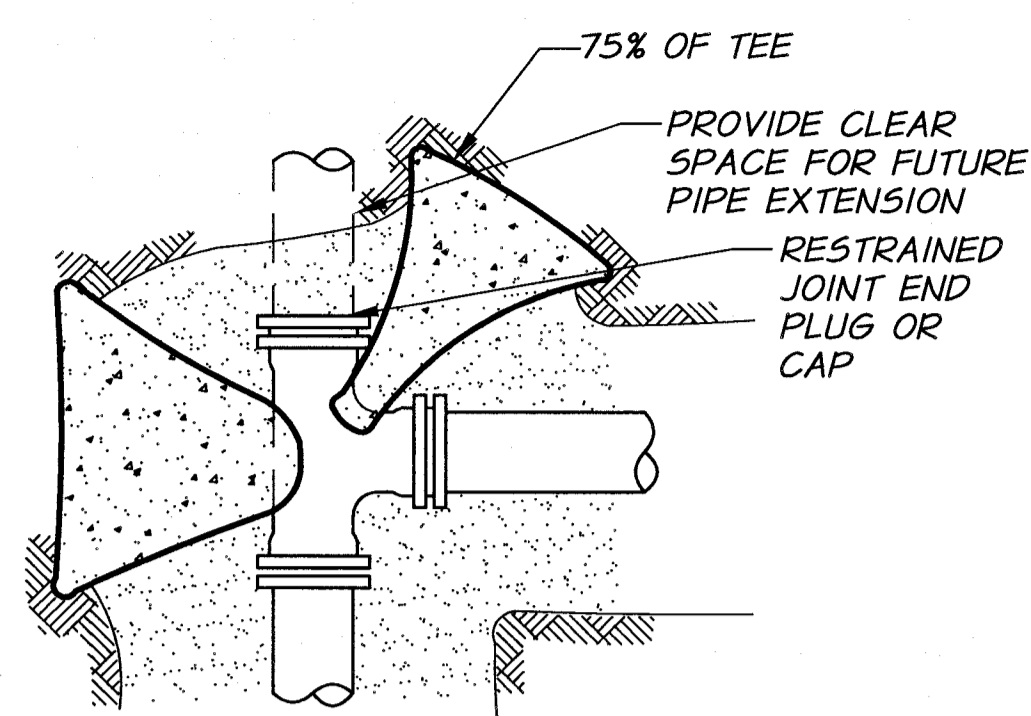

BEARING AREA (A) = HEIGHT (H) x LENGTH (L)  
 $A = H \times L$

**PLAN**

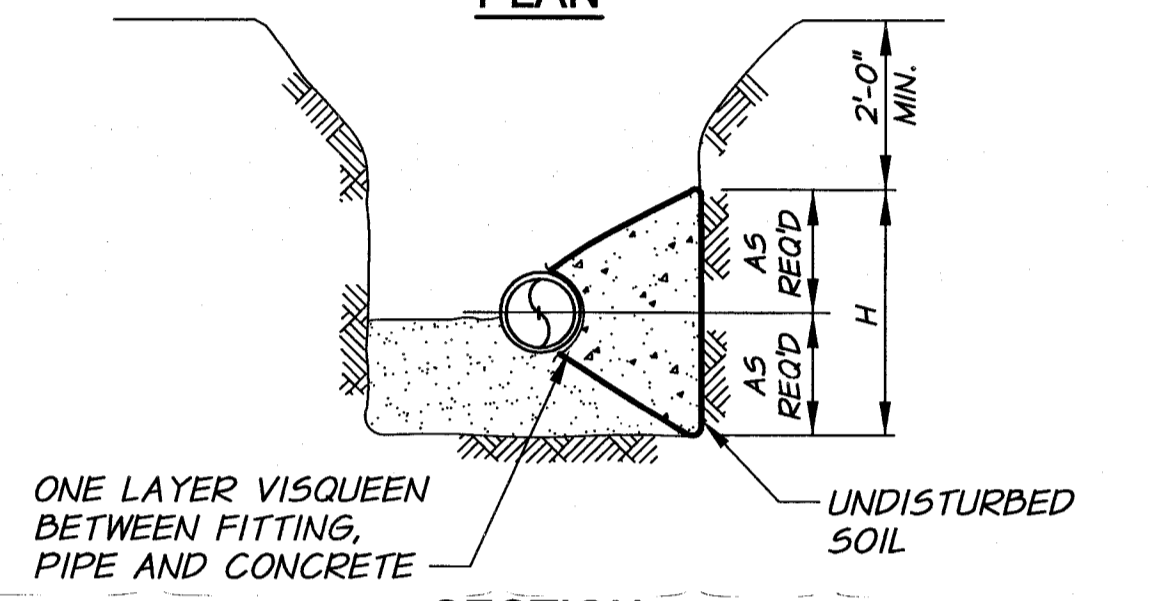


**SECTION**

**TYPICAL THRUST BLOCK DETAILS**

**TYPICAL THRUST BLOCK LOCATIONS**

**PLAN VIEWS**

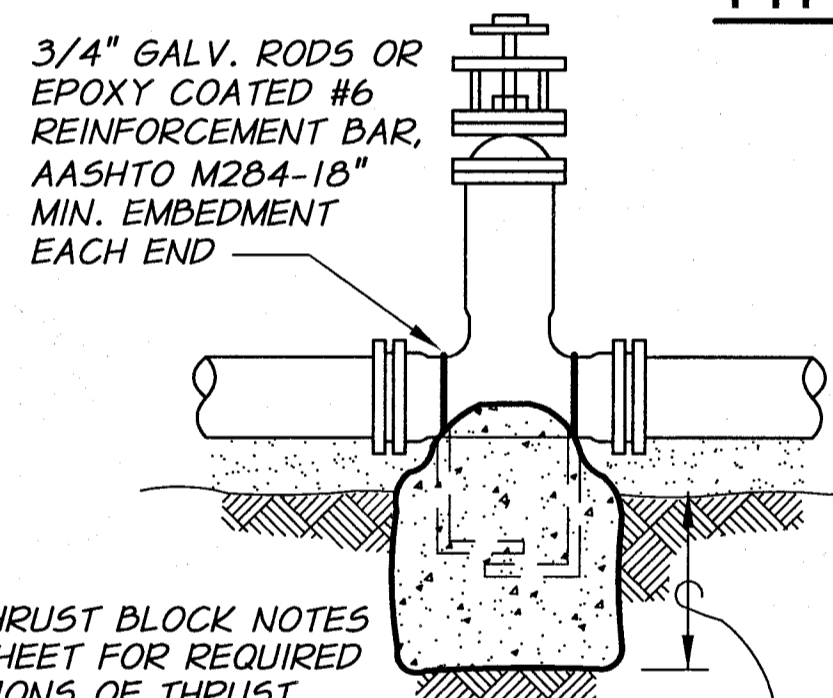


NOTE: SEE THRUST BLOCK NOTES THIS SHEET FOR REQUIRED LOCATIONS OF THRUST BLOCKS FOR VALVES.


BEARING AREA SHALL BE AS CALCULATED FOR DEAD END WATER LINE.

**TYPICAL VALVE THRUST BLOCK**

NOTE: NOT REQUIRED FOR VALVES WITH FLANGED CONNECTION TO TEE WITH THRUST BLOCK.

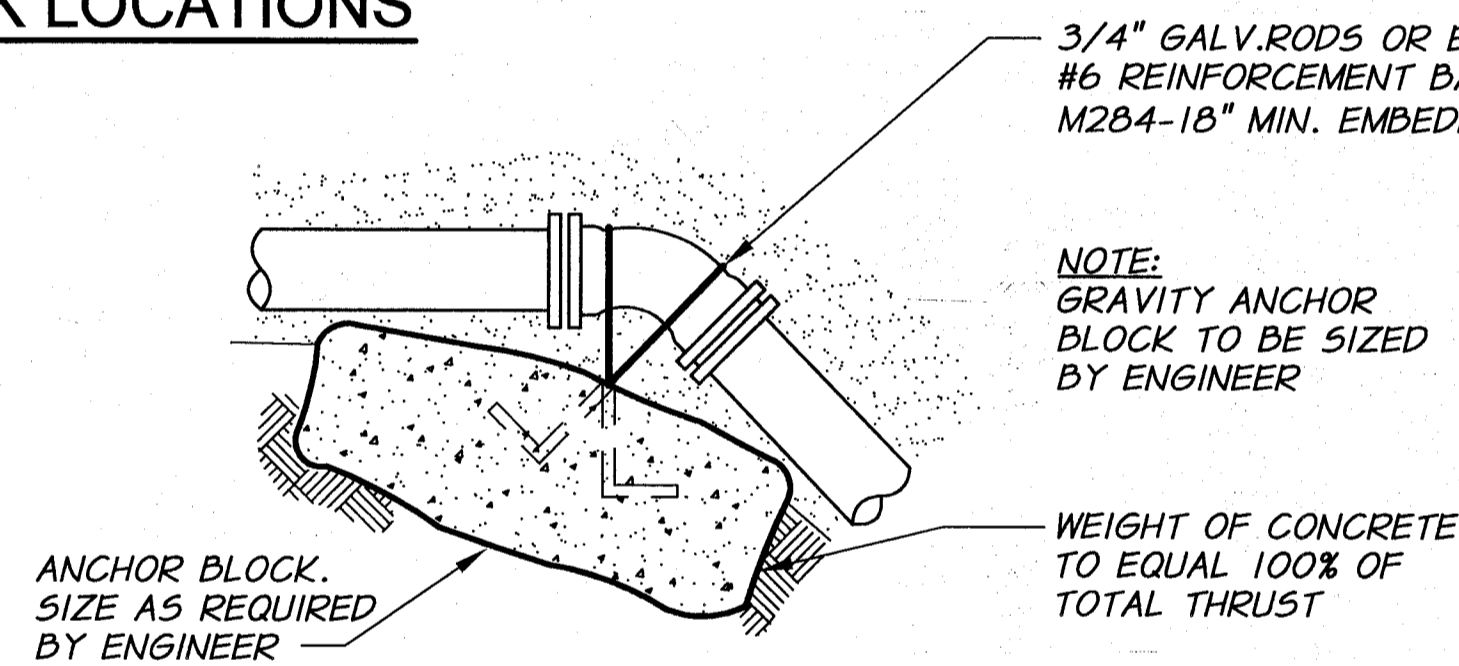


**SECTIONS**

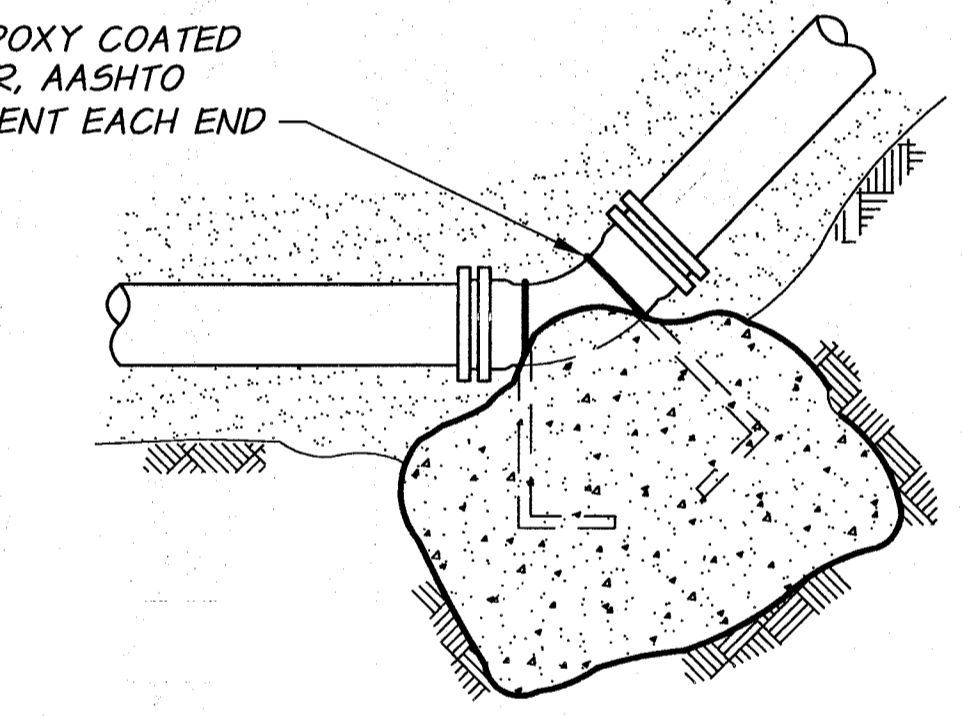


3/4" GALV. RODS OR EPOXY COATED #6 REINFORCEMENT BAR, AASHTO M284-18" MIN. EMBEDMENT EACH END

NOTE: GRAVITY ANCHOR BLOCK TO BE SIZED BY ENGINEER

WEIGHT OF CONCRETE TO EQUAL 100% OF TOTAL THRUST

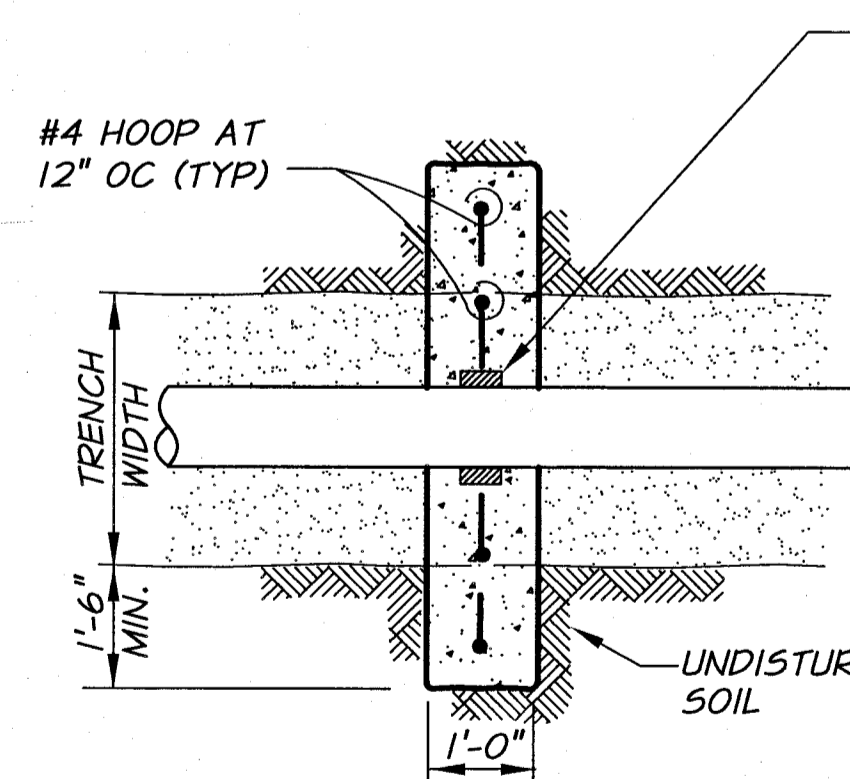

MEGALUG RESTRAINED JOINT DEVICE BY EBAA IRON, INC. OR APPROVED EQUAL. MEGALUG REQUIRED TO TRANSFER THRUST FROM PIPE TO CONCRETE COLLAR. FOR HDPE PIPE USE A FLANGE ADAPTOR FUSED IN PIPELINE.

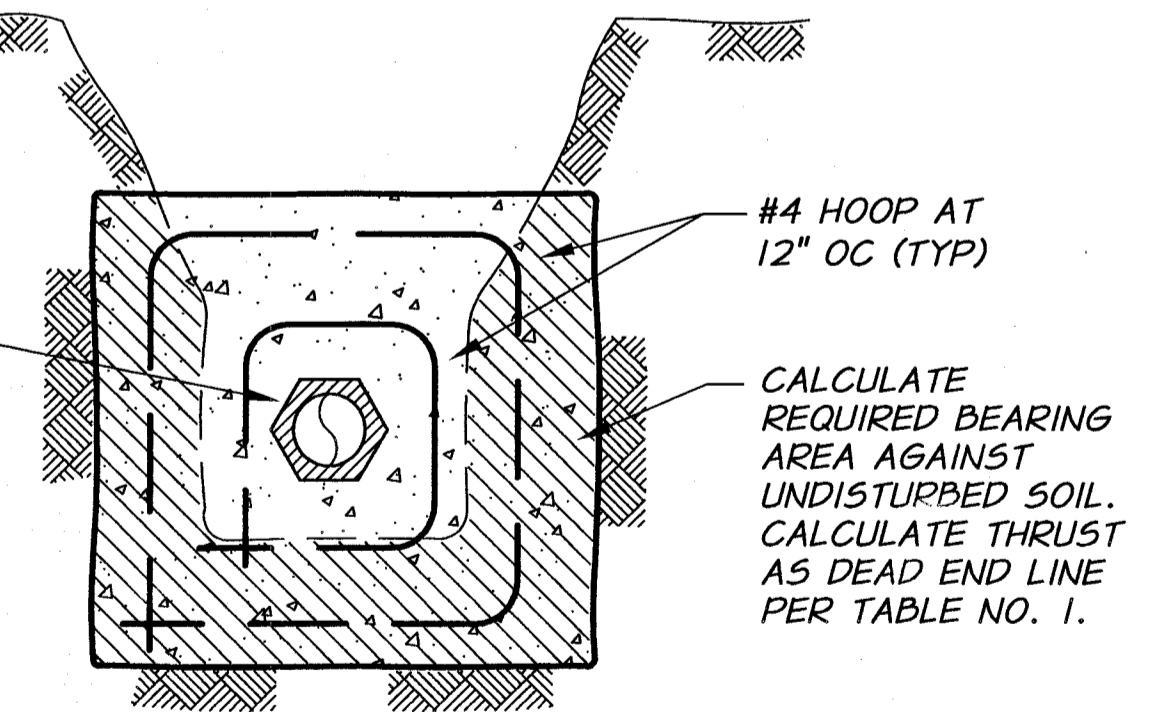

CALCULATE REQUIRED BEARING AREA AGAINST UNDISTURBED SOIL. CALCULATE THRUST AS DEAD END LINE PER TABLE NO. 1.

**ANCHOR COLLAR**


**TYPICAL ANCHOR BLOCKS**



|             |              |   |                 |      |             |
|-------------|--------------|---|-----------------|------|-------------|
| REVISION    | BY           | DATE  | HORIZ. SCALE    | NONE | VERT. SCALE |
| DESIGNED BY | H. MORRISON  | JOB NUMBER                                      | 1199-336        | DATE | 2013        |
| DRAWN BY    | D. CHRISTMAN | ACAD FILE                                       | Thrust-PH3C.dwg |      |             |
| REVIEWED BY | B. MOORE     | COPYRIGHT 2013 BY ANDERSON-PERRY & ASSOC., INC. |                 |      |             |

**RECORD DRAWINGS**

APRIL 18, 2014  
 These record drawings have been prepared, in part, on the basis of information compiled and furnished by others. They may contain some discrepancies and omissions, and do not necessarily represent "exact" field conditions. The Owner and the Engineer accept no responsibility for their accuracy.

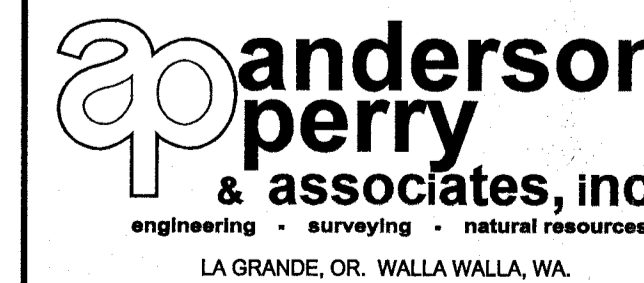

**BENTON IRRIGATION DISTRICT**  
 IRRIGATION SYSTEM IMPROVEMENTS  
 PHASE 3C

**THRUST BLOCK DETAILS**

SHEET

27