




B.I.D. PARCEL DELIVERY
(SERVICE ADDITION)
SCALE: 1"=50'

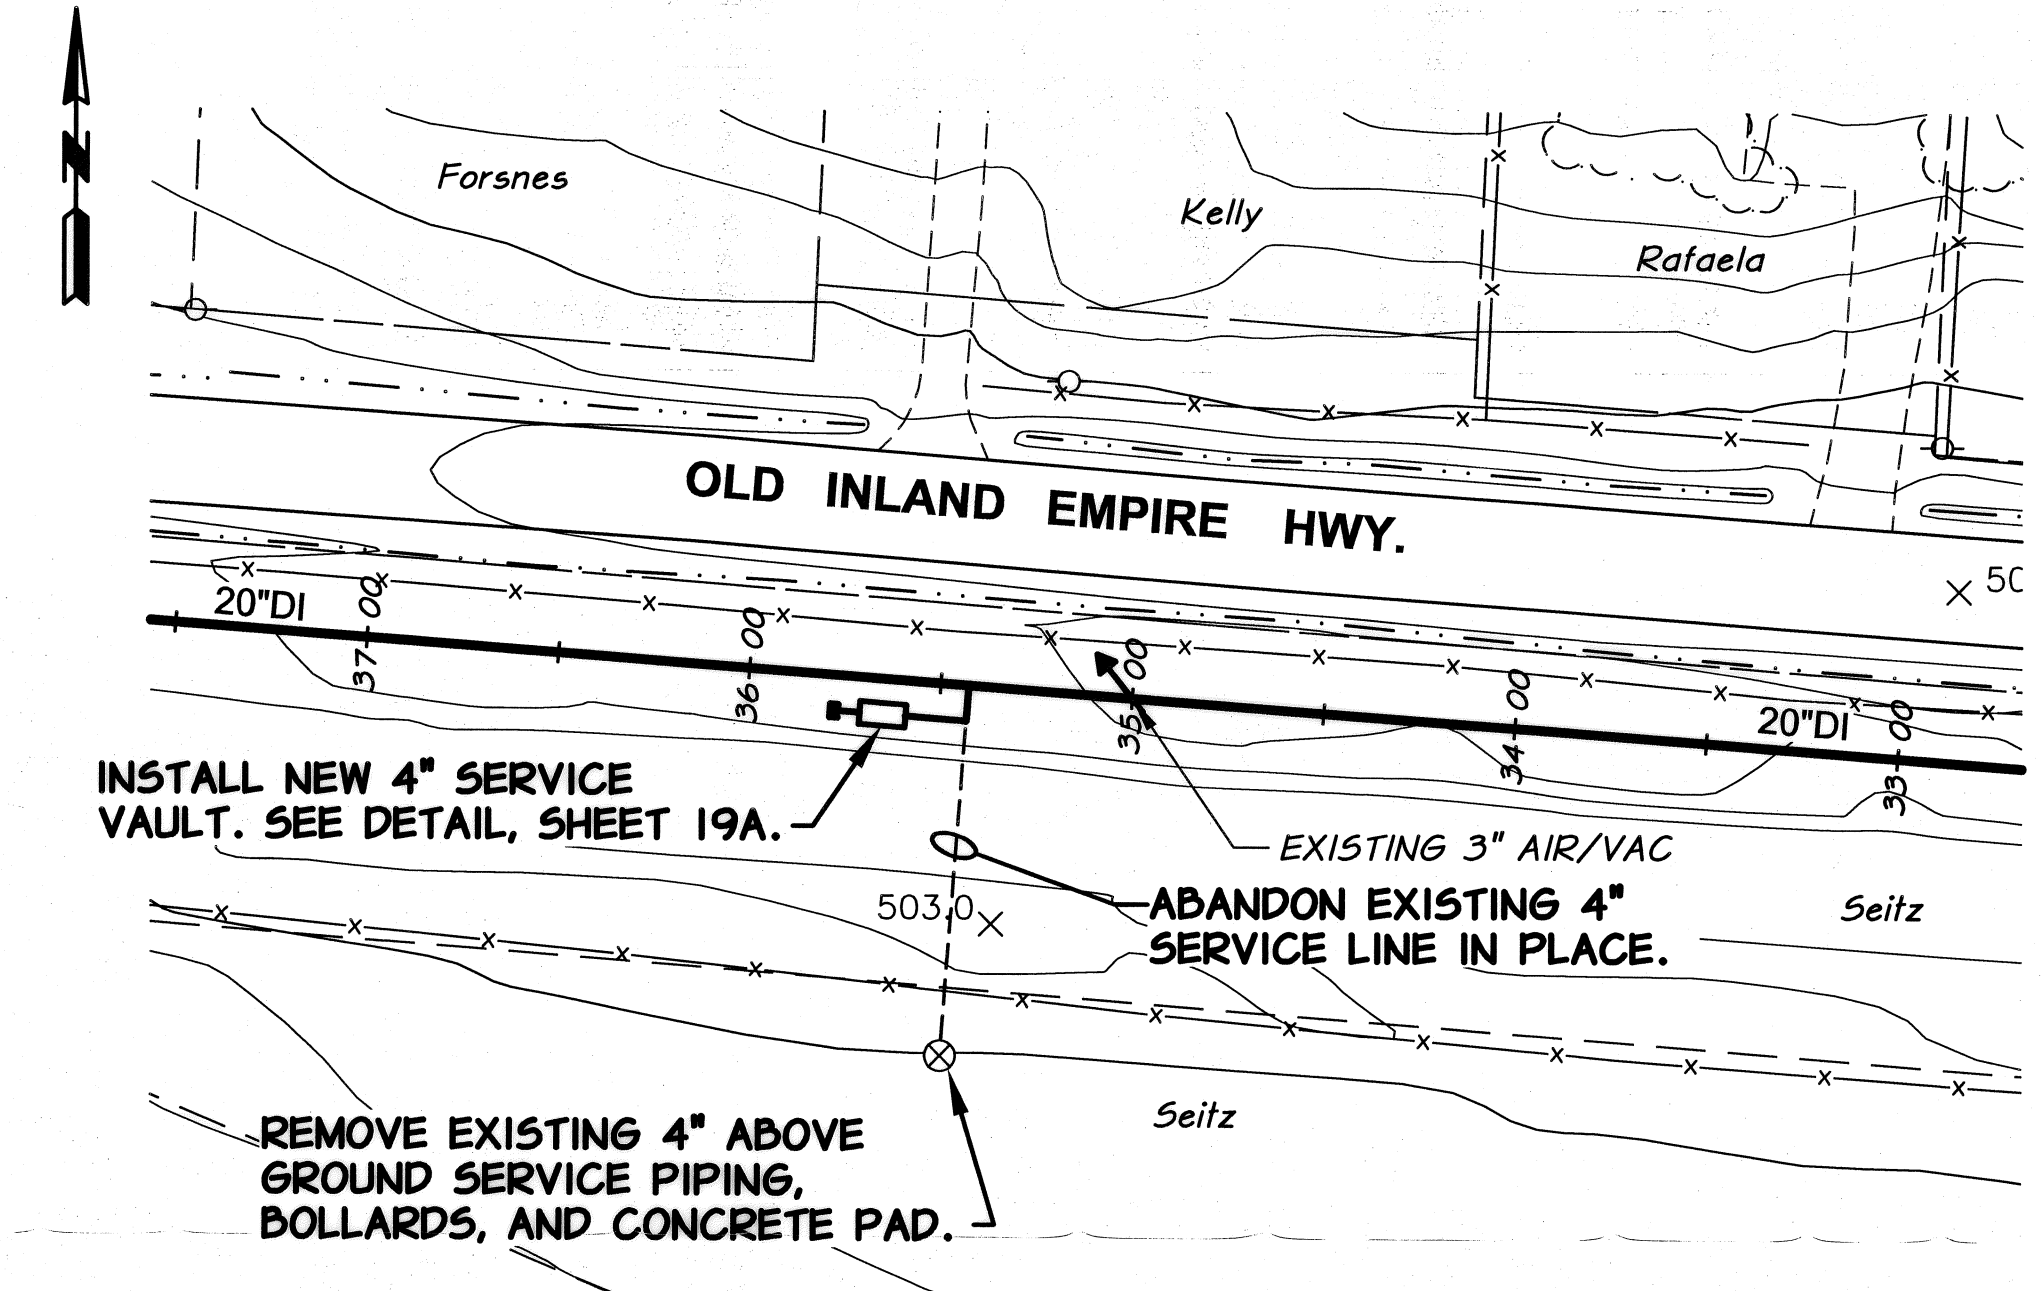

SEITZ DELIVERY UPDATE
(CHANGE ORDER 1.2)
SCALE: 1"=50'

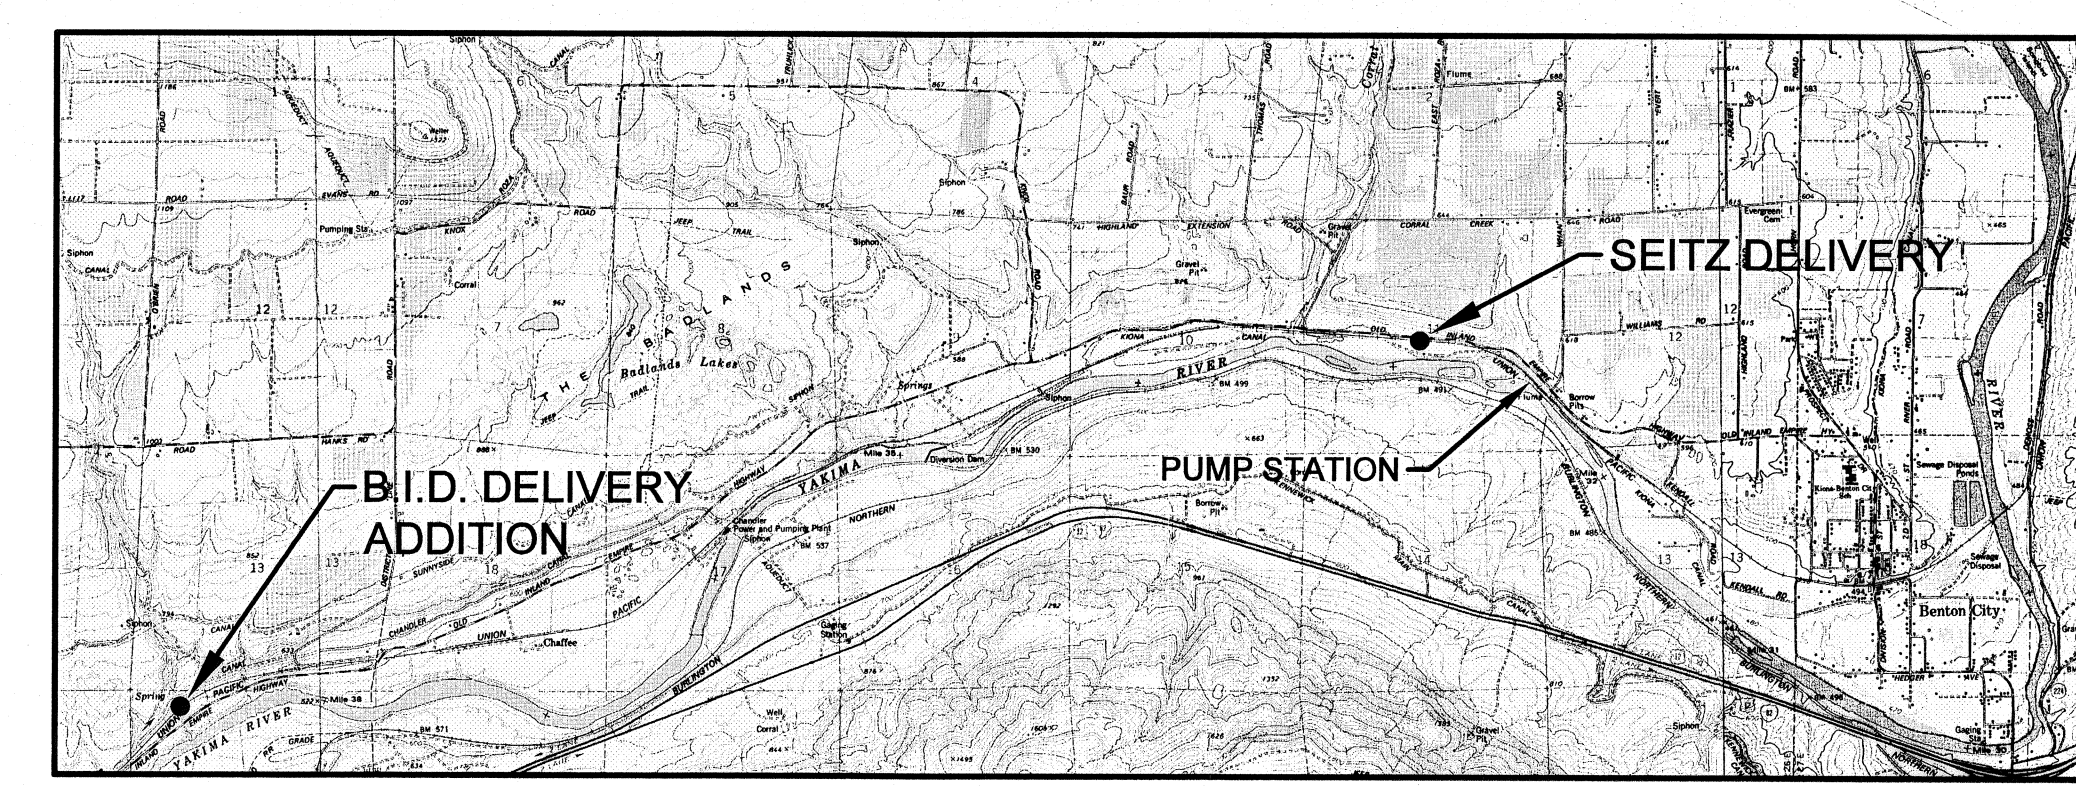


BENTON IRRIGATION DISTRICT
SERVICE UPDATE LOCATIONS
N.T.S.

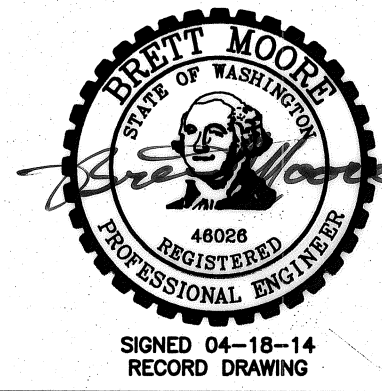

RECORD DRAWING		B.M. 4/14		SCALE IN FEET 0 50 100 150	
DESIGNED BY	H. MORRISON	HORIZ. SCALE	1"=50'	DATE	2013
DRAWN BY	E. ARNTZ	JOB NUMBER	1199-336	ACAD FILE	PH3C - Seitz CO.dwg
REVIEWED BY	D. MOORE	COPYRIGHT 2013 BY ANDERSON-PERRY & ASSOC., INC.			

RECORD DRAWINGS
APRIL 18, 2014
These record drawings have been prepared, in part, on the basis of information compiled and furnished by others. They may contain some discrepancies and omissions, and do not necessarily represent "exact" field conditions. The Owner and the Engineer accept no responsibility for their accuracy.

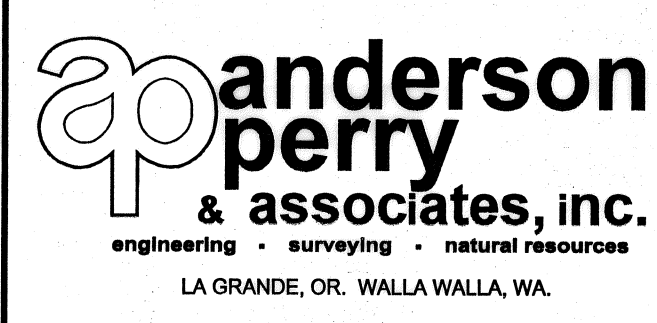

BENTON IRRIGATION DISTRICT
IRRIGATION SYSTEM IMPROVEMENTS
PHASE 3C
ADDED SERVICE AND CHANGE ORDER 1.2

SHEET
12A