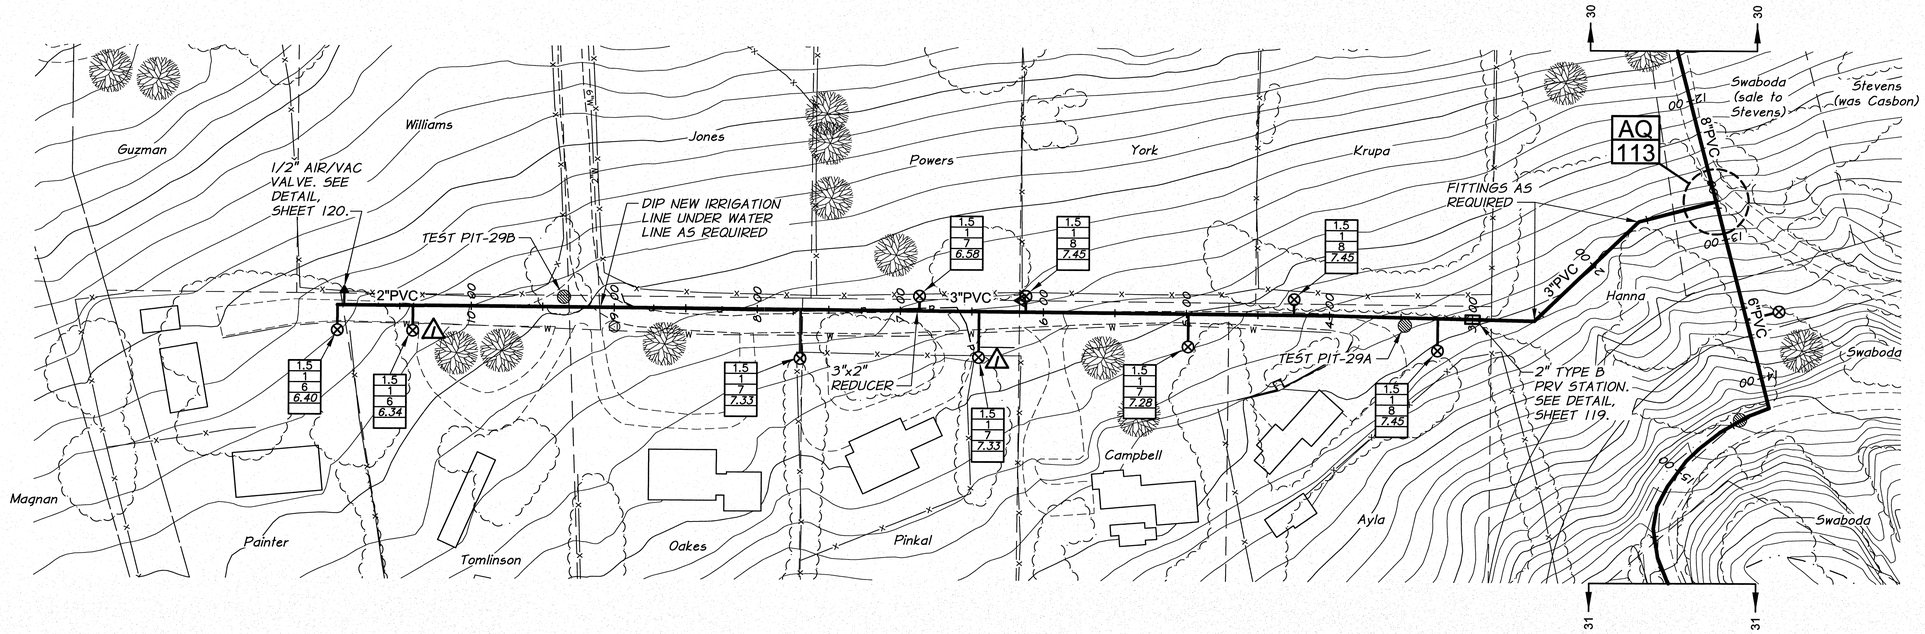

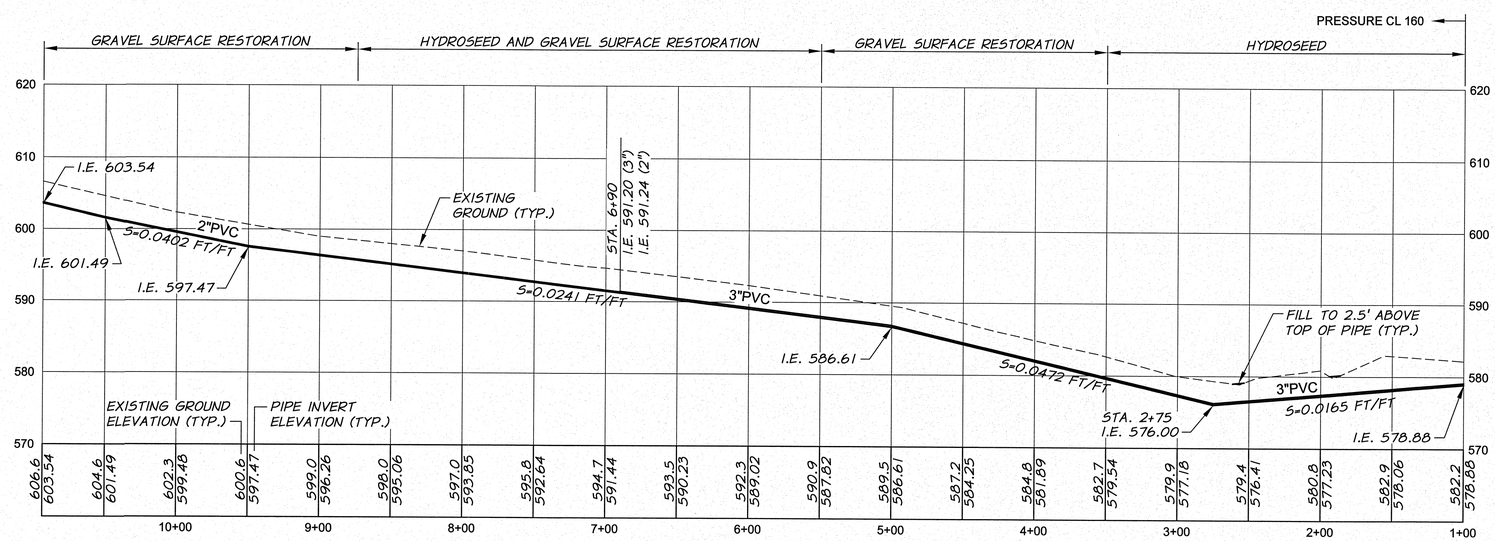

ADDITIVE ALTERNATIVE A

BRETT MOORE
STATE OF WASHINGTON
46026
REGISTERED
PROFESSIONAL ENGINEER
SIGNED 06-15-12
RECORD DRAWING

RECORD DRAWING	E.H.	12/11	
REVISION	BY	DATE	
DESIGNED BY R. HARRIS	XREFS: TB-BID.dwg		
DRAWN BY D. CHRISTMAN			
REVIEWED BY H. PERRY			

SCALE IN FEET: 50 0 50 100 150
SCALE IN FEET: 10 0 10 20 30

HORZ. SCALE	1"=50'	VERT. SCALE	1"=10'
JOB NUMBER	1199-336	DATE	2009
ACAD FILE:	464TH-PNP.dwg		

COPYRIGHT 2009 BY ANDERSON-PERRY & ASSOC., INC.

RECORD DRAWINGS

These record drawings have been prepared, in part, on the basis of information compiled and furnished by others. They may contain some discrepancies and omissions, and do not necessarily represent "exact" field conditions. The Owner and the Engineer accept no responsibility for their accuracy.

anderson perry & associates, inc.
engineering · surveying · natural resources
LA GRANDE, OR. WALLA WALLA, WA.

BENTON IRRIGATION DISTRICT
IRRIGATION SYSTEM IMPROVEMENTS
PHASE I

464TH STREET PIPING
PLAN AND PROFILE - STA. 1+00 TO 10+94

SHEET
38

ARCHIVED

Q:\BENTON I.D\1199_336_PRESSURE_PRR\dwg\464TH-PNP.dwg, 464TH, 6/19/2012 1:14:39 PM