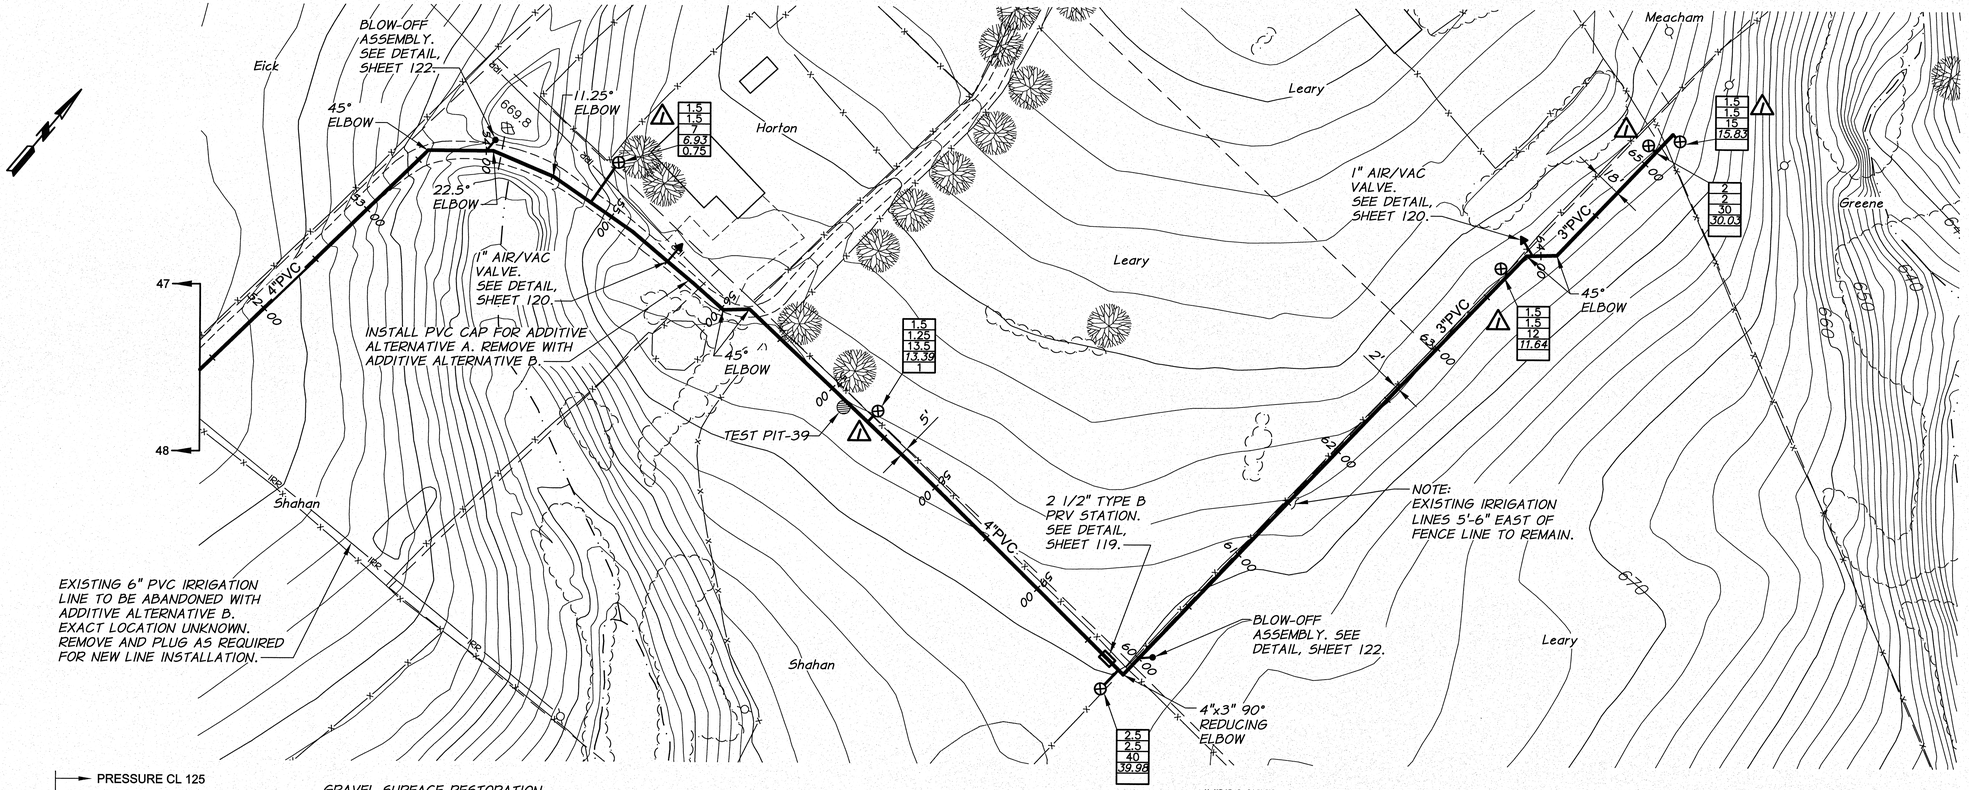

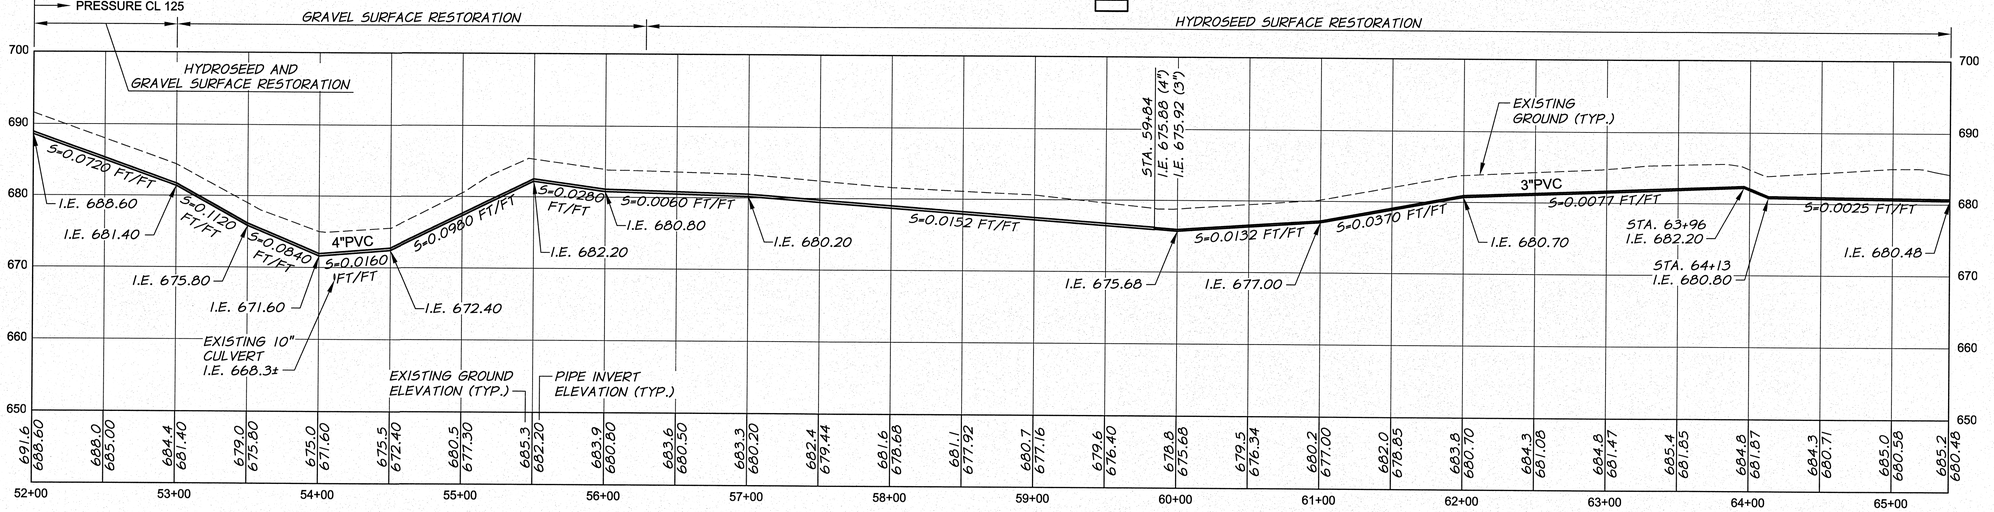

ADDITIVE ALTERNATIVE A - STA. 52+00 TO 55+70
ADDITIVE ALTERNATIVE B - STA. 55+70 TO 65+40

BRETT MOORE
STATE OF WASHINGTON
46026
REGISTERED
PROFESSIONAL ENGINEER
SIGNED 06-15-12
RECORD DRAWING

RECORD DRAWING	E.H.	12/11
REVISION	BY	DATE
DESIGNED BY R. HARRIS	XREFS: TB-BID.dwg	
DRAWN BY D. CHRISTMAN		
REVIEWED BY H. PERRY		

50 0 50 100 150 SCALE IN FEET
10 0 10 20 30 SCALE IN FEET

HORZ. SCALE 1"=50' VERT. SCALE 1"=10'
JOB NUMBER 1199-336 DATE 2009
ACAD FILE: HIGHLAND-PNP.dwg

COPYRIGHT 2009 BY ANDERSON-PERRY & ASSOC., INC.

RECORD DRAWINGS

These record drawings have been prepared, in part, on the basis of information compiled and furnished by others. They may contain some discrepancies and omissions, and do not necessarily represent "exact" field conditions. The Owner and the Engineer accept no responsibility for their accuracy.

anderson perry & associates, inc.
engineering · surveying · natural resources
LA GRANDE, OR. WALLA WALLA, WA.

BENTON IRRIGATION DISTRICT

IRRIGATION SYSTEM IMPROVEMENTS PHASE I

HIGHLAND EXTENSION ROAD PIPING PLAN AND PROFILE - STA. 52+00 TO 65+28

SHEET 48

C:\BENTON LID\1199_336_PRESSURE_RR\dwg\HIGHLAND-PNP.dwg, HSR V, 6/19/2012 1:31:59 PM