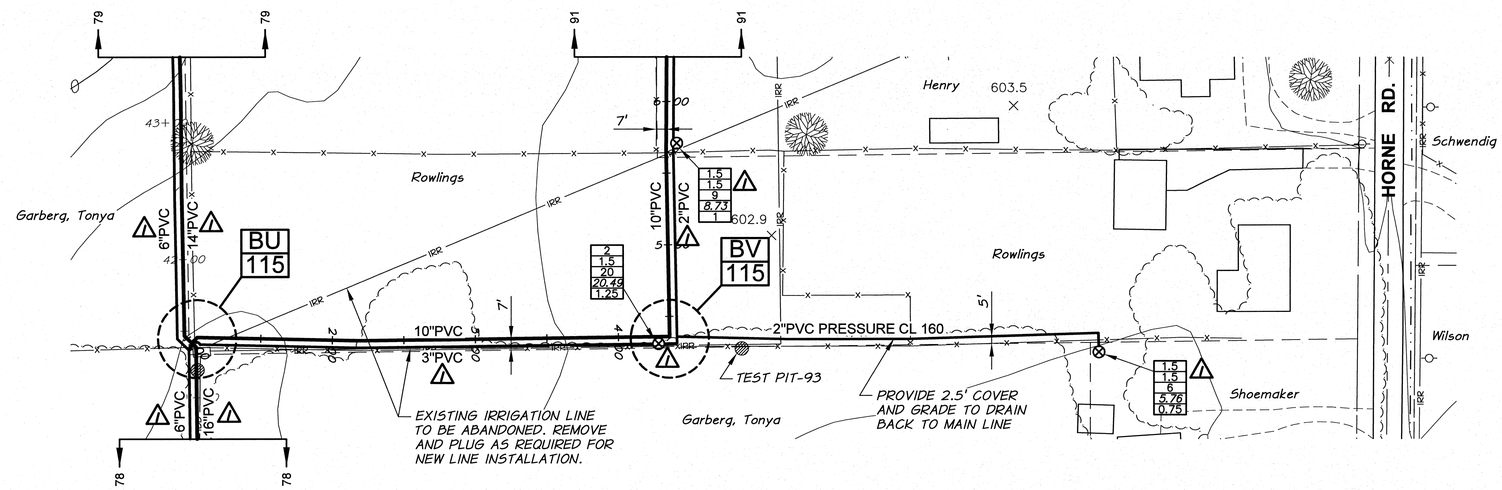

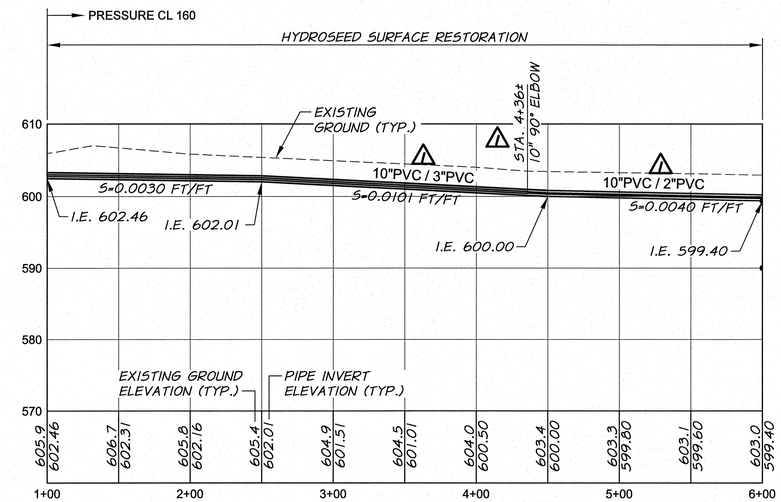

ADDITIVE ALTERNATIVE B

BRETT MOORE
STATE OF WASHINGTON
46026
REGISTERED
PROFESSIONAL ENGINEER
SIGNED 06-15-12
RECORD DRAWING

REVISION	BY	DATE
RECORD DRAWING	E.H.	12/11

SCALE IN FEET: 50 0 50 100 150
SCALE IN FEET: 10 0 10 20 30

DESIGNED BY R. HARRIS	XREFS: TB-BID.dwg	HORZ. SCALE 1"=50'	VERT. SCALE 1"=10'
DRAWN BY R. RASMUSSEN		JOB NUMBER 1199-336	DATE 2009
REVIEWED BY H. PERRY		ACAD FILE: HIGHLAND-ACCORD-SUBS.dwg	

COPYRIGHT 2009 BY ANDERSON-PERRY & ASSOC., INC.

RECORD DRAWINGS

These record drawings have been prepared, in part, on the basis of information compiled and furnished by others. They may contain some discrepancies and omissions, and do not necessarily represent "exact" field conditions. The Owner and the Engineer accept no responsibility for their accuracy.

anderson perry & associates, inc.
engineering · surveying · natural resources
LA GRANDE, OR. WALLA WALLA, WA.

BENTON IRRIGATION DISTRICT
IRRIGATION SYSTEM IMPROVEMENTS
PHASE I

HIGHLAND ROAD TO ACORD ROAD PIPING
PLAN AND PROFILE - STA. 1+00 TO 6+00

SHEET
90

ARCHIVED

C:\BENTON LD\1199_336_PRESSURE_IRR\dwg\HIGHLAND-ACCORD-SUBS.dwg, SUB10A, 6/22/2012 10:12:42 AM