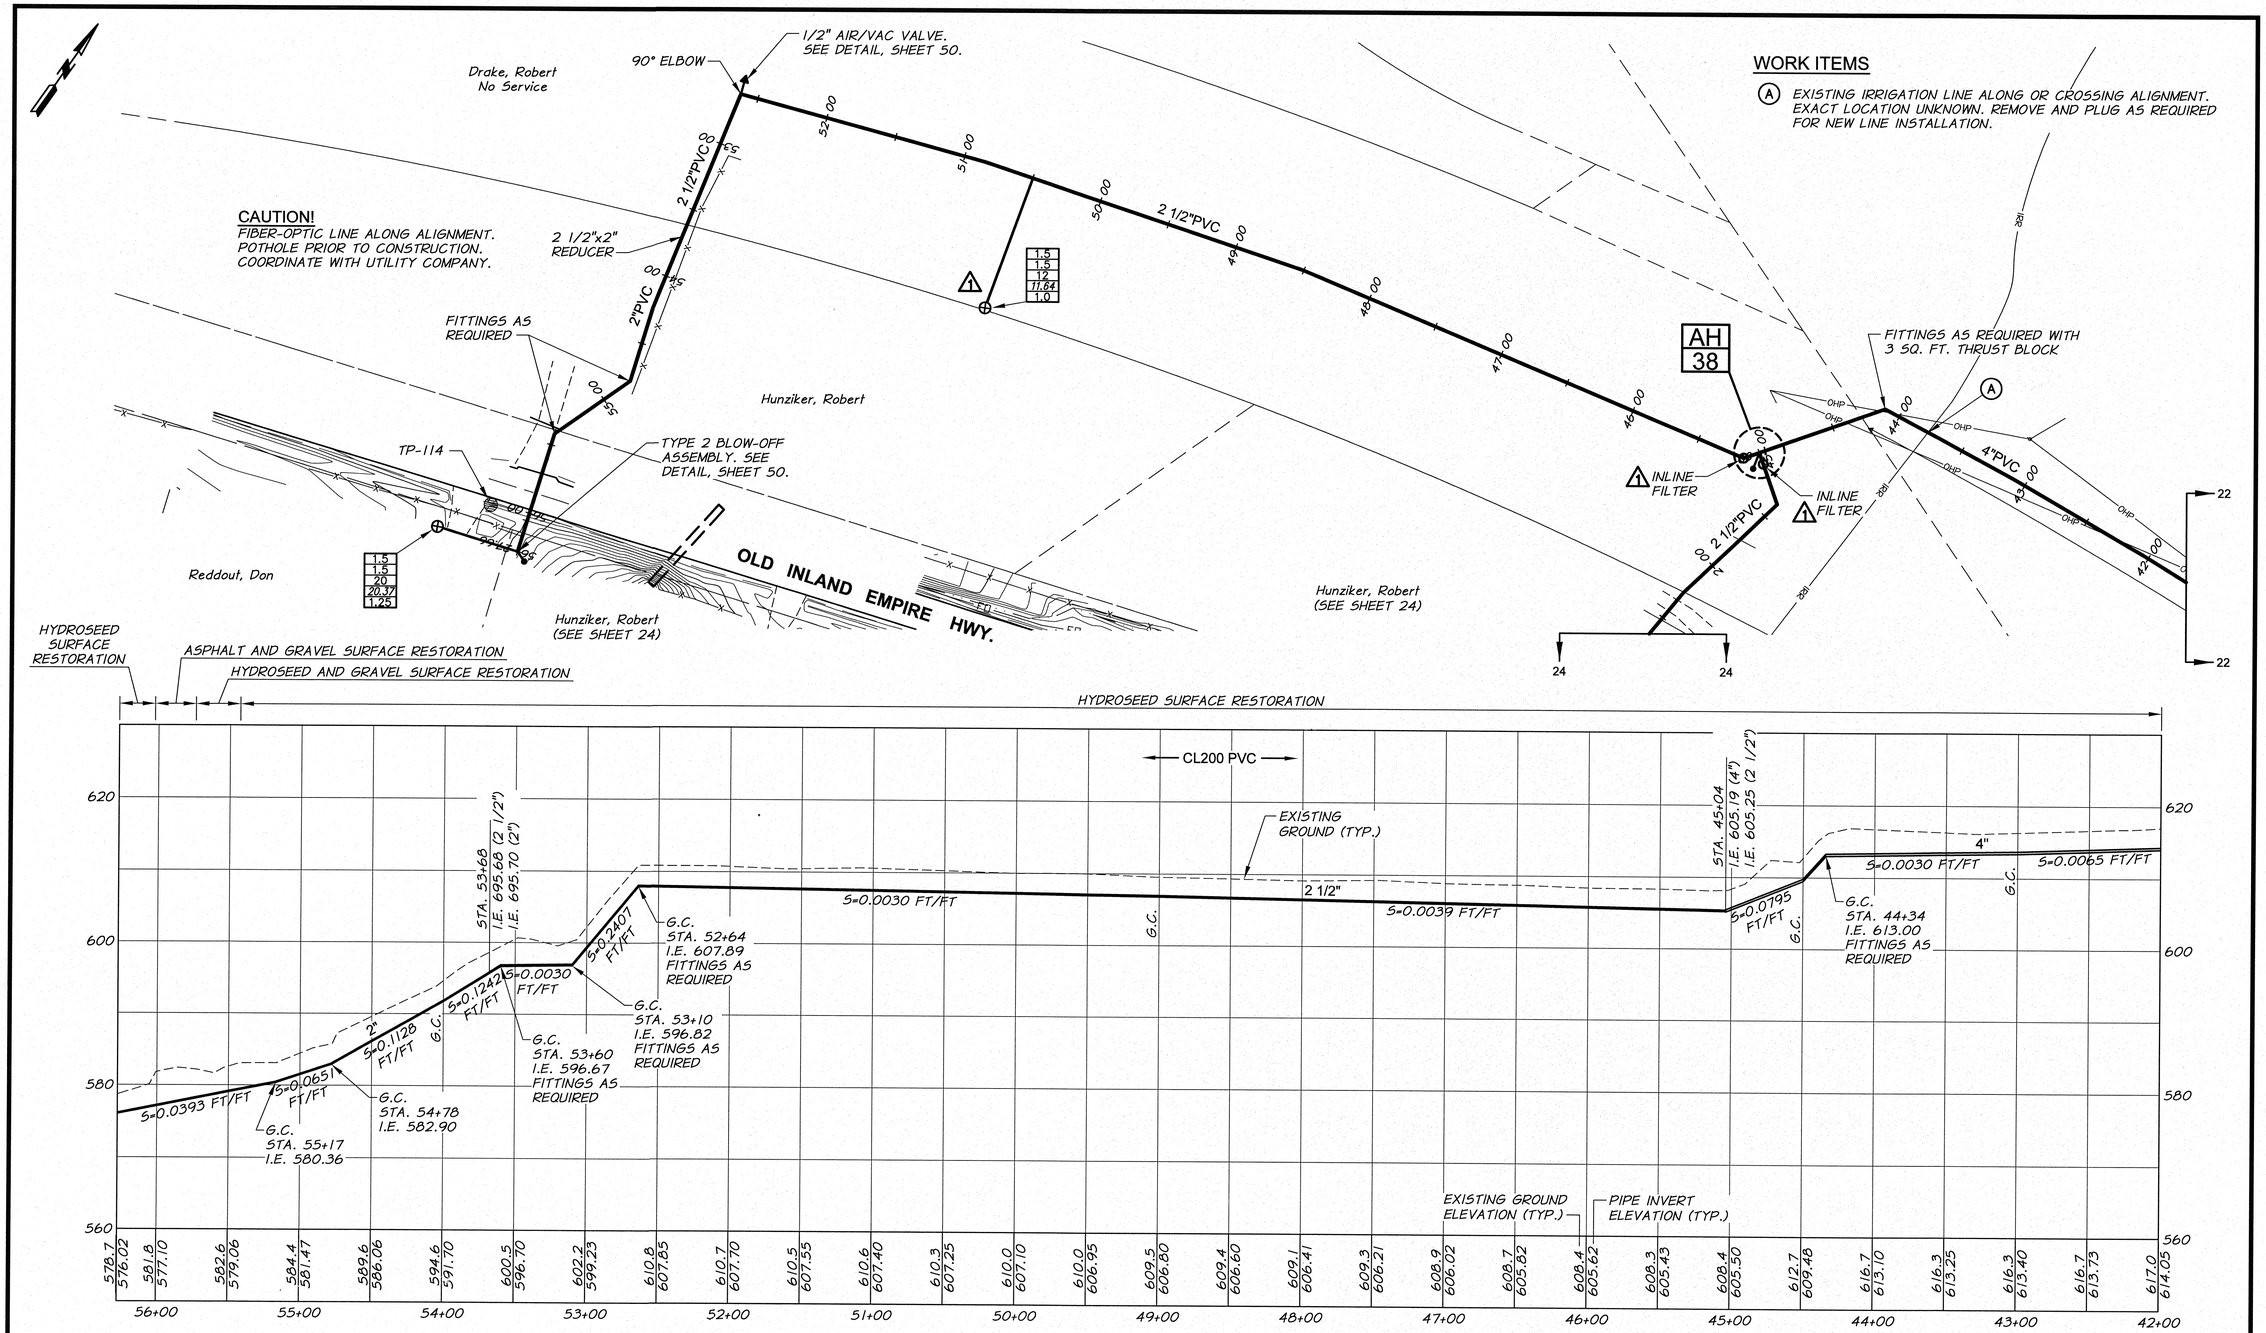

SIGNED 06-04-12
RECORD DRAWINGS

REVISION	BY	DATE
RECORD DRAWINGS	B.M.	5/12

DESIGNED BY R. HARRIS
DRAWN BY E. ARNTZ
REVIEWED BY B. MOORE
XREFS: TB-BID.dwg

SCALE IN FEET (50 0 50 100 150)
SCALE IN FEET (10 0 10 20 30)
HORZ. SCALE 1"=50' VERT. SCALE 1'=10"
JOB NUMBER 1199-336 DATE 2011
ACAD FILE: West_Main _E.dwg

COPYRIGHT 2011 BY ANDERSON-PERRY & ASSOC., INC.

RECORD DRAWINGS

These record drawings have been prepared, in part, on the basis of information compiled and furnished by others. They may contain some discrepancies and omissions, and do not necessarily represent "exact" field conditions. The Owner and the Engineer accept no responsibility for their accuracy.

anderson perry & associates, inc.
engineering · surveying · natural resources
LA GRANDE, OR. WALLA WALLA, WA.

BENTON IRRIGATION DISTRICT
IRRIGATION SYSTEM IMPROVEMENTS
PHASE 2B

O.I.E. HWY. PIPING
STA. 42+00 TO STA. 56+28

SHEET
23

ARCHIVED