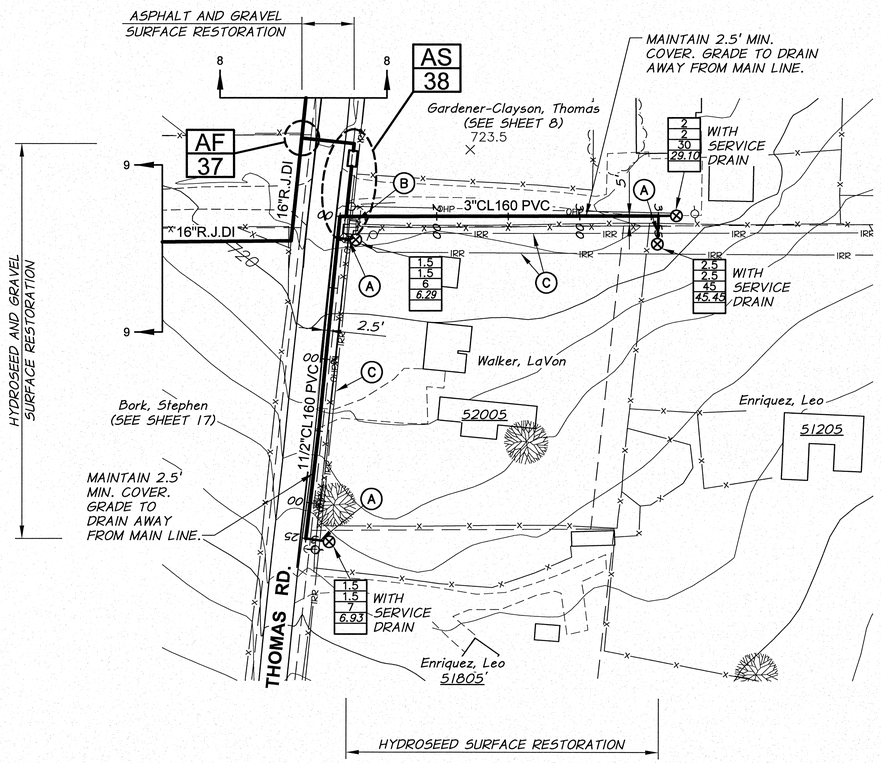

WORK ITEMS

(A) EXISTING IRRIGATION LINE ALONG OR CROSSING ALIGNMENT. EXACT LOCATION UNKNOWN. REMOVE AND PLUG AS REQUIRED FOR NEW LINE INSTALLATION.

(B) EXISTING IRRIGATION CONTROL STRUCTURE TO BE REMOVED.

(C) EXISTING IRRIGATION LINE ALONG ALIGNMENT TO BE ABANDONED. REMOVE AND PLUG AS REQUIRED FOR NEW LINE INSTALLATION.

ROBERT MOORE — STATE OF WASHINGTON — 48028 — REGISTERED PROFESSIONAL ENGINEER

SIGNED 07-09-12
RECORD DRAWINGS

REVISION	BY	DATE

DESIGNED BY	R. HARRIS	XREFS: TB-BID.dwg	
DRAWN BY	E. ARNTZ		
REVIEWED BY	B. MOORE		

50 0 50 100 150 SCALE IN FEET
10 0 10 20 30 SCALE IN FEET

HORZ. SCALE 1"=50' VERT. SCALE 1'=10"
JOB NUMBER 1199-336 DATE 2011
ACAD FILE: North_West _B.dwg

COPYRIGHT 2011 BY ANDERSON-PERRY & ASSOC., INC.

RECORD DRAWINGS

These record drawings have been prepared, in part, on the basis of information compiled and furnished by others. They may contain some discrepancies and omissions, and do not necessarily represent "exact" field conditions. The Owner and the Engineer accept no responsibility for their accuracy.

anderson perry & associates, inc.
engineering · surveying · natural resources
LA GRANDE, OR. WALLA WALLA, WA.

BENTON IRRIGATION DISTRICT
IRRIGATION SYSTEM IMPROVEMENTS PHASE 2C

EAST ROZA TO KNOX ROAD PIPING
STA. 1+00 TO 3+55 AND STA. 1+00 TO 3+25

SHEET 18

ARCHIVED

Q:\BENTON I.D\1199_336_PRESSURE_IRR\dwg\PHASE_2\North_West _B.dwg, North West 23, 7/3/2012 10:45:47 AM