WORK ITEMS

(A) EXISTING IRRIGATION LINE ALONG OR CROSSING ALIGNMENT. EXACT LOCATION UNKNOWN. REMOVE AND PLUG AS REQUIRED FOR NEW LINE INSTALLATION.

(C) EXISTING IRRIGATION LINE ALONG ALIGNMENT TO BE ABANDONED. REMOVE AND PLUG AS REQUIRED FOR NEW LINE INSTALLATION.

SURFACE RESTORATION SCHEDULE		
LINE	LOCATION (STA.)	DESCRIPTION
E	7+00 TO 19+50	GRAVEL
	19+50 TO 20+00	ASPHALT AND GRAVEL
	20+00 TO 21+75	HYDROSEED
	21+75 TO 22+20	ASPHALT AND GRAVEL
	22+20 TO 22+79	HYDROSEED AND GRAVEL
	22+75 TO 22+95	ASPHALT
	22+95 TO 23+21	HYDROSEED AND GRAVEL
	SERVICE AT 8+10	ASPHALT AND GRAVEL
	SERVICE AT 10+90	ASPHALT AND GRAVEL
	SERVICE AT 14+02	ASPHALT AND GRAVEL
	SERVICE AT 17+10	ASPHALT AND GRAVEL

GRADE CONTROL SCHEDULE			
LINE	FROM STA.	TO STA.	CONTINUOUS SLOPE DIRECTION
E	7+00	10+77	DOWNWARD
	10+77	16+77	UPWARD
	16+77	23+21	DOWNWARD

NOTES:
1. MINIMUM COVER FROM FINISH GRADE TO TOP OF PIPE SHALL BE 2.5 FEET.
2. MINIMUM SLOPE OF INSTALLED PIPING SHALL BE 0.003 FT/FT.
3. LOT LINES AND RIGHT-OF-WAYS SHOWN ARE APPROXIMATE ONLY.

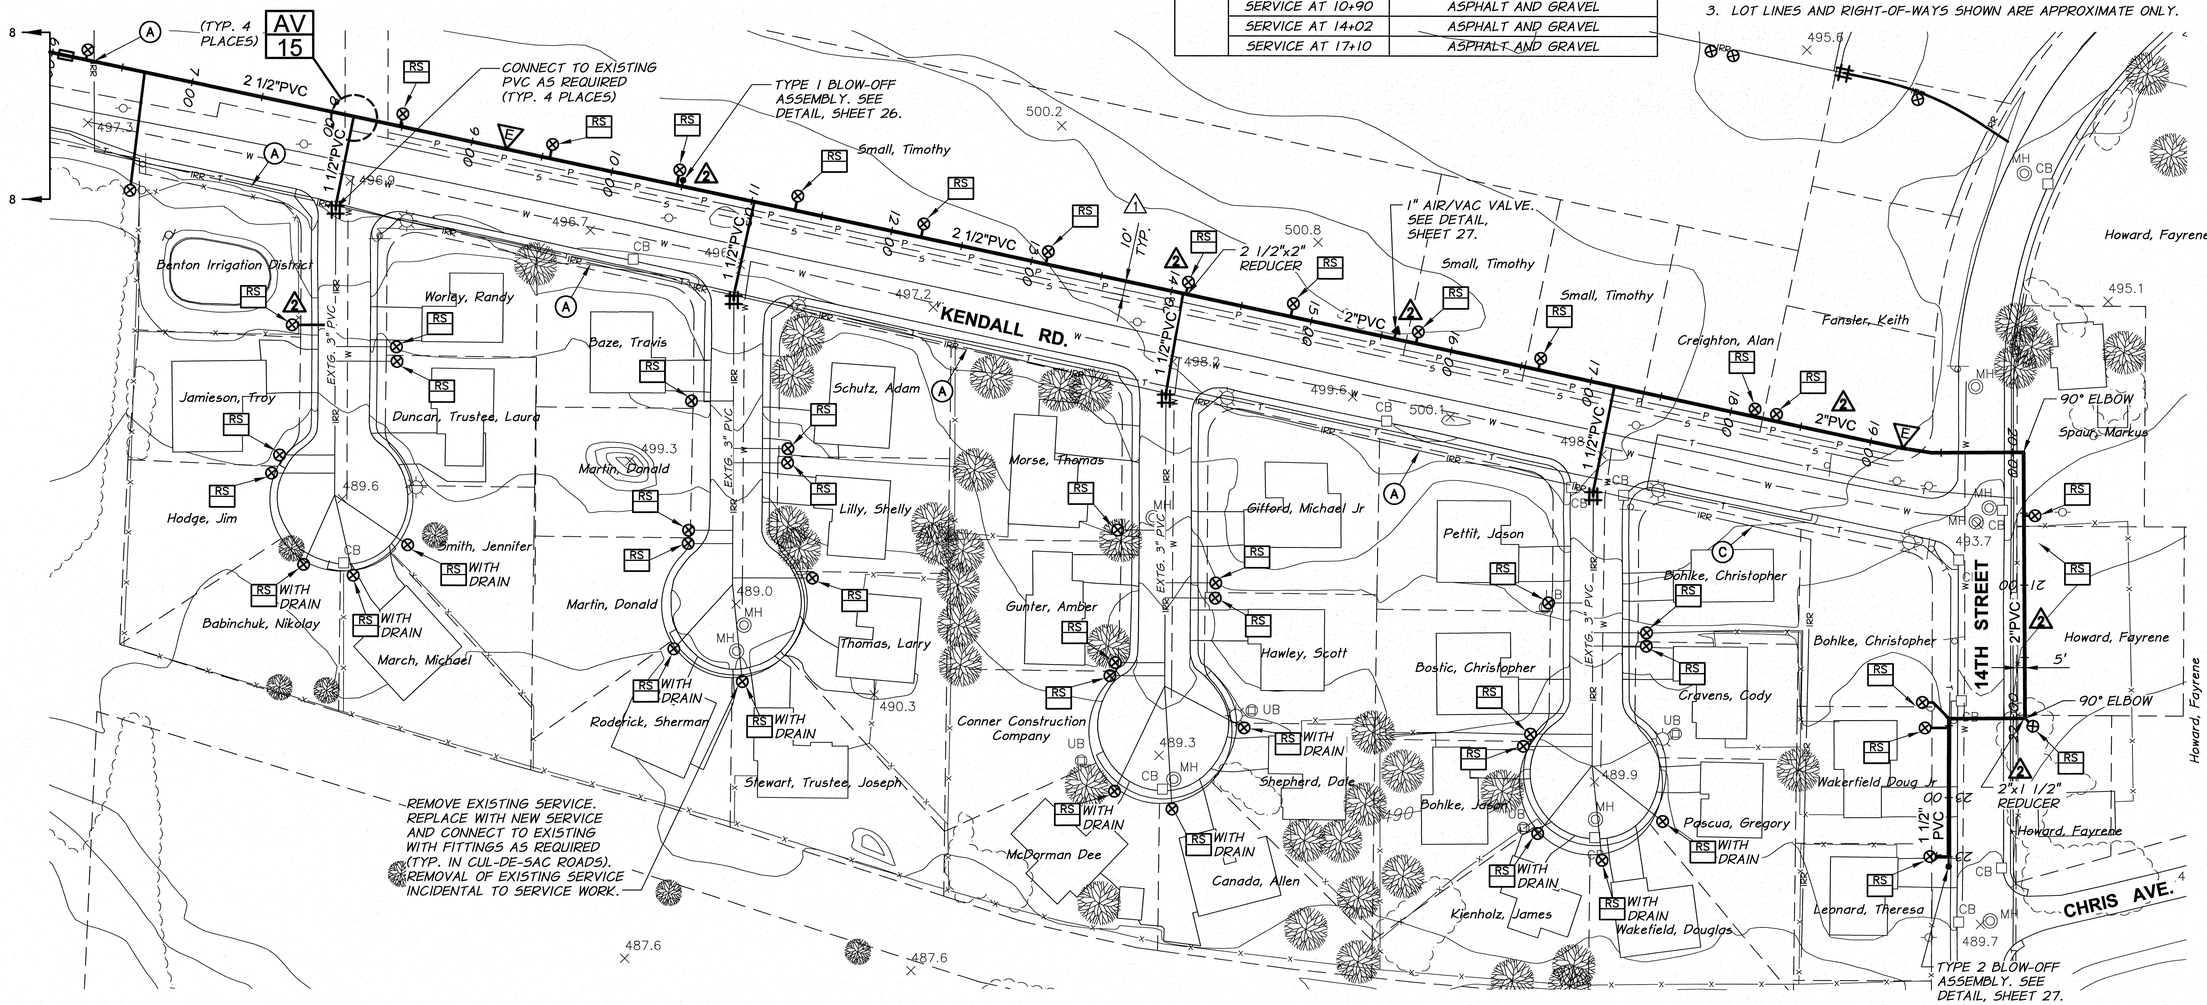

BRETT MOORE — STATE OF WASHINGTON — 46026 — REGISTERED PROFESSIONAL ENGINEER
SIGNED 07-13-12
RECORD DRAWING

REVISION	BY	DATE
2 RECORD DRAWING	B.M.	7/12
1 LINE 'E' LOCATION ADJUSTMENT	B.M.	9/11

SCALE IN FEET: 50 0 50 100 150

DESIGNED BY	R. HARRIS	HORZ. SCALE	1"=50'
DRAWN BY	D. CHRISTMAN	VERT. SCALE	
REVIEWED BY	B. MOORE	JOB NUMBER	1199-336
		DATE	2011
		ACAD FILE:	PNP-KendallSouth.dwg

COPYRIGHT 2011 BY ANDERSON-PERRY & ASSOC., INC.

RECORD DRAWINGS

These record drawings have been prepared, in part, on the basis of information compiled and furnished by others. They may contain some discrepancies and omissions, and do not necessarily represent "exact" field conditions. The Owner and the Engineer accept no responsibility for their accuracy.

anderson perry & associates, inc.
engineering · surveying · natural resources
LA GRANDE, OR. WALLA WALLA, WA.

BENTON IRRIGATION DISTRICT

IRRIGATION SYSTEM IMPROVEMENTS PHASE 3A

KENDALL RD. SOUTH PIPING
LINE E STA. 7+00 TO STA. 23+41

SHEET 9

ARCHIVED

Q:\BENTON 1.0\1199_336_PRESSURE_IRR\dwg\PHASE_3\PNP-KendallSouth.dwg, KSI, e.earntz